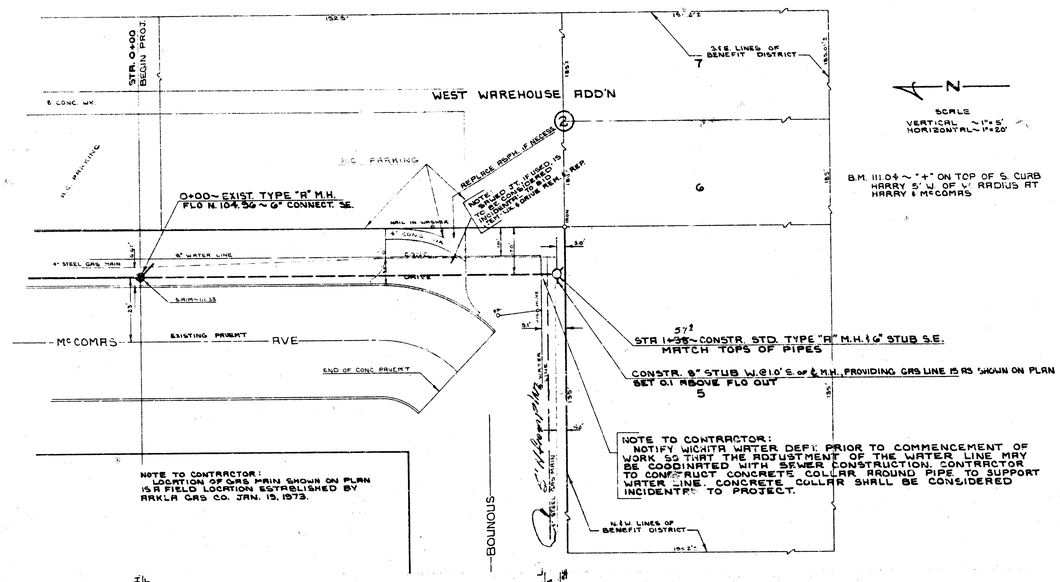

"As Built" Final Measurements SS J.H. #9

LAT 119 ~ S.S.# 22

CITY OF WICHITA

R.W. LINN ~ CITY ENGINEER

DATE JAN. 1973 PROJ. NO. DBKL 572076

DLK TATE

DLK-123

31