


B.M. 99.93 City Std. Disc 6' N & 2' E of
SE R/W Corner of Sheridan & 31st St. S.

B.M. 103.52 City B.M. Dis- Top East End
South Handrail R.C.B.C. Sheridan & 31st

SHERIDAN

AVE.

LANE

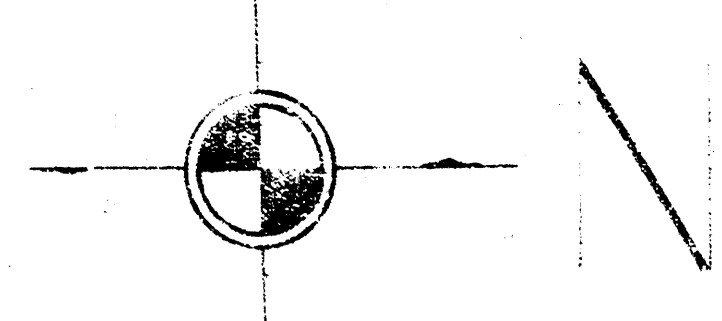


Plan Scale 1" = 40'
Profile Scale 1" = 40' Horiz.
1" = 5' Vert.

Sta 0+00
Proposed M.H.
8" Stub N.
93.37 Flo

BUILDERS

Sta 3+20
Const. Std. M.H.
Type "A" or "C"



Sta 6+45.8
Const. Std. M.H.
Type "A" or "C"
Install 8" Stub N.

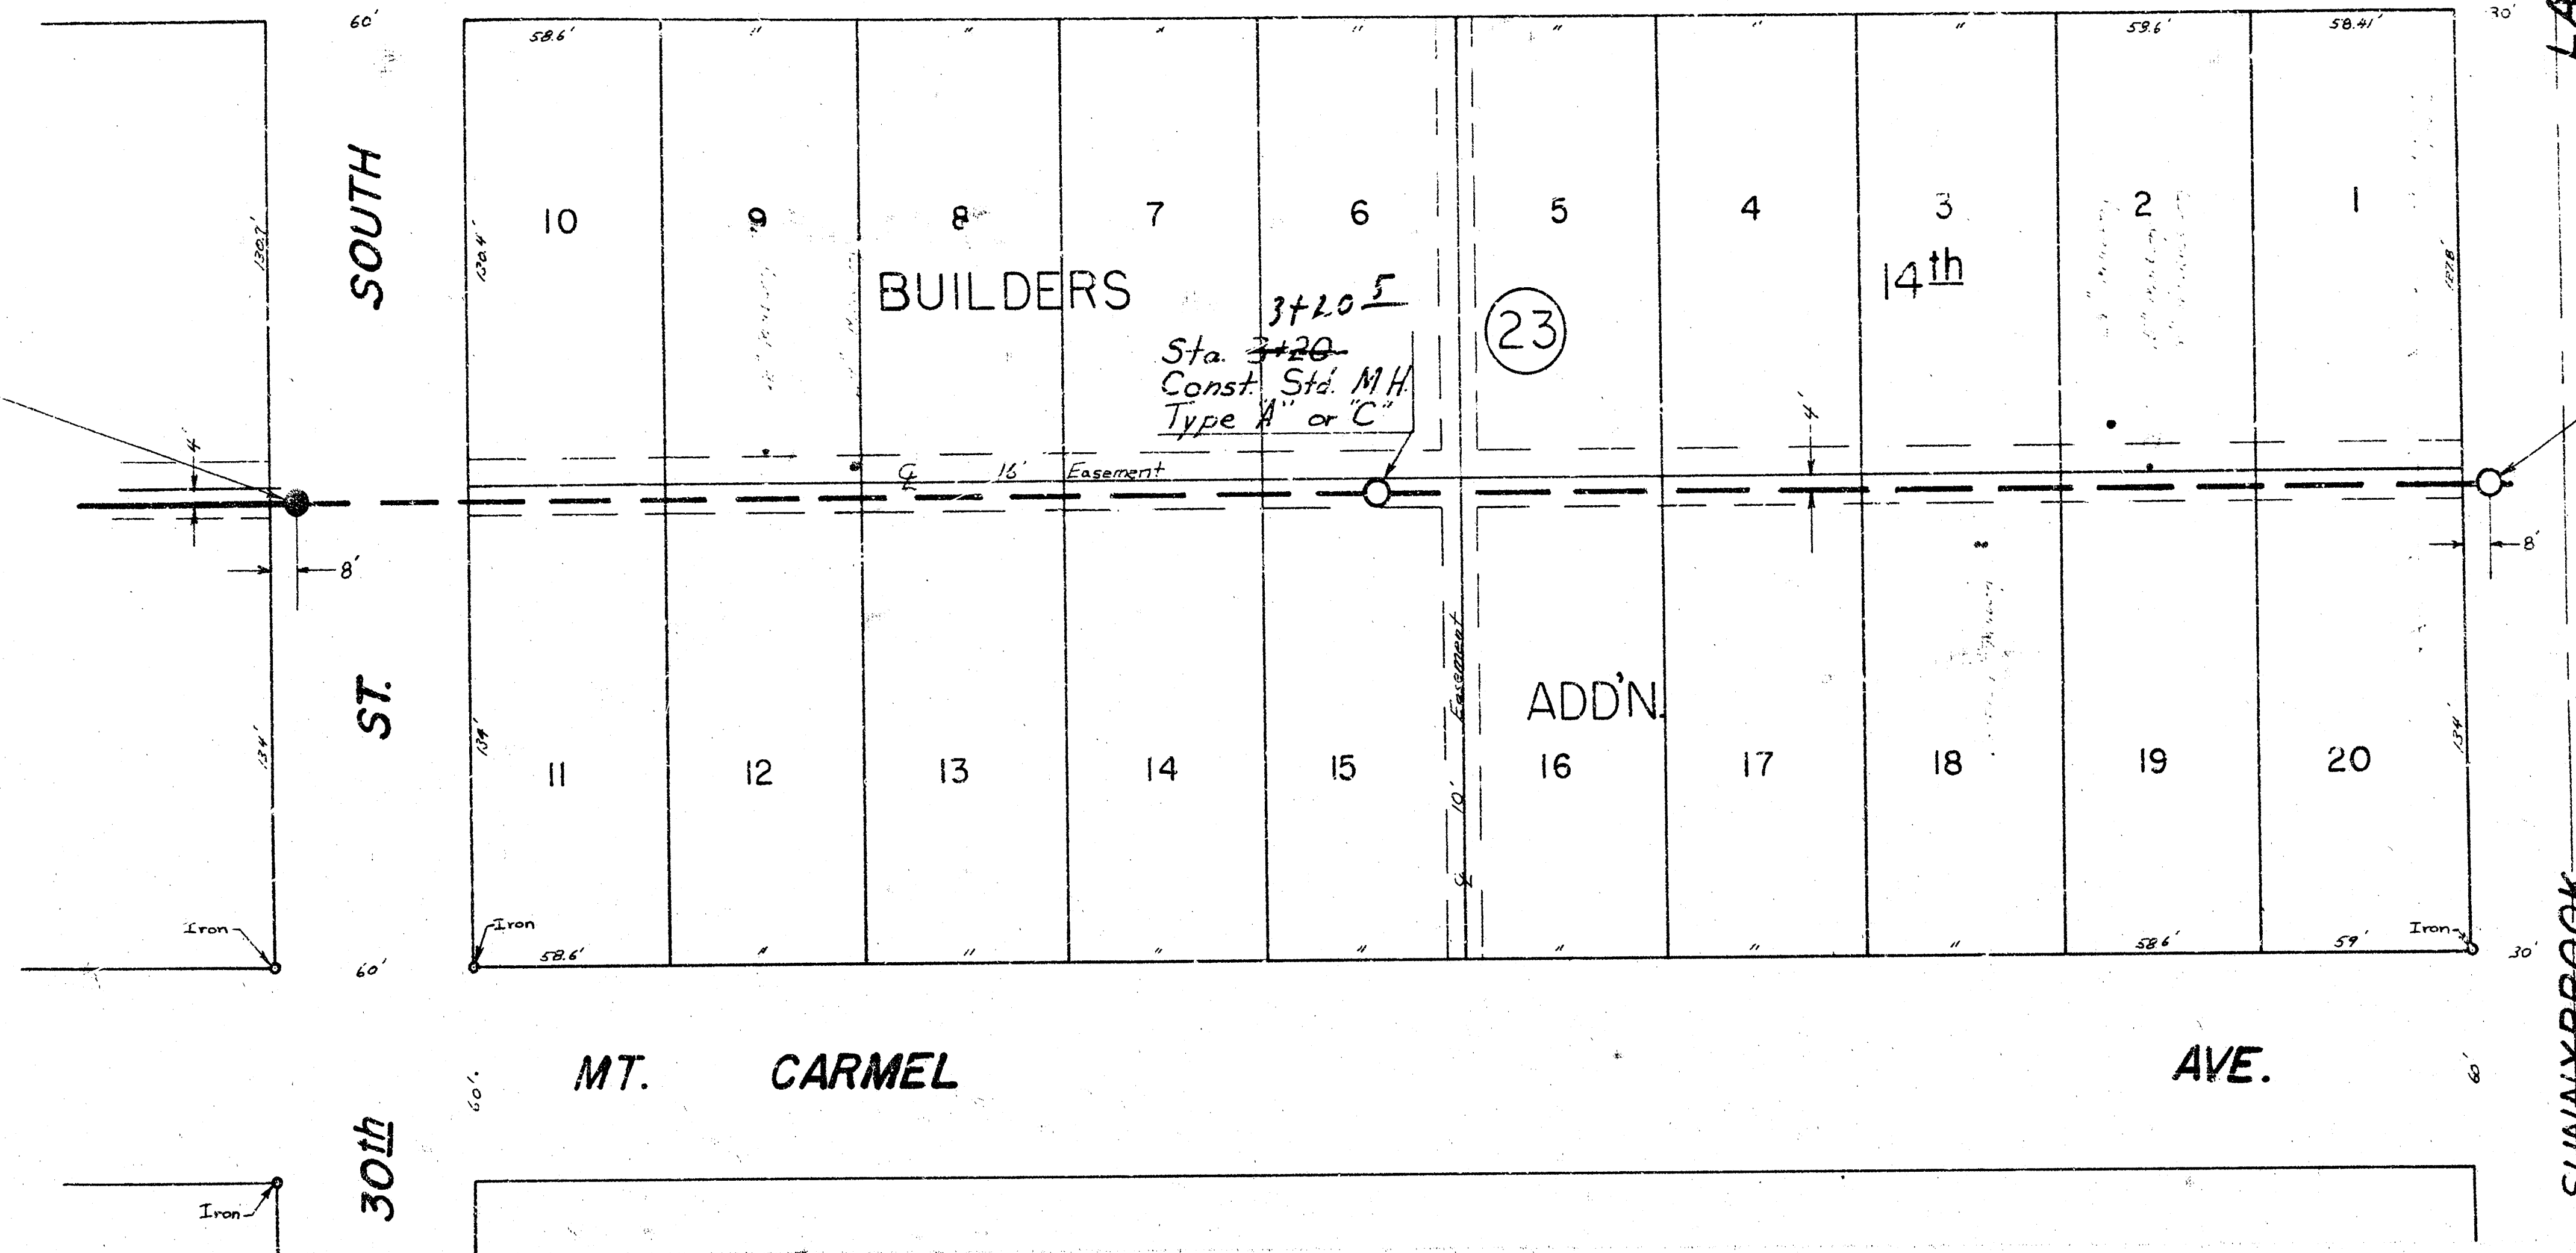

Sta. 0+00
Proposed M.H.
8" Stub N.
93.37 Flo

Sta. 3+20
Const. Std. M.H.
Type "A" or "C"

Sta. 6+45.8
Const. Std. M.H.
Type "A" or "C"
Install 8" Stub N.

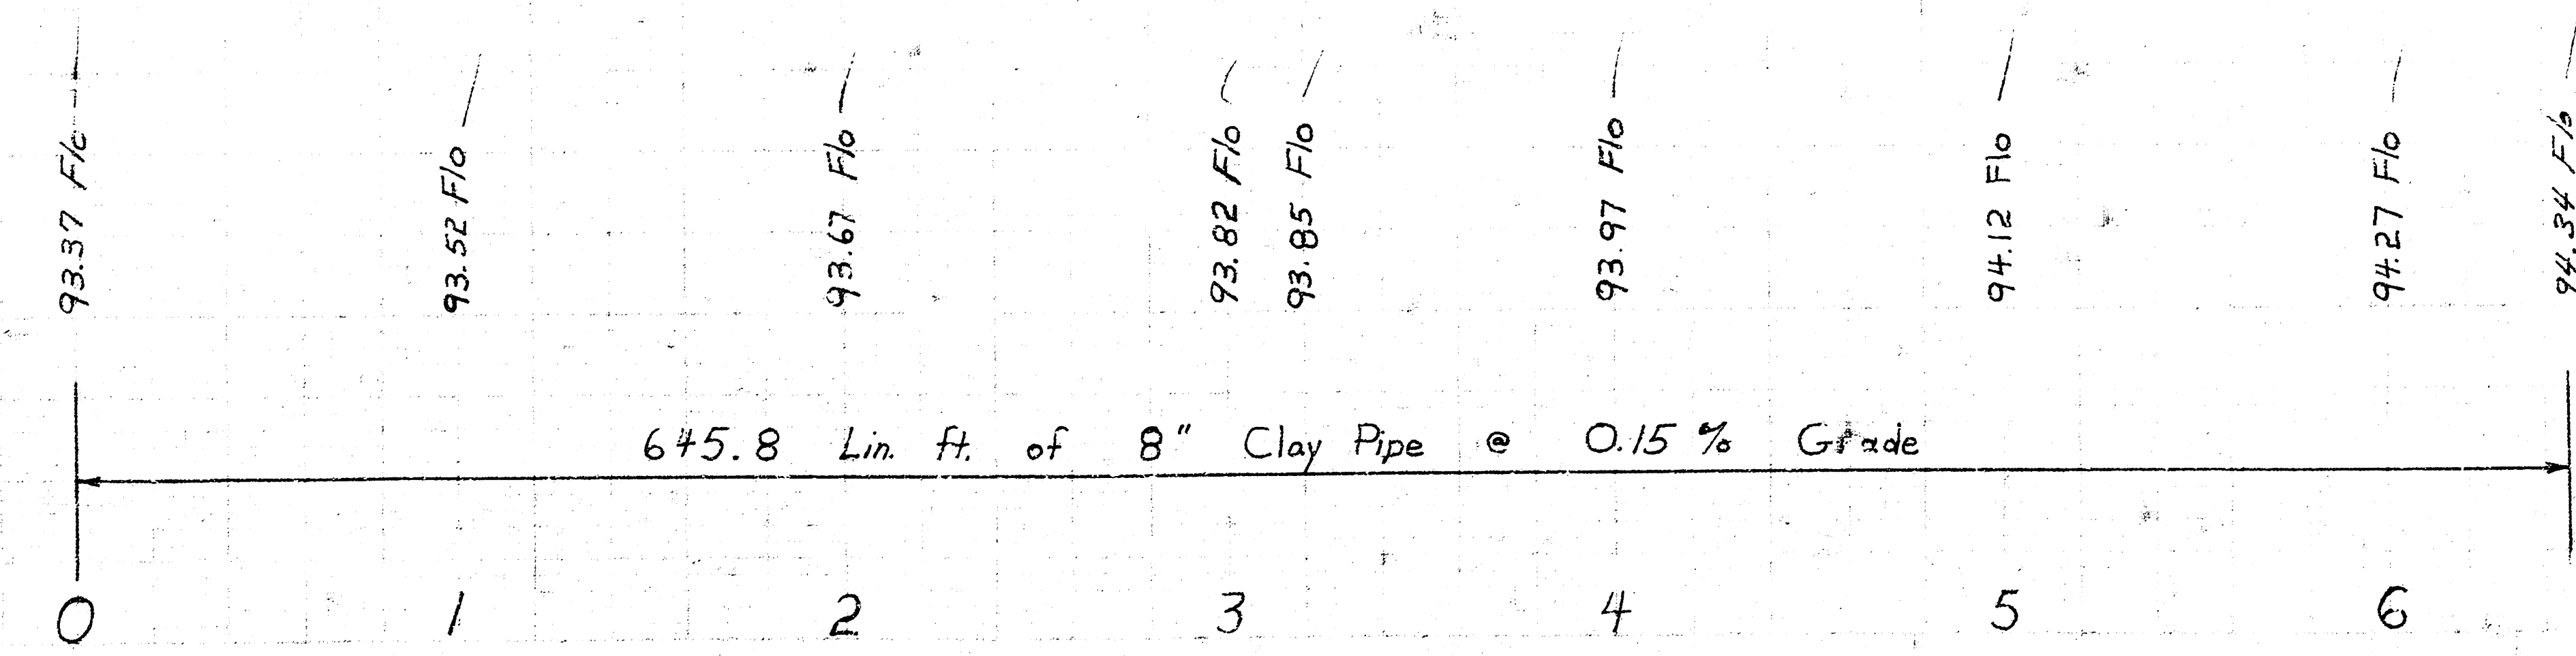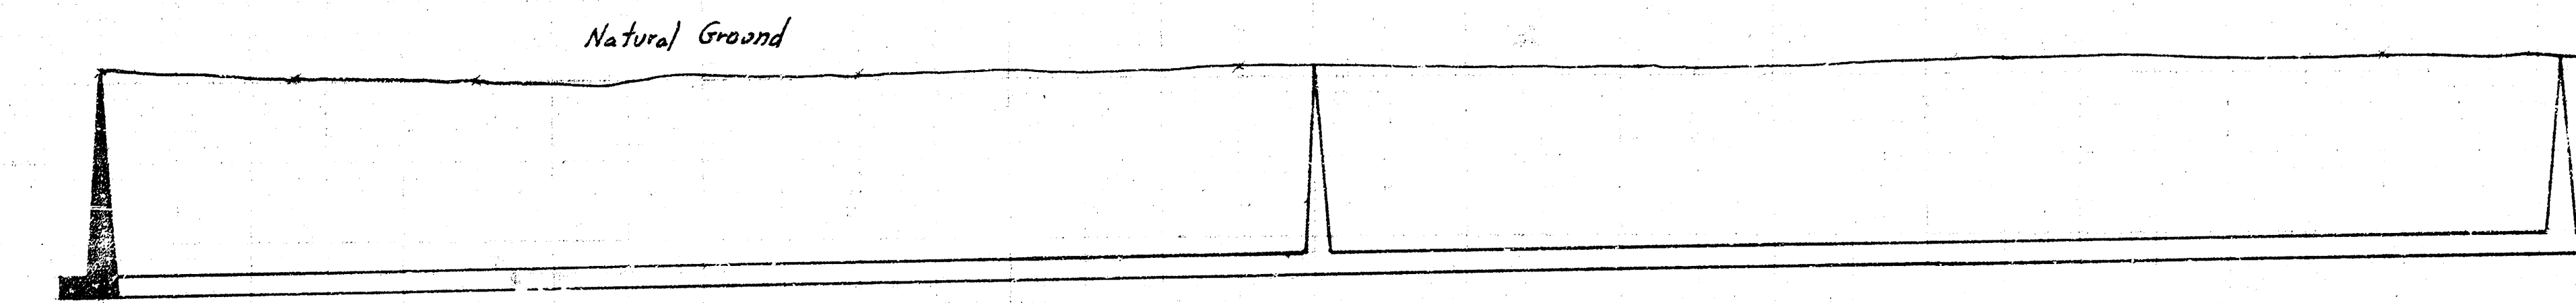

6+5.8 Lin. ft. of 8" Clay Pipe @ 0.15 % Grade



LAT. 133 S.S. NO. 22
CITY OF WICHITA, KANSAS
R. W. LINN CITY ENGINEER
PROJECT NO. DBKL 575033

14 8 5 2 1/4