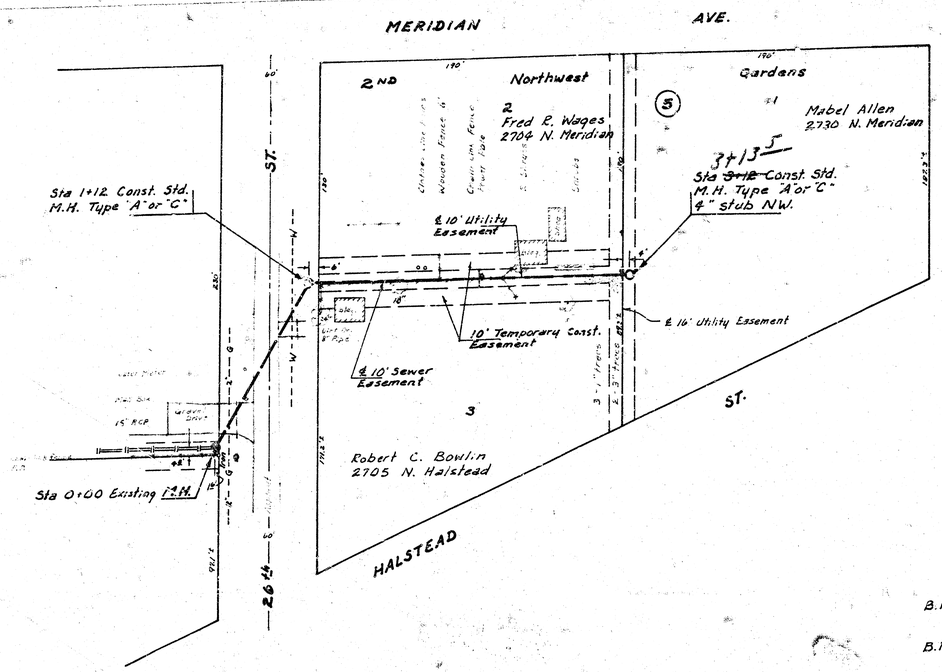

Plan Scale 1" = 40'
Profile Scale 1" = 40' Horz.
1" = 5' Vert.

NOTE:
Contractor shall give property owners affected by the construction of this project a minimum of 24 hours advance notice prior to the start of construction.

B.M. 127.50 NE. Side Power Pole, S. Side 26th 2nd Power Pole E. of Meridian

B.M. 127.29 City Std. Disc 36' W & 6' S. of ℄ of 25th St. No. & Meridian

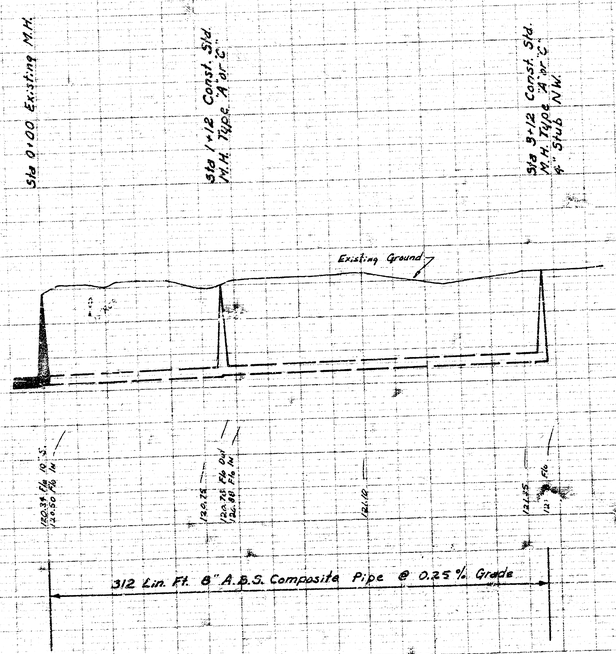

As built 9-14-77

LAT. 136 S.S. NO. 22
CITY OF WICHITA, KANSAS
R. W. LINN — CITY ENGINEER
DATE: June, 1977 PROJ. NO. DBKL577021

PLATE 1-SINGLE PLAN AND PROFILE-FULL LOAD

14 10 4 01 41