



Survey of Kansas Notebook K-24
 Surveyed by
 Date Nov 1935

B. M. 95.76 Std. S.E. Cor. 31st & Seneca

NOTE
 LINE FROM 0+00 TO 0+42 IS A CUT
 SEWER BUILT BY PRIVATE CONTRACT.
 LINE FROM 0+42 TO 1+60 IS A
 PRIVATE SEWER.

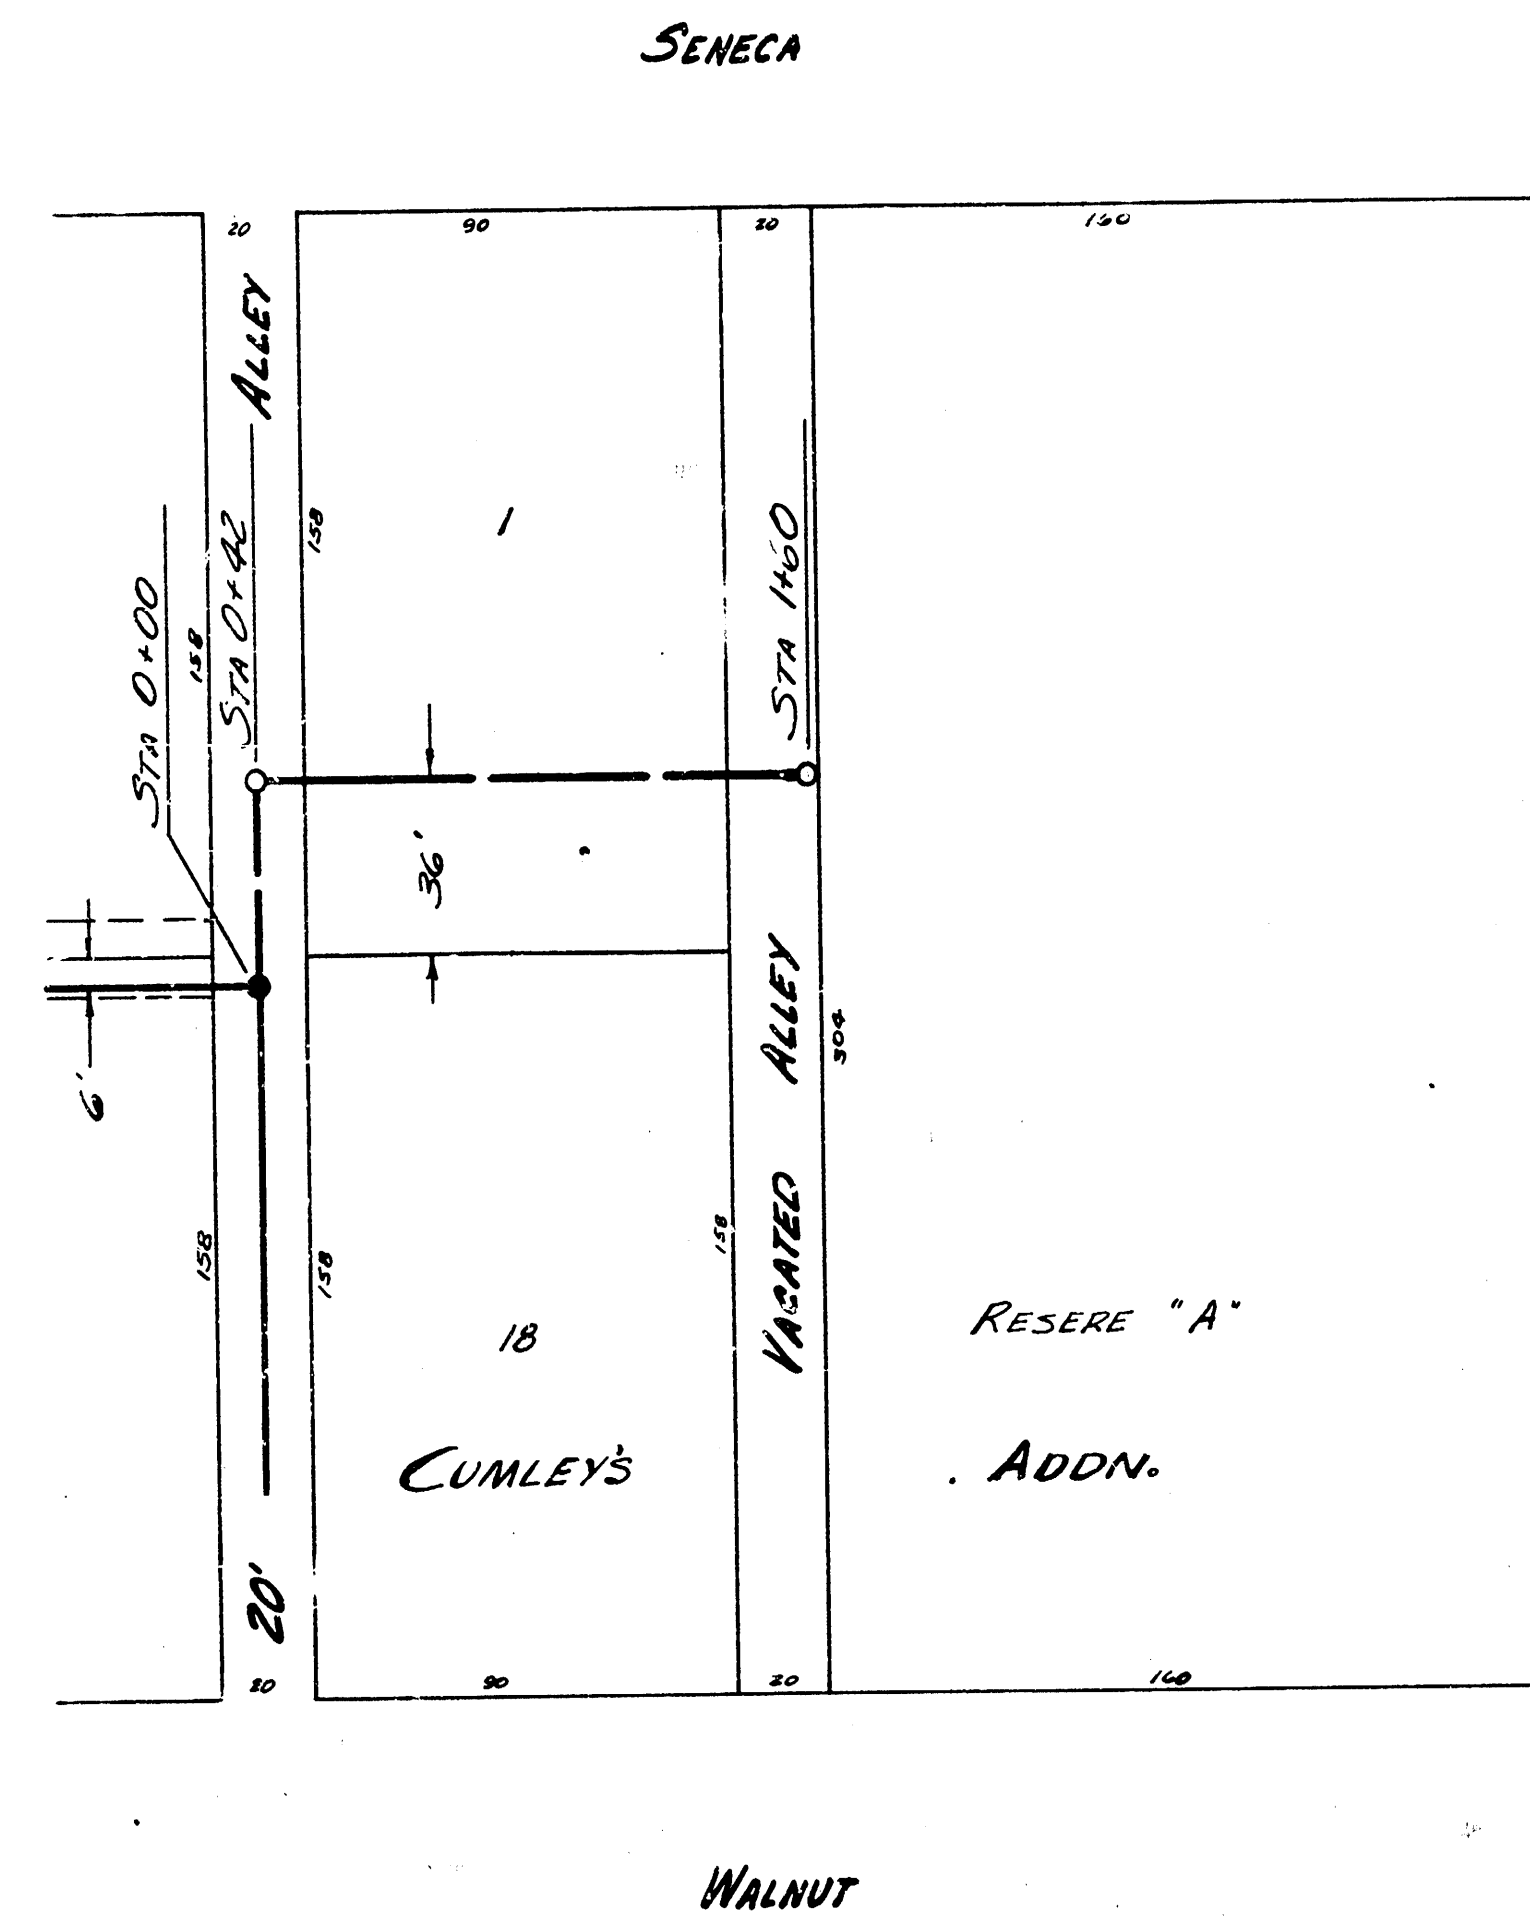

PLAN SCALE 1"=40'
 PROFILE SCALE 1"=40' HOR. 1"=4' VERTICAL

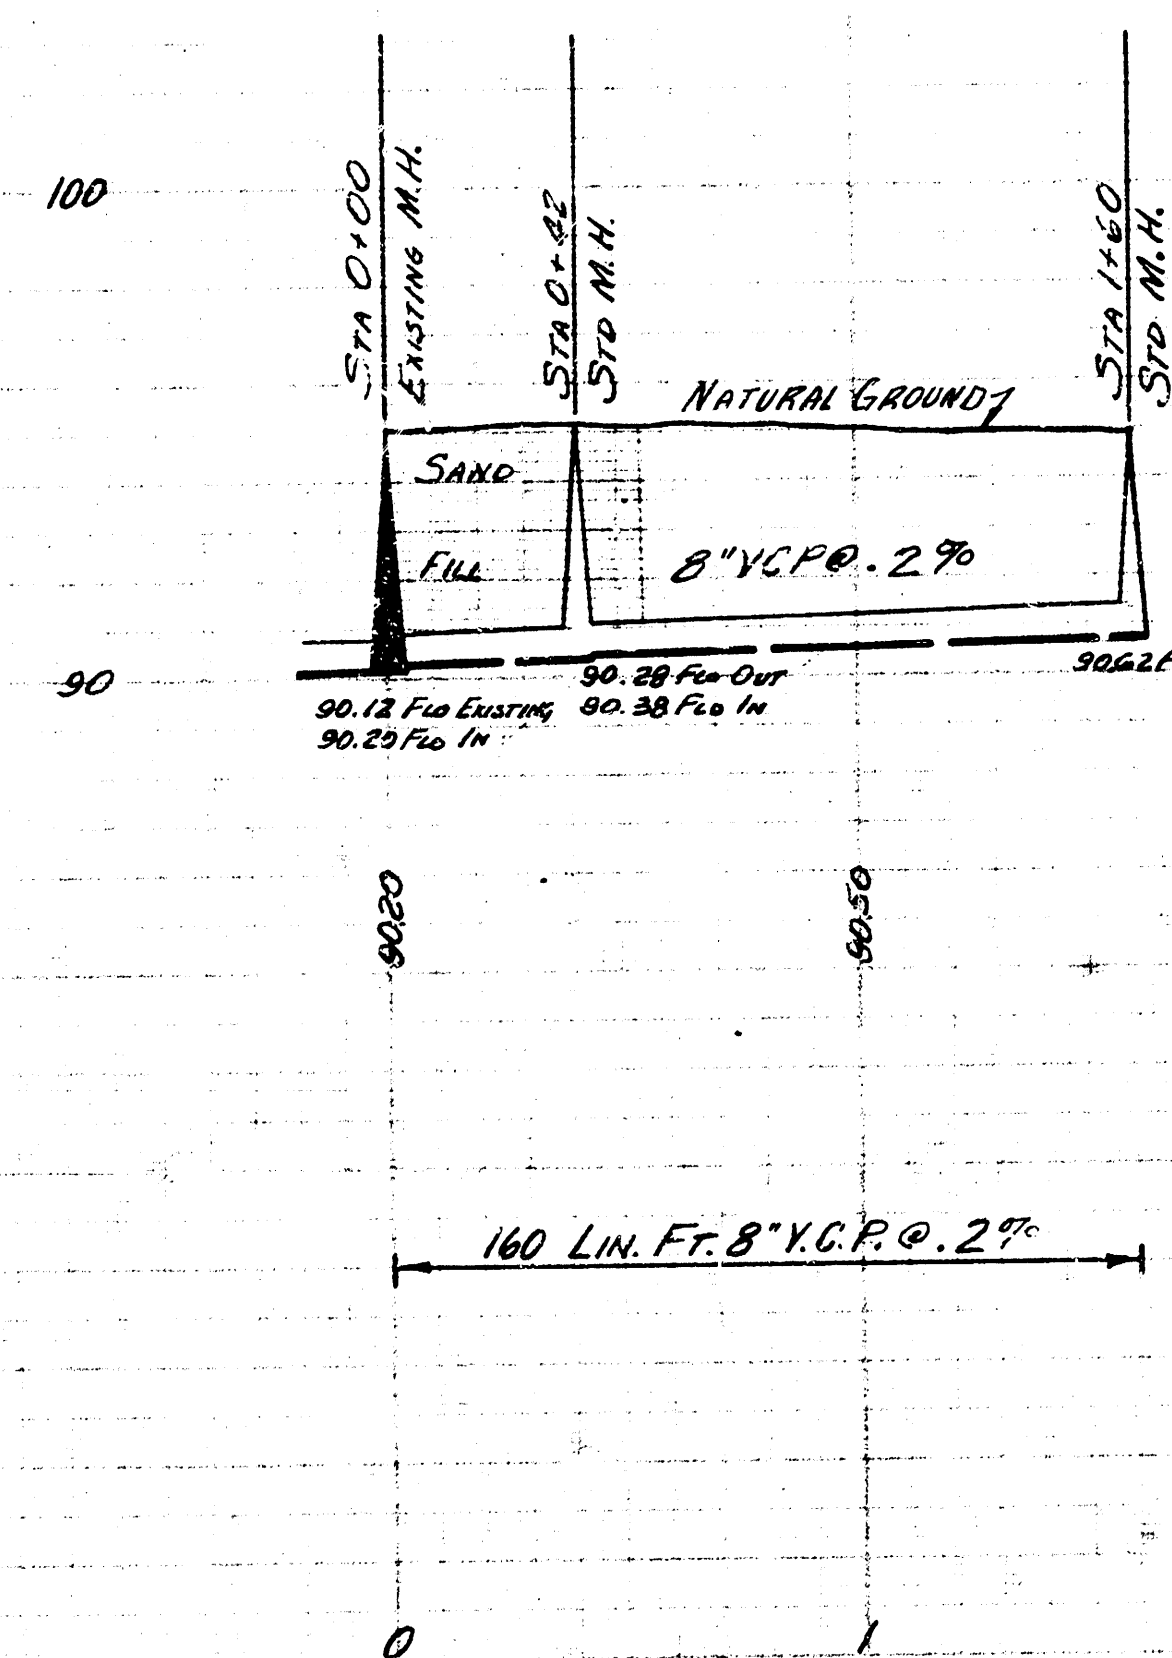

EXT. LAT. 9 SAN. SEWER 22
 CITY OF WICHITA, KANSAS
 B.E. SMITH CITY ENGINEER
 Nov. 1935 PRIVATE CONTRACT