


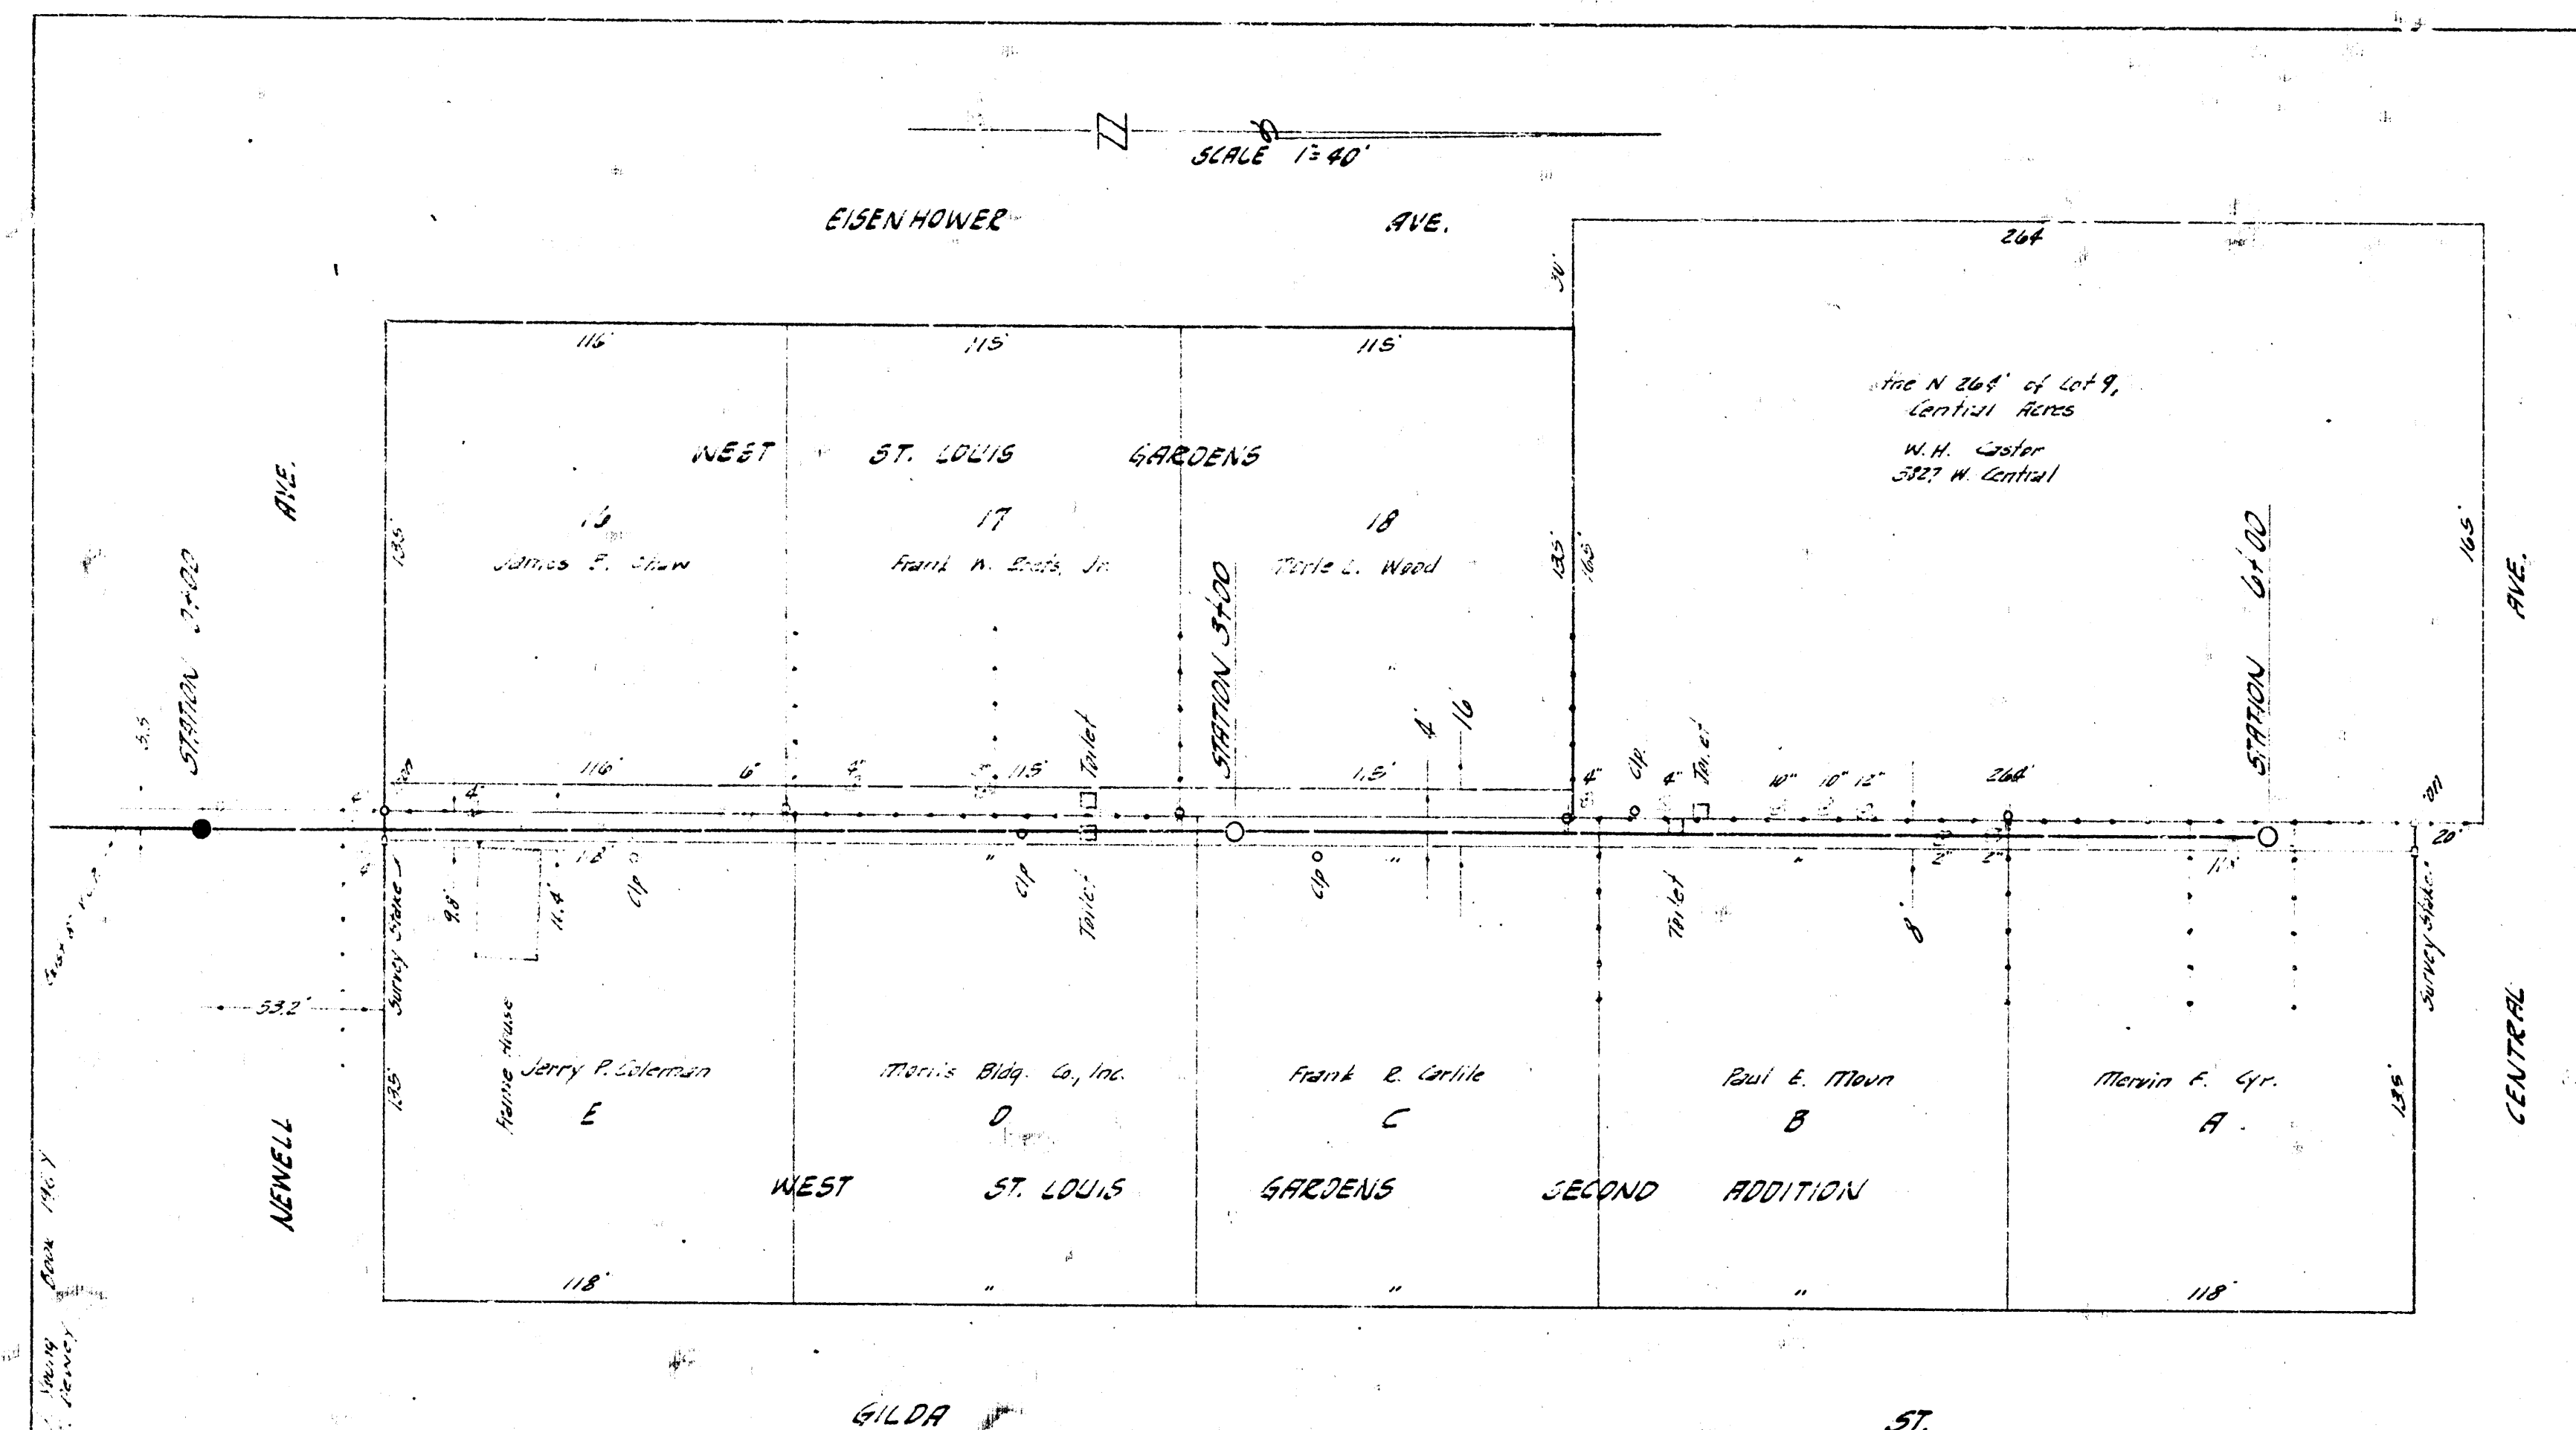

BASELINE & STATIONING = 3" E PROPERTY LINE
 B.M. 121.99 - AG GREEN 55 H.P. 55 NEWELL, 140' N OF GILDA

PLAN SCALE 1"=40'
 PROFILE SCALE 1"=40' HOR, 1"=4' VERTICAL

