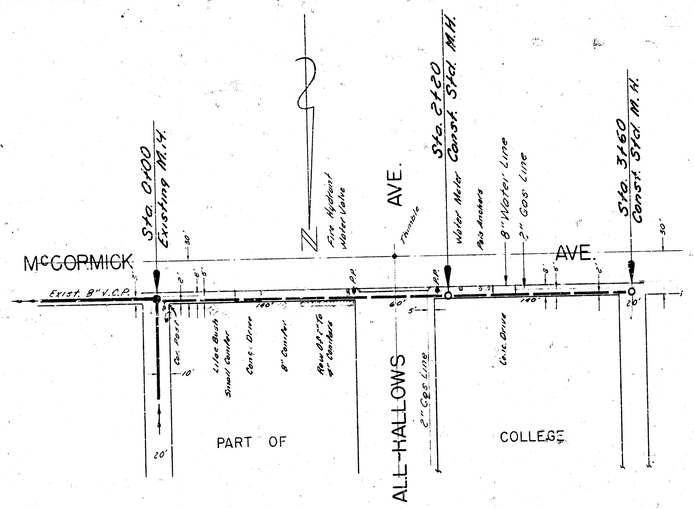

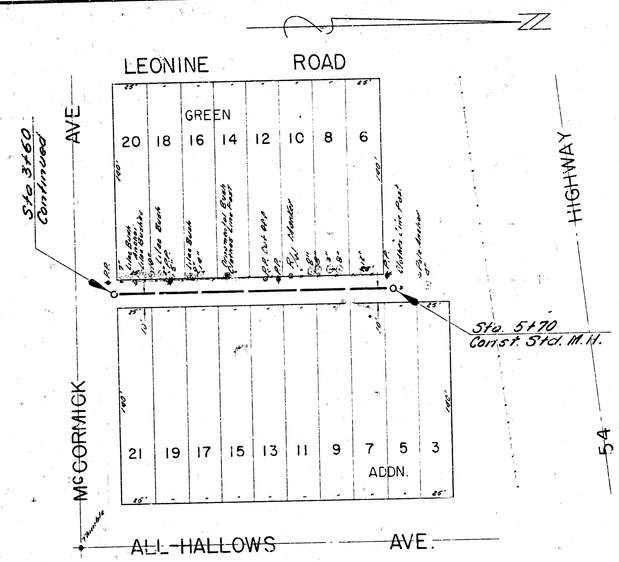

NOTE TO CONTRACTOR
Herrick Concrete Drives.
New Sewer 1'N. of & 0.0' 0+00 M.H., Shade Floor To Drain.

PLAN SCALE 1" = 40'
PROFILE SCALE 1" = 40' HOR.
1" = 4' VERT.

B.M. 113.47 SPIKE IN P.P. N.E. COR. SHERIDAN & McCORMICK

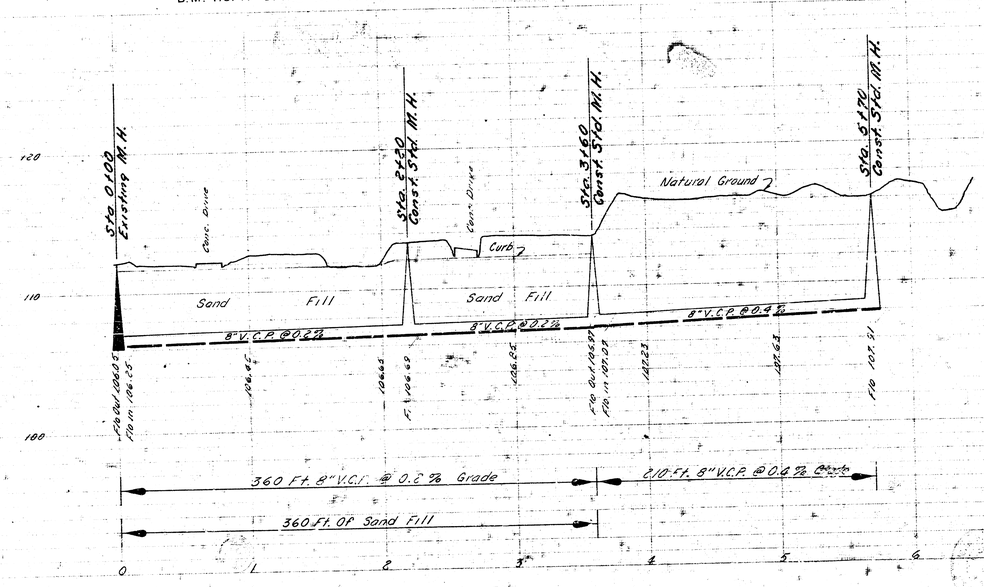

LAT. 81-S.S. NO. 22
CITY OF WICHITA, KANSAS
B.E. SMITH, CITY ENGINEER
PROJ. NO. C22-14 DATE June 1962