



BM 129.81 City std. 320' S. of C of 33rd St. North going east & 22.0' E. of C of Arkansas
 BM 130.51 Top East Curb of Arkansas at South line of 32nd St. North being 29.5' south of thimble on C

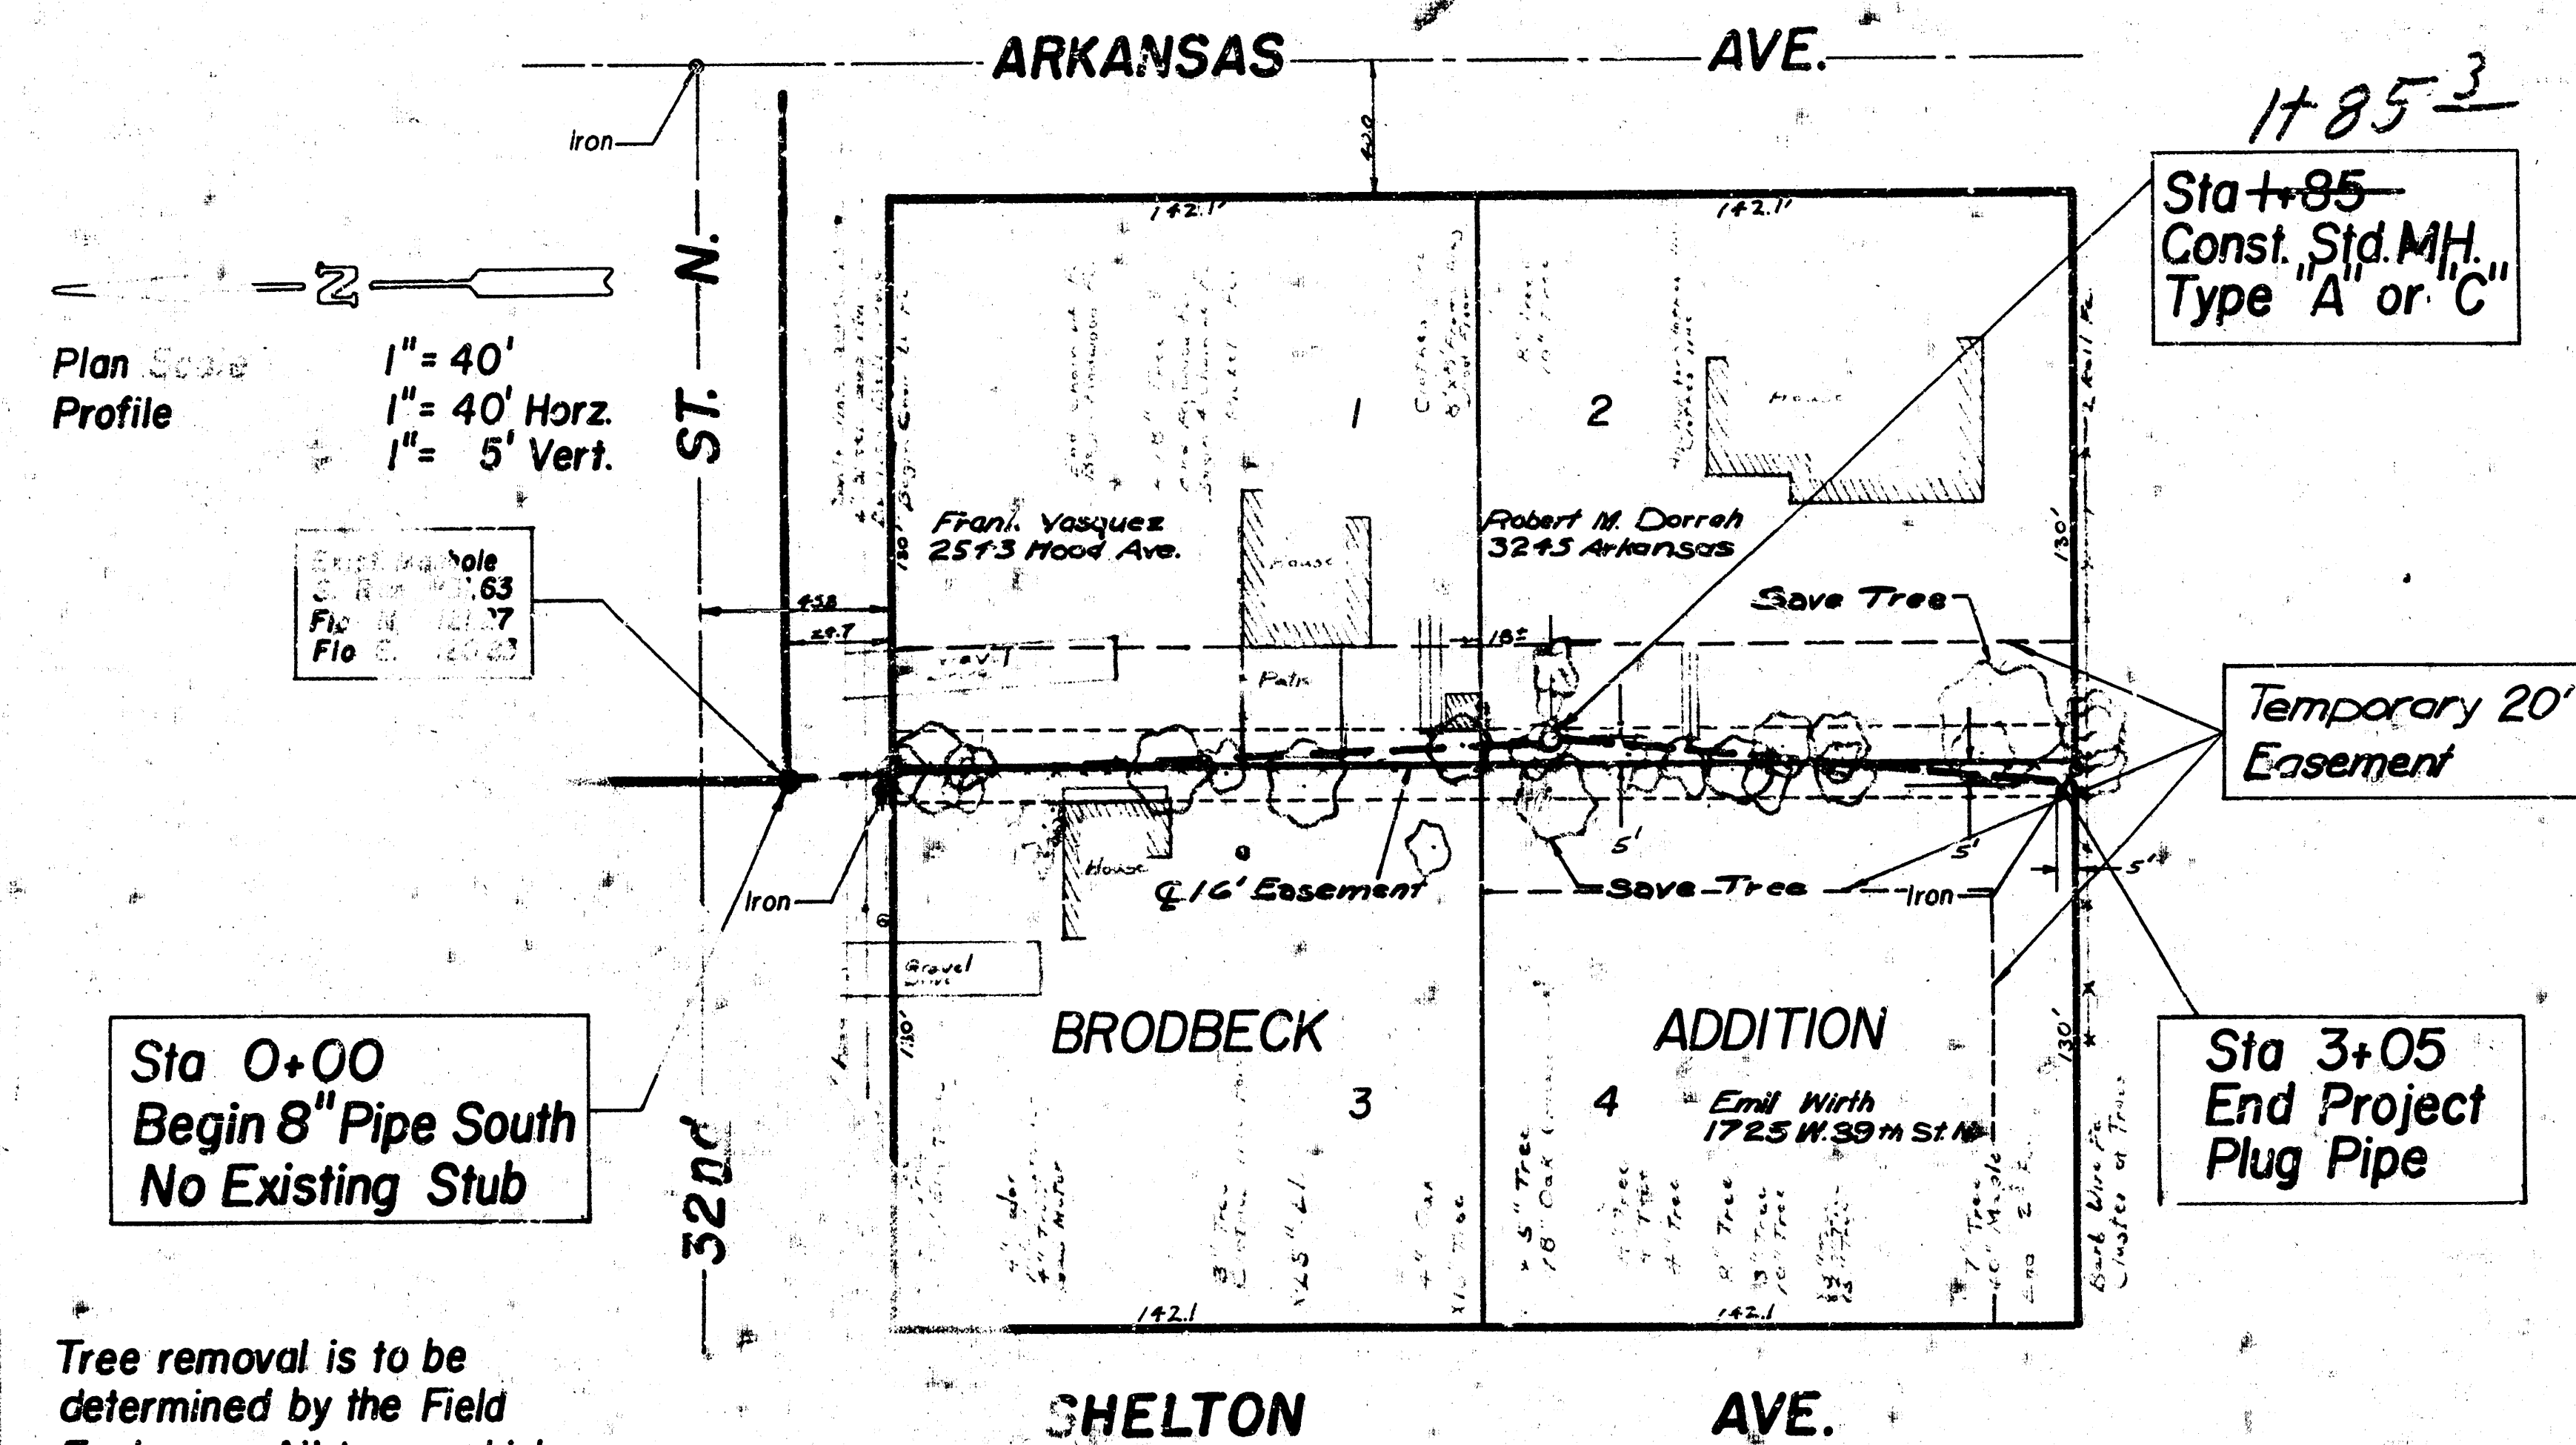


Tree removal is to be determined by the Field Engineer. All trees which can be saved will be saved.

Field Engineer to make 'ties' to all irons. Irons disturbed or destroyed are to be replaced.

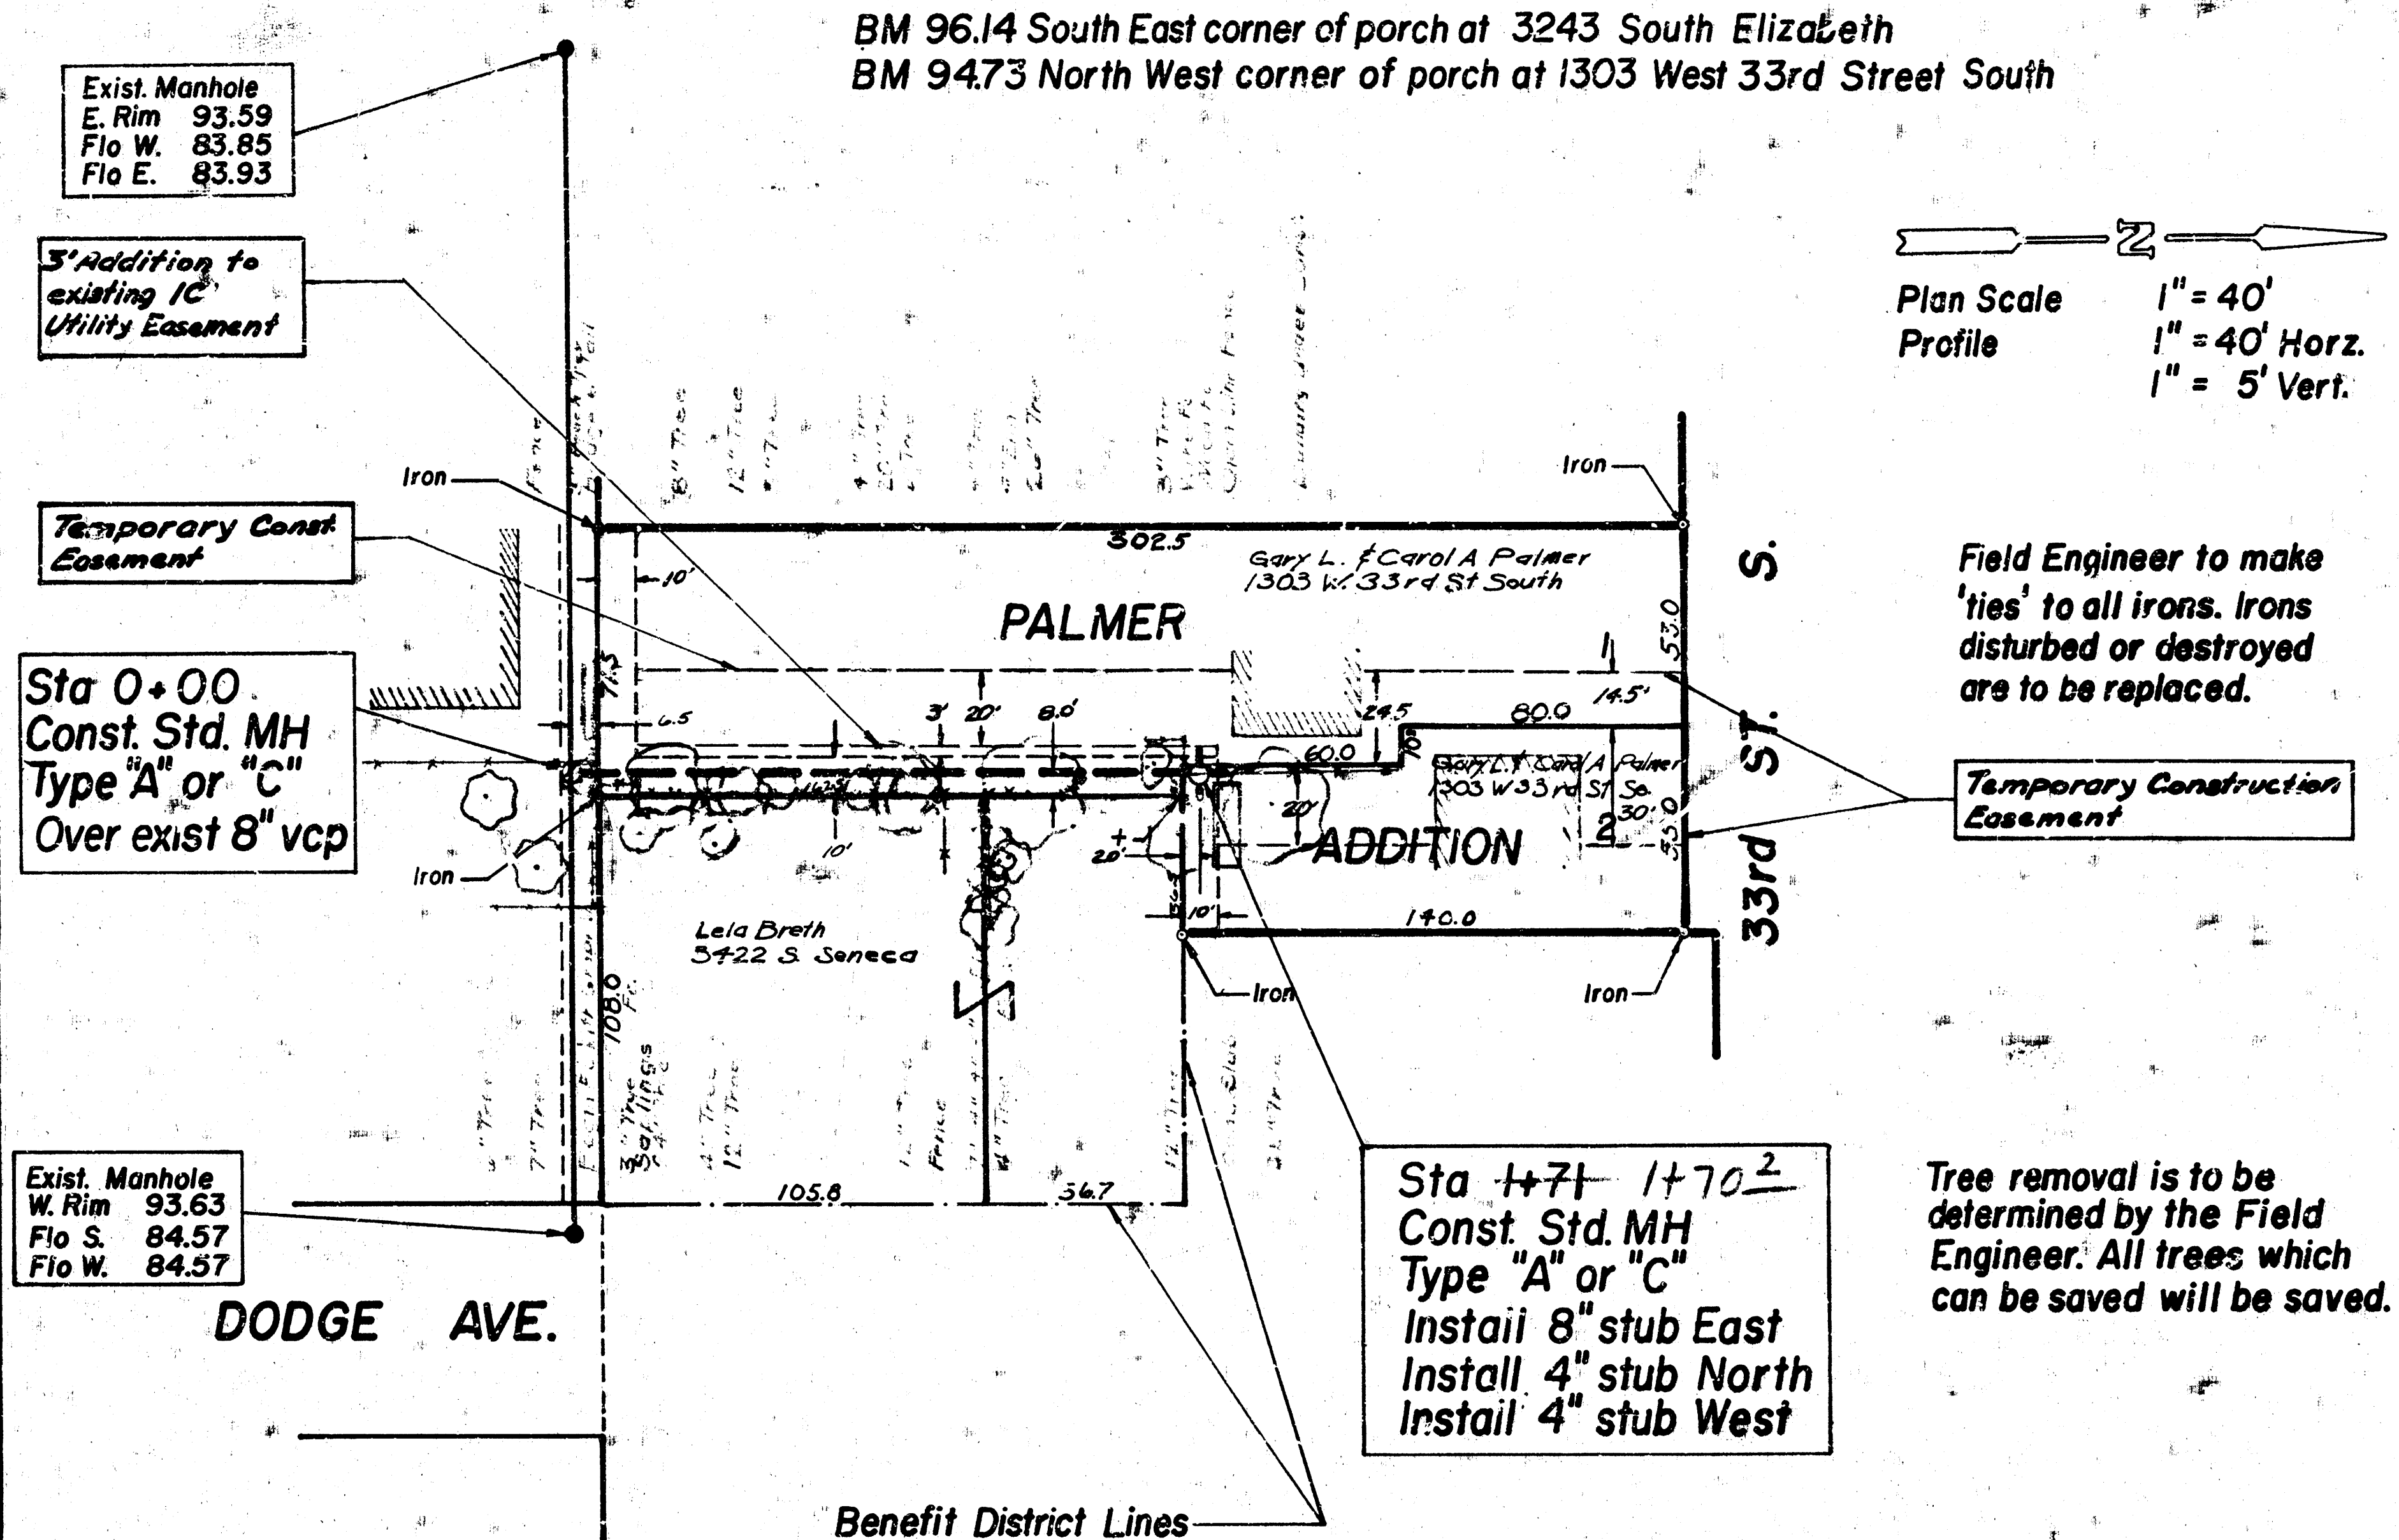


Field Engineer to make 'ties' to all irons. Irons disturbed or destroyed are to be replaced.

Tree removal is to be determined by the Field Engineer. All trees which can be saved will be saved.

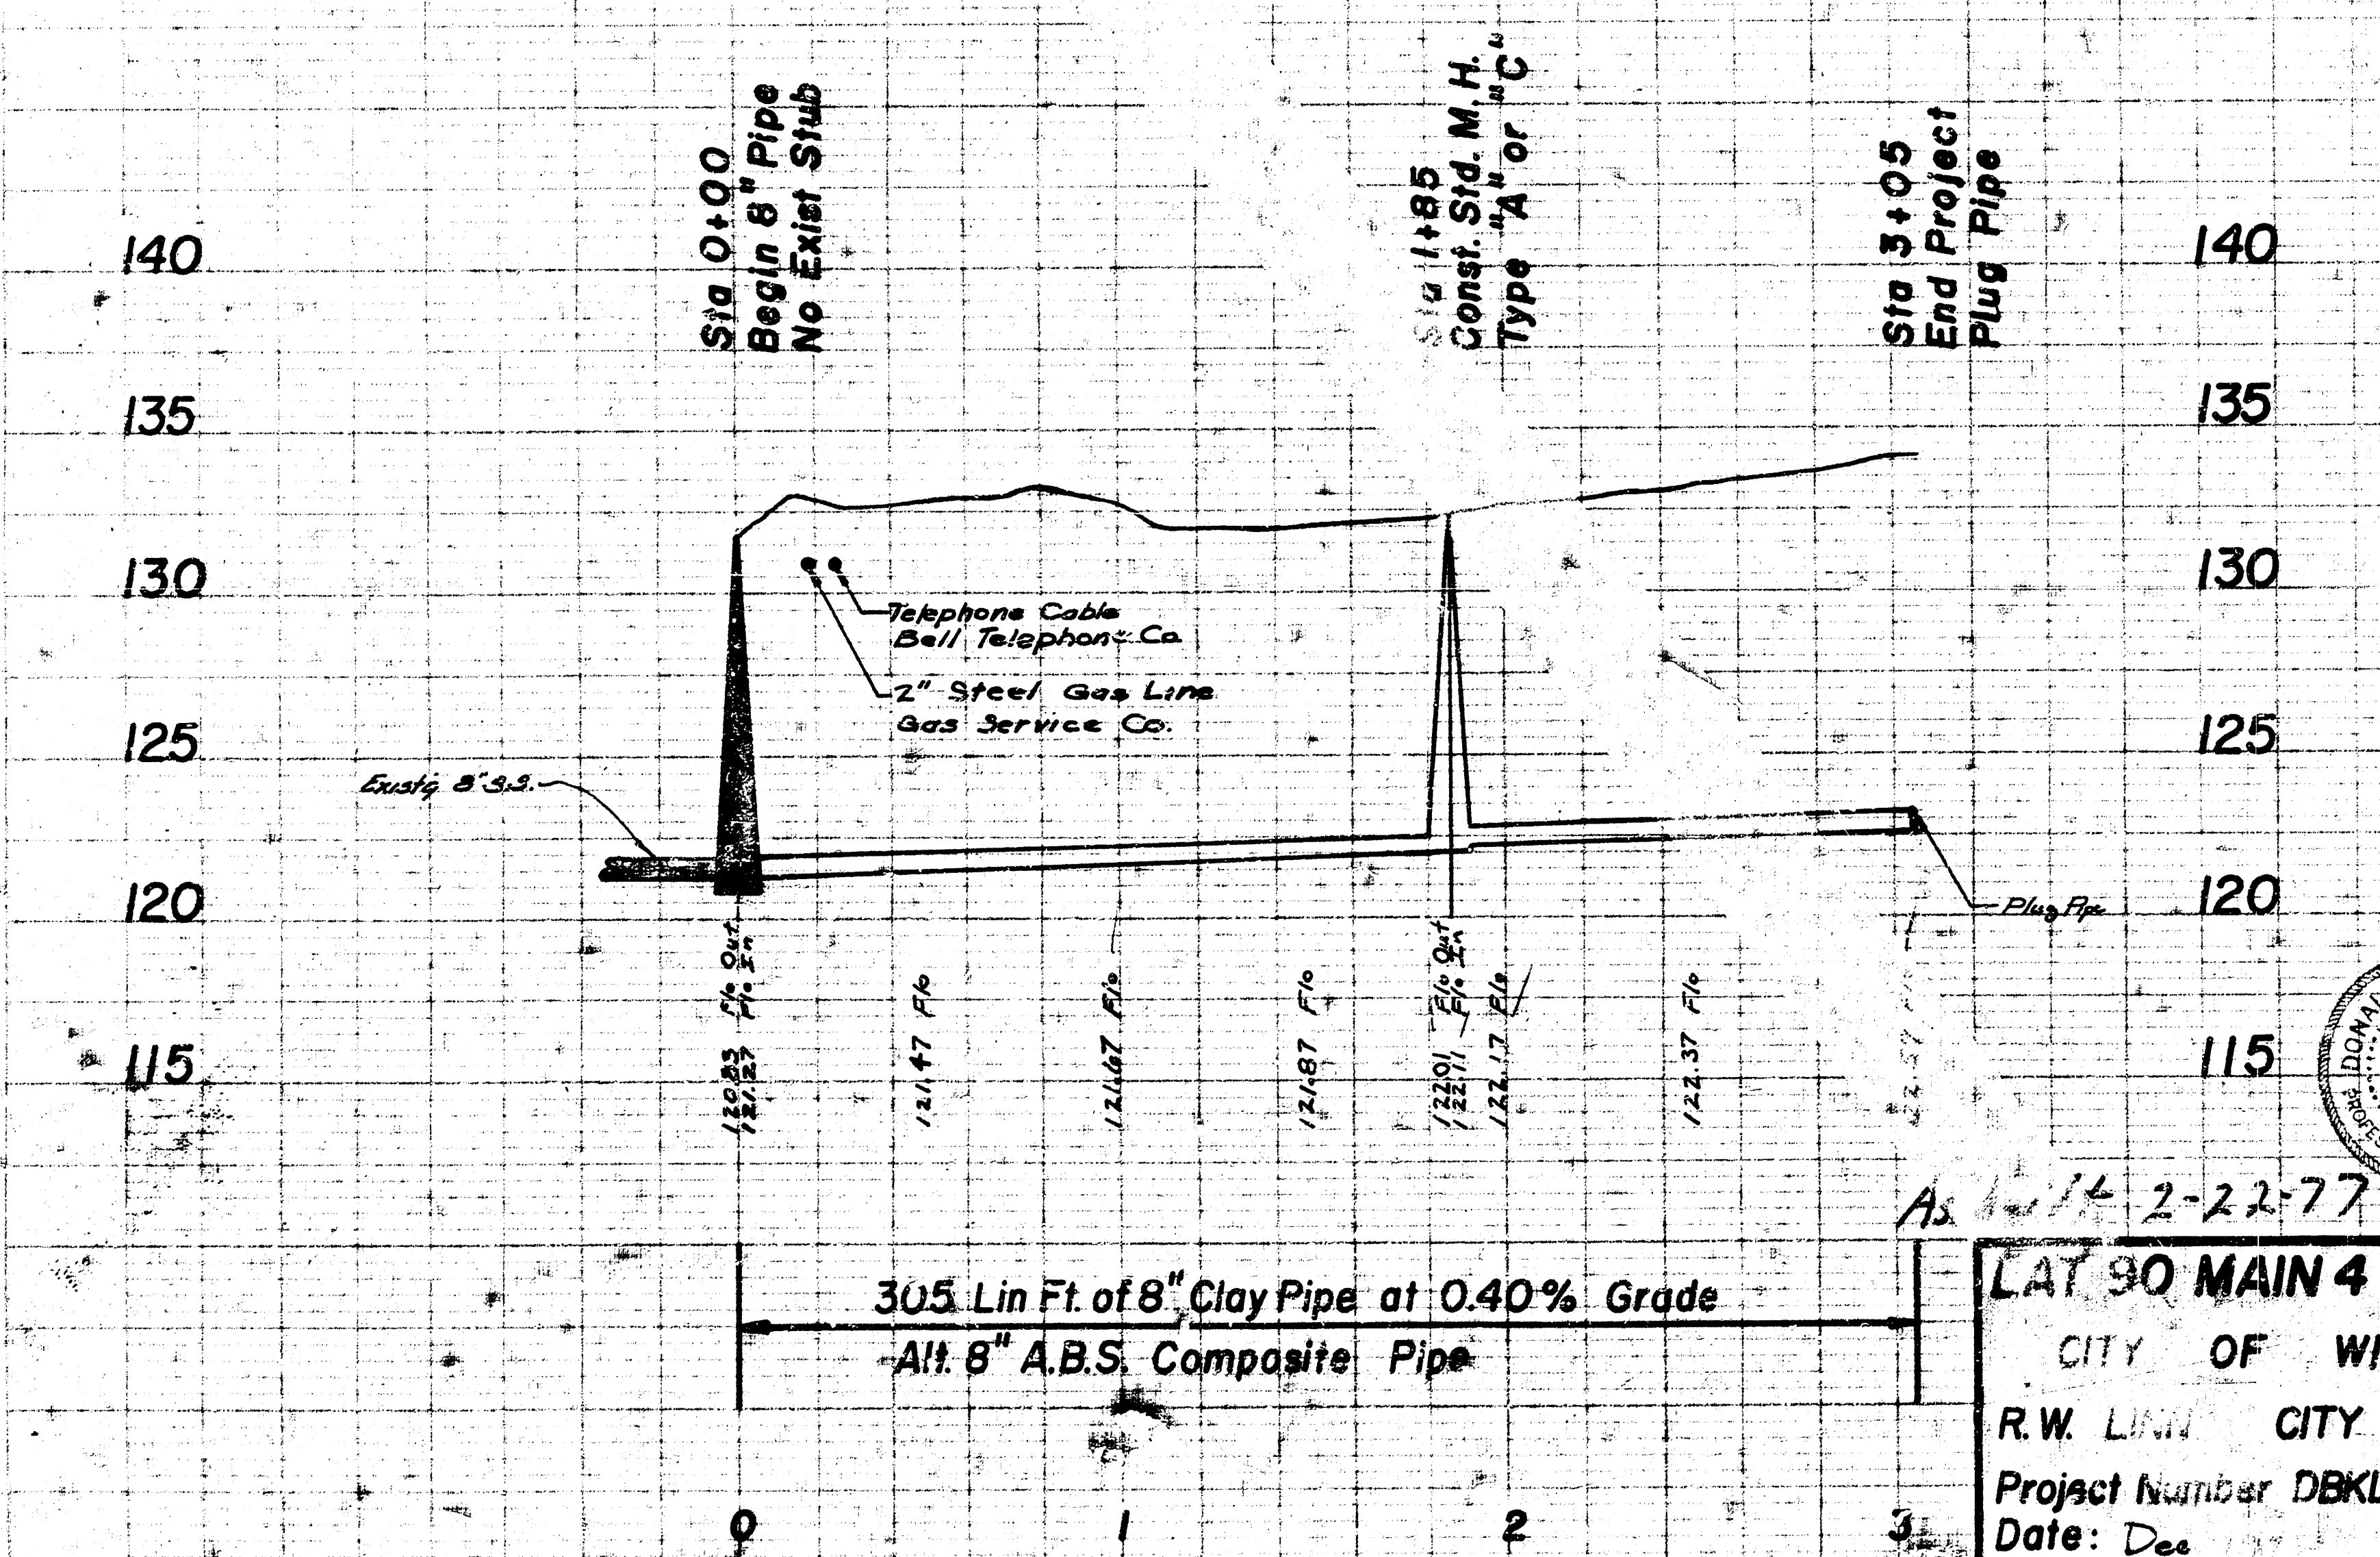

LAT 90 MAIN 4 SS 23
 CITY OF WICHITA
 R.W. LINN CITY ENGINEER
 Project Number DBKL576057
 Date: Dec

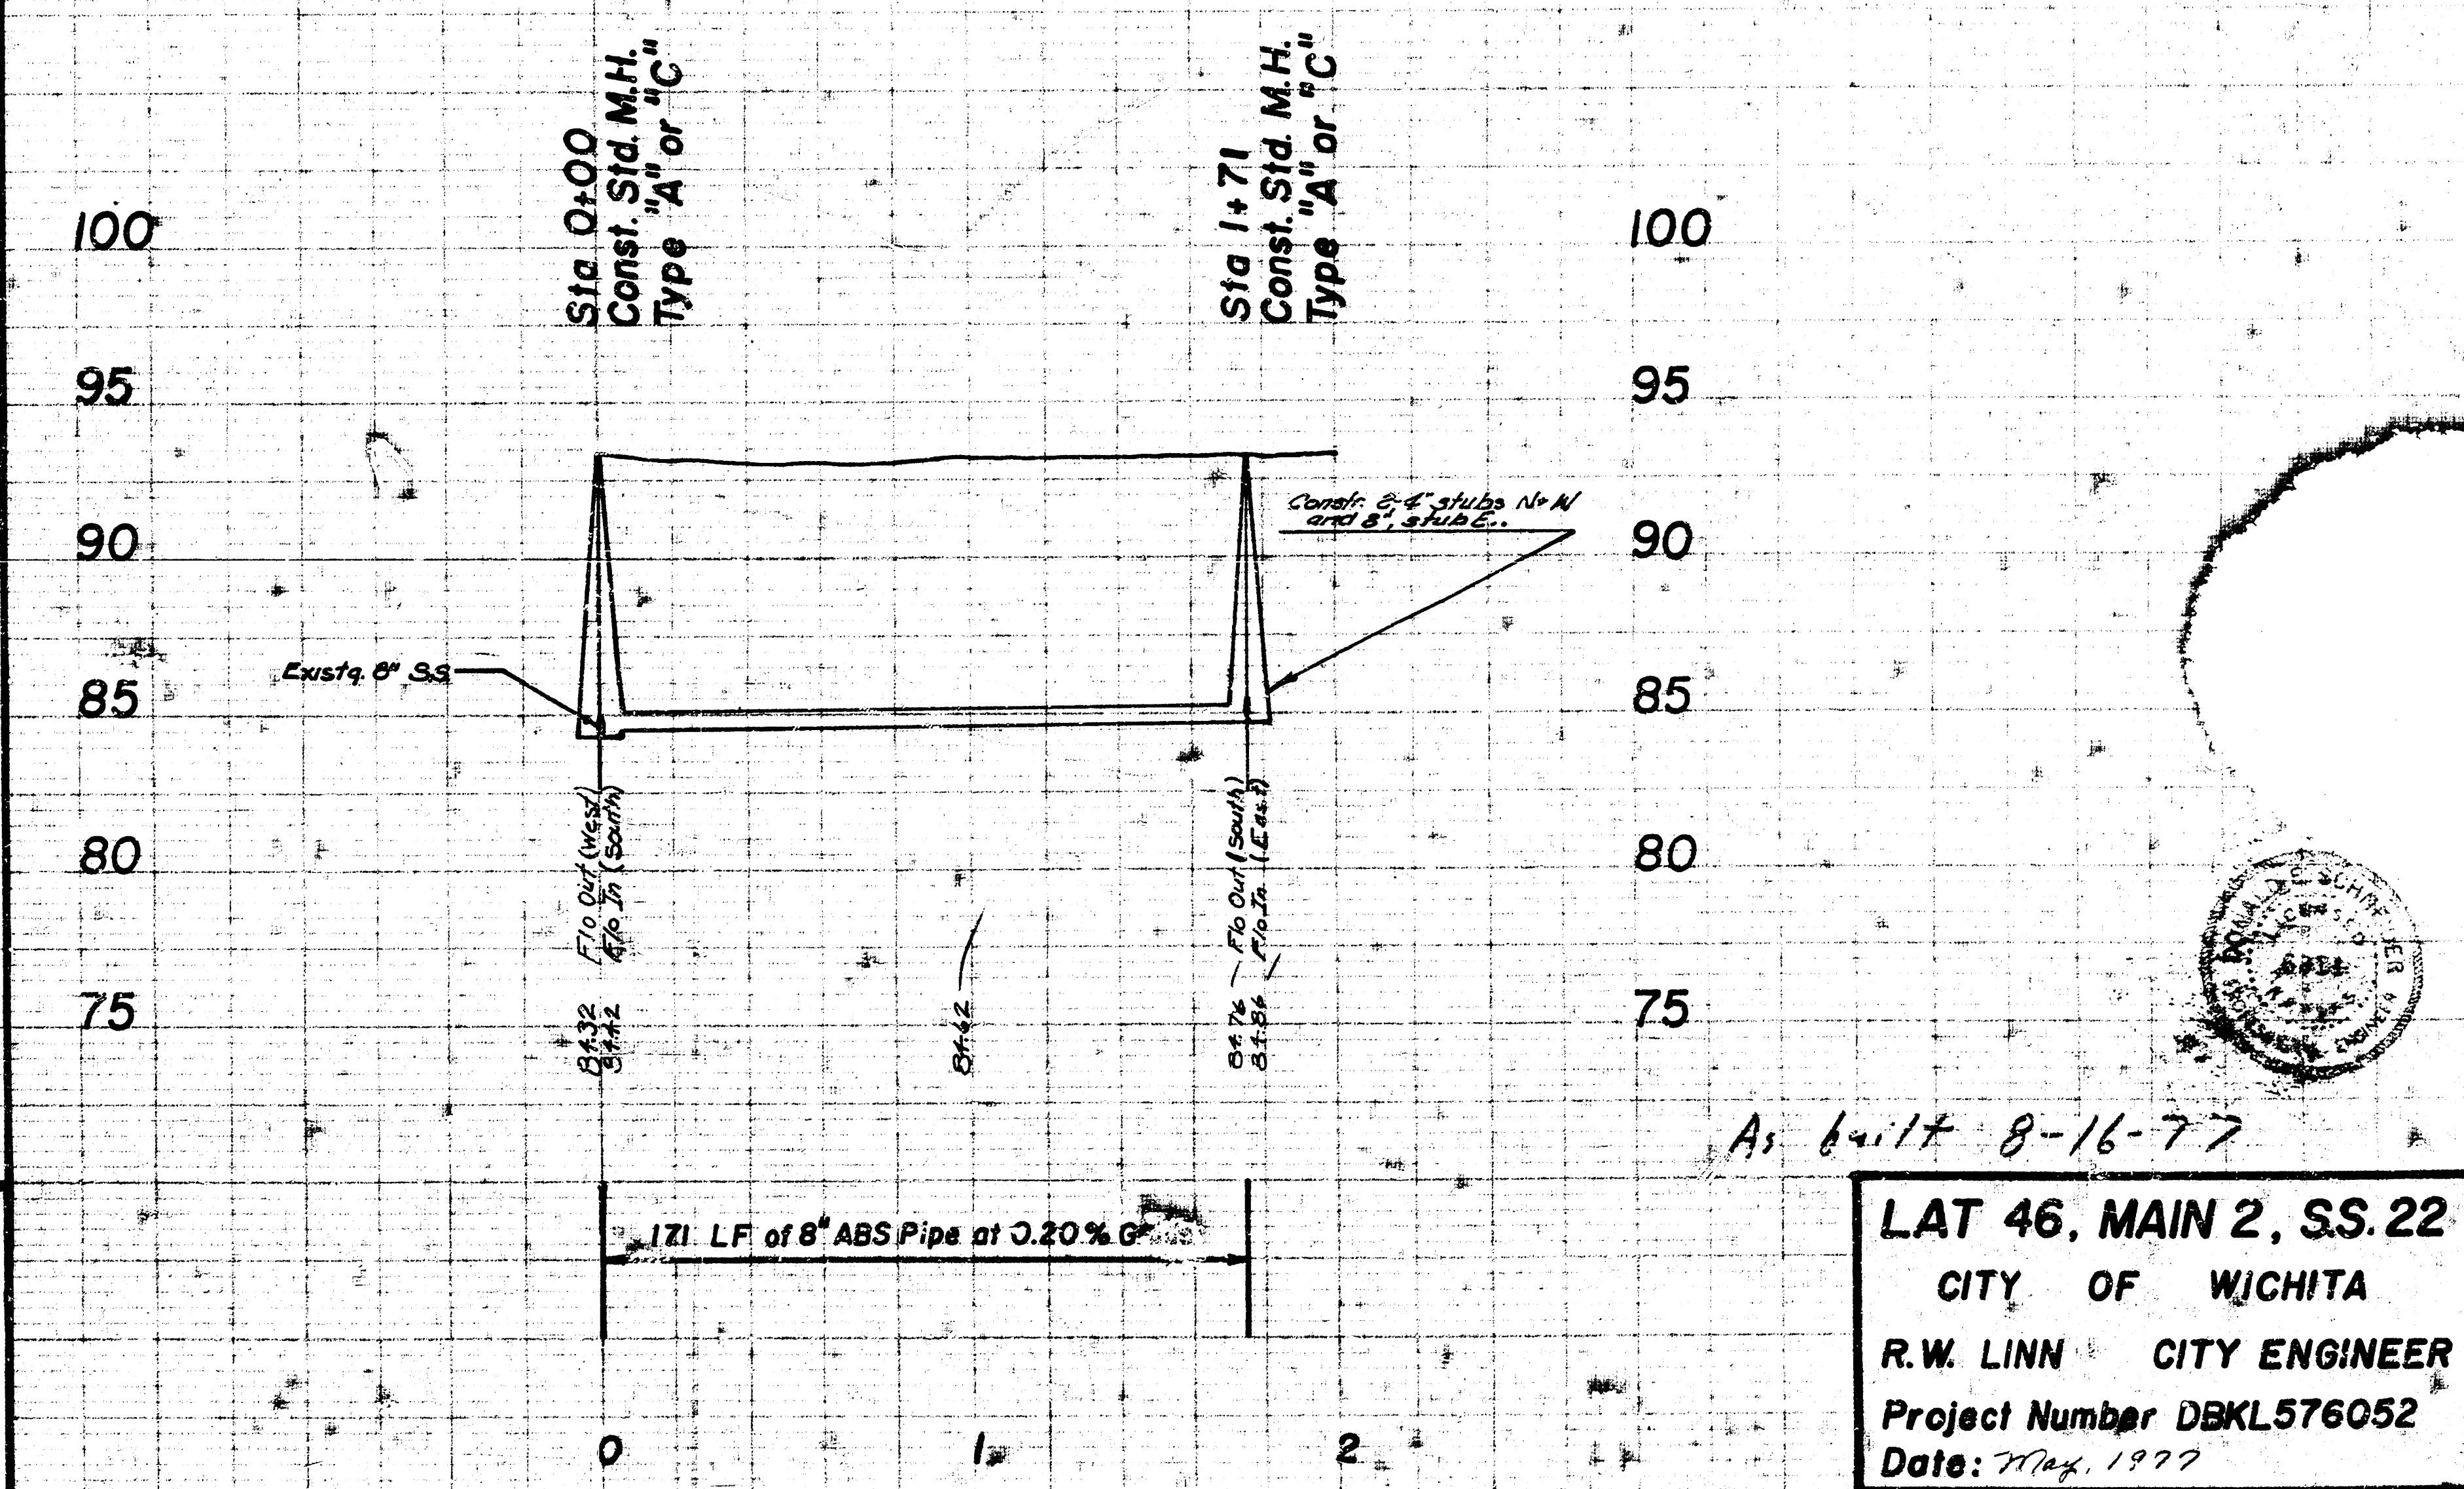

LAT 46, MAIN 2, SS 22
 CITY OF WICHITA
 R.W. LINN CITY ENGINEER
 Project Number DBKL576052
 Date: May, 1977