

SENeca

EXCEPTION

PAWNEE

WALNUT

ST.

M & B ADDITION

PPCo. ADDITION #2

1

2

31



1. A saw cut of at least one-half the depth of existing surface courses or one-fourth the depth of the existing total pavement thickness shall be provided at locations where proposed construction or reconstruction of the existing surface or pavement or which partial removal of that surface or pavement is required. Sawed joint to facilitate removal within 3 feet (3') of existing joint shall be permitted and required. The limits of removal shall extend to the existing joint. Such saw cuts will not be paid for directly and this cost shall be considered as subsidiary to the removal of the surface or pavement.
2. Rubble from the removal of miscellaneous structures and excavations or excavations shall not be disposed of on sites to be provided by the Contractor. These sites shall be approved by the Engineer as to suitability, appearance and site location. Locations that, in the opinion of the Engineer, will leave an unsightly appearance will not be approved.
3. The Contractor shall be responsible for preserving property irons. The Contractor will be required to re-establish any property irons which are damaged or destroyed by his excavation operation or to have them re-established by a licensed land surveyor or a licensed professional engineer in accordance with state laws.
4. Pavement removal and/or replacement will be measured and paid for on the linear foot basis as measured along the center line of the sewer regardless of width or thickness. Minimum limits of such pavement removal and replacement shall be one foot beyond the limits of the excavation made for the sewer or the structure, except where the lines of excavation are within the limits of the existing structure. The limits of removal shall be extended to the joint. Removal and replacement of existing pavement shall conform to the applicable sections of the City of Wichita Standard Specifications.
5. Contractor to insure that only one drive approach will be closed to traffic at any time during construction.
6. The Contractor is to notify Businesses 24 hours prior to beginning construction of the sewer.
7. The Contractor is to contact Utility Companies prior to construction to verify any underground utilities in the vicinity.

AUGUST 1936

LAT. 48 MAIN 2 S.S. 22
SANITARY SEWER TO SERVE
LOT 1 PPCd. #2 ADDITION
CITY OF WICHITA, KS.
PROJECT NO.
468-76-245-81587-000-000-001

BAUGHMAN COMPANY, P.A.
SURVEYING & ENGINEERING
316/262-7271 • 315 ELLIS • WICHITA, KANSAS 67211

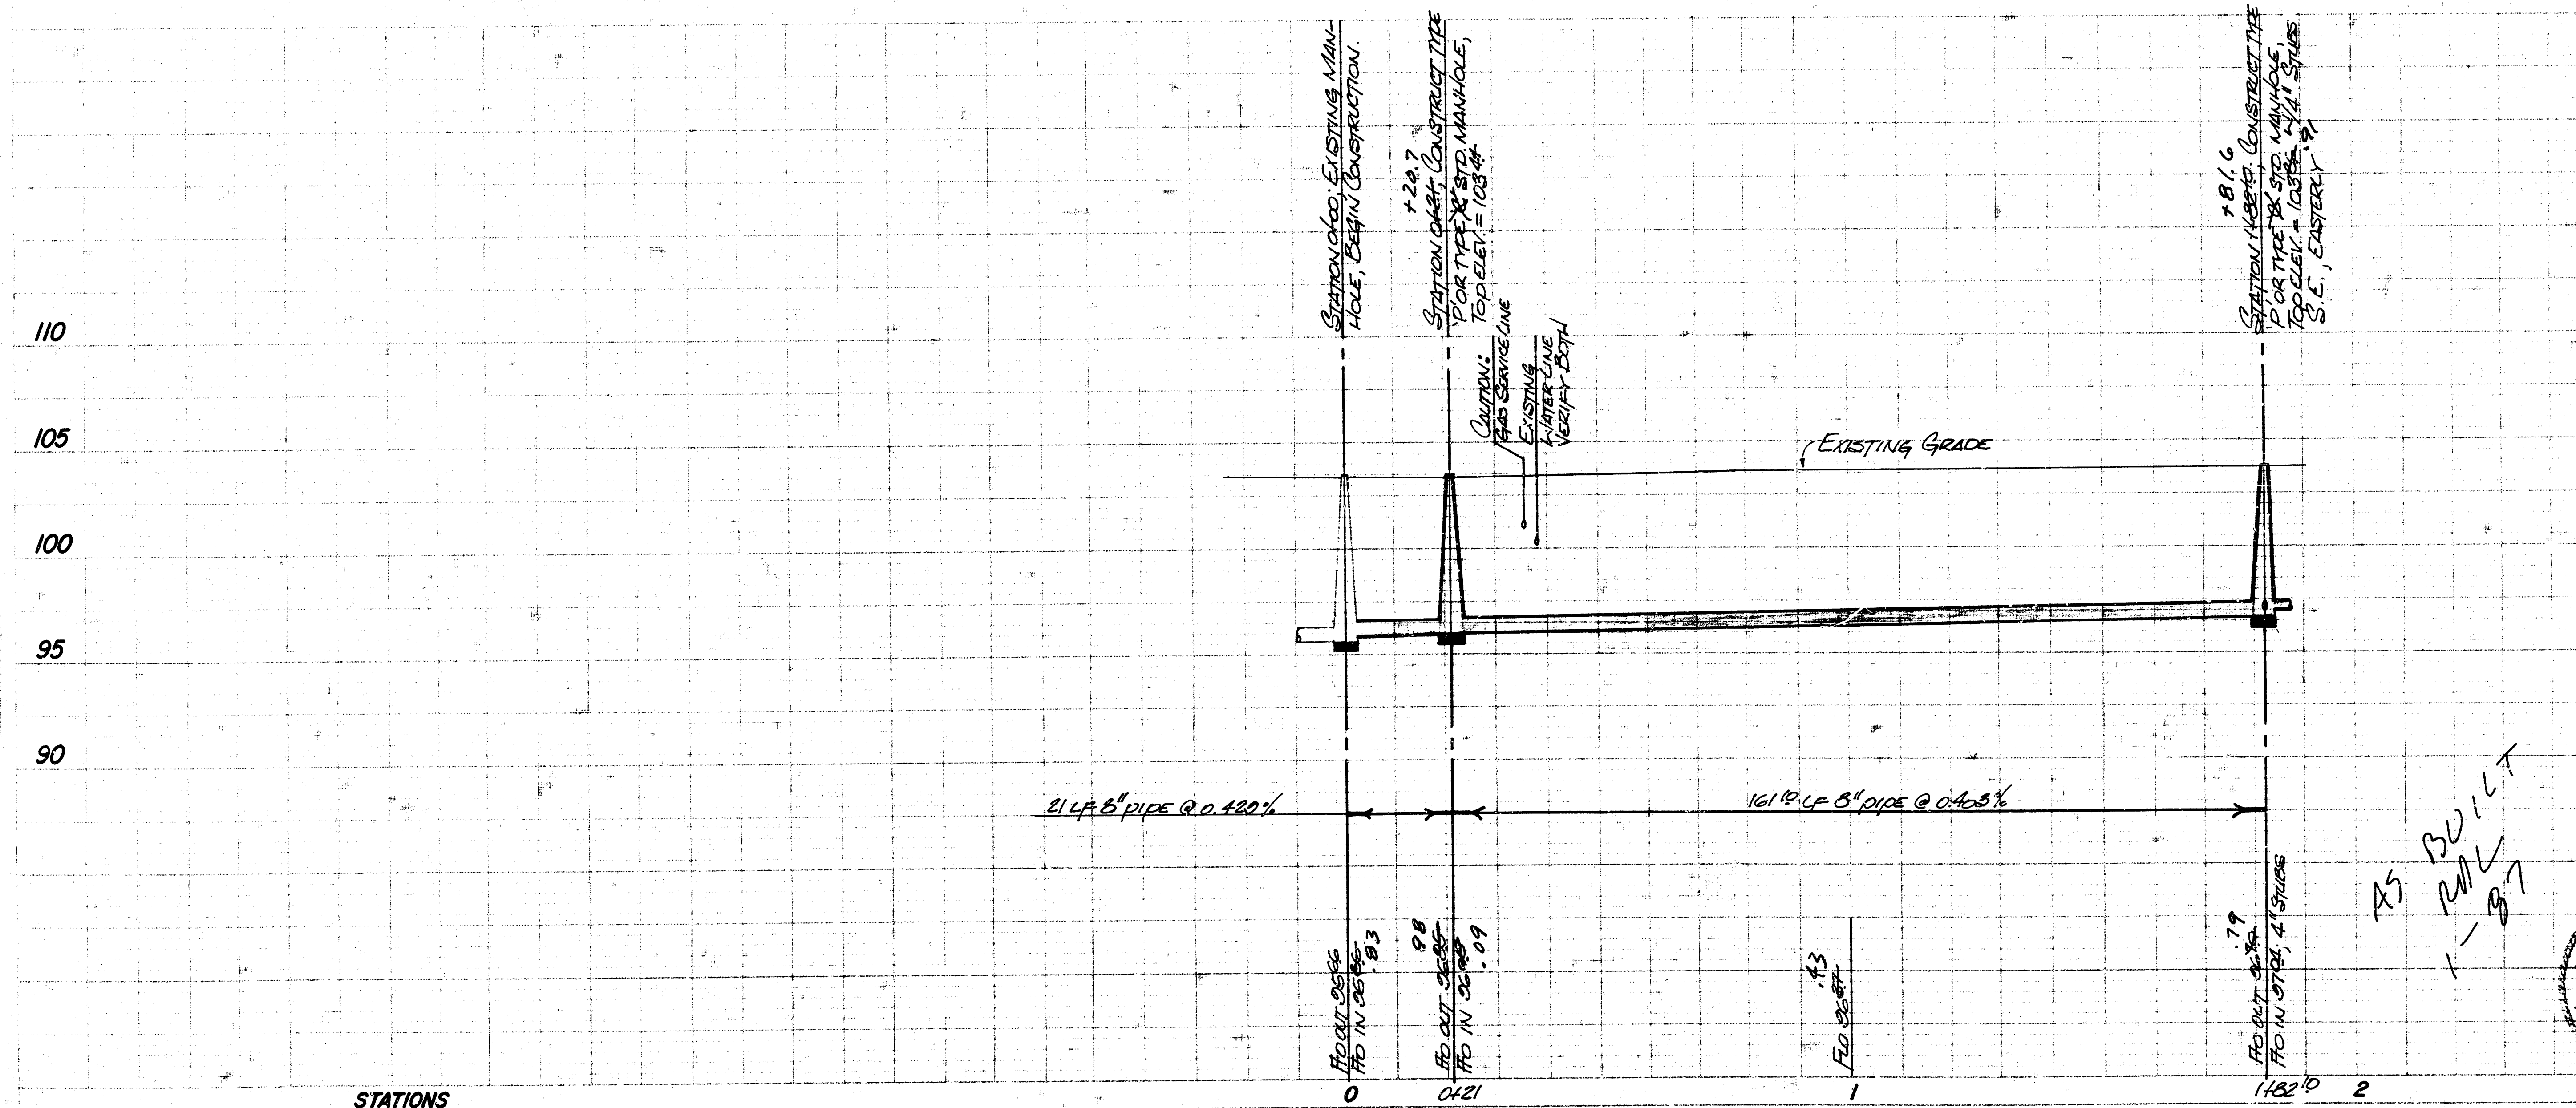


PLATE 1-SINGLE PLAN AND PROFILE-FULL LINE
30 TELETYPE
PRINTED IN U.S.A.

A circular professional engineer seal for N. Brent Wooley. The outer ring contains the text "N. BRENT WOOLEY" at the top and "PROFESSIONAL ENGINEER" at the bottom. The inner circle contains the text "LICENSED" at the top, the license number "8476" in the center, and "KANSAS" at the bottom.

01 1 8 21