LOCATION MAP

LAT. 1 SUB. 3 S.S. 22

CITY OF WICHITA

B.E. SMITH CITY ENGINEER

JAN. 1955 PROJ. NO. C24-82

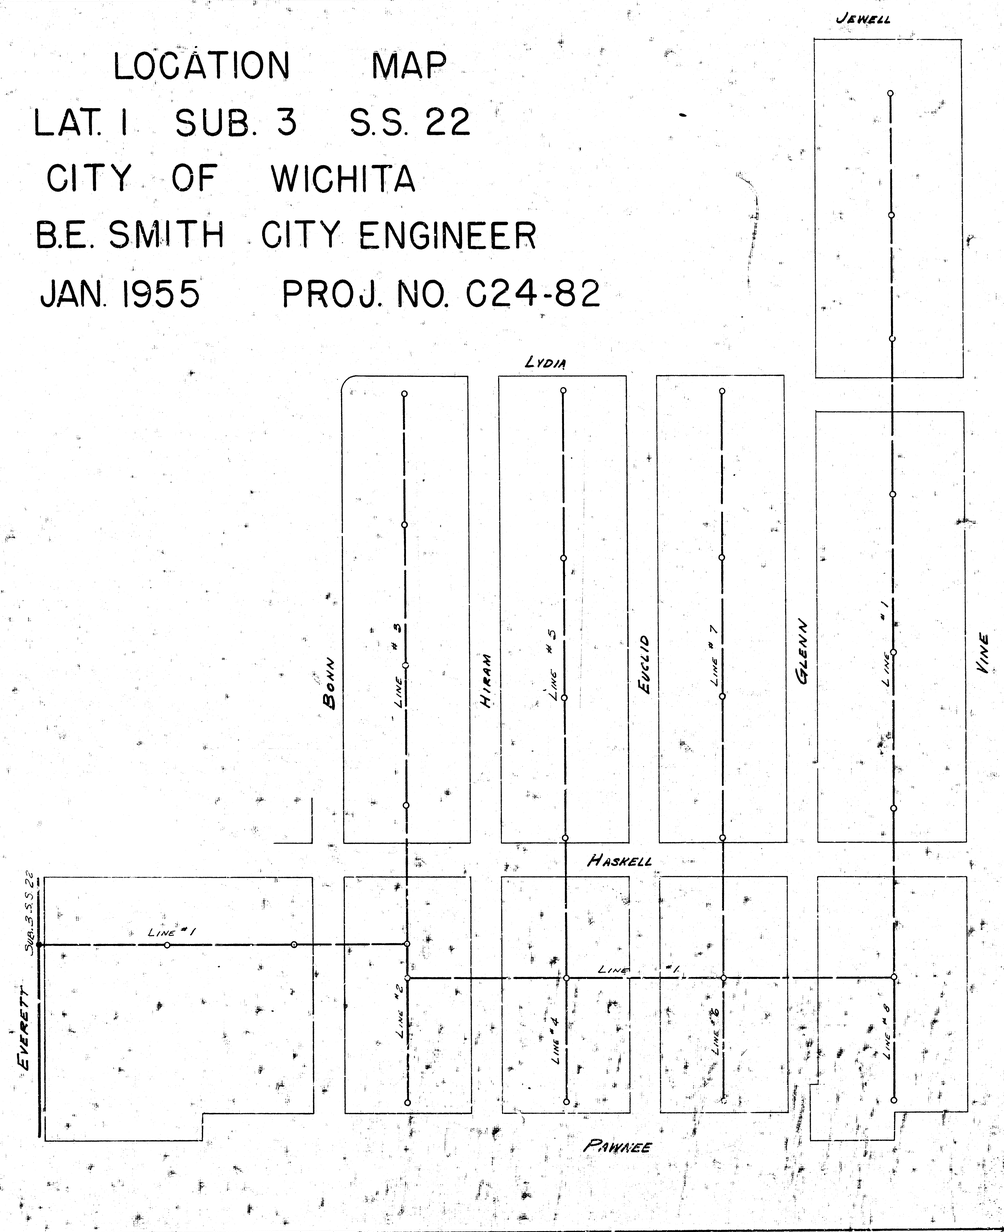

Plotted by LEROY R. BLAIR
Checked by
Date JAN 1955

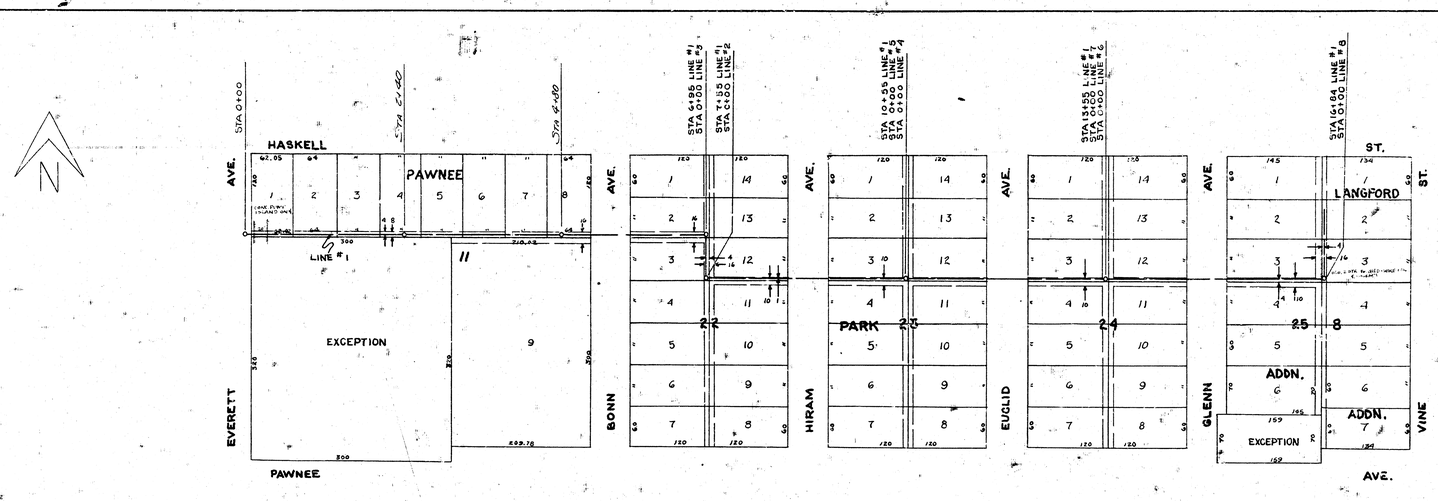

BENCH MARK

120° SPIKE W.S. KG&E POLE N.S. JEWELL @ E.L. PAWNEE PARK ADDN. (BETWEEN VINE & GLENN) 103.599

B.M. 12060 DOUBLE SPIKE W.S. KG&E POLE N.S. PAWNEE, 134' W. OF VINE

SCALE 1" = 80'

PROFILE SCALE 1" = 80' HOR. 1" = 4' VERT.

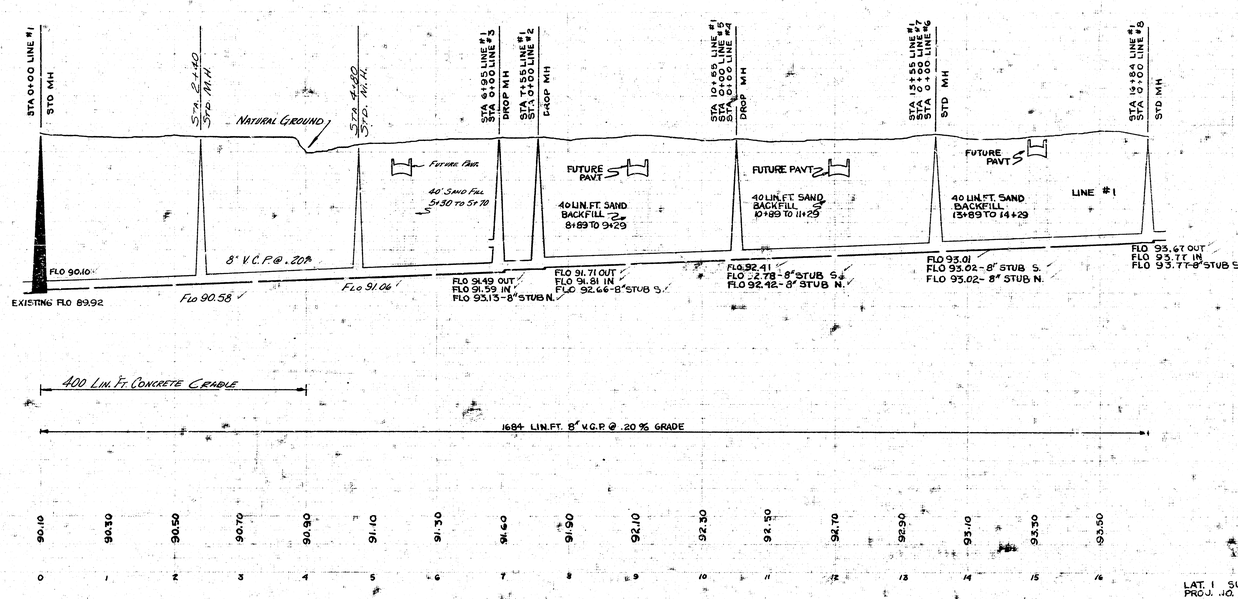

LAT. 1 SUB. 3, SAN. S. 22
PROJ. NO. C24-82
SHEET 2 OF 5

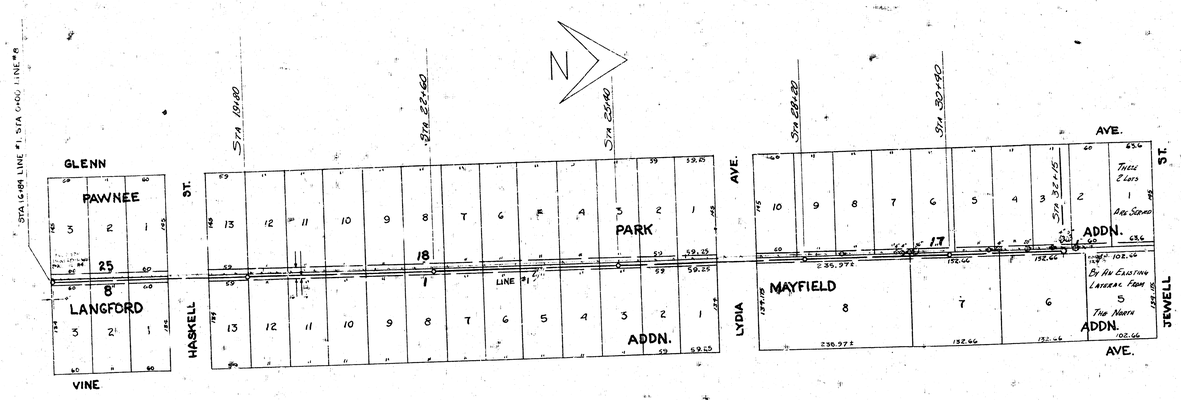

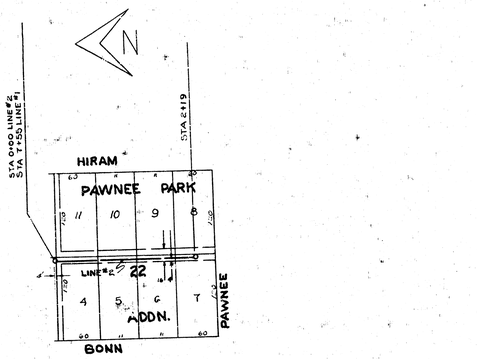

SCALE: 1" = 80'

PROFILE SCALE: 1" = 80' HOR. 1" = 4' VERT.

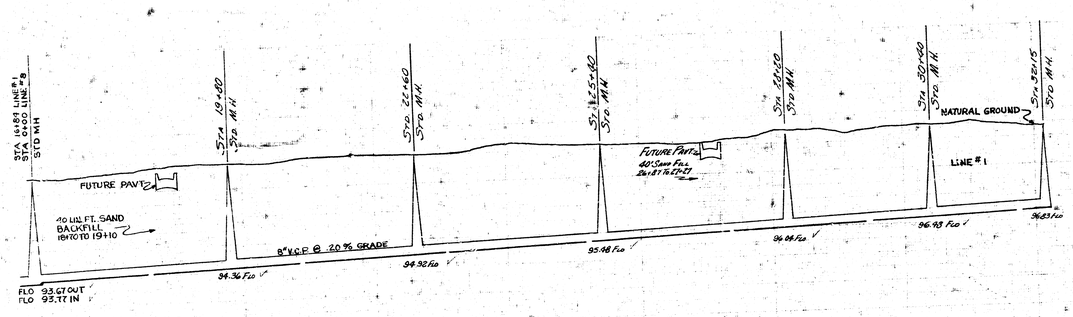

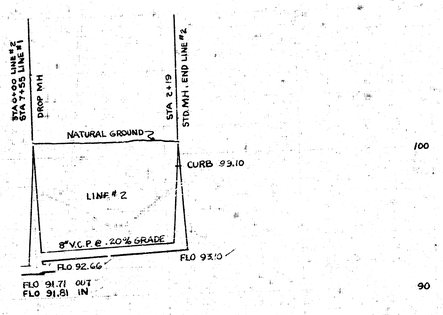

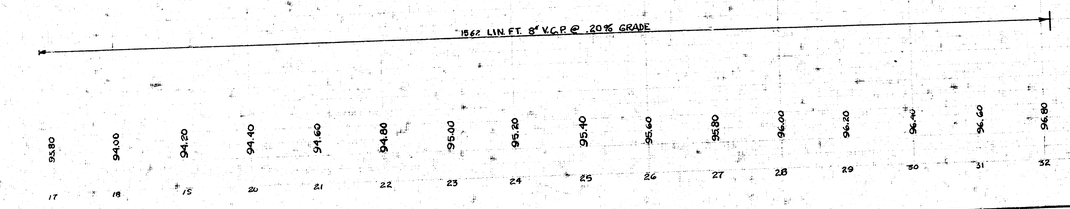

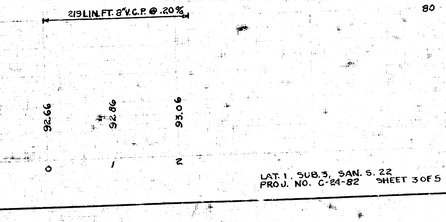

LAT. 1, SUB. 3, SAN. S. 22
PROJ. NO. C-24-82 SHEET 3 OF 5

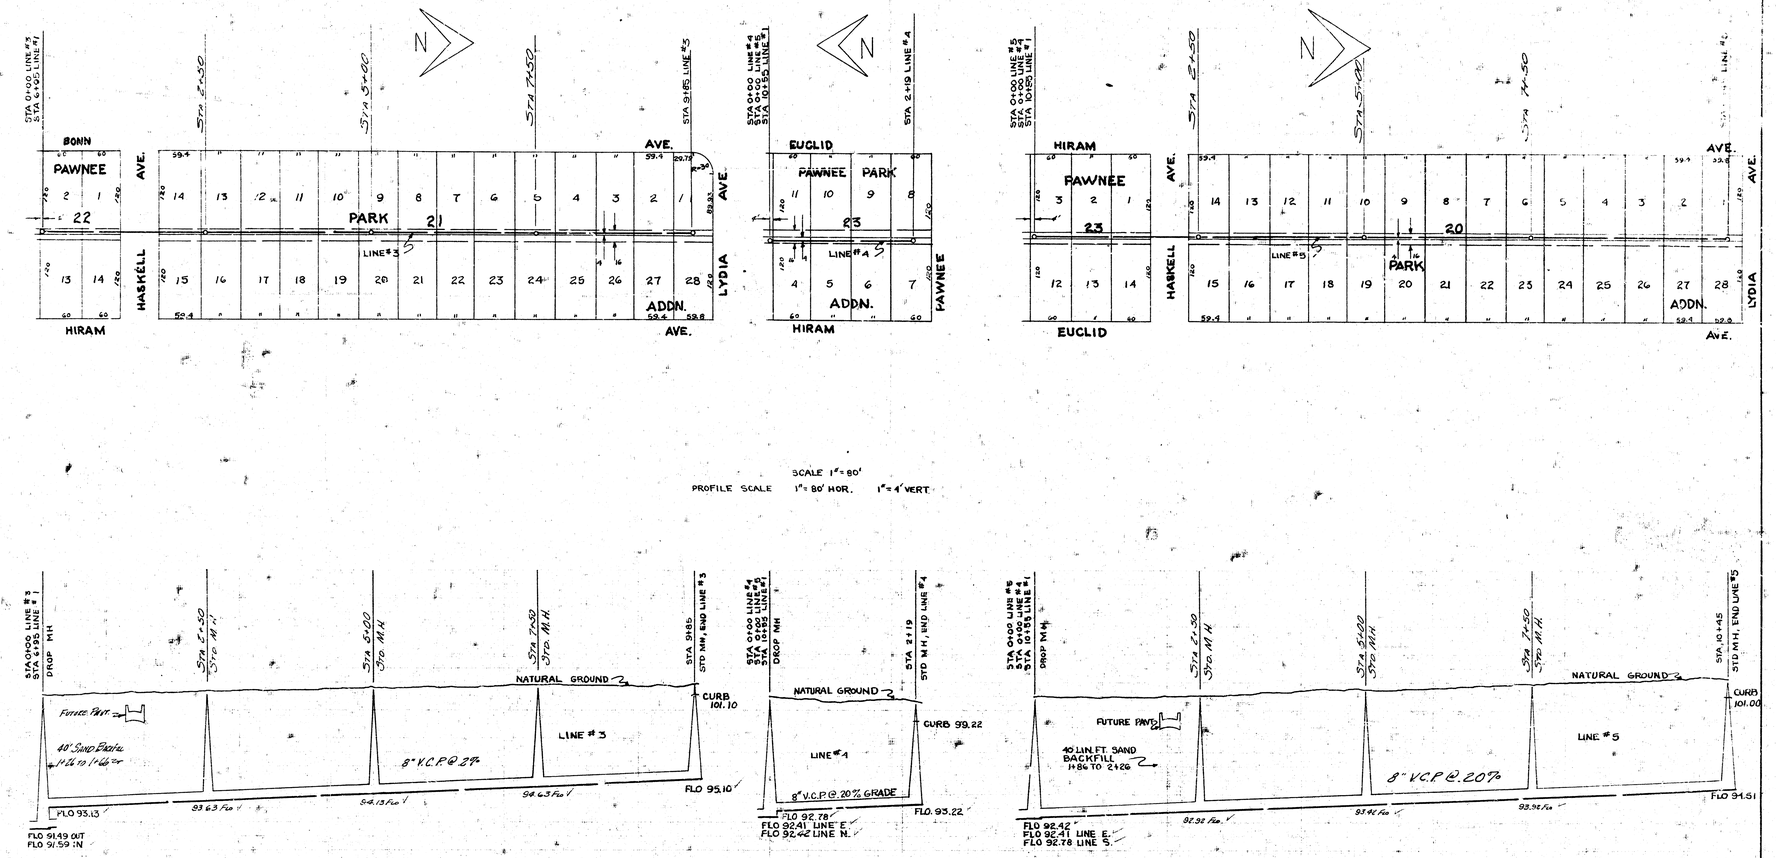

LAT 1, SUB. 3, SAN. S. 22
PROJ. NO C 24-82 SHEET 4 OF 5

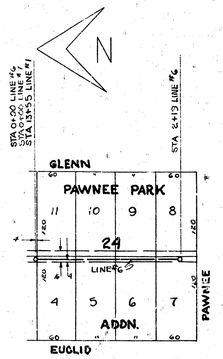

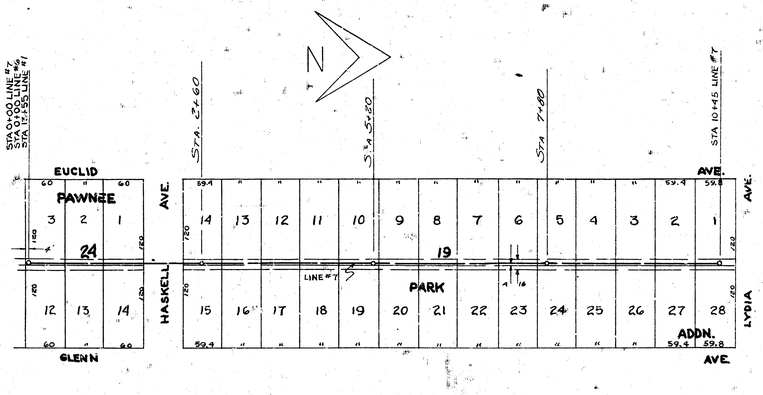

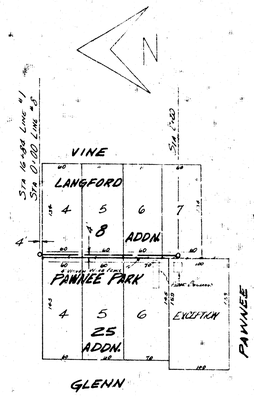

SCALE 1" = 80'
PROFILE SCALE 1" = 60' HOR. 1" = 4' VERT.

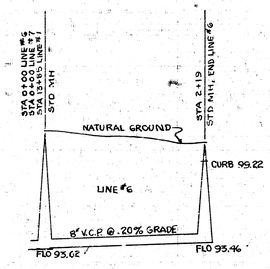

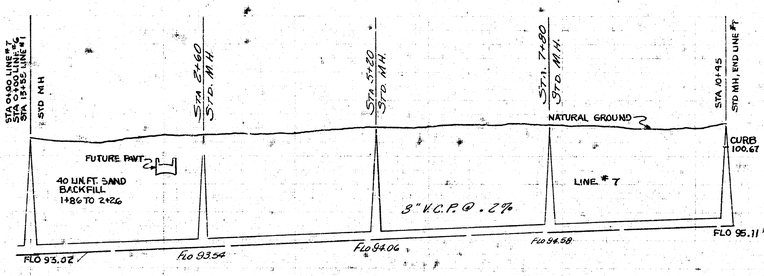

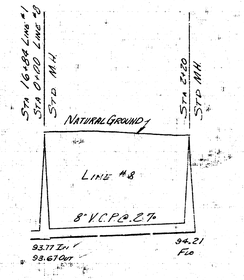

LAT. I, SUB. 3, SAN. S. 22
PROJ. NO. C24-82 SHEET 5 OF 5