


Survey I. Hanson, November 14/22
 Surveyed by C. Sellers
 Checked by C. Sellers
 Date Nov. 1955

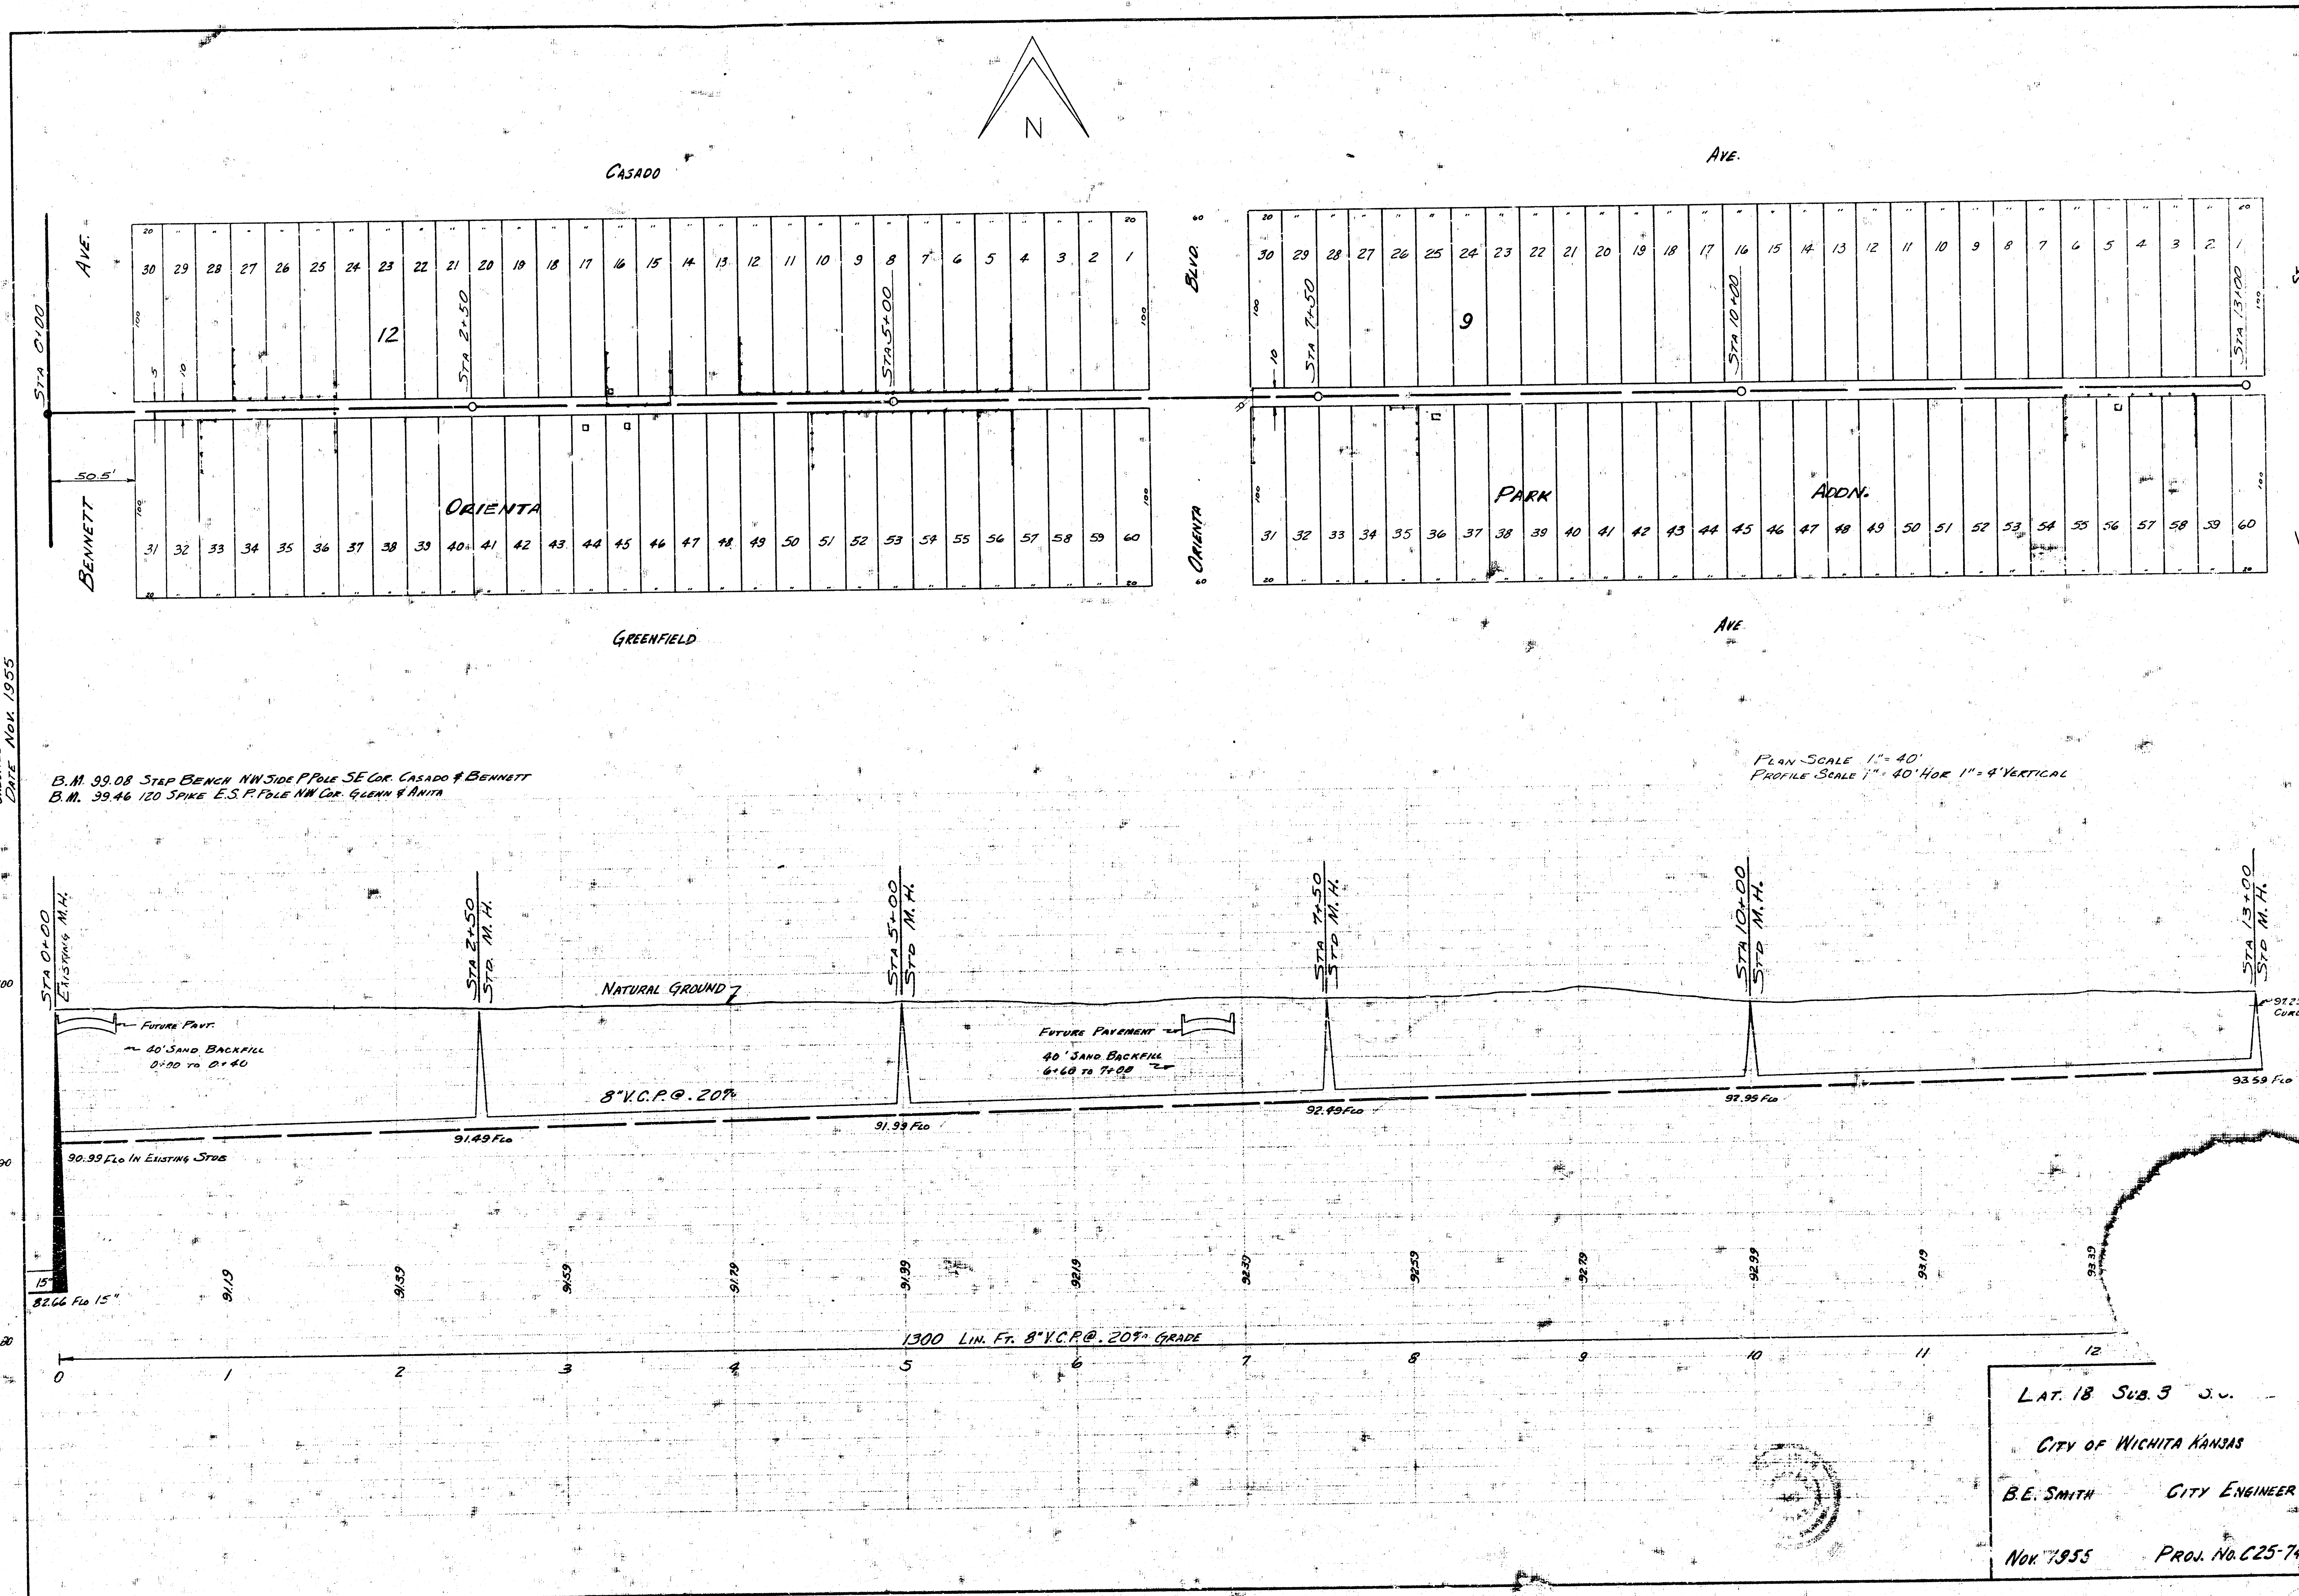

LAT. 18 SUB. 9 S.W.
 CITY OF WICHITA KANSAS
 B.E. SMITH CITY ENGINEER
 NOV. 1955 PROJ. NO. C25-74