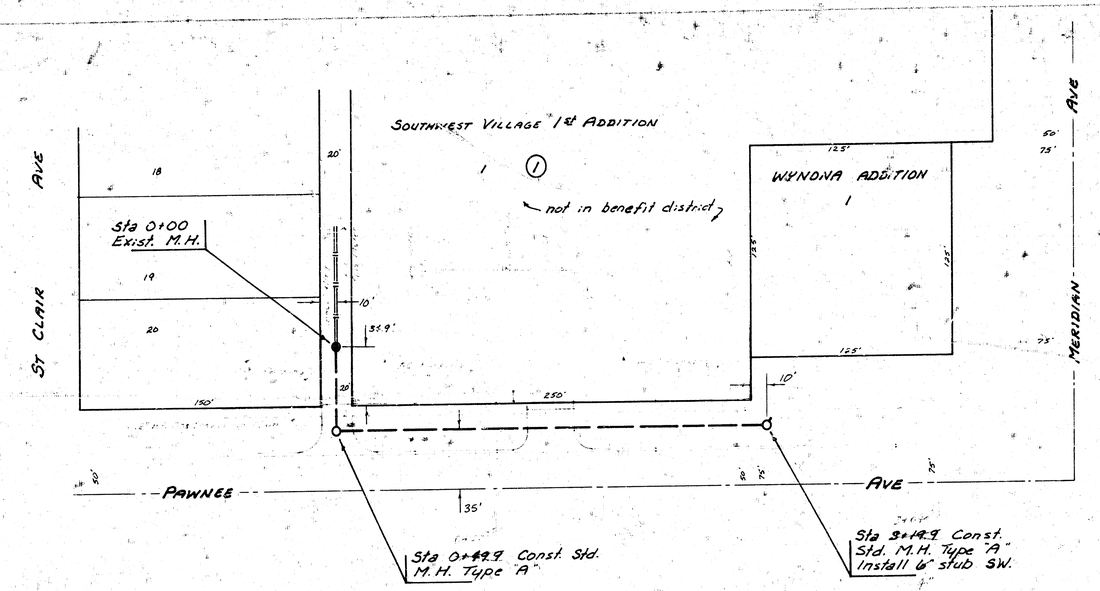


B. Potter R. Loomis


PLAT B.R.16

Scale Plan 1" = 40'
Profile 1" = 40' Horz.
1" = 5' Vert.

NOTE: CONTRACTOR SHALL MAINTAIN VEHICULAR ACCESS TO COMMERCIAL BUILDING ON LOT 1, BLOCK , SOUTHWEST VILLAGE 1ST ADDITION TO PAWNEE AVENUE AT ALL TIMES DURING THE CONSTRUCTION OF THIS PROJECT.

NOTE: SIX INCH STUB IN MANHOLE AT STATION 3 + 19.9 SHALL BE INSTALLED AT AN ELEVATION WHICH WILL PERMIT CONNECTION OF BUILDING LOCATED ON WYNONA ADDITION SUCH THAT THE BUILDING SEWER WILL NOT BE IN CONFLICT WITH THE 12" GAS SERVICE COMPANY MAIN.

B.M. 102.07 City Std. 42' S. and 525' E. of E's Paynee and Meridian.

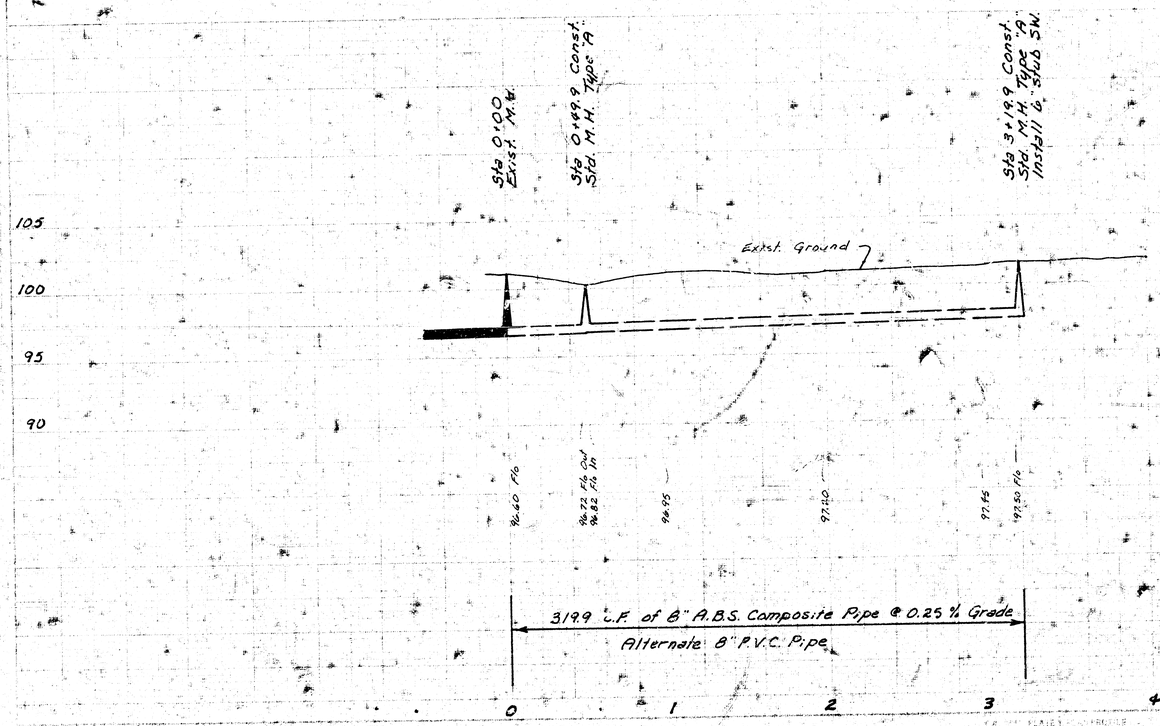

LAT 34, MAIN 3, SANITARY SEWER NO. 22
CITY OF WICHITA, KANSAS
DEAN SELLERS — CITY ENGINEER
PROJ. NO. 468-76245-80791-000-00000

14 S 3 E