



CONTRACT LINES FOR PURCELL'S 6TH
LINE 1 - STA. 0+10 - STA. 46+38
" 2 - STA. 0+10 - STA. 20+10
" 2A - STA. 0+10 - STA. 01+80
" 3 - STA. 0+10 - STA. 81+08
" 4 - STA. 0+10 - STA. 64+50
" 5 - STA. 0+10 - STA. 49+64
" 5-0 - STA. 0+10 - STA. 45+03

CONTRACT LINES FOR PURCELL'S 5TH.
LINE 1 - STA. 96+65 - STA. 52+87
LINE 2 - STA. 20+10 - STA. 29+69
LINE 2B - STA. 0+10 - STA. 01+80



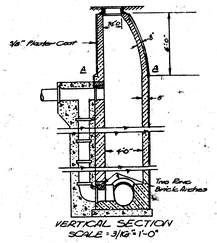


VERTICAL SECTION
SCALE: 3/16"=1'-0"

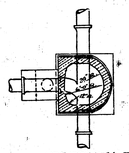


HORIZONTAL SECTION
A-A

DETAIL OF SPECIAL MANHOLE

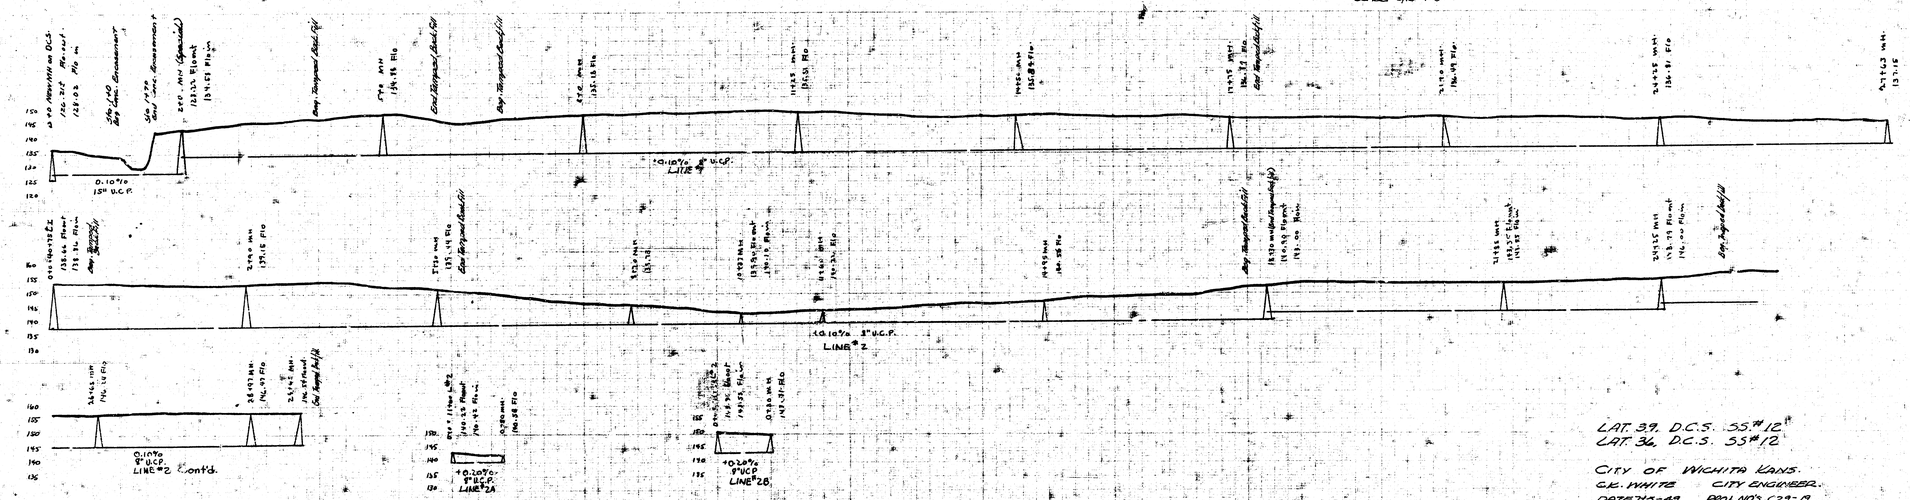

LAT. 39. D.C.S. 35' 12"
LAT. 36. D.C.S. 35' 12"

CITY OF WICHITA KANS.
C.R. WHITE CITY ENGINEER.
DATE 7-13-49 PROJ. NOS C29-19 C29-31

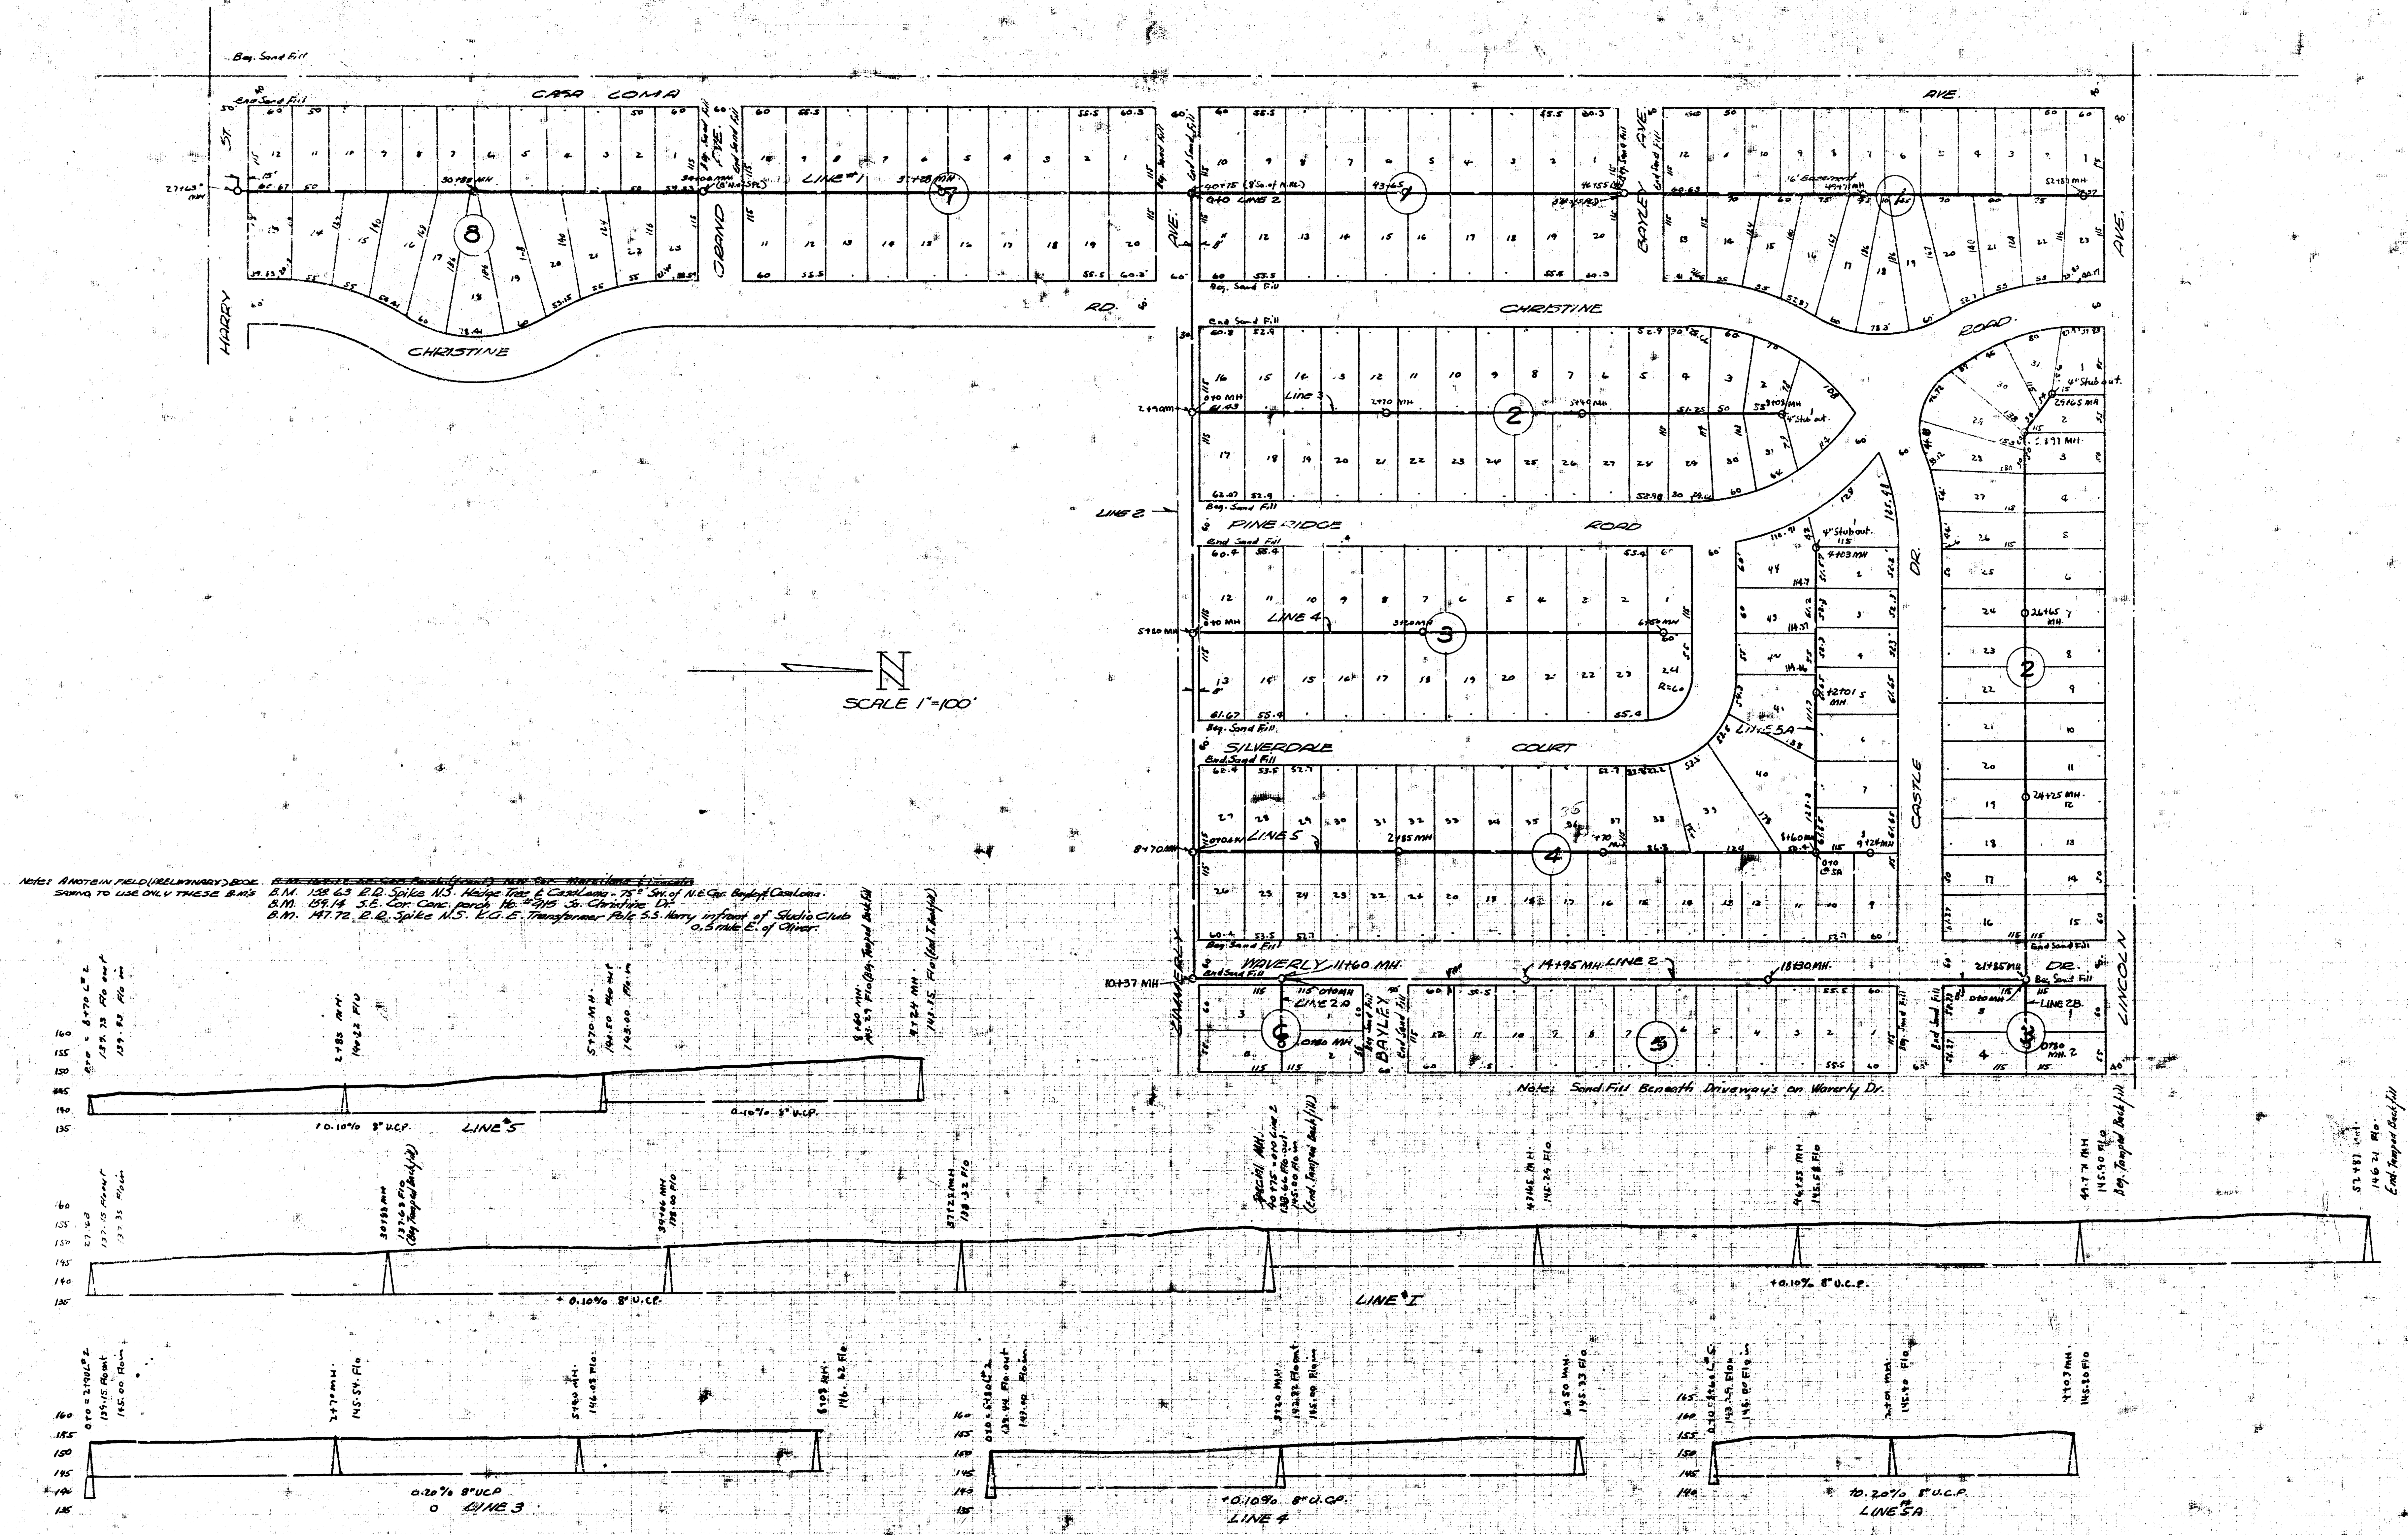
Beg. Sand Fill
CASA LOMA AVE.
HARRY ST.
GRAND AVE.
AVE.
BAYLEY AVE.
CHRISTINE RD.
CHRISTINE ROAD
LINE 1
LINE 2
Line 3
LINE 4
LINE 5
LINE 5A
LINE 2A
LINE 2B
PINE RIDGE ROAD
SILVERDALE COURT
CASTLE DR.
WAVERLY DR.
BAYLEY
LINCOLN AVE.
SCALE 1"=100'
N
Note: Sand Fill Beneath Driveway's on Waverly Dr.
Note: A NOTE IN FIELD (PRELIMINARY) BOOK SAYING TO USE ONLY THESE B.M's
B.M. 158.63 R.R. Spike N.S. Hedge Tree & CasaLoma - 75' Sw. of N.E. Cor. Bayley & CasaLoma.
B.M. 159.14 S.E. Cor. Conc. porch Ho. #915 So. Christine Dr.
B.M. 147.72 R.R. Spike N.S. K.G.E. Transformer Pole S.S. Harry infront of Studio Club 0.5 mile E. of Oliver.
0.10% 8" U.C.P.
LINE 5
+0.10% 8" U.C.P.
LINE 1
0.20% 8" UCP
LINE 3
+0.10% 8" U.C.P.
LINE 4
+0.20% 8" U.C.P.
LINE 5A