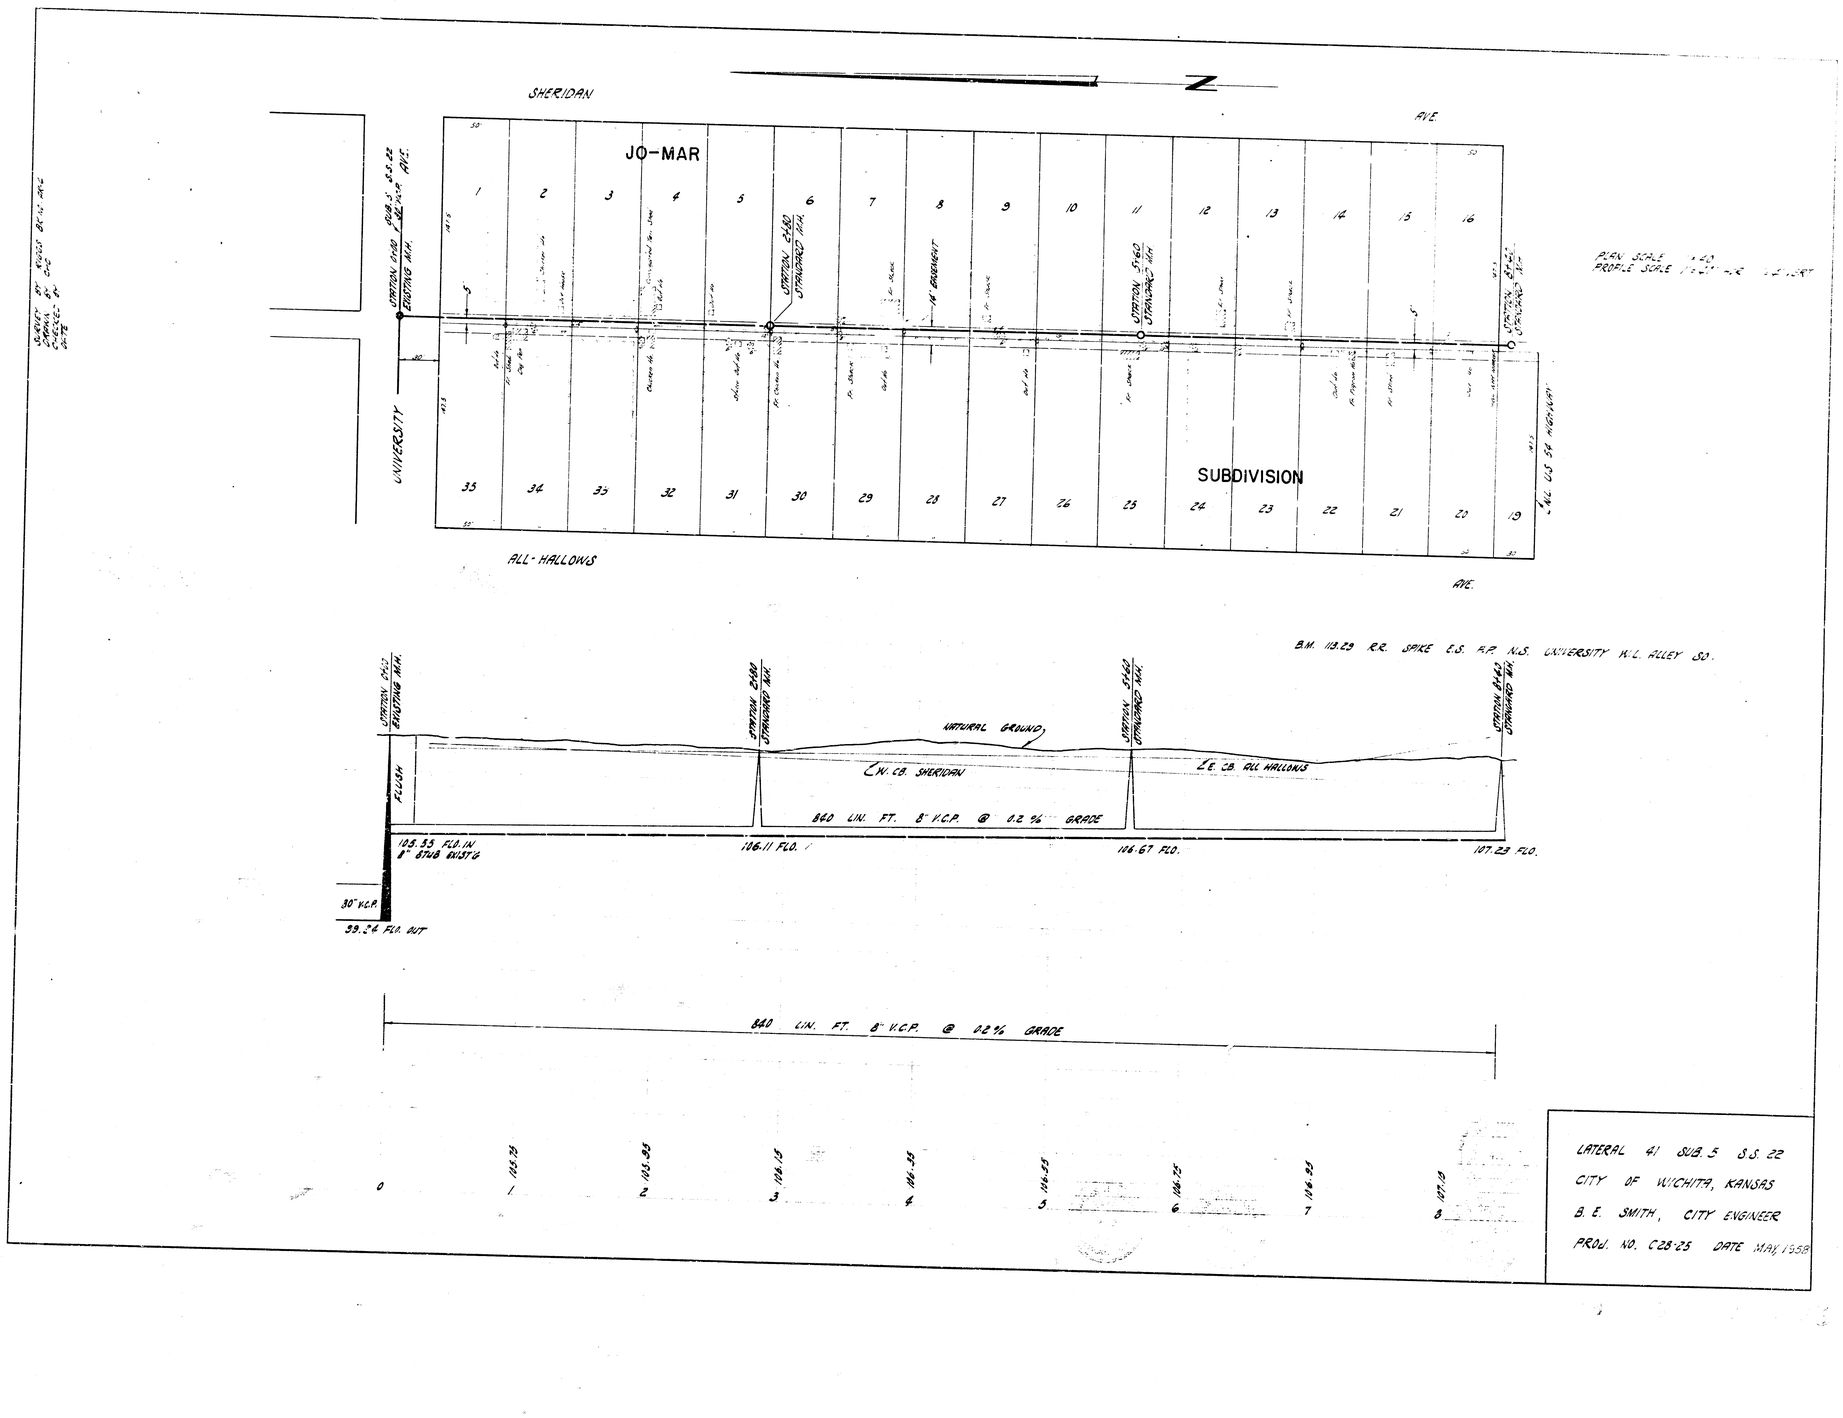


LATERAL 41 SUB. 5 S.S. 22
CITY OF WICHITA, KANSAS
B. E. SMITH, CITY ENGINEER
PROJ. NO. C28-25 DATE MAY 1958