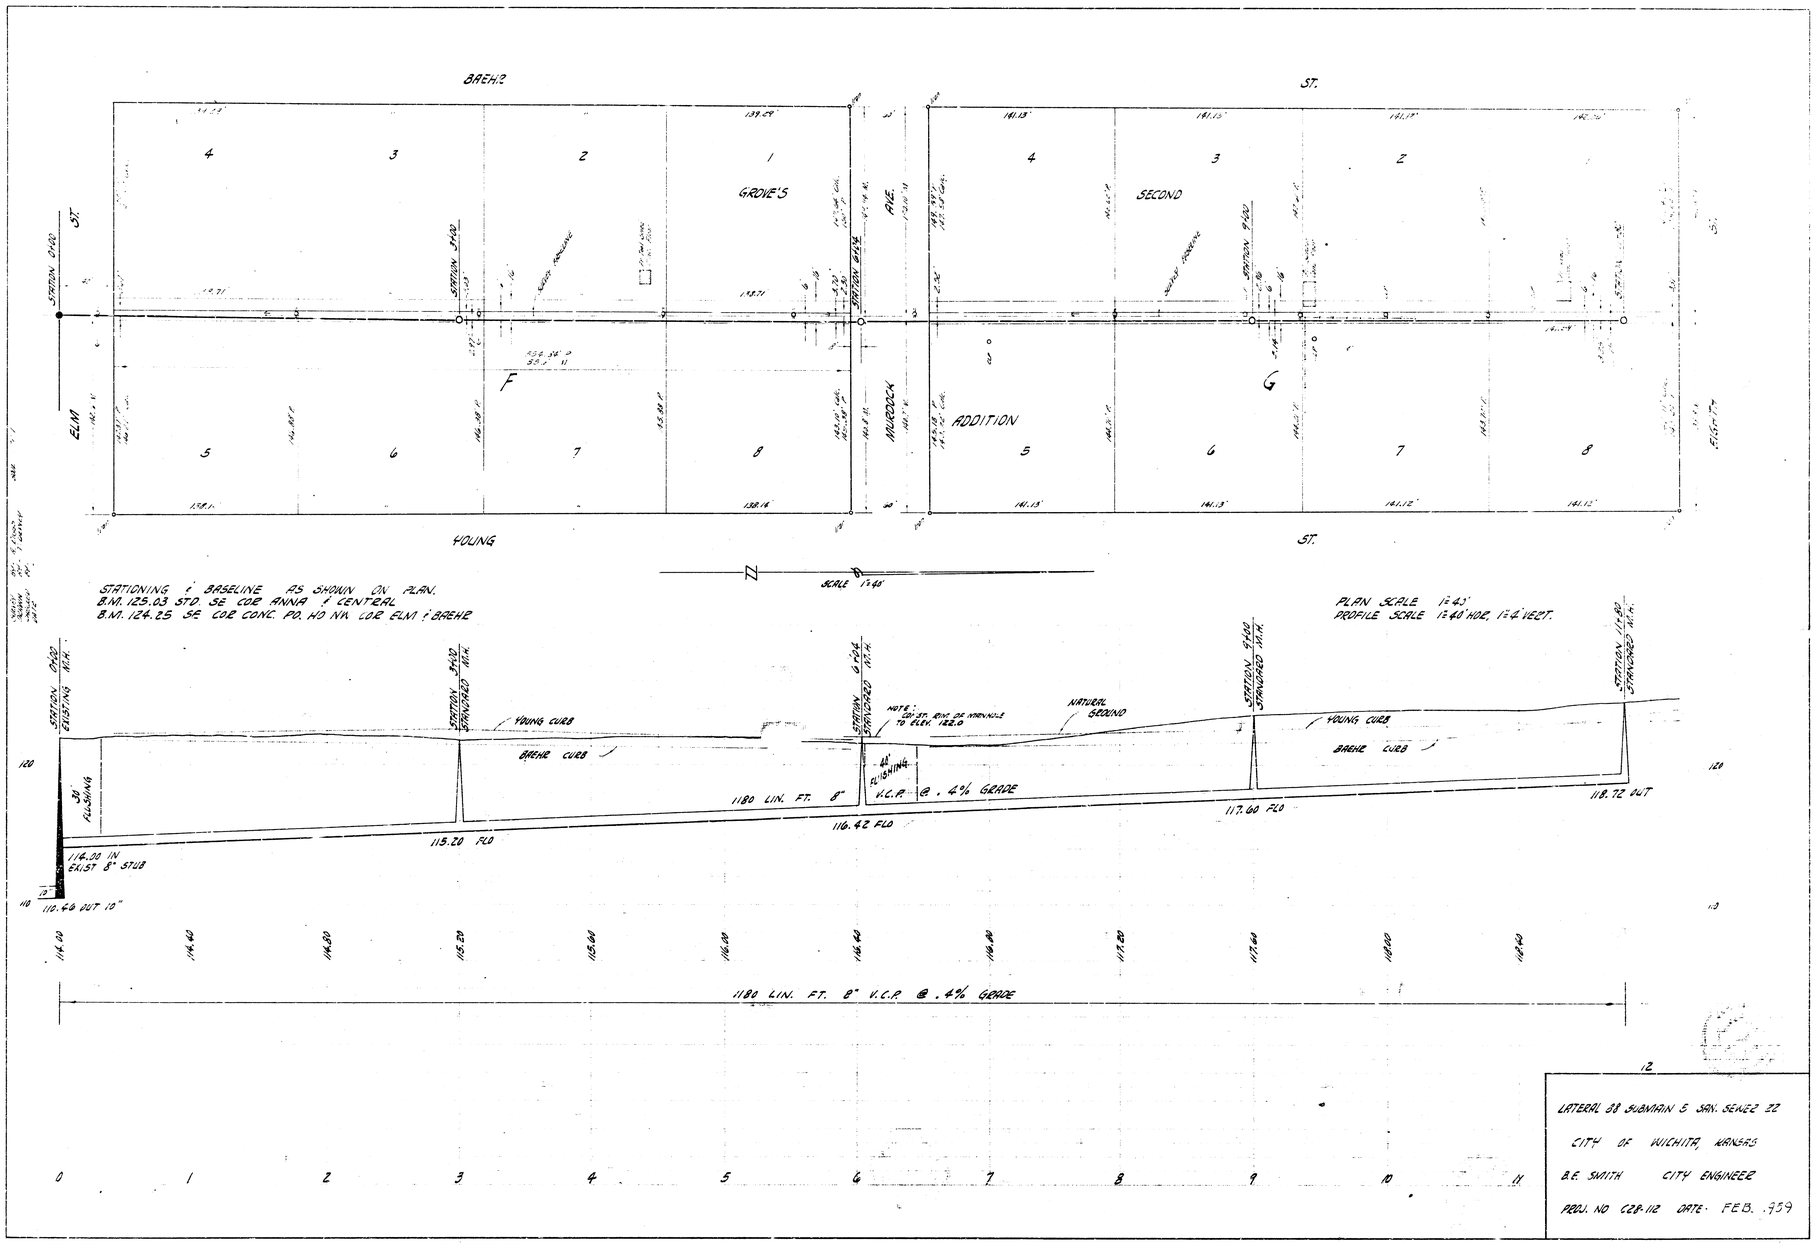

LATERAL 88 SUBVIAN & SAN. SEWER 22

CITY OF WICHITA, KANSAS

B.E. SMITH CITY ENGINEER

PROJ. NO CCB-112 DATE: FEB. 1959

8 3 4 (15)