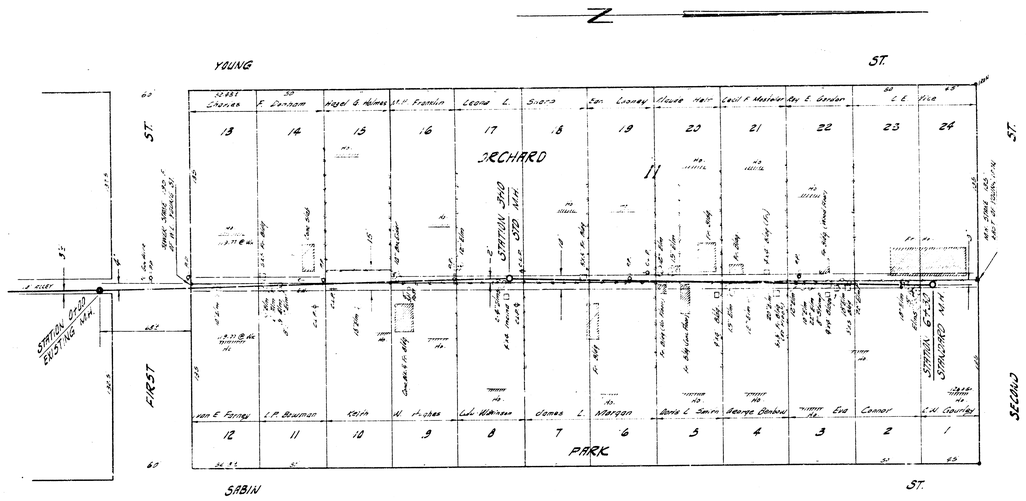

MAIN SCALE 1" = 40'
PROFILE SCALE 1" = 20' HOR. 1" = 4' VERT.

B.M. 119.690 STANDARD N.E. COR. WEST & SECOND
B.M. 118.40 DOUBLE SPIKE S.E. COR. A POLE N.E. COR. SABIN & 1ST ST

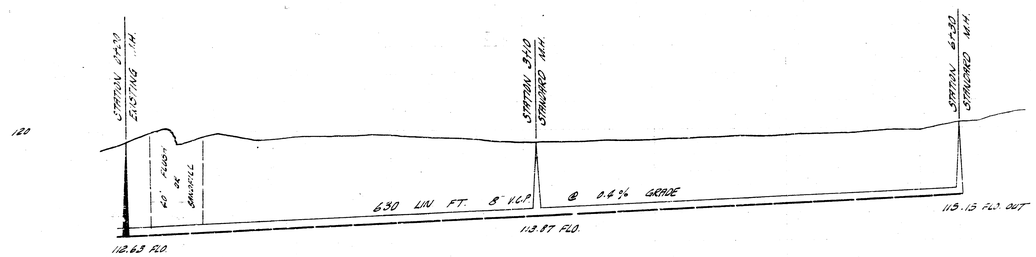

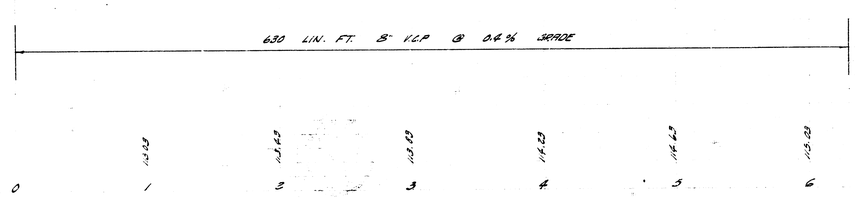

LATERAL 102 · SUB. 5 SAN. SEWER 22
CITY OF WICHITA, KANSAS
B.E. SMITH CITY ENGINEER
PROJ. NO. 629-9 DATE: MAY 1959