B. M. 115.54 "M" in Mueller F. P. S.E. West & McCormick

B. M. 113.25 S.W. cor. wk S.E. Kessler & McCormick.

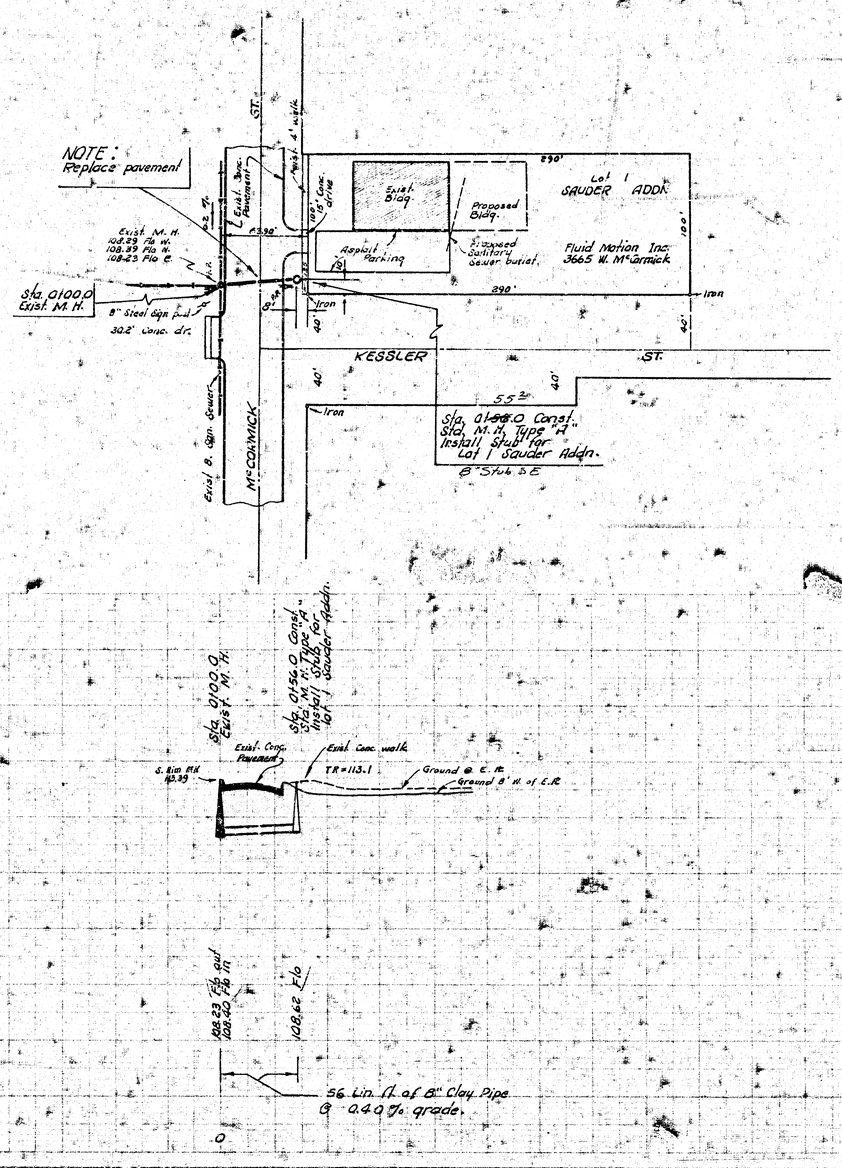


N

Plan Scale 1" = 40'
Profile Scale 1" = 40' Hor. c.
1" = 5' Vert.

As Built Final Map SS Jk #6

LAT. 125, S. S. NO. 22

CITY OF WICHITA, KANSAS

R. W. LINN — CITY ENGINEER

MAR. 1974 PROJECT NO. DBKL574004

14 9 3 10