Bm 168.59 Stand. SW Douglas & Oliver
172.71 x on W. cb. Railroad 10 N of NL Douglas

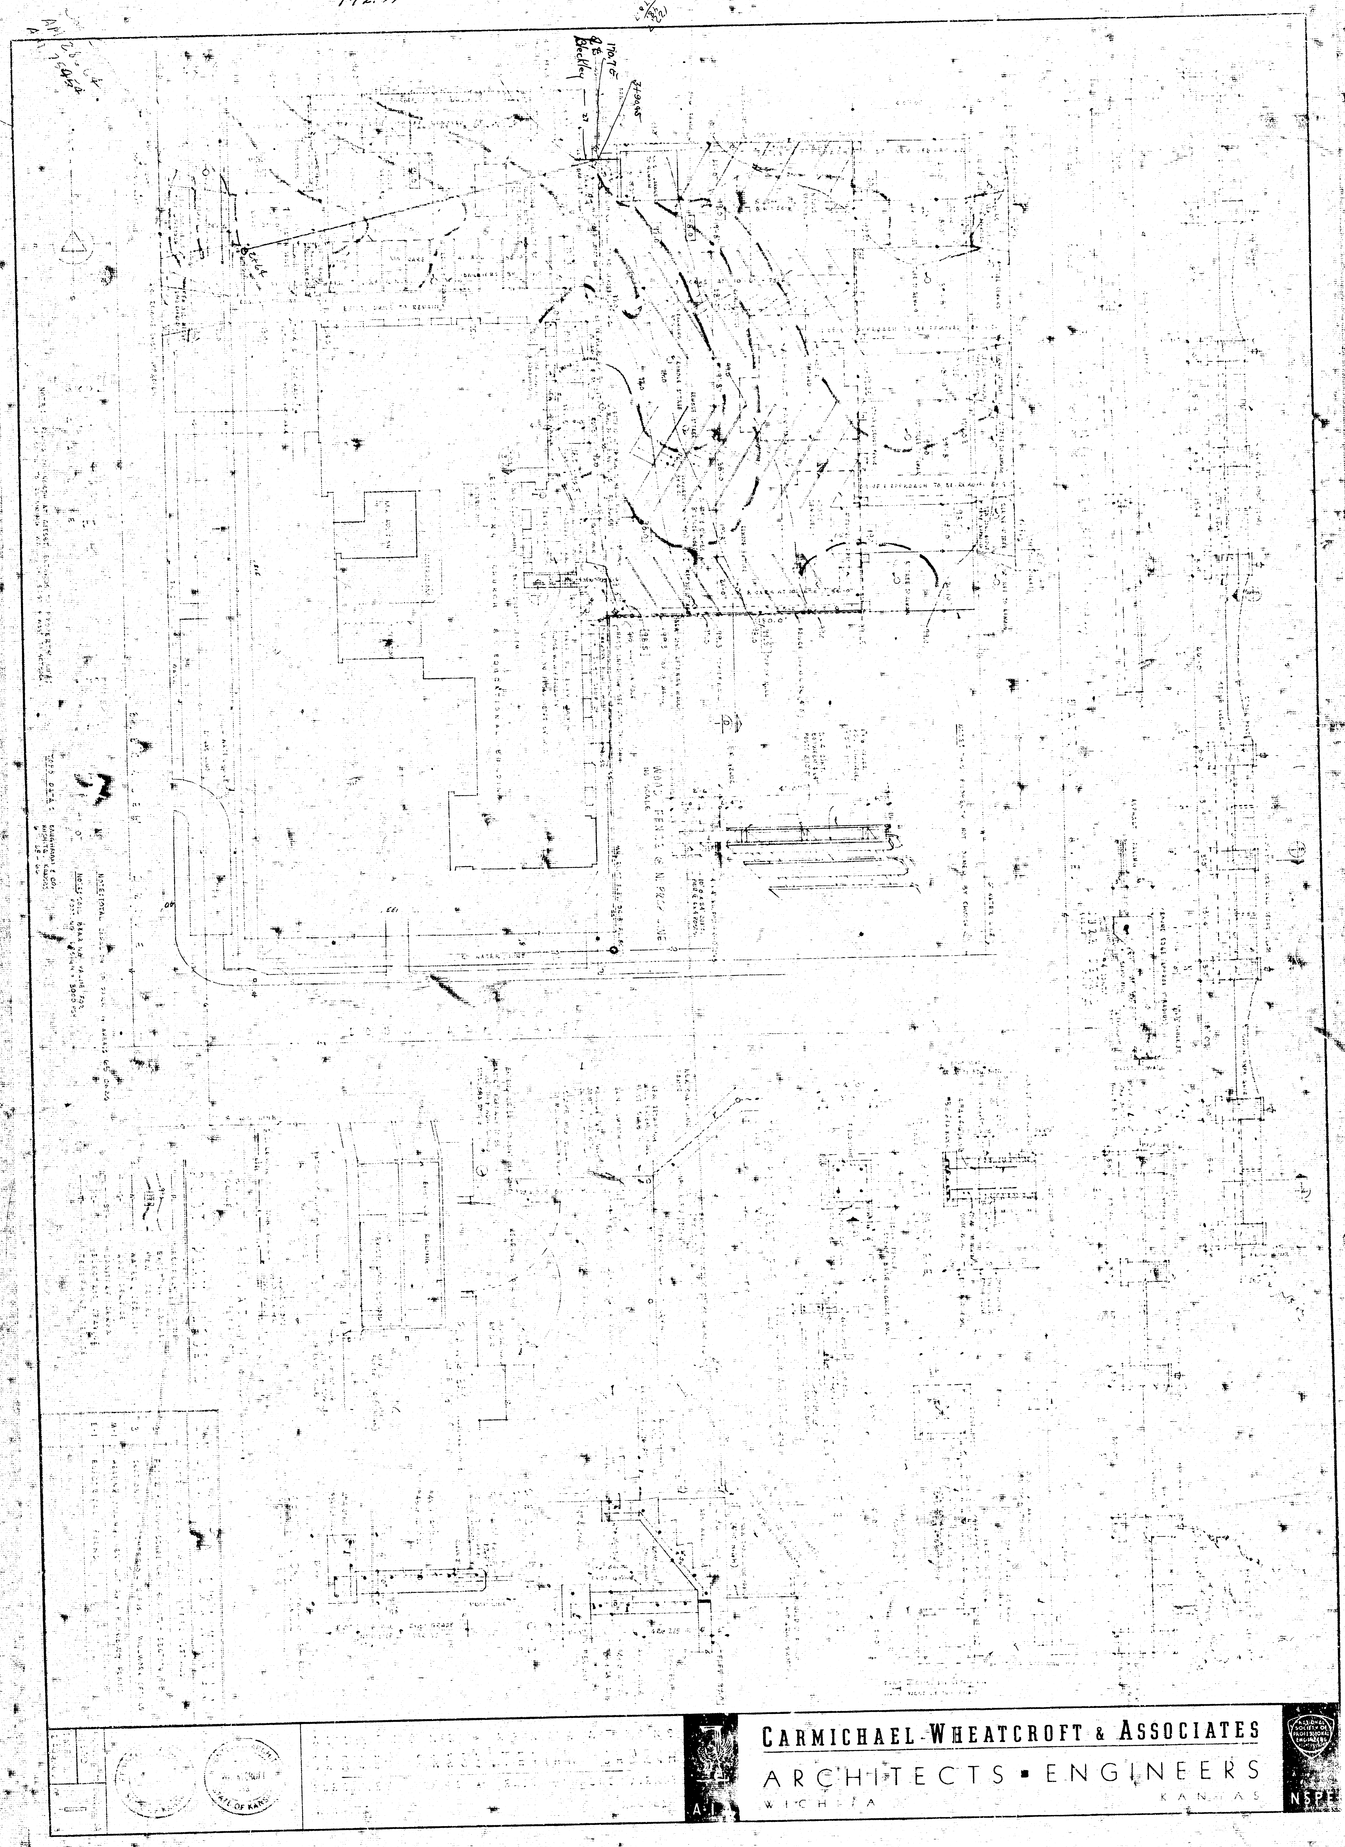
E.E. Berkley
Master Plans
Revised
Addition
Addition
Addition

B.M. 163.02 "G" in Globe E. cb. Glendale S.L. Douglas

Survey: G. Young Pitch: Ex. Check:

STA. 0100 CONST. STD. M.H. TYPE "A" OVER EXIST. 8" V.C.P.

STA. 2+63.8 CONST. STD. M.H. TYPE "A"

BLECKLEY DR.

STRIEFF

CORONADO PLACE (VACATED)

DOUGLAS AVE.

Note: Plug exist. S.S.

Note: Plug exist. S.S.

STA. 3+98.8 CONST. STD. M.H. TYPE "A" OVER EXIST. 8" V.C.P. END PROJECT.

NOTE TO CONTRACTOR

This project will be constructed under the supervision of the CITY ENGINEER and conforming to the SPECIFICATIONS of the CITY OF WICHITA. The CONTRACTOR will reimburse the City of Wichita for all cost of Engineering, Plans and Inspection.

Plan Scale 1"=40'
Profile Scale 1"=40' Hor.
1"=4' Vert.

PLACE

BATTIN AVE.

National Ground

8" V.C.P. @ 0.55%

Exist. 8" V.C.P.

395 LIN. FT. 8" V.C.P. @ 0.55% GRADE

GRACE PRESBYTERIAN CHURCH, S.S.
CITY OF WICHITA, KANSAS
B.E. SMITH, CITY ENGINEER
PRIVATE PROJECT
DATE:

Survey: G. Young Pitch: Ex. Check:

30YD AVE.

STA. 0+00 EXIST. M.H. EXIST. 8" STUB N.

ST. LOUIS AVE.

WEST CENTRAL GARDENS

SECOND ADDN.

STA. 6+00 CONST. STD. M.H. TYPE "A" CONST. 8" STUB N.

STA. 3+00 CONST. STD. M.H. TYPE "A"

WEST ST. LOUIS GARDENS

NEWELL AVE.

EISENHOWER AVE.

NOTE: TO CONTRACTOR
#1 - Replace all fences
#2 - Replace clothesline poles

Plan Scale 1"=40'
Profile Scale 1"=40' Hor.
1"=4' Vert.

B.M. 123.11 N.E. Cor. Porch Ho. S.W. Boyd & Newell

N. Rim 180.64

National Ground

8" V.C.P. @ 0.20%

600 LIN. FT. 8" V.C.P. @ 0.20% GRADE

LAT. 192, SUB. 5, S.S. 22
CITY OF WICHITA, KANSAS
B.E. SMITH, CITY ENGINEER
PROJECT NO. C26-58
DATE: SEPT. 1956

3 15 3 (5)