

B.M. 1259 R.R. Spike on West side p. pole on ℄ DOUGHERTY & ℄ WHITEHALL W.
B.M. 1270 R.R. Spike on North - - - South side 13TH - 615' West ℄ 13TH & BICKEL

N

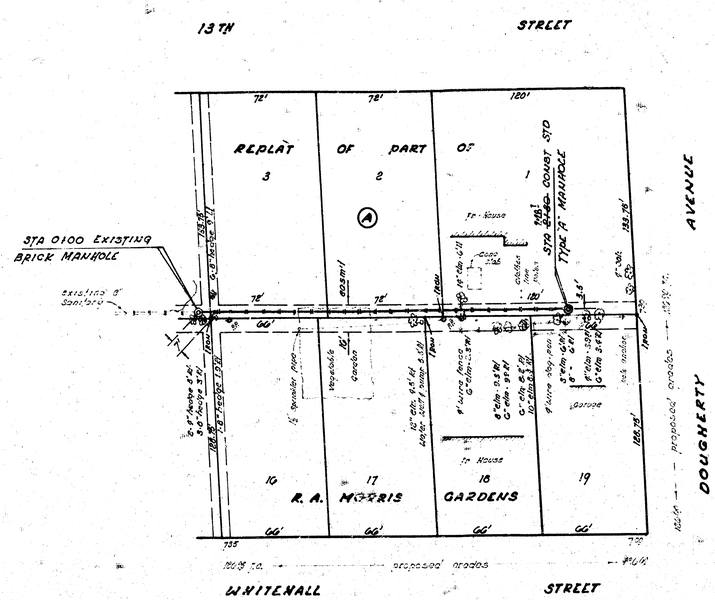 


PLAN SCALE 1" = 40'
PROFILE 1" = 40' HORZ.
1" = 5' VERT

"As Built" is Sept '72 Final Measurement in S.S. JK#5

LATERAL 213, MAIN 5, S.S. 22
CITY OF WICHITA, KANSAS
R.W. LINN CITY ENGINEER
DATE SEPT. 1972 PROJ No. DBKL 572038
1/1

LARRY W. LAURSEN LICENSED 6363 KANSAS PROFESSIONAL ENGINEER

DEAN S. SELLICK LICENSED 3663 KANSAS PROFESSIONAL ENGINEER

Blogs
Aft 74 Checked by LWL

14 4 5 15

1-Engr
1-Insp

FILMED FROM THE BEST