


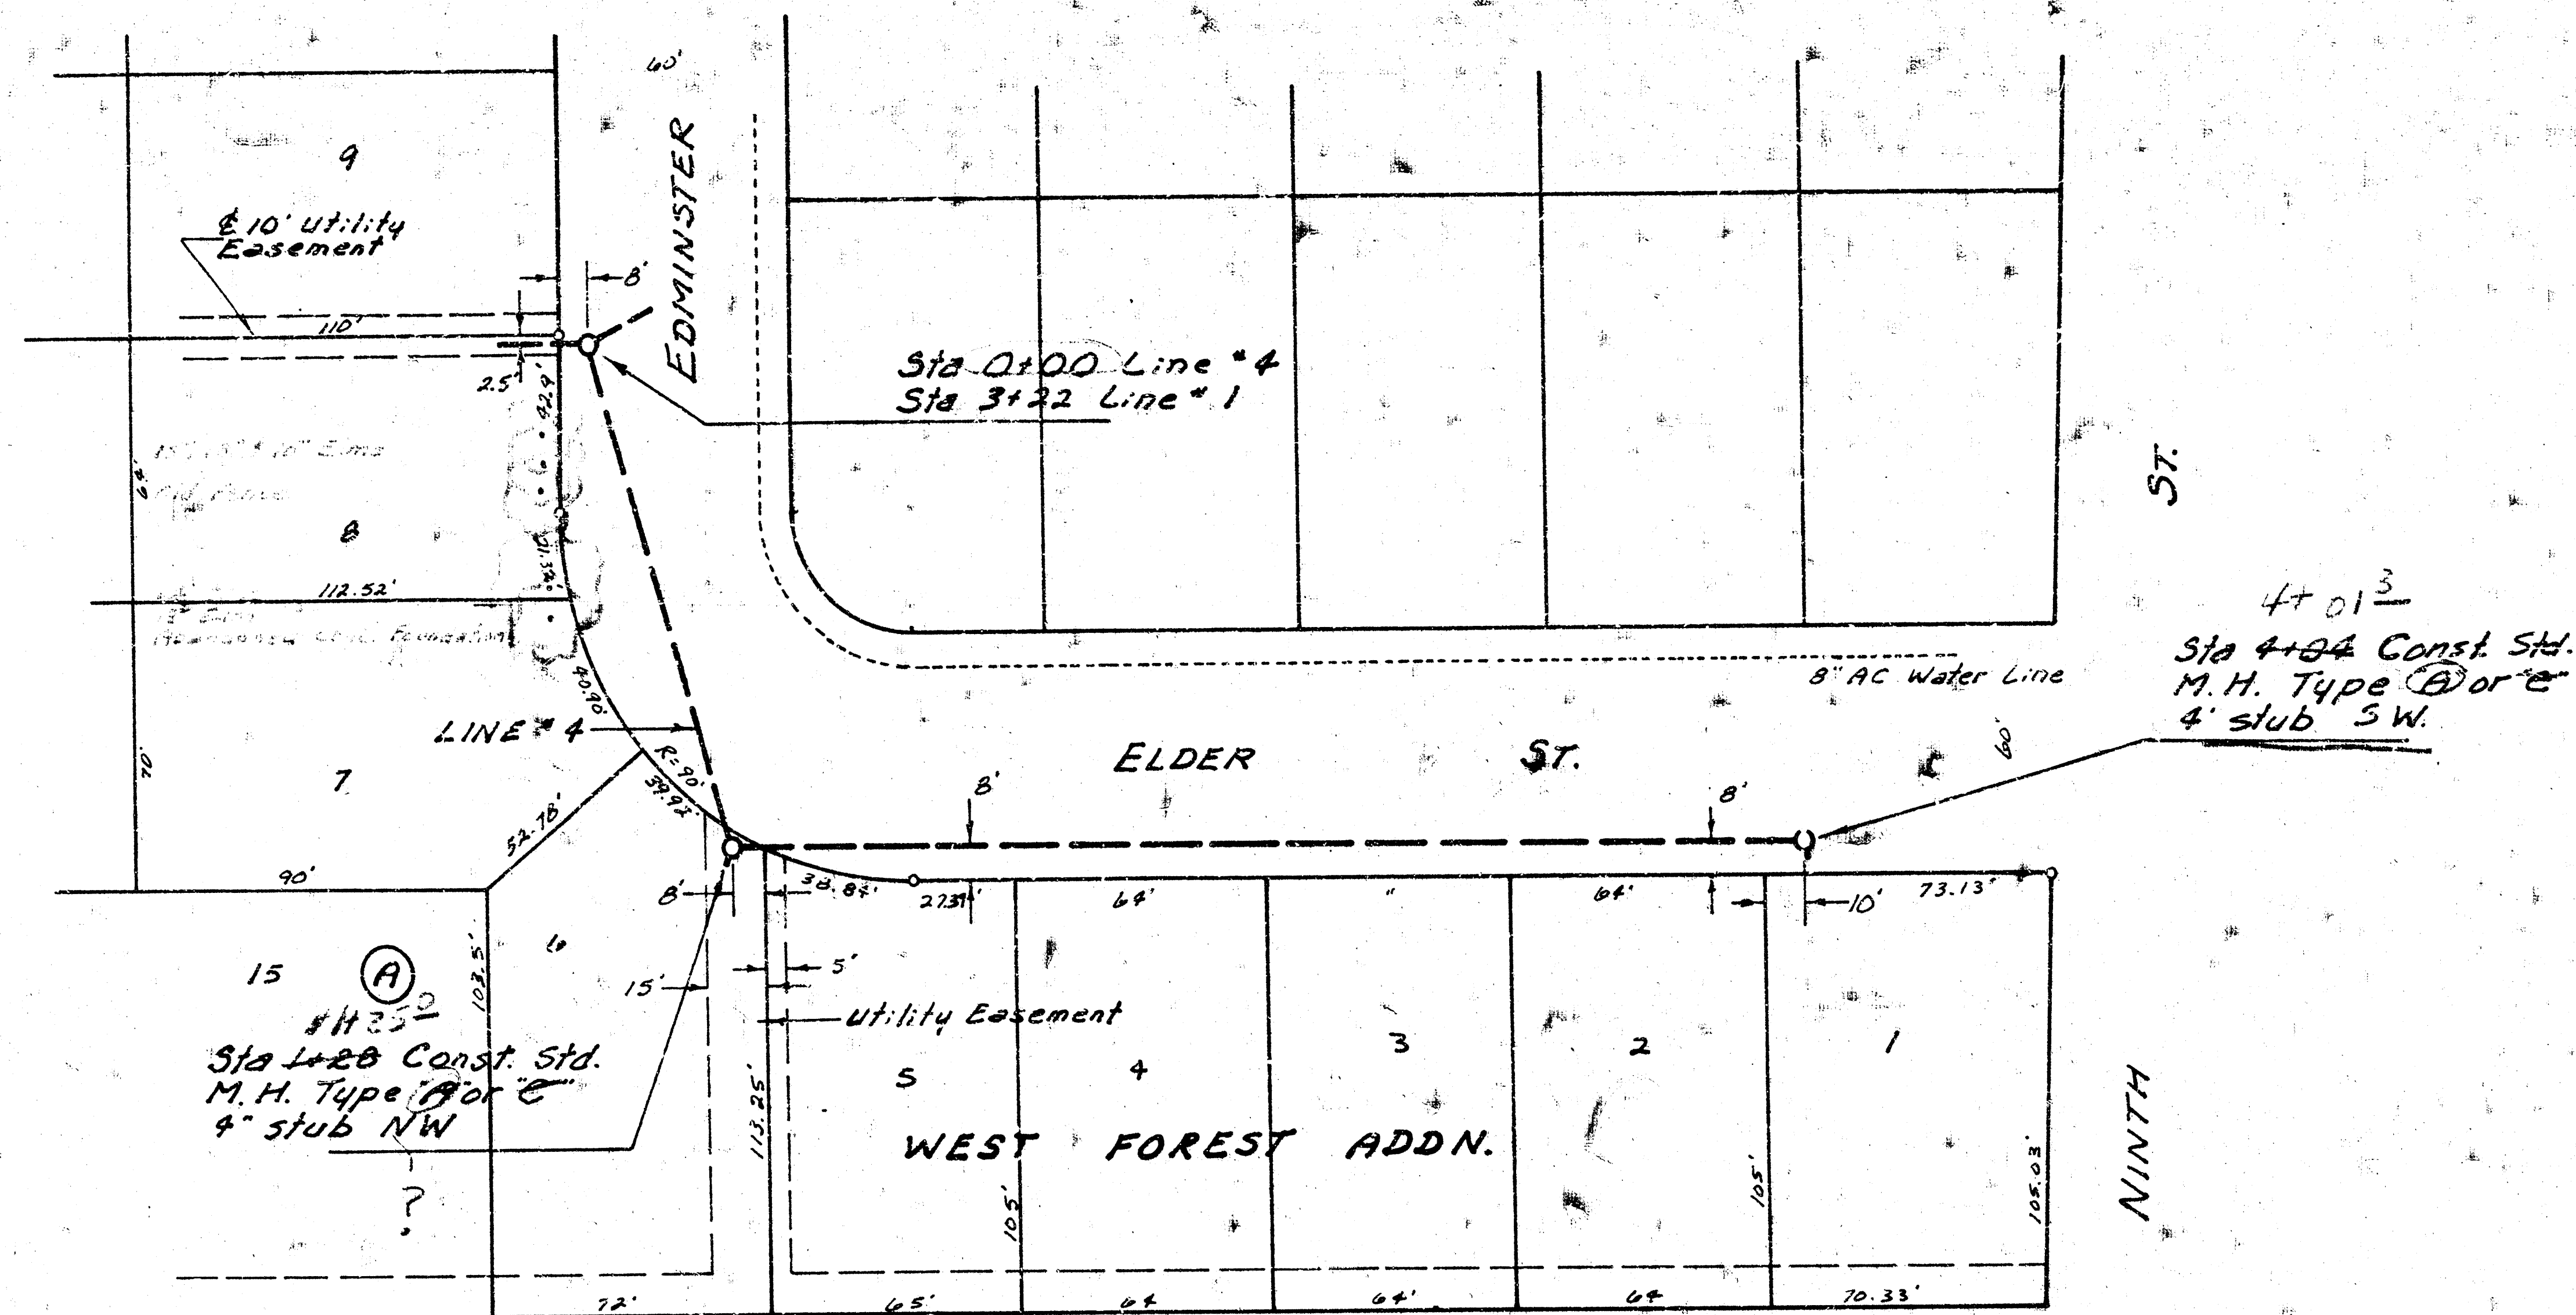

Scale Plan 1" = 40'
 Profile 1" = 40' Horiz.
 1" = 5' Vert.

