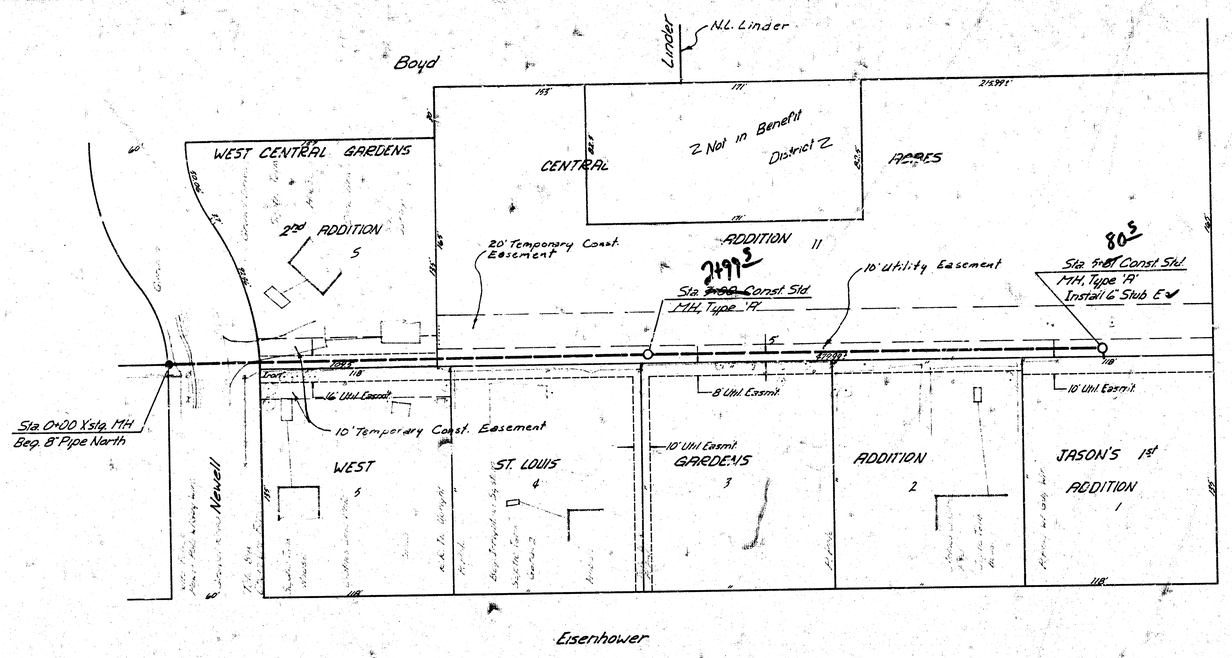

Z

SCALE
Hort. 1" = 40'
Vert. 1" = 5'

B.M. 132.55 City Std. Top of Wing Wall N.E. Corner Bridge, Central & Big Ditch

B.M. 126.04 N.E. Corner Concrete Porch to House @ 709 Eisenhower

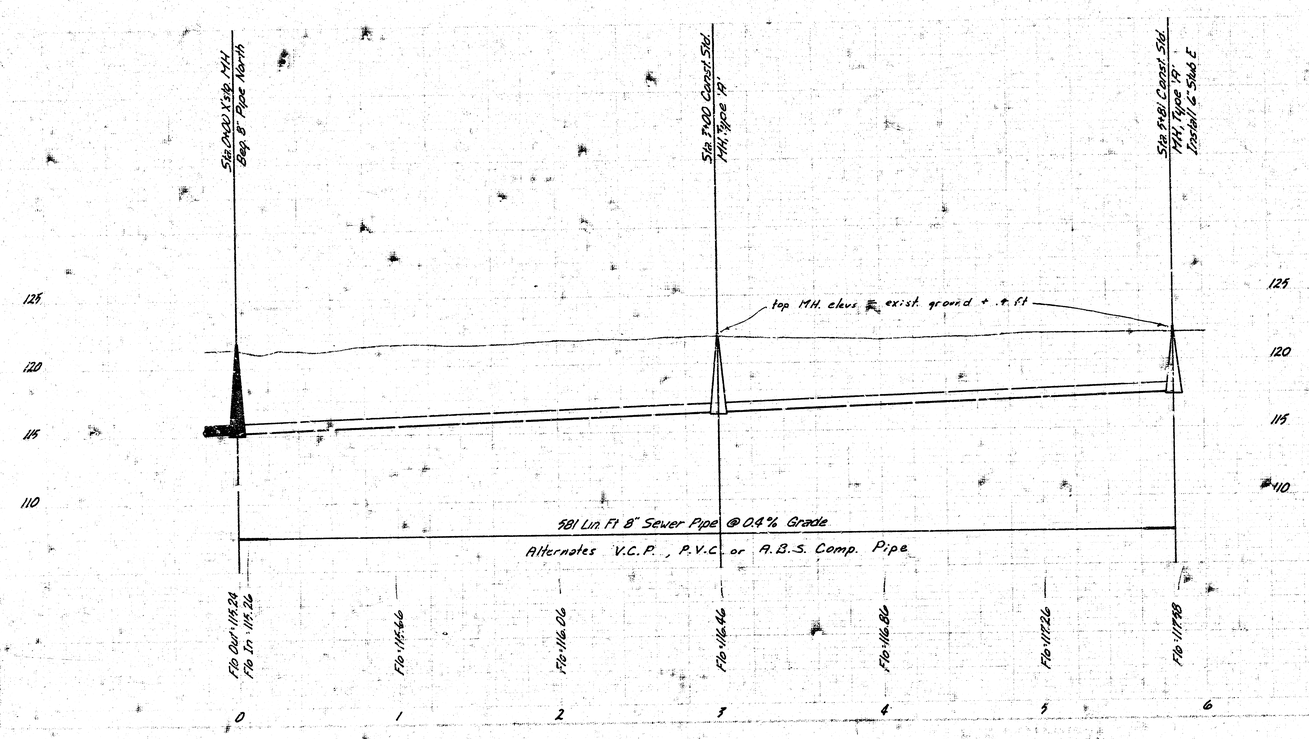

As Built
SFS
9/81

DONALD O. SCHMEDT
PROFESSIONAL ENGINEER
6311
KANSAS

Lat. 231, Maun 5, SS #22
468-76-245-80929-000-000-001
City of Wichita, Kansas
Dept. of Public Works - Eng. Div.
R.W. Bruggeman — City Engineer

FILMED FROM THE BEST AVAILABLE COPY.....