



SURVEY BY: KRAMER, INC. K-21
CHECKED BY: CHD
DATE: 10/15

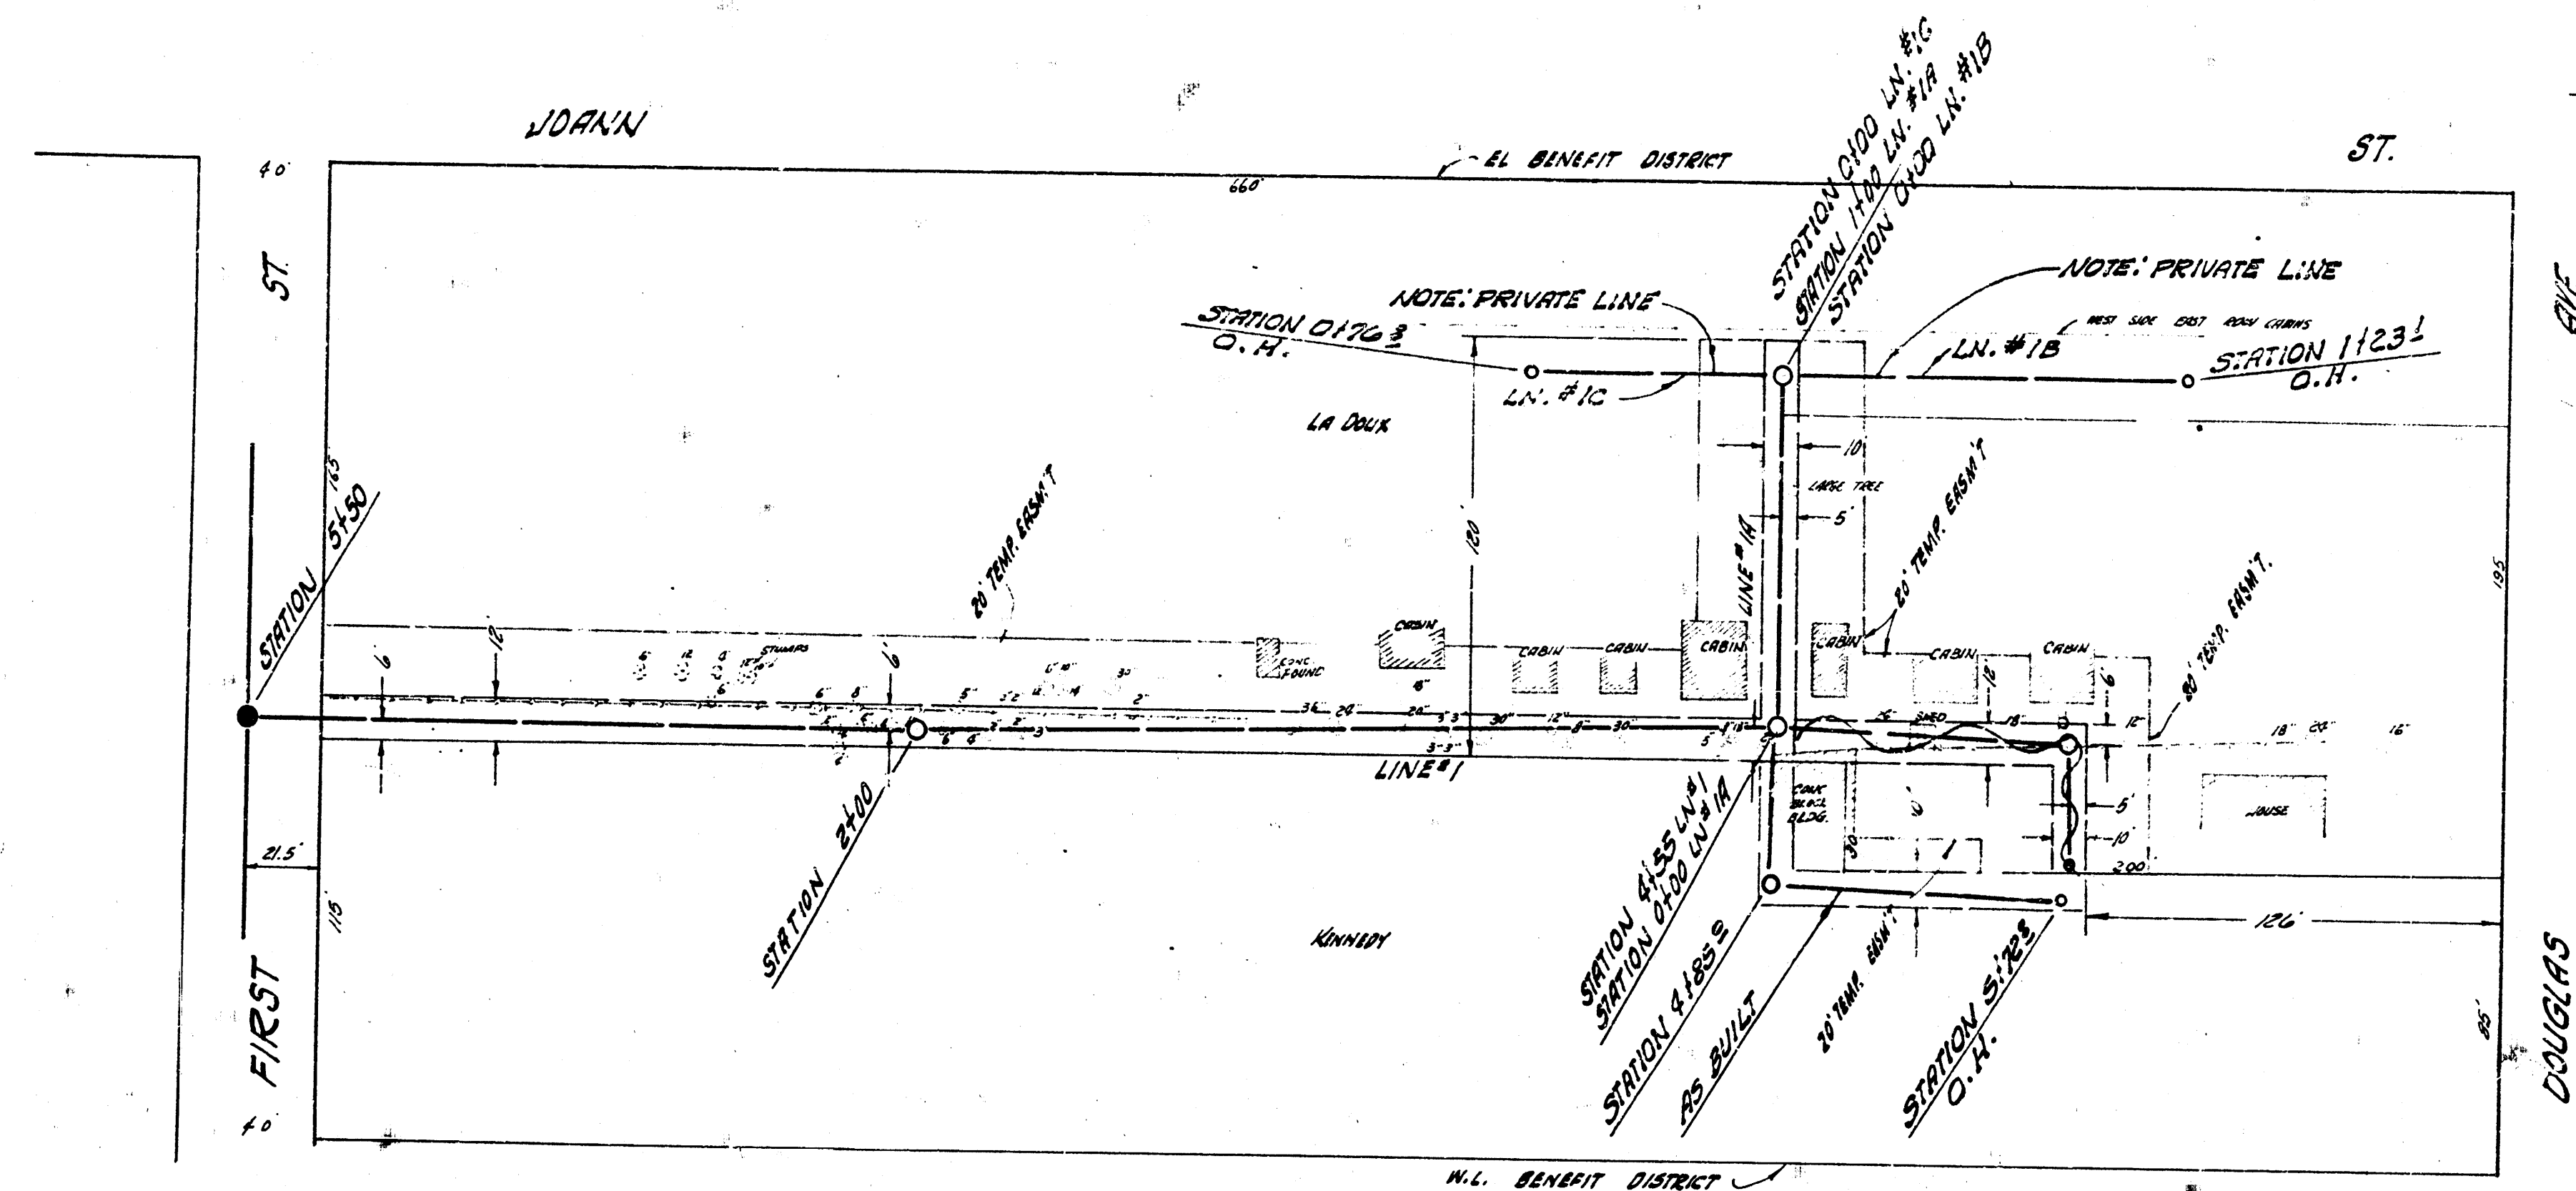

PLAN SCALE 1" = 40'
PROFILE SCALE 1" = 40' HOR. 1" = 4' VERT.

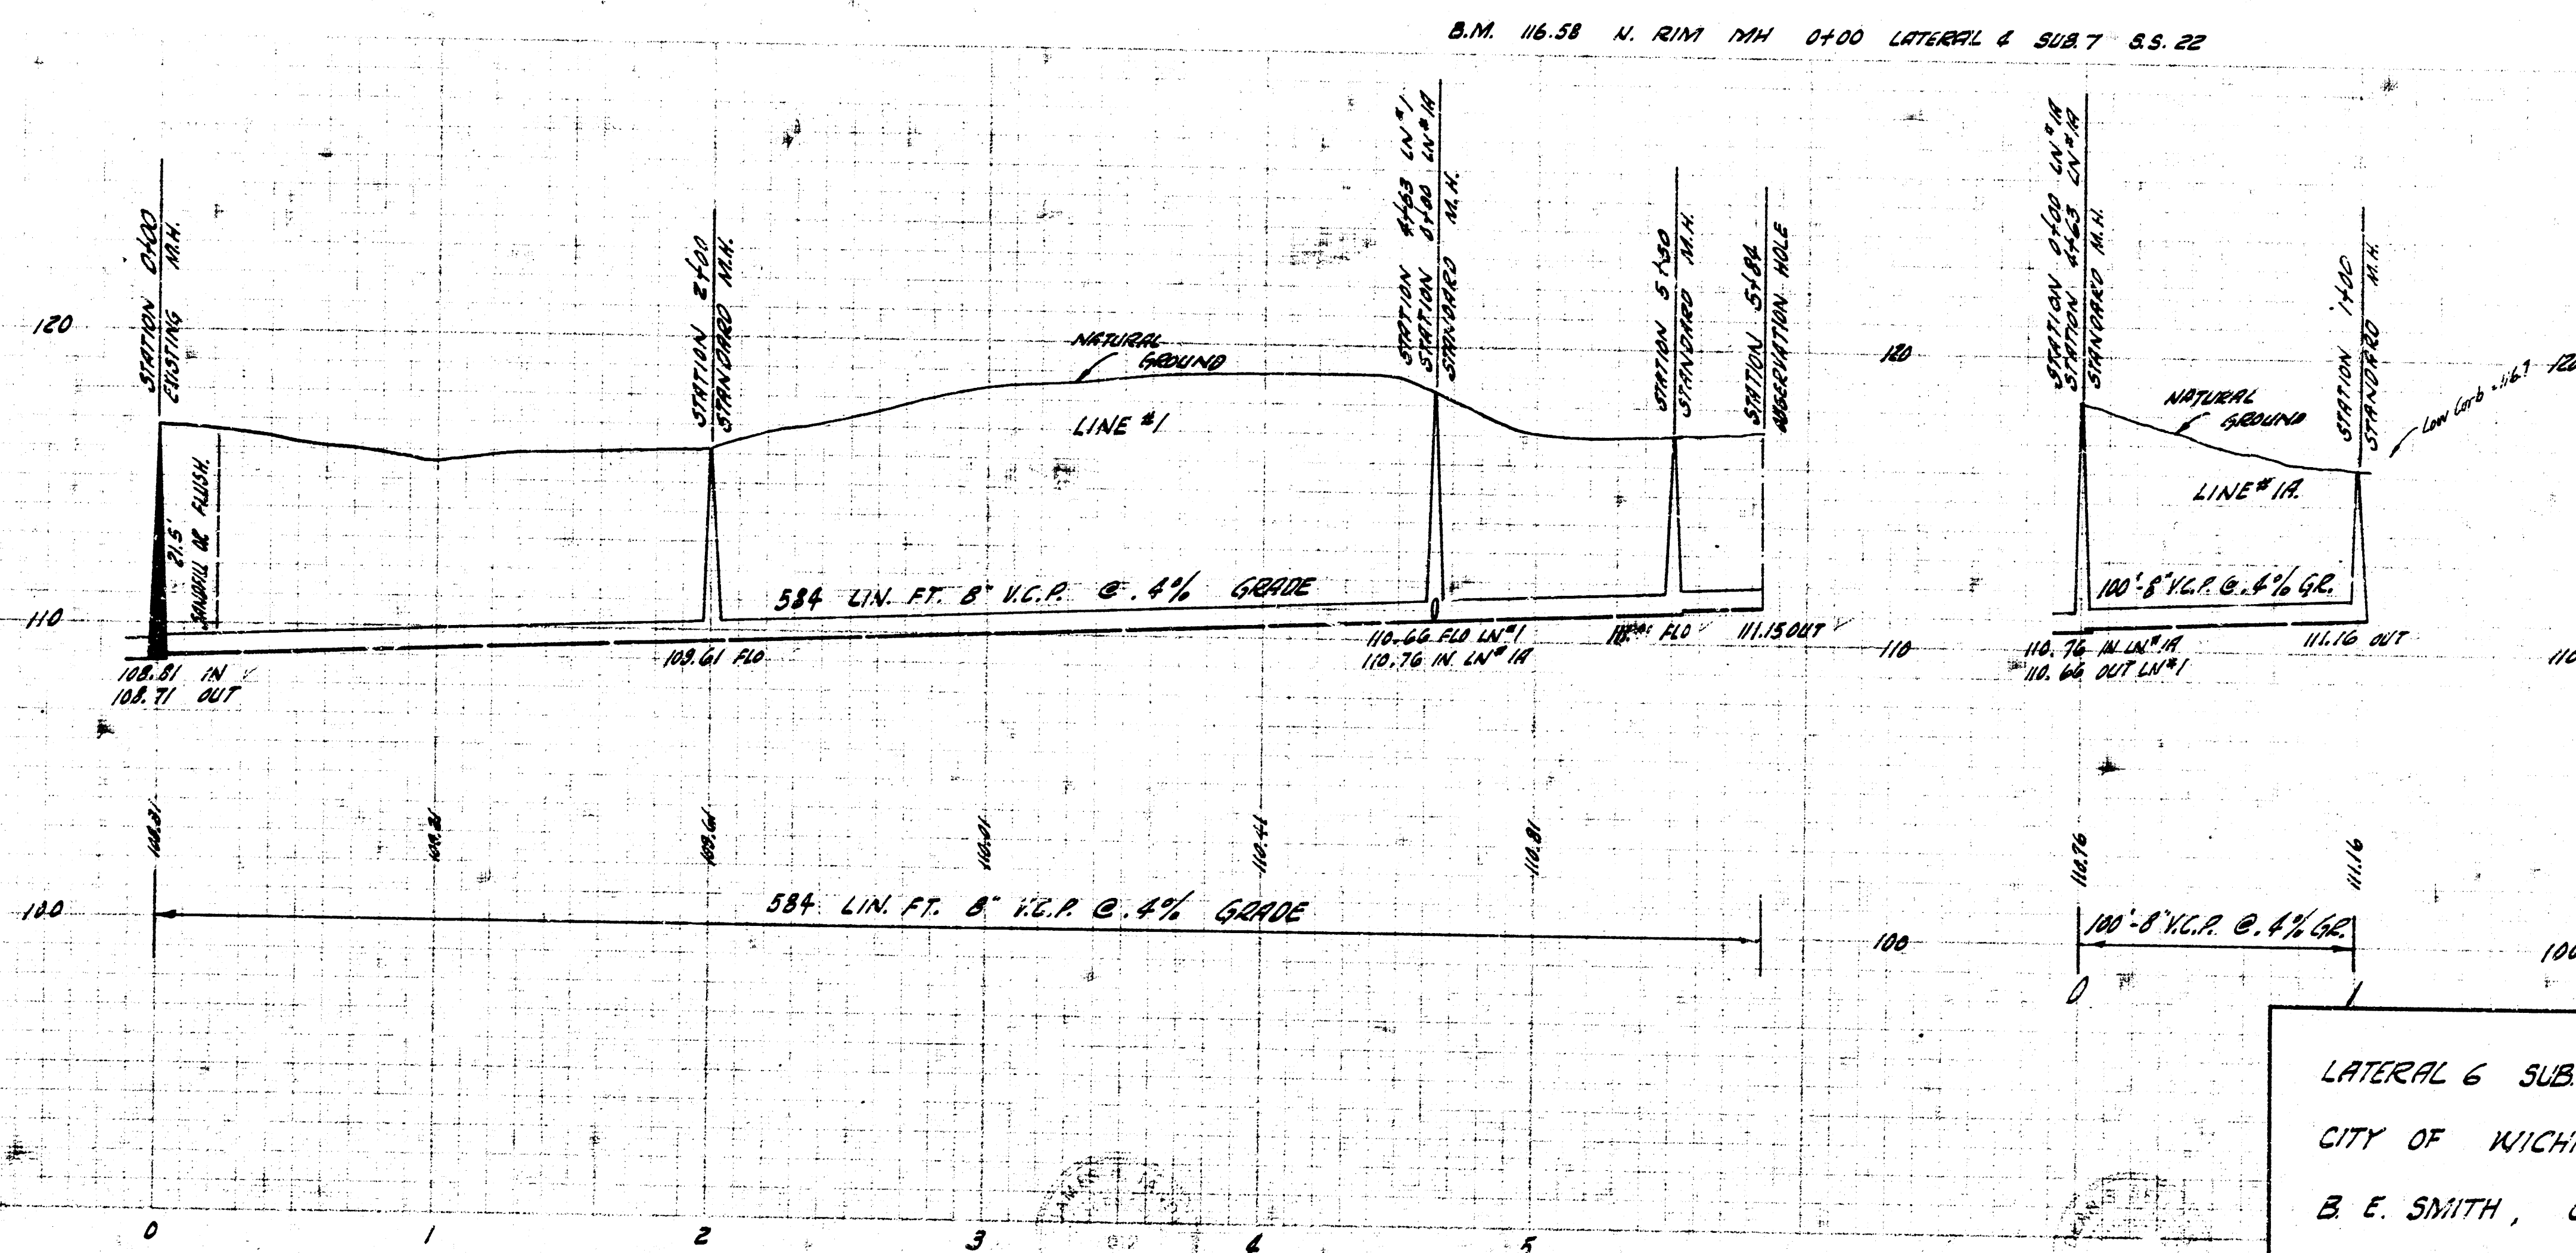

LATERAL 6 SUB. 6 S.S. 22
CITY OF WICHITA, KANSAS
B. E. SMITH, CITY ENGINEER
PROJ. NO. C27-44 SEPT. 1952