LOCATION MAP
SUBMAIN NO. 8, SANITARY SEWER NO. 22
CITY OF WICHITA, KANSAS
B.E. SMITH CITY ENGINEER PROJ. NO. C25-68



Submain 8 Sanitary Sewer 22
Project No. C25-68 Sheet 10/3

Survey by Hanson Brown & Company
Checked by
Date 1.11.26

ST. LOUIS AVE.

RESERVE "B"

AVE.

℄ SHERIDAN

CENTRAL AVE.

KNIGHT ACRES

Sta 0+00
Sta 1+45.81
Sta 1+78.25
Sta 4+50
Sta 7+28
Sta 9+28.5
Sta 11+62.5

20' Temp. Easement

20' Temp. Easement

NEWELL ST.

WESTRIDGE ST.

PEACOCK ADDITION 2

5 6 7 8

BM. 122.52 STAN. WEST & CENTRAL
BM. 118.53 SO. RIM M.H. STA 0+00
BM. 121.46 S.W. COR. CONC. PORCH H0^{m} 602 N. SHERIDAN

PLAN SCALE 1"=40'
PROFILE SCALE 1"=40' HOR, 1"=4' VERTICAL

Sta 0+00 Const. Special Drop Manh.

Sta 1+45.81 Prop. M.H.
Sta 1+78.25 Prop. M.H.
Sta 4+50 Prop. M.H.
Sta 7+28 Prop. M.H.
Sta 9+28.5 Prop. M.H.
Sta 11+62.5 Prop. M.H.

Natural ground

120
110

1200 Lin. Ft. 8" V.C.P. @ .3% Grade

107.50 In
107.98 Ft. 108.01 Ft
103.04 8" S. 110.00 In 8" N.
108.85 Ft
103.68 Ft.
113.70 Ft 8" Stub N.
110.26 Ft
110.99 Ft
111.02 Ft 8" Stub N.

36"
101.63 Ft Out


107.50 108.10 108.40 108.70 108.80 109.30 109.60 109.90 110.20 110.50 110.80 111.10

1200 Lin. Ft. 8" V.C.P. @ .3% Grade

70' Cone Cradle

0 1 2 3 4 5 6 7 8 9 10 11 12

Submain 3 Sanitary Sewer 22
Project No. 025-68 Sheet 2 of 3

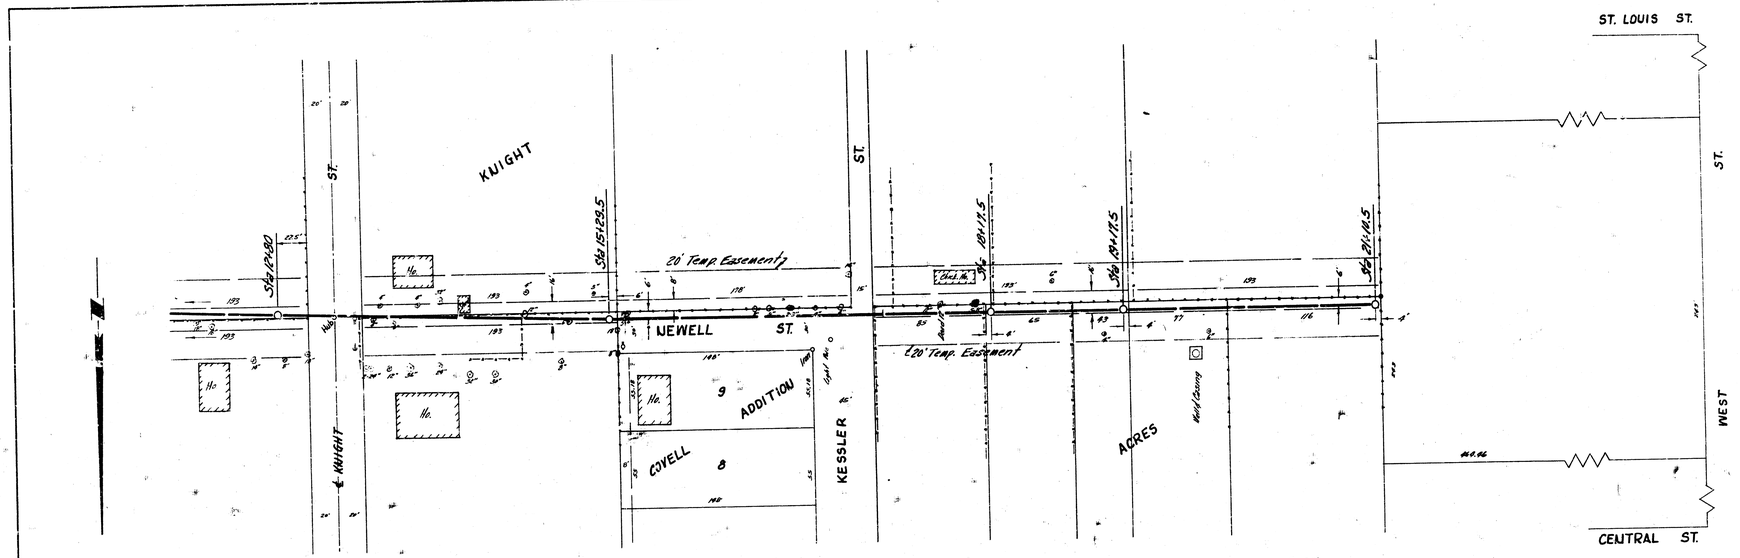

Subsewer B Sanitary Sewer 62
Project No. C25-68 Sheet 3 of 3