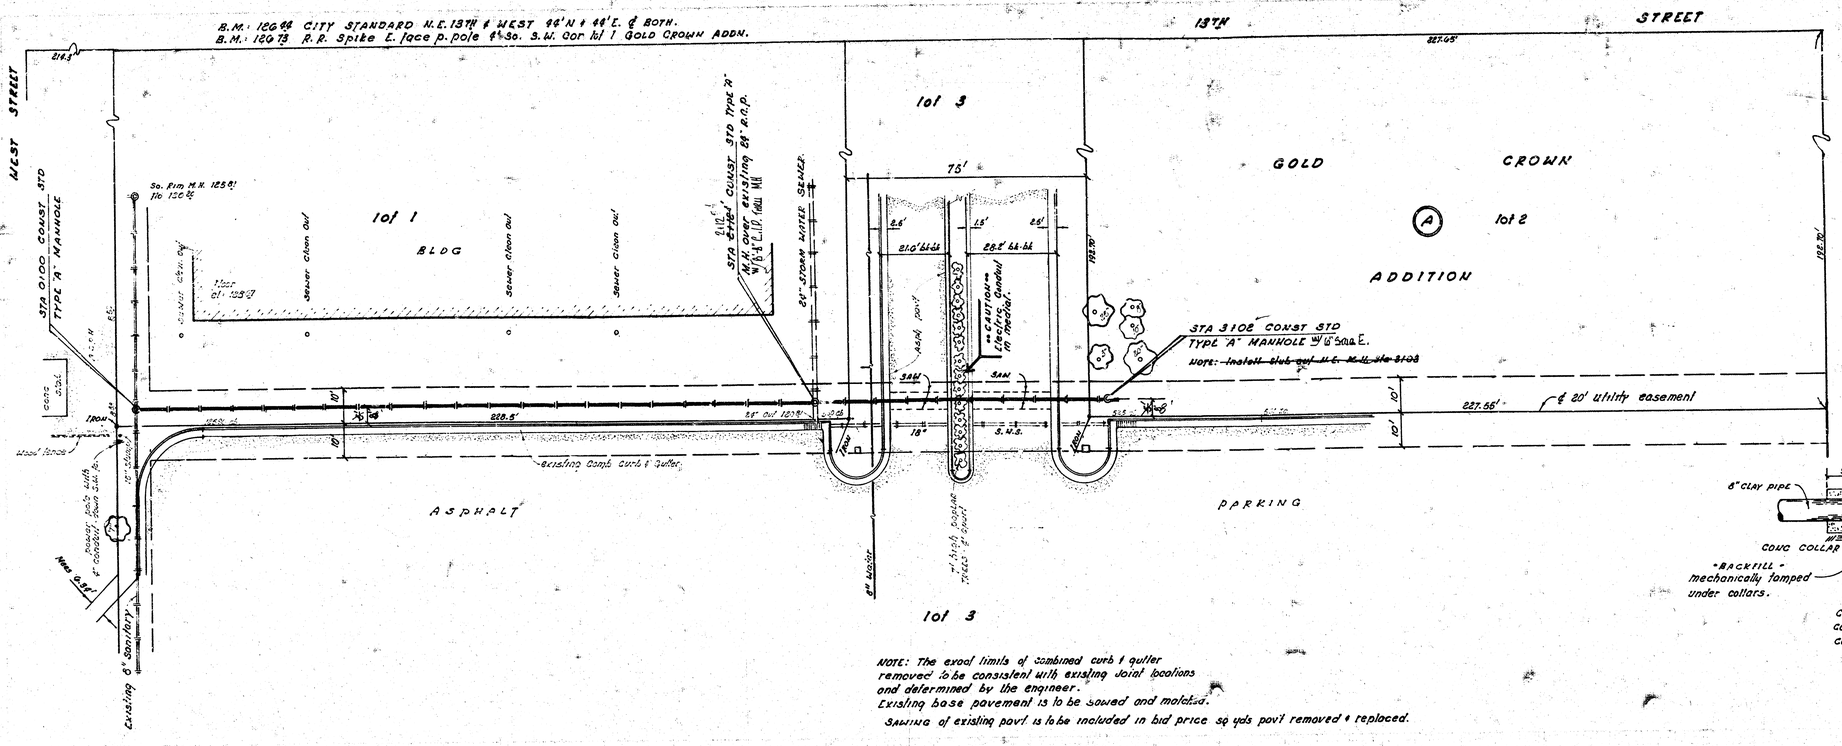

NOTE: The exact limits of combined curb & gutter removed to be consistent with existing joint locations and determined by the engineer.
Existing base pavement is to be sawed and matched.
SAWING of existing pavt. is to be included in bid price sq yds pavt removed & replaced.

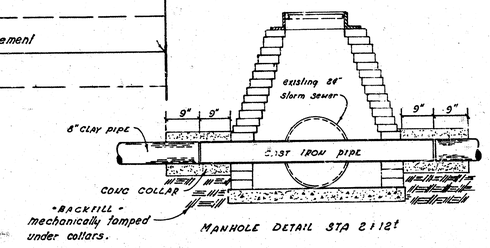

MANHOLE DETAIL STA 2+12±

Concrete collars and compacting fill under collars is to be included in bid price L.F. cast iron pipe.

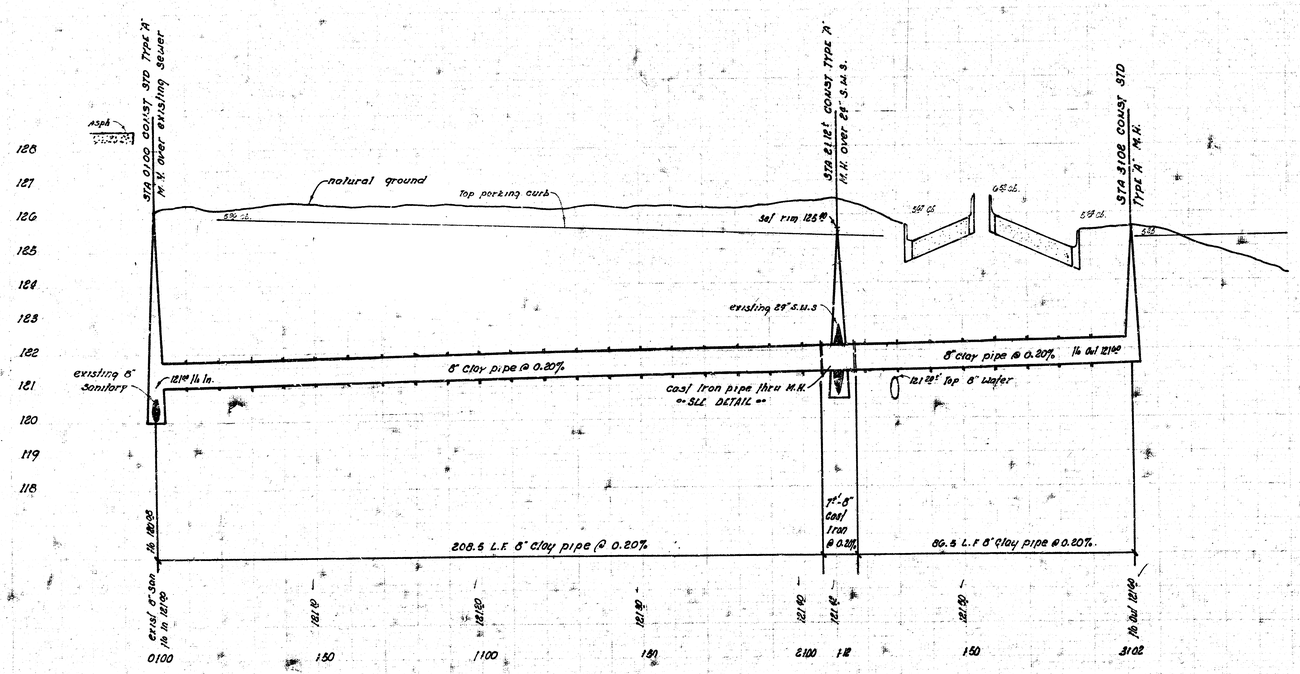

DEAN S. SELLERS LICENSED 3683 KANSAS PROFESSIONAL ENGINEER

DONALD E. SCHNEIDER LICENSED 6311 KANSAS PROFESSIONAL ENGINEER

AS BUILT FROM FINAL MEASUREMENTS IN SS BK #4

LATERAL 28, MAIN 9, S.S. # 22.
CITY OF WICHITA, KANSAS
R. W. LINN, CITY ENGINEER
DATE Sept 1972 PROJ No. DBKL 572043

14 4 5 14

FILMED FROM THE BEST AVAILABLE COPY