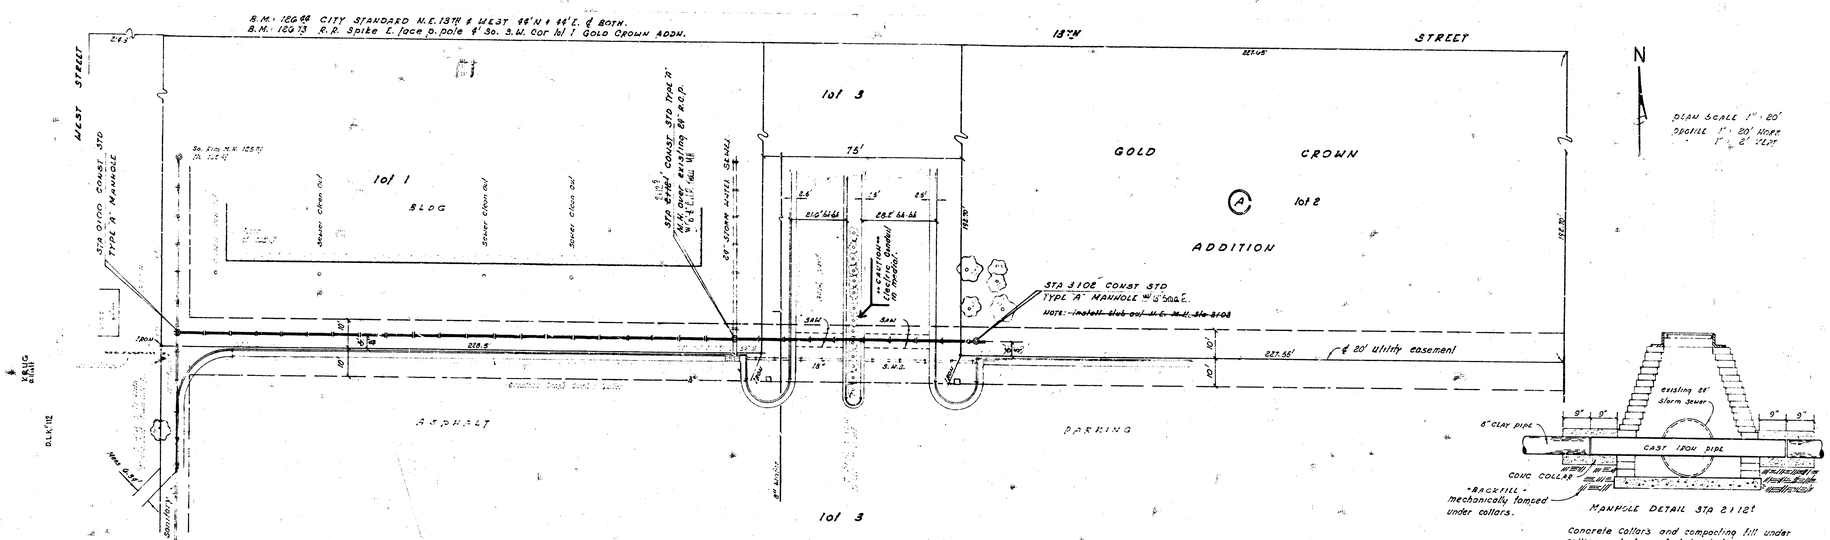

MANHOLE DETAIL STA 2112

Concrete collars and compacting fill under collars is to be included in bid price L.F. cast iron pipe.

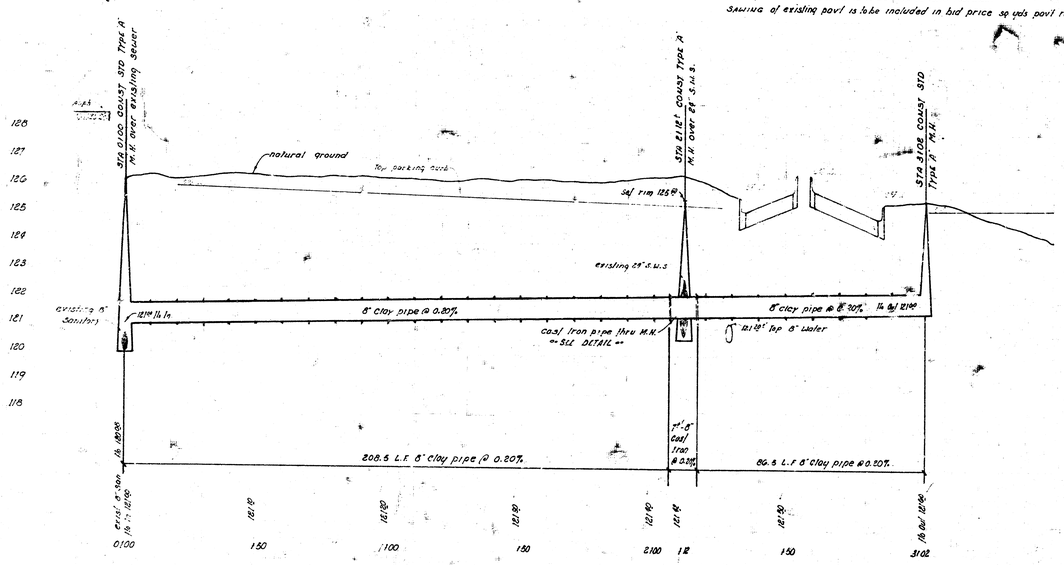

AS BUILT FROM FINAL MEASUREMENTS IN SS BK #4

LATERAL 28, MAIN 9, S.S. # 22.

CITY OF WICHITA, KANSAS

R. W. LINN CITY ENGINEER

DATE Sept. 1972 PROJ. # DBKL 572043

DONALD E. SCHNEIDER REGISTERED 6311 KANSAS PROFESSIONAL ENGINEER

KRUG DLK 112