


SEVEN EIGHT 4 77

11-82

Dr.
WESTRIDGE

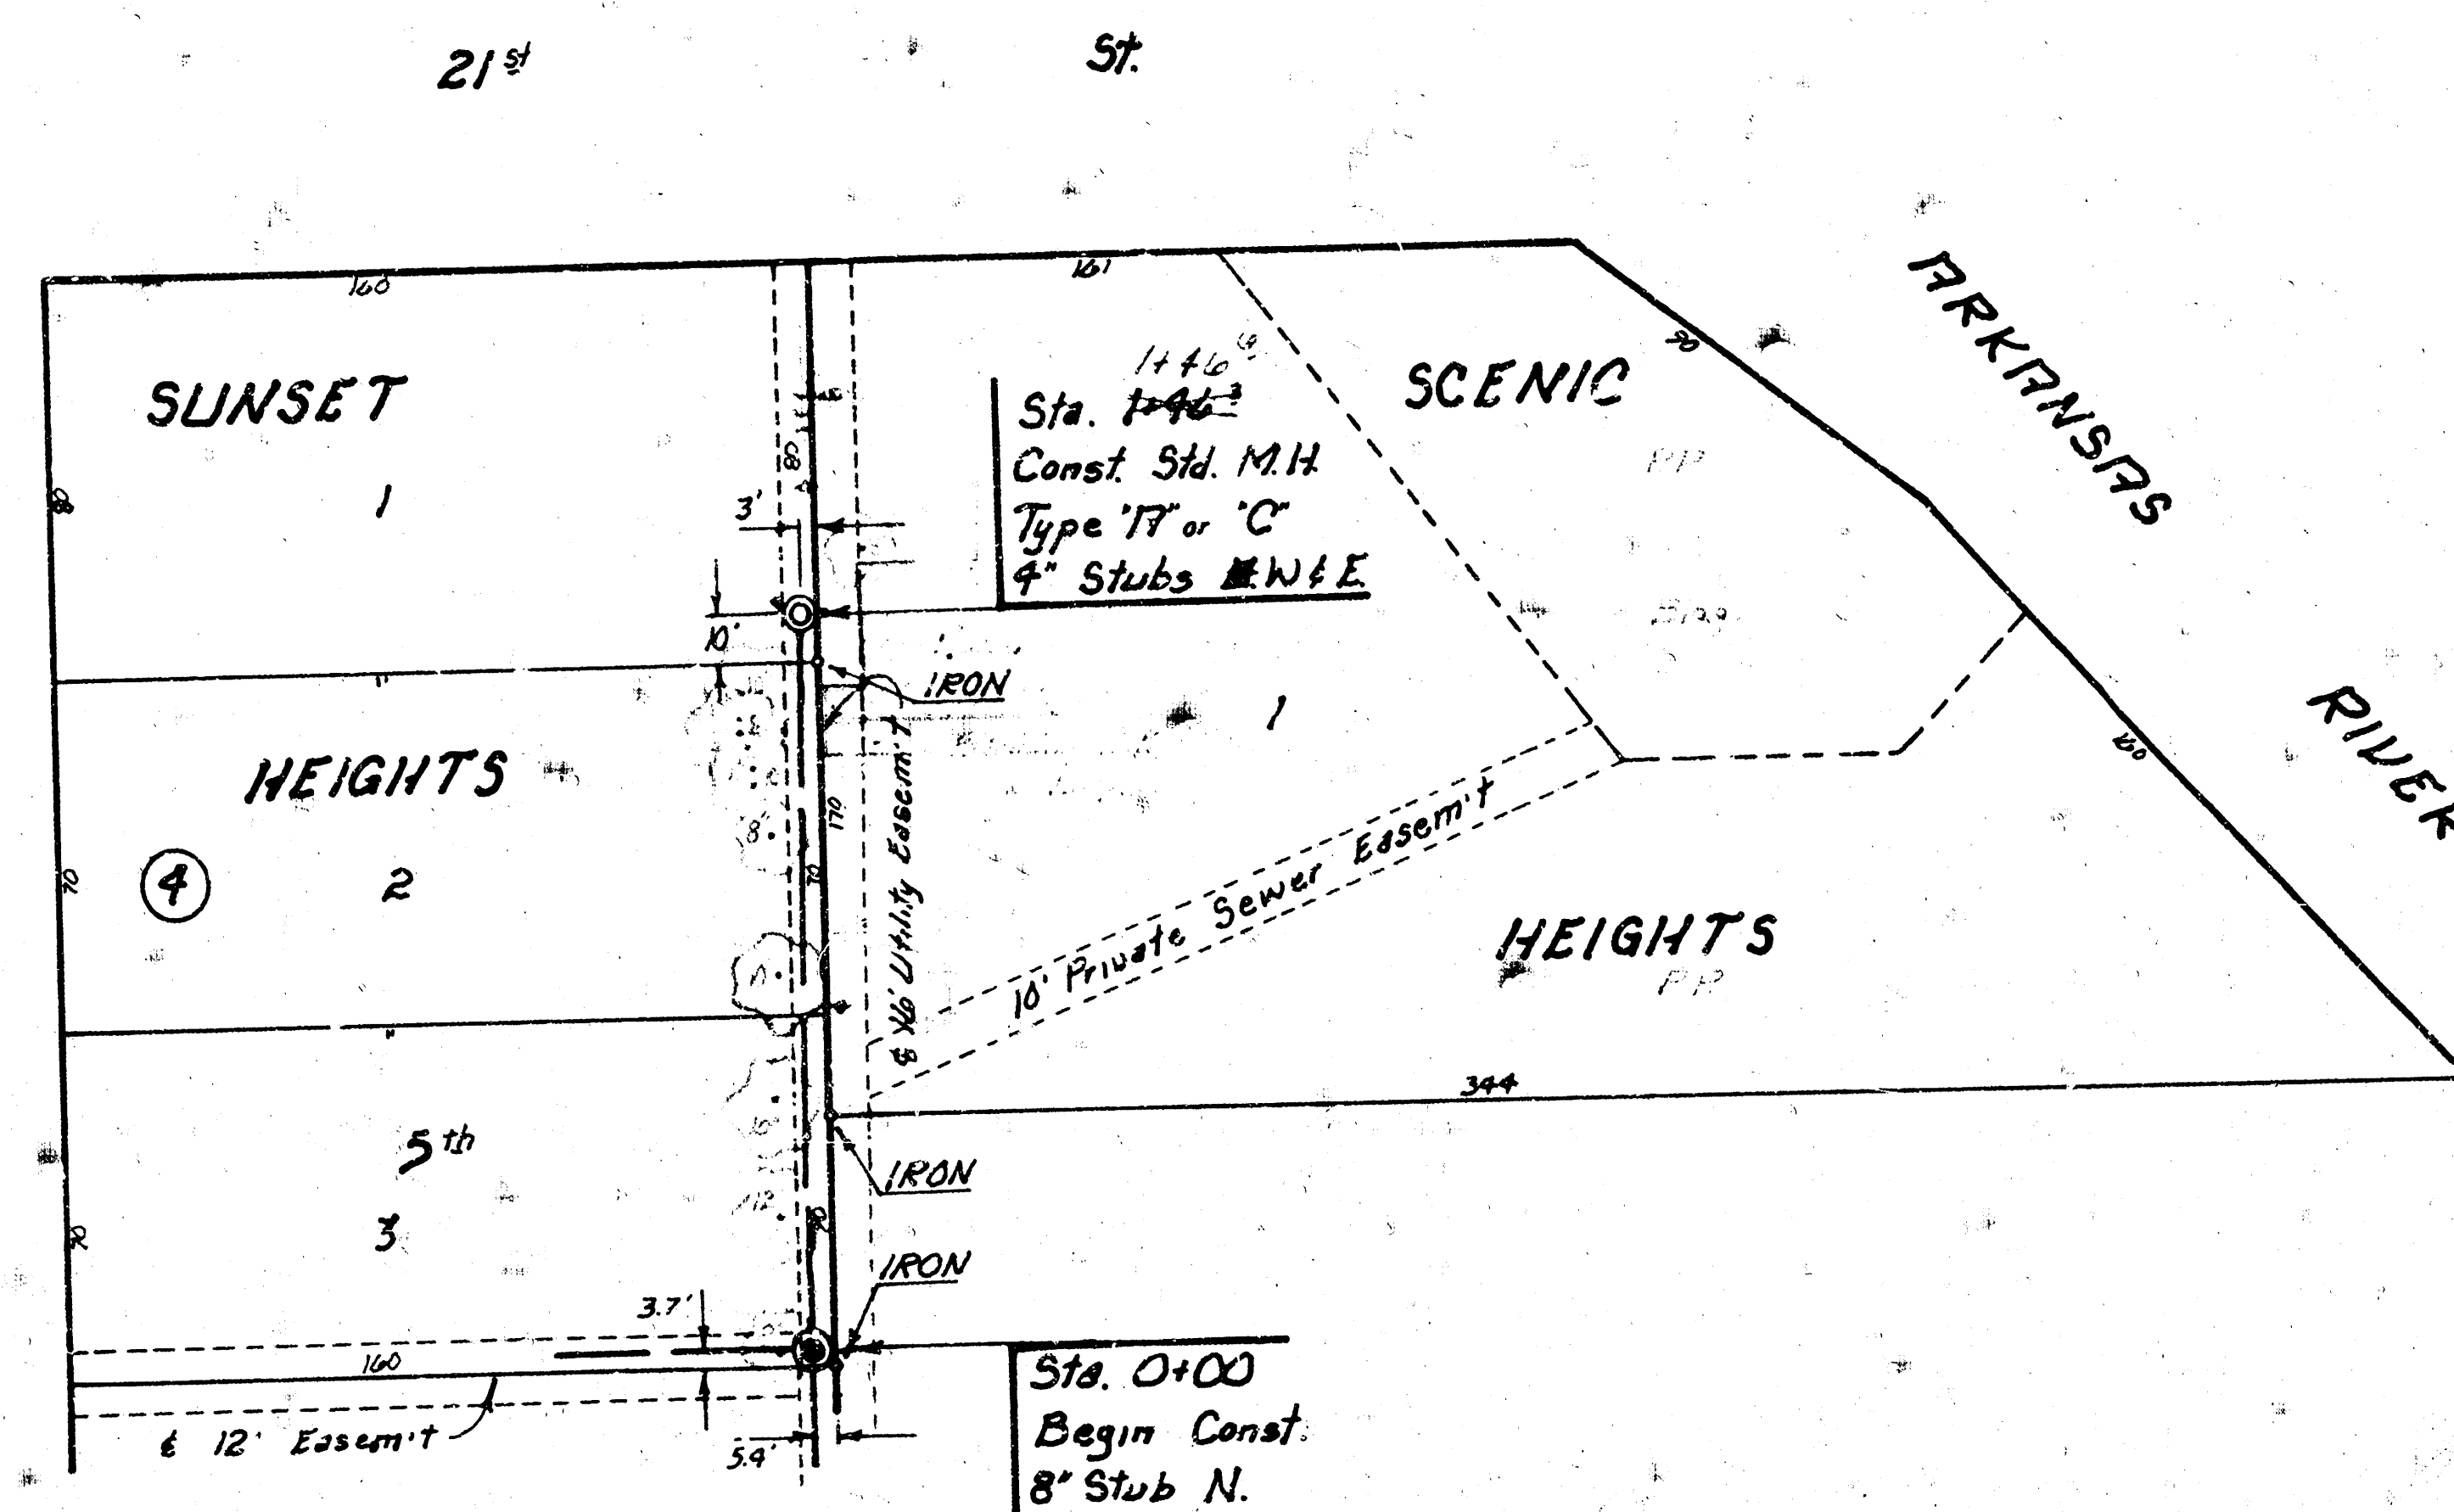

NOTE: CONTRACTORS METHODS FOR CONSTRUCTING THIS PROJECT SHALL BE SUCH THAT WILL PREVENT DAMAGE OF ANY TREES AND RETAINING WALL.

B.M. 132.91 N.E. Cor. Can. Porch
2117 W. RIDGE Dr.

SCALE


Plan 1" = 40'
Profile 1" = 40'
Horz 1" = 40'
Vert 1" = 5'

135

130

125


120

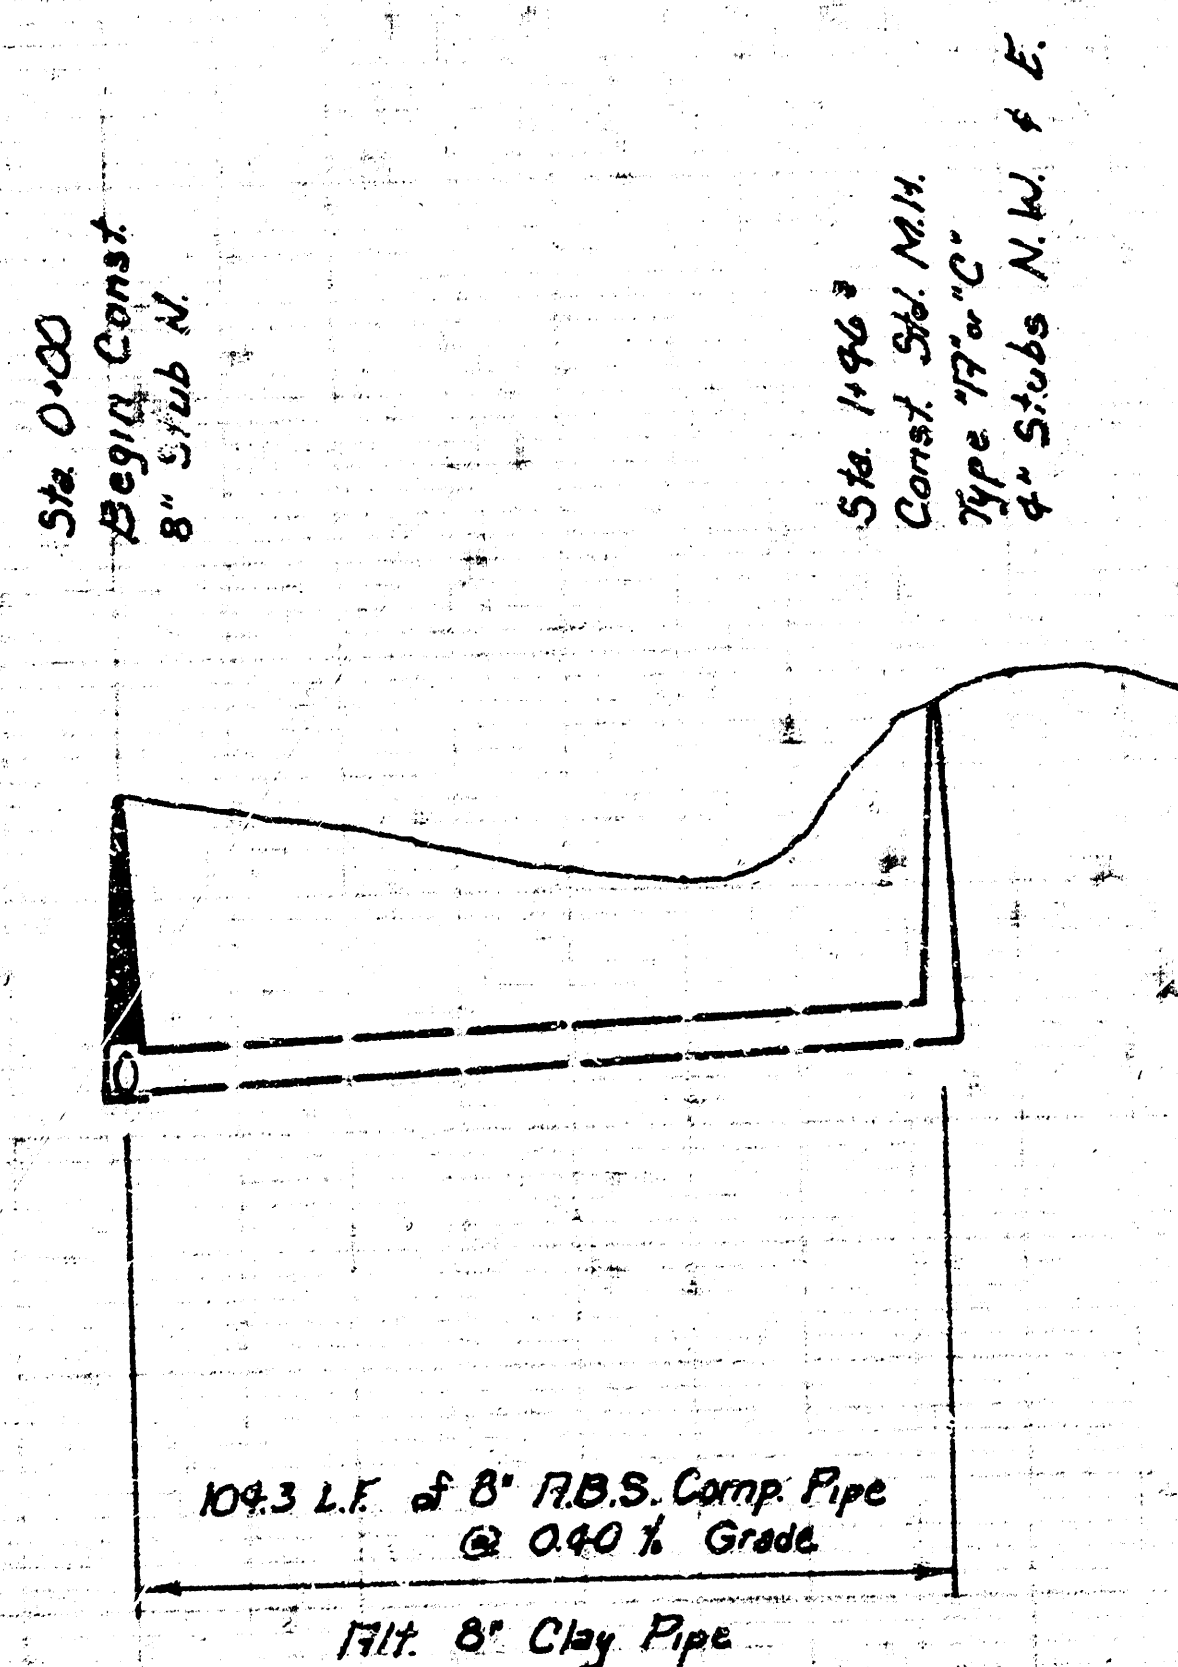

125.8 ft. Old
126.0 ft. New

120.0

120.0

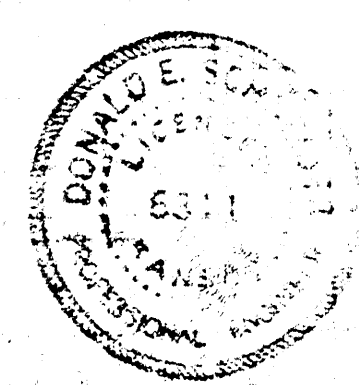

As Bldg
2/2/97

Lat. 37, Main 10, S.S. No. 22
City of WICHITA, KANSAS
R.W. LINN CITY ENGINEER
PROJ. NO. 468-76-245-80732-000-000-001
DATE: