



SURVEY BY KELLER & ASSOCIATES
 DRAWING BY C.D.
 CHECKED BY
 DATE

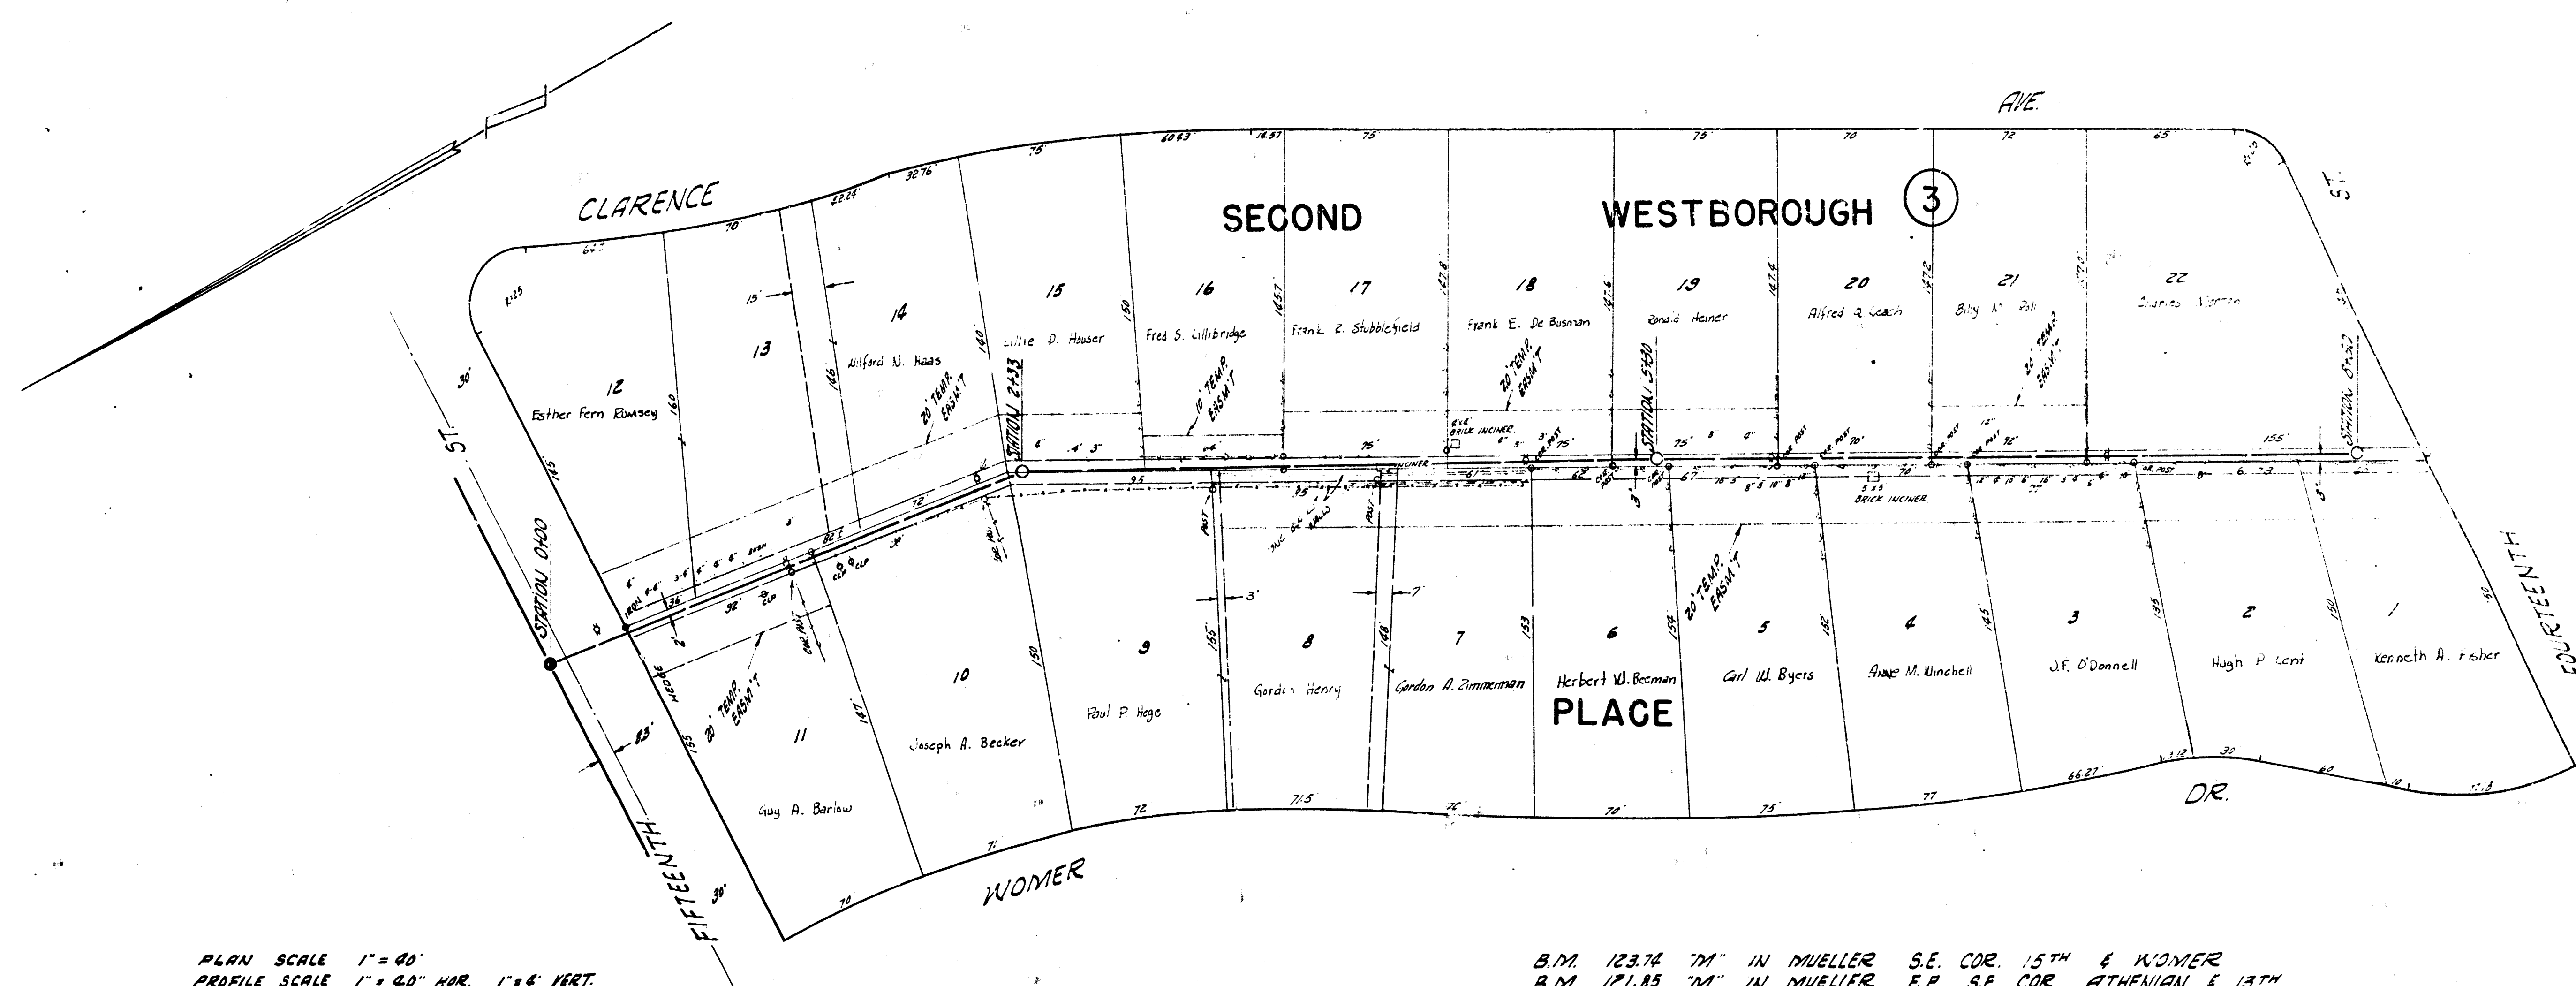

PLAN SCALE 1" = 40'
 PROFILE SCALE 1" = 4.0' HOR. 1" = 4' VERT.

B.M. 123.74 "M" IN MUELLER S.E. COR. 15TH & WOMER
 B.M. 121.85 "M" IN MUELLER F.P. S.E. COR. ATHENIAN & 13TH

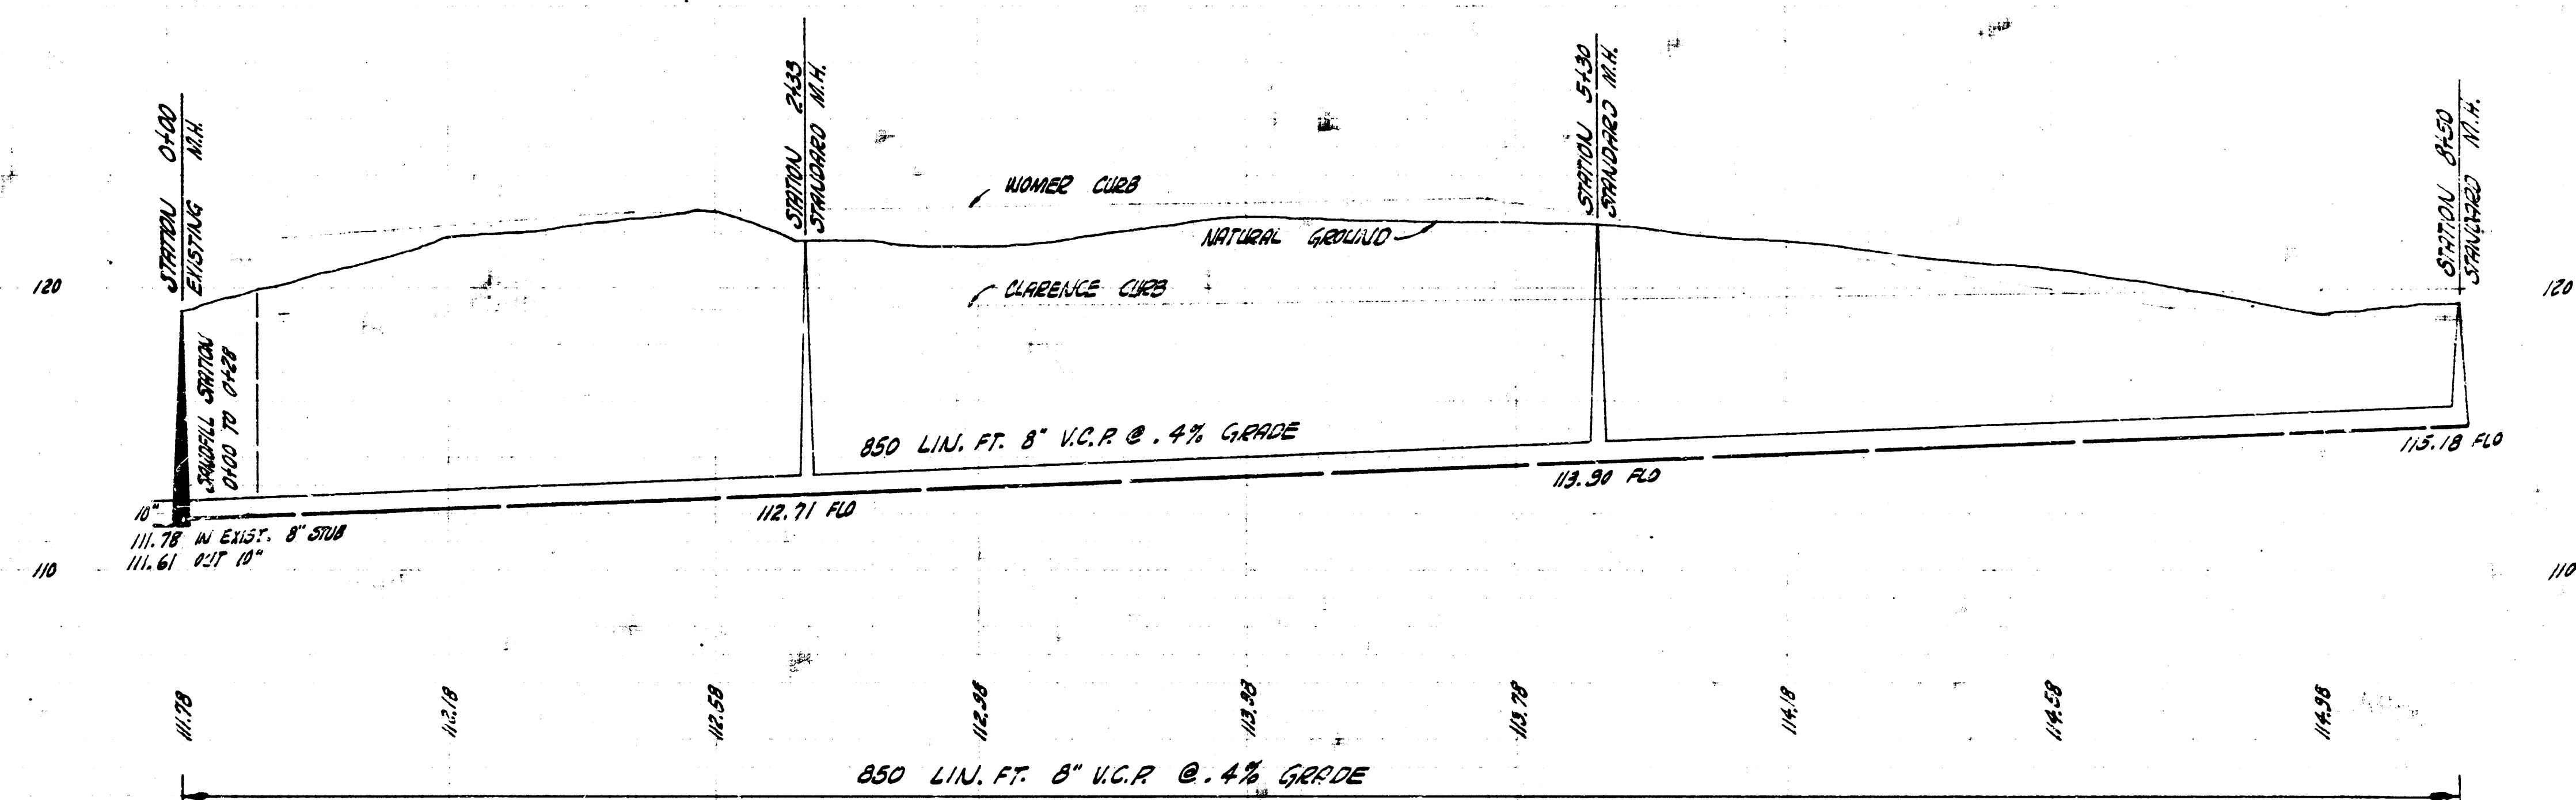

LATERAL 12 SUB 13 S.S.22
 CITY OF WICHITA, KANSAS
 B. E. SMITH, CITY ENGINEER
 PROJ. NO. C27-40 SEPT. 1958