



Survey
Plans
By
B. E. Smith
Checked by
B. E. Smith

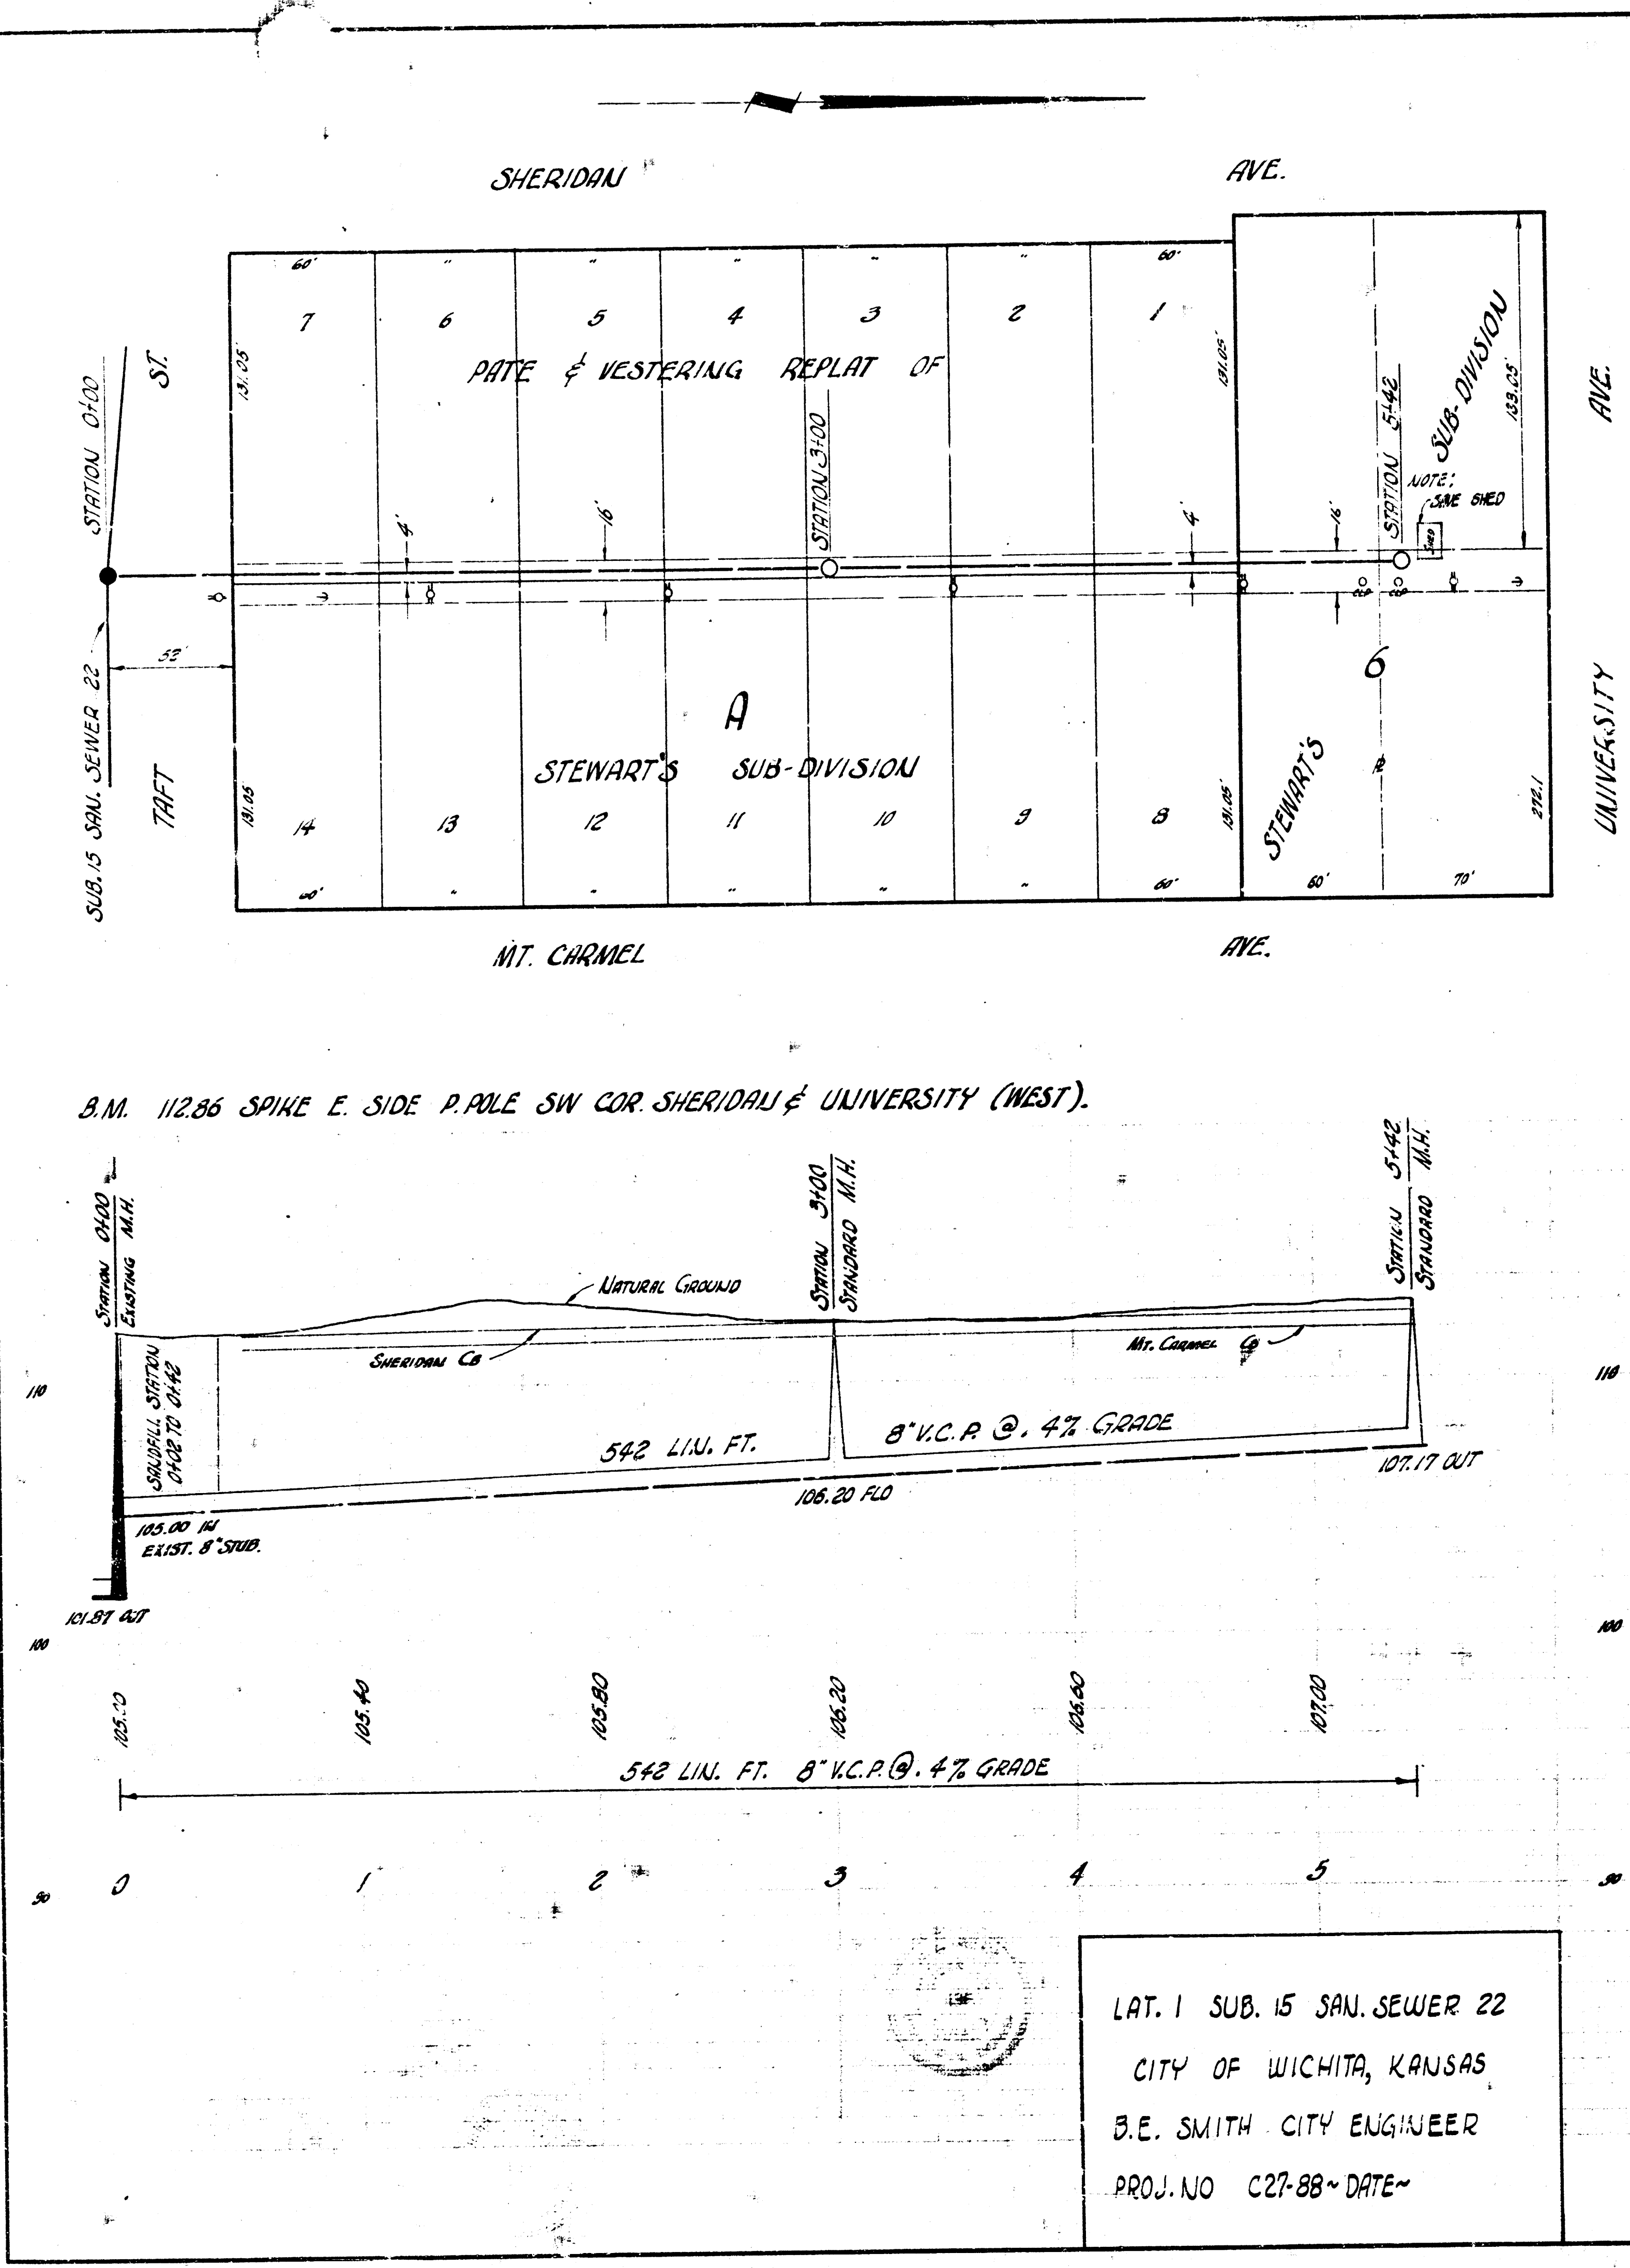

LAT. 1 SUB. 15 SAN. SEWER 22
CITY OF WICHITA, KANSAS
B.E. SMITH CITY ENGINEER
PROJ. NO C27-88~DATE~

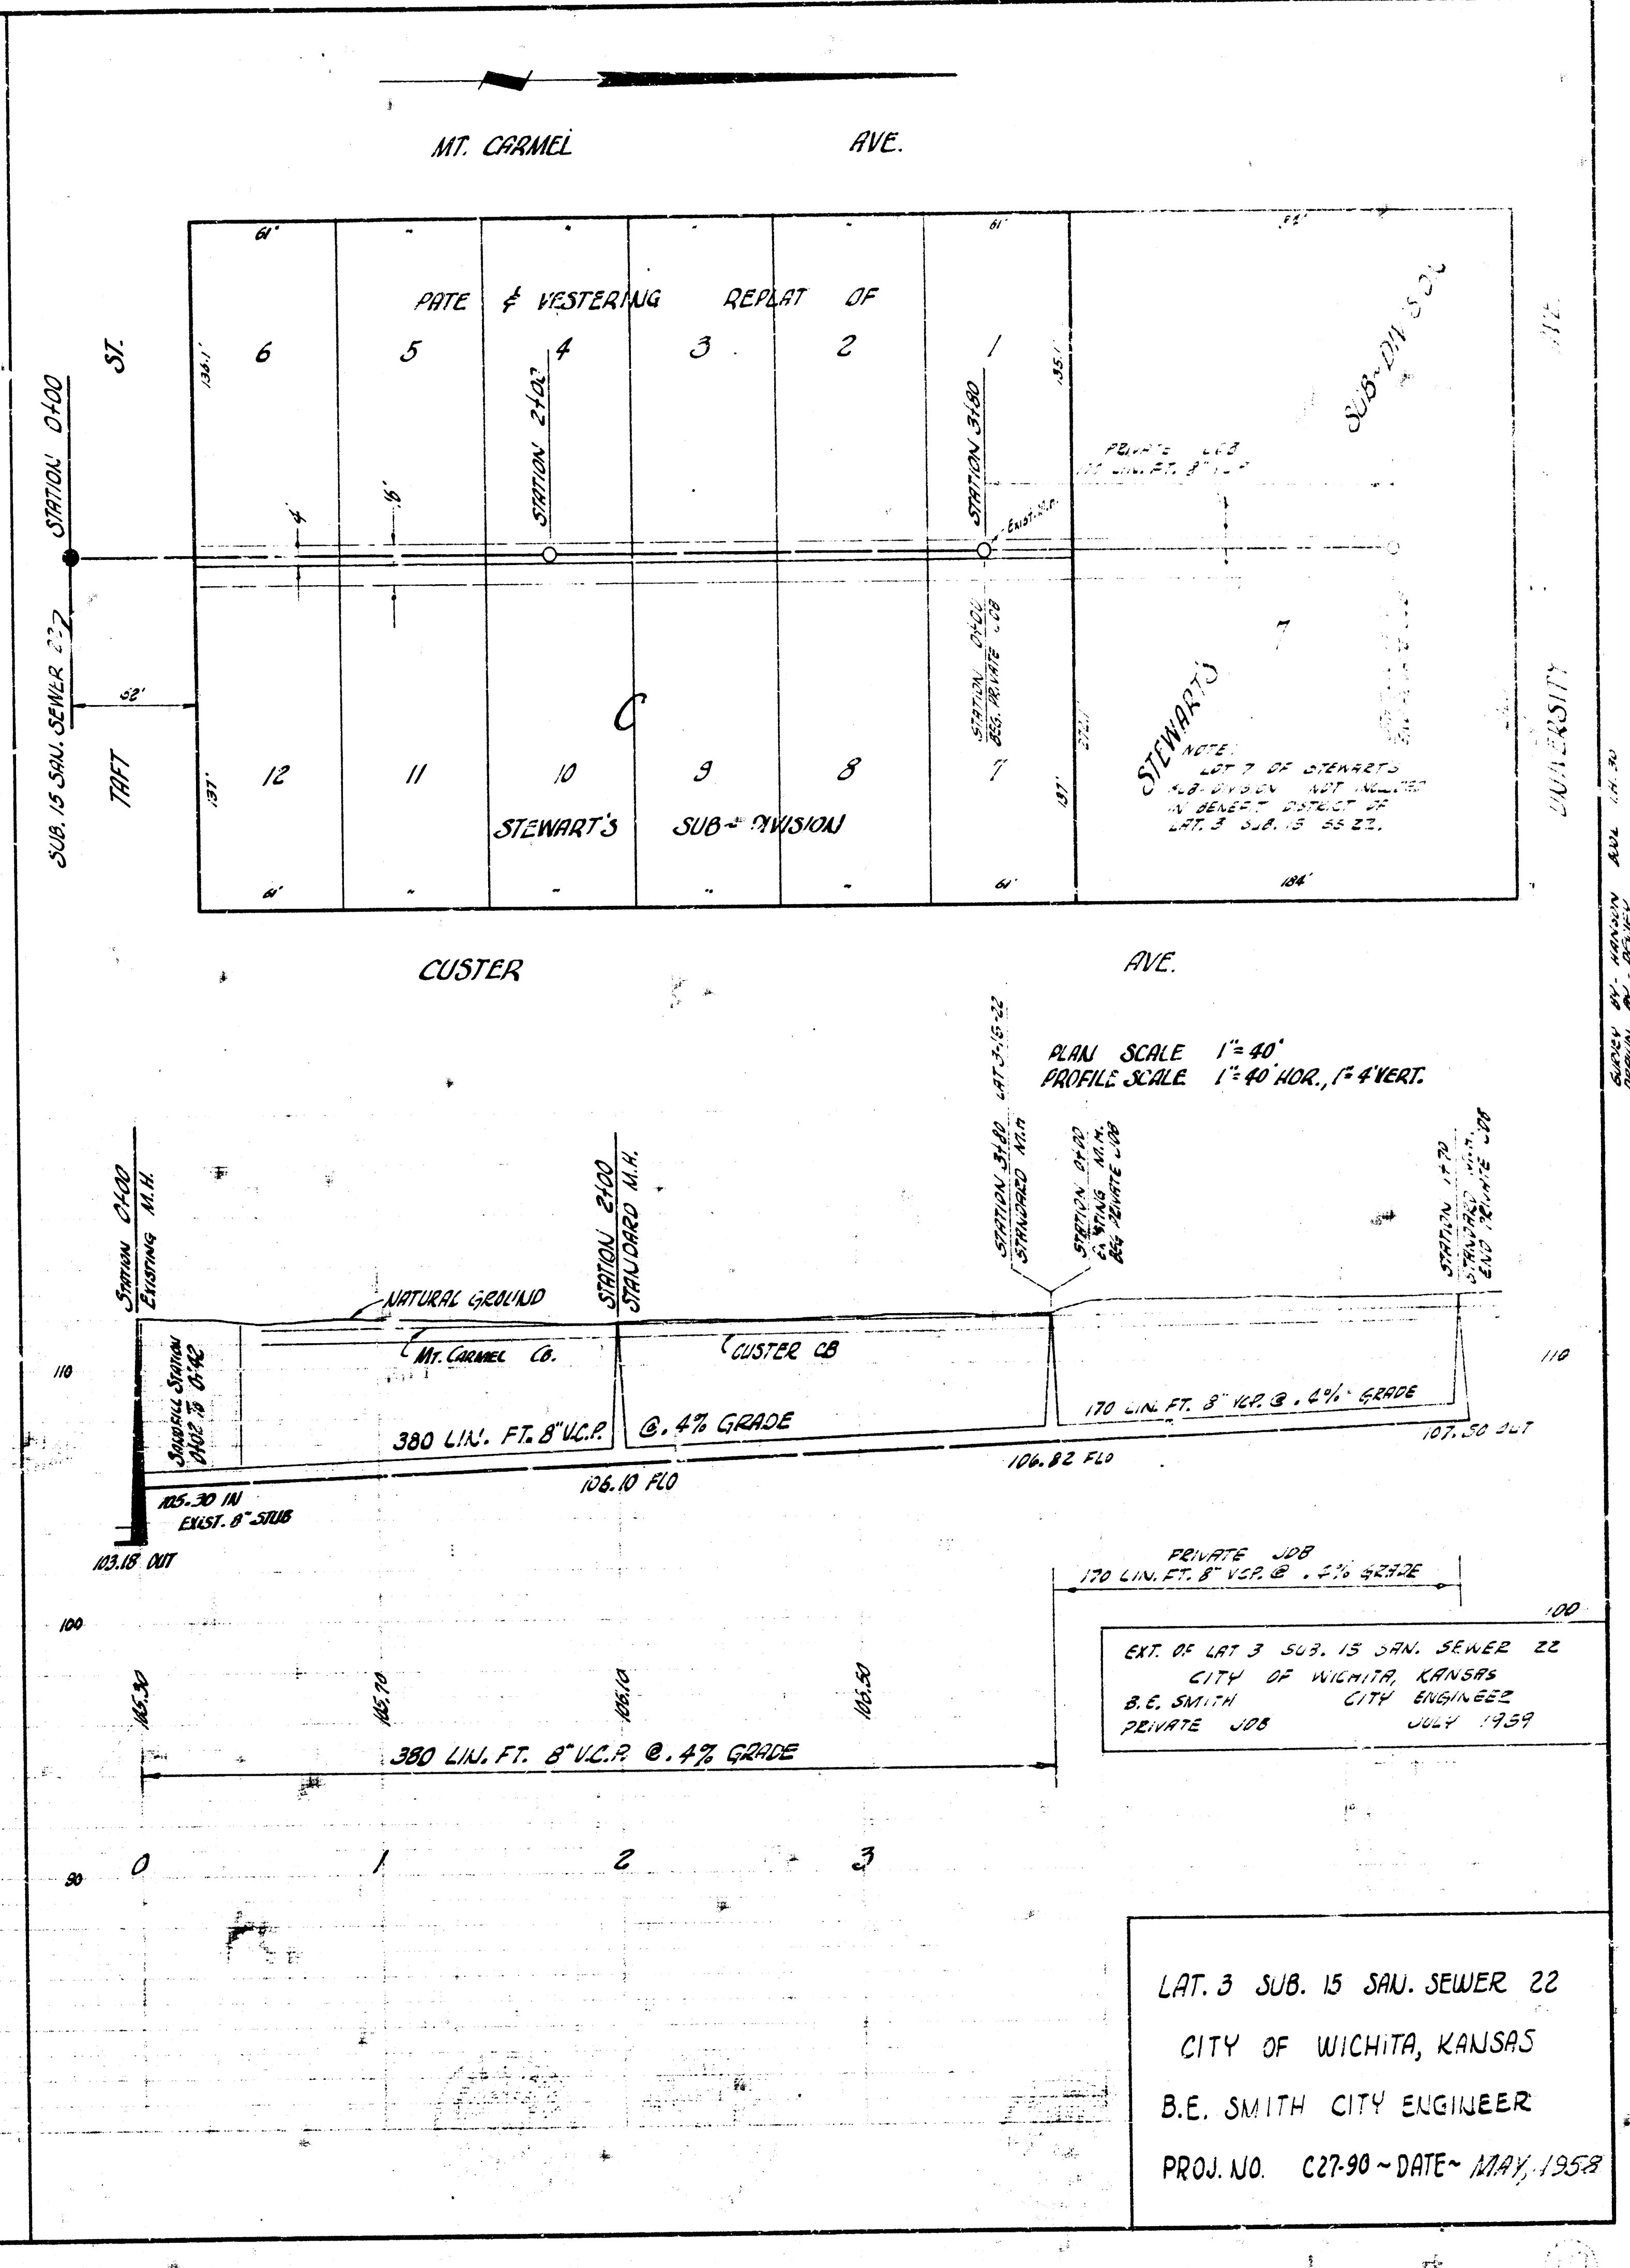

LAT. 3 SUB. 15 SAN. SEWER 22
CITY OF WICHITA, KANSAS
B.E. SMITH CITY ENGINEER
PROJ. NO C27-90~DATE~ MAY, 1958