

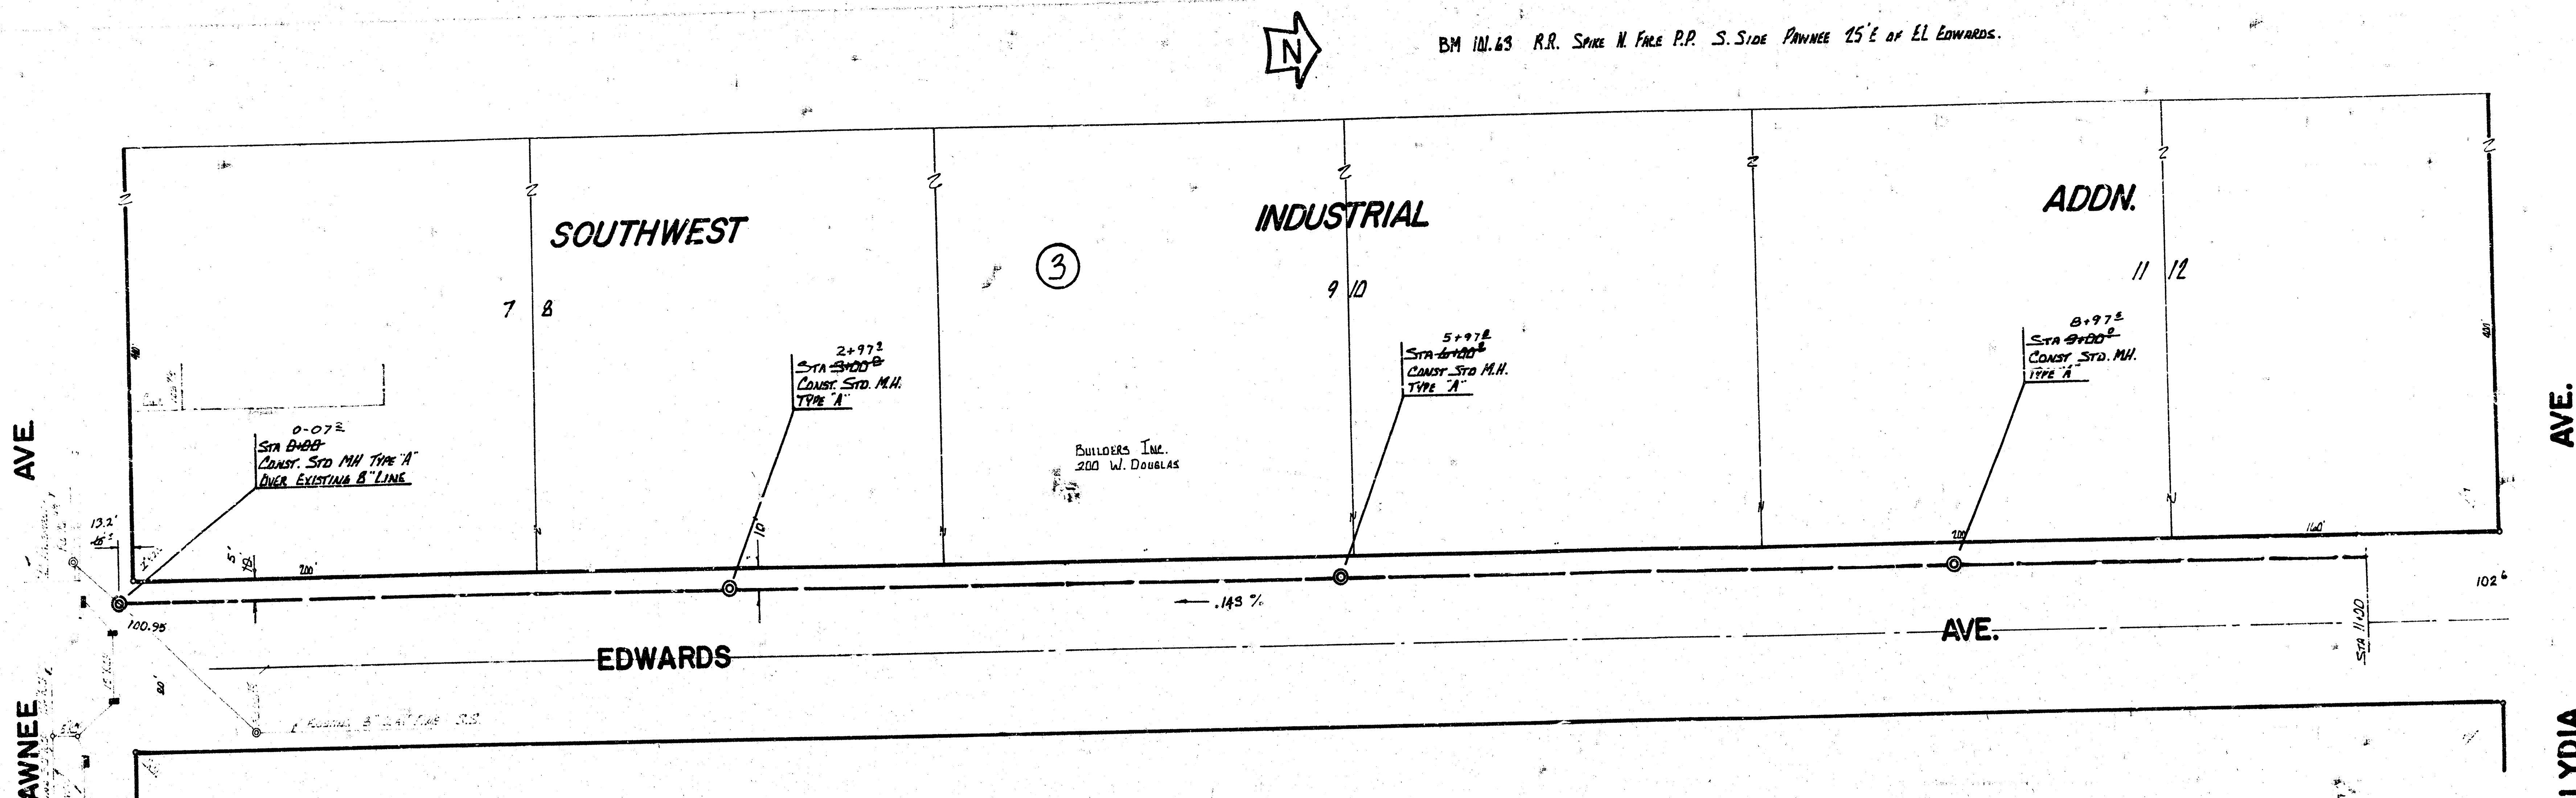


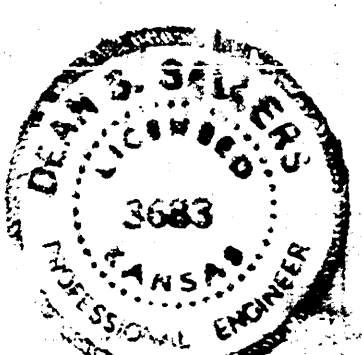


NOTE: ALL EXCESS MATERIAL EXCAVATED FROM TRENCH FOR SEWER SHALL BE SPREAD OVER THE ROAD TO PROVIDE ADDITIONAL COVER.

NOTE: MINIMUM COVER OF 2.5' TO BE MAINTAINED THROUGHOUT PROJECT.


PLAN SCALE 1"=40'
PROFILE SCALE 1"=4' HORIZ.
1"=5' VERT.

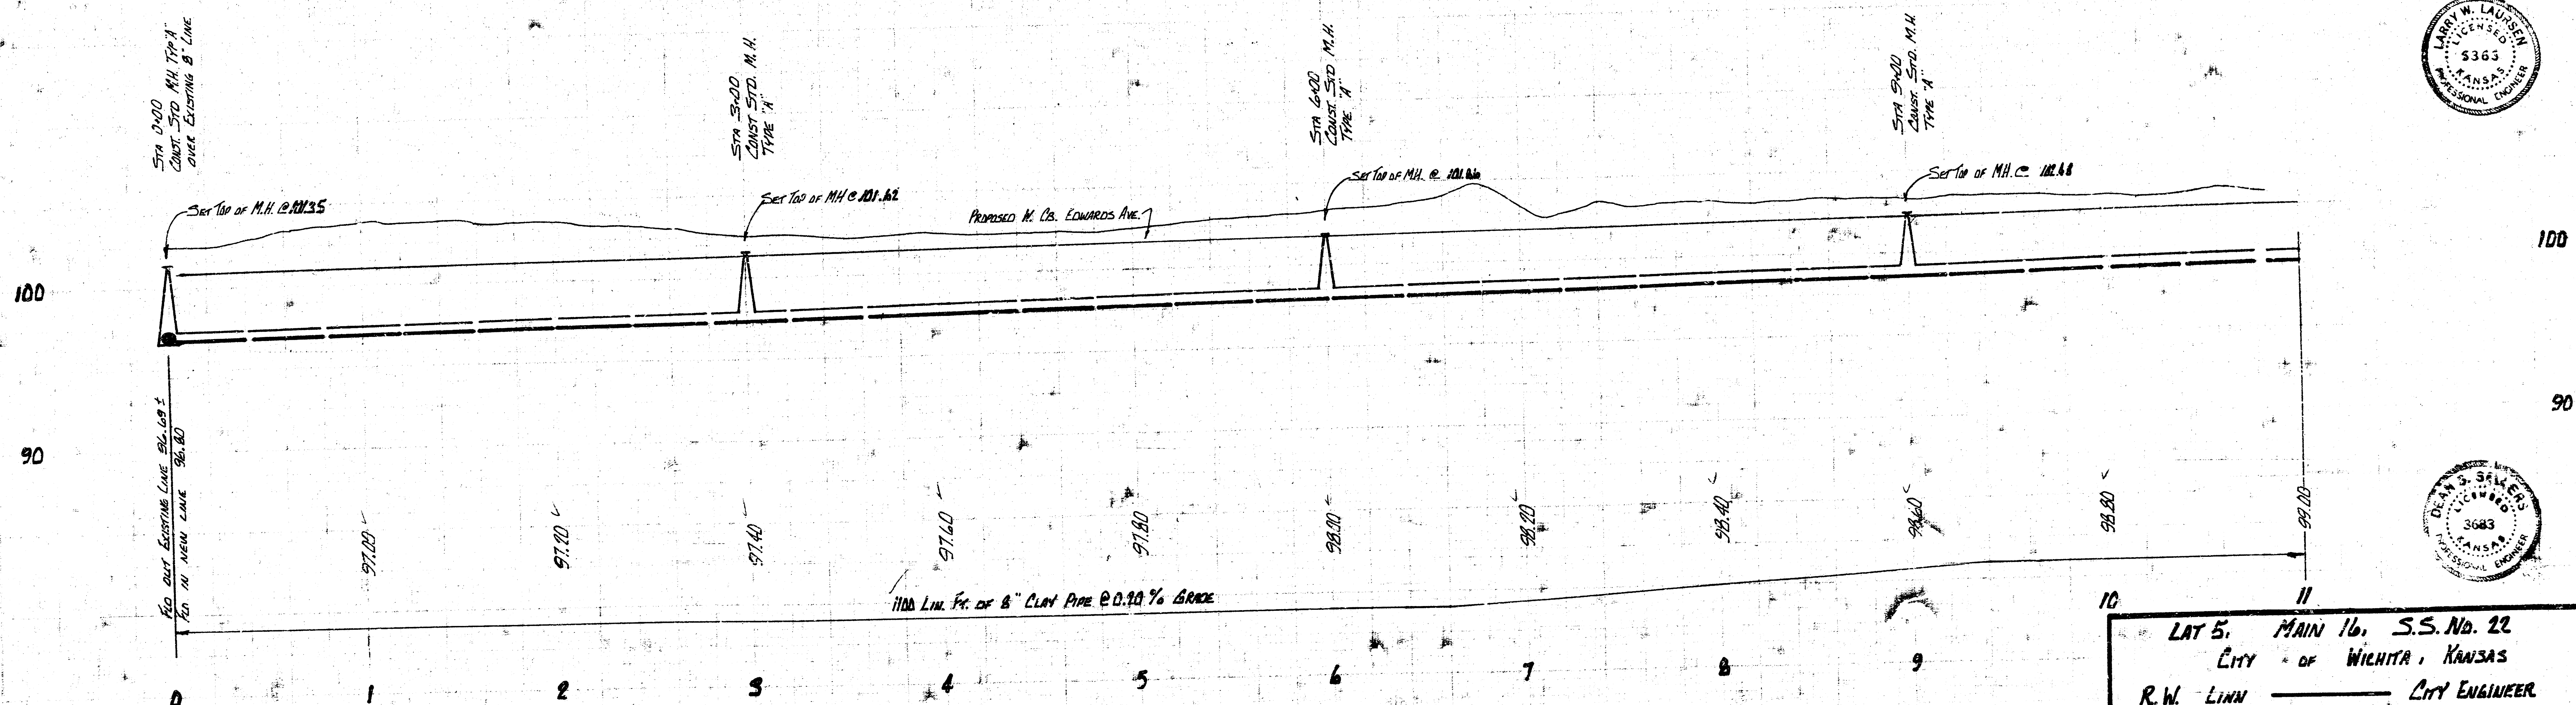


LAT 5, MAIN 16, S.S. No. 22
CITY OF WICHITA, KANSAS
R.W. LINN CITY ENGINEER
DATE: JAN. 1973 SHEET 1 OF 3
PROJECT No. DBKL 3720 55
10 sets - Eng.
1 set - Mayor

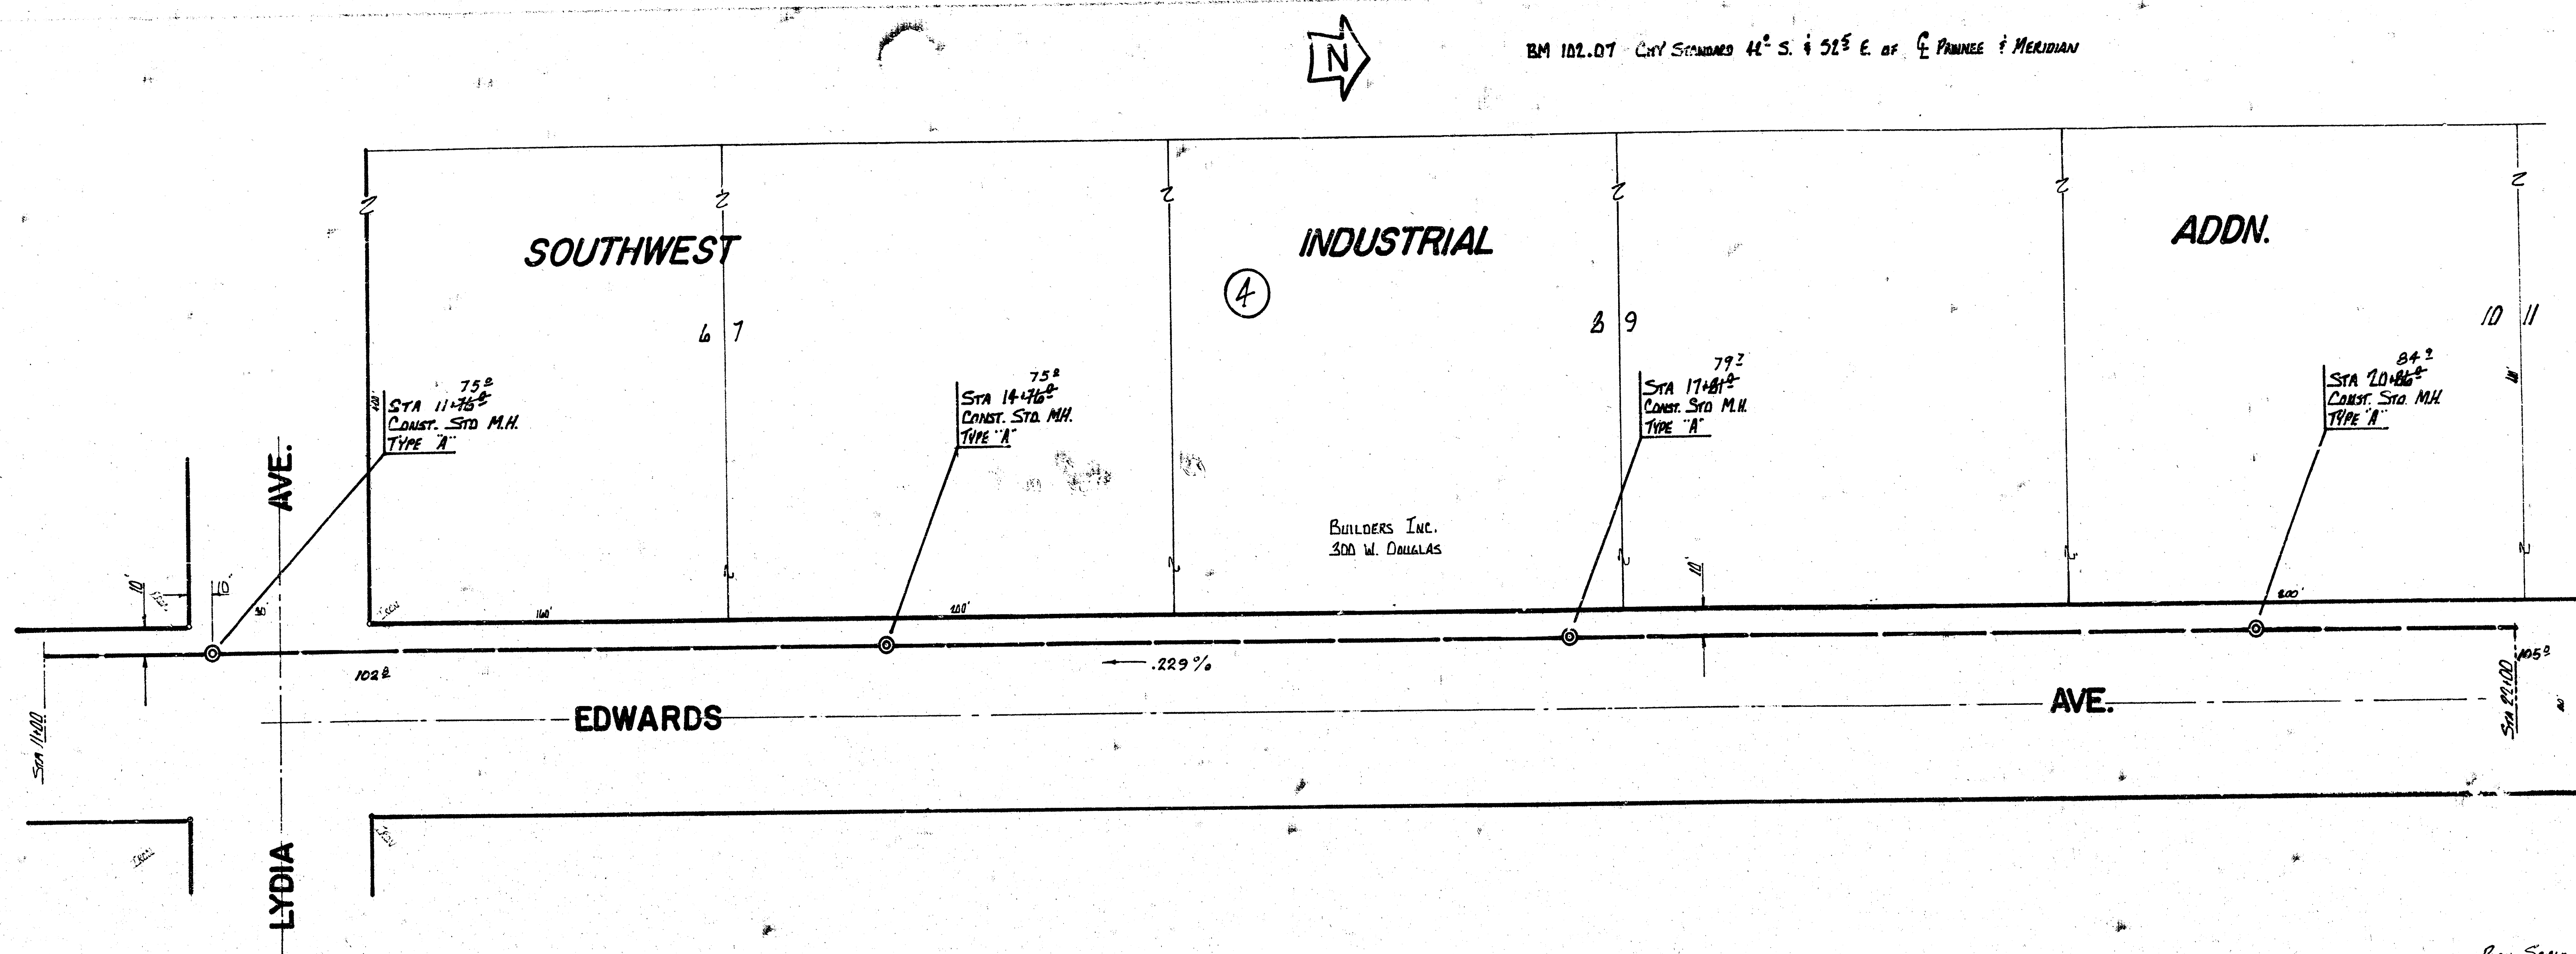

PLAN SCALE 1"=40'
 PROFILE SCALE 1"=20' HORIZ.
 1"=5' VERT.

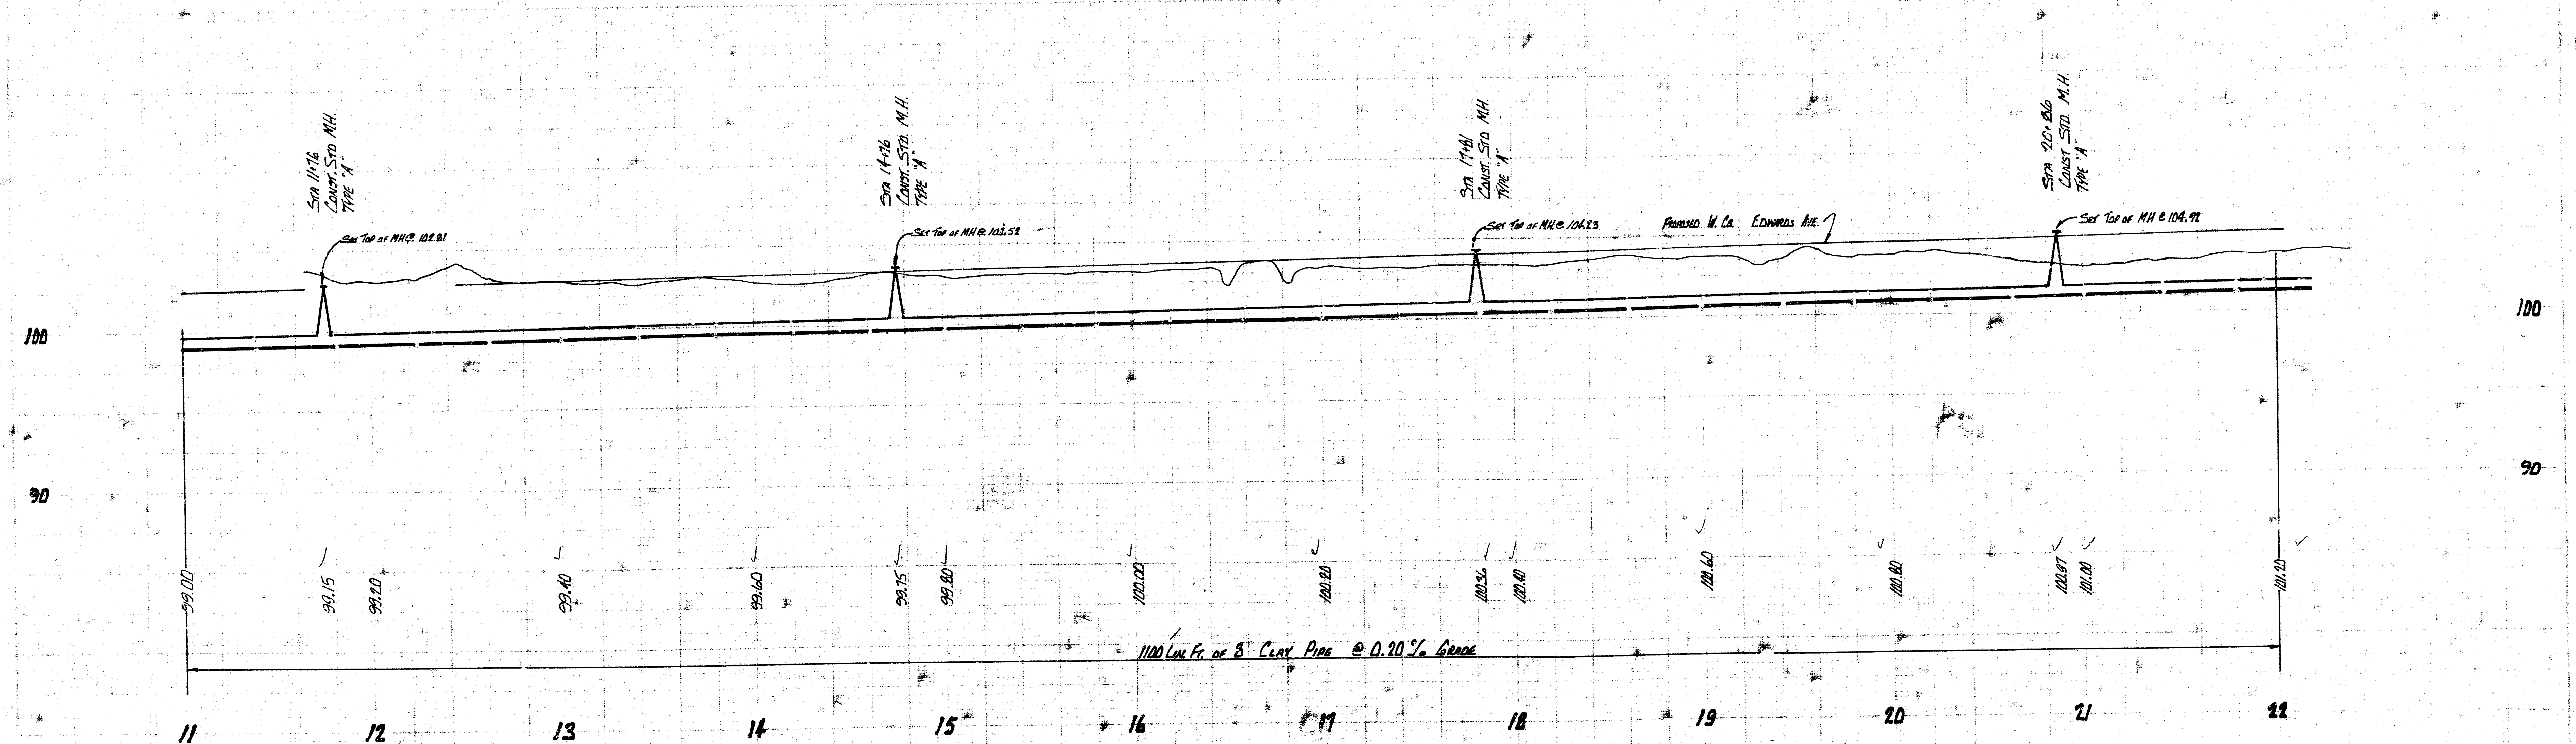

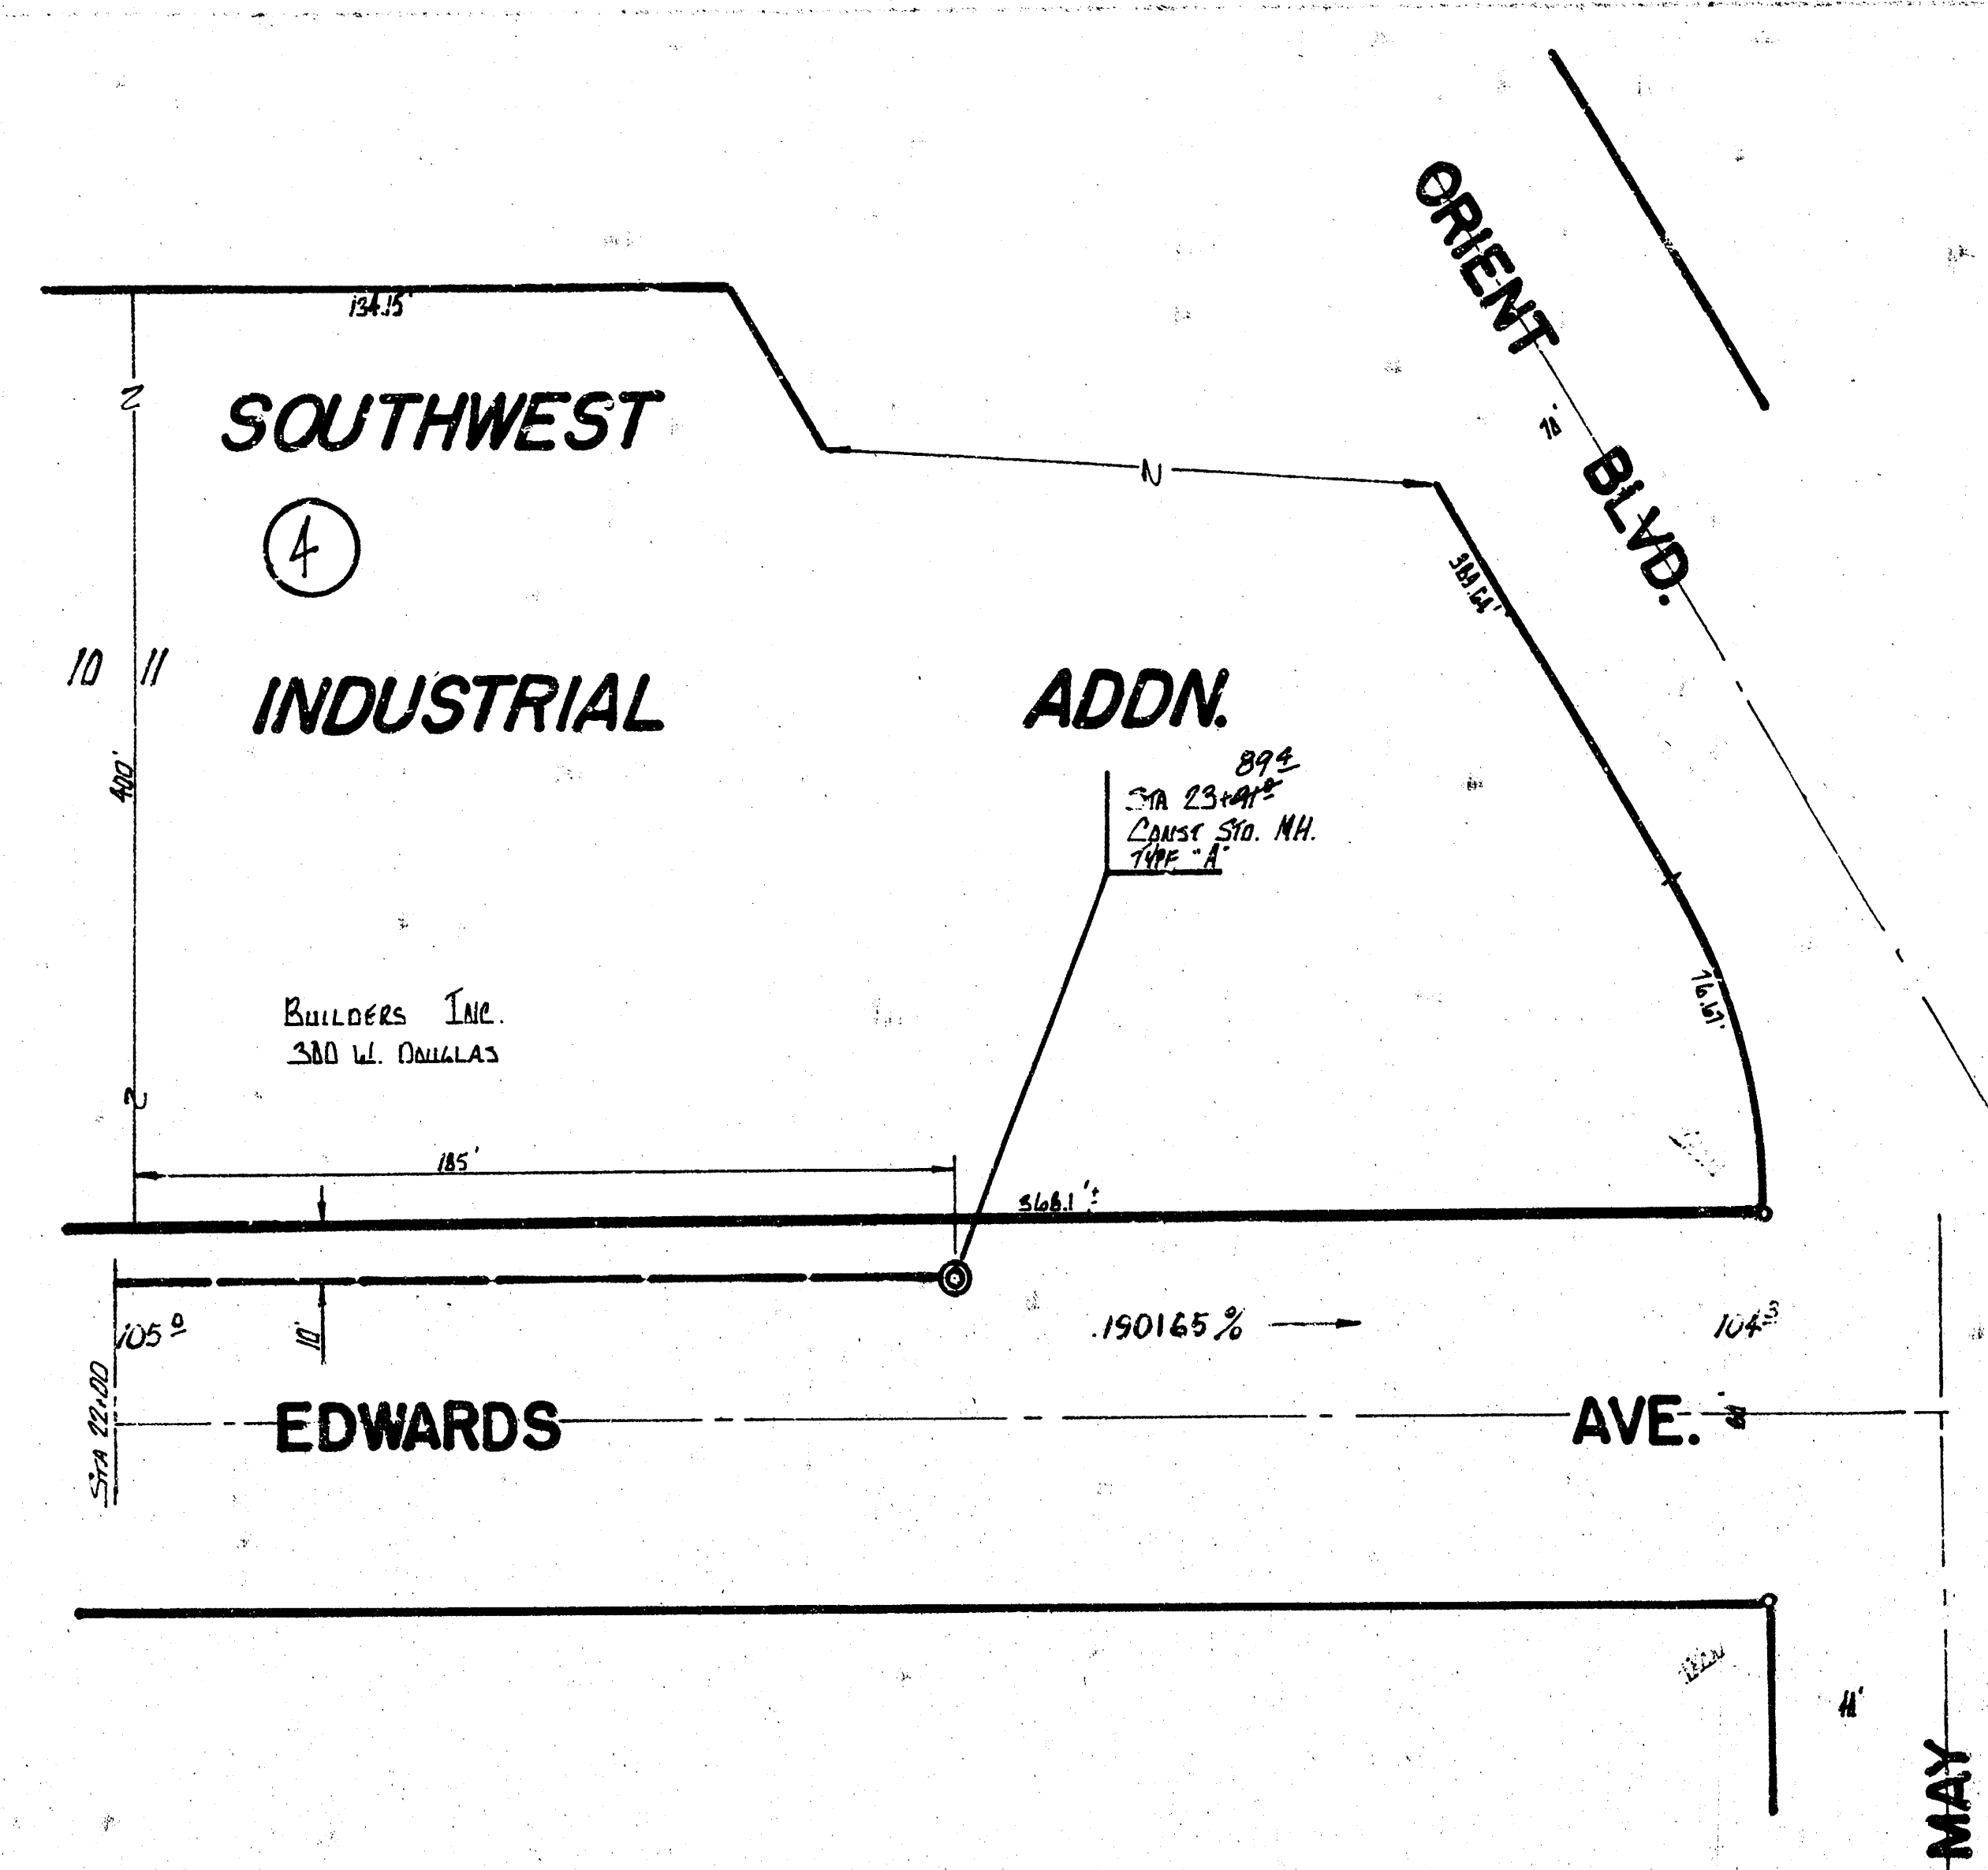

SM 105.15 R.R. SPIKE S-SIDE H.P. S-SIDE MAY 125' E OF EL EDWARDS

PLAN SCALE 1"=40'
 PROFILE SCALE 1"=40' HORIZ.
 1"=5' VERT.

