



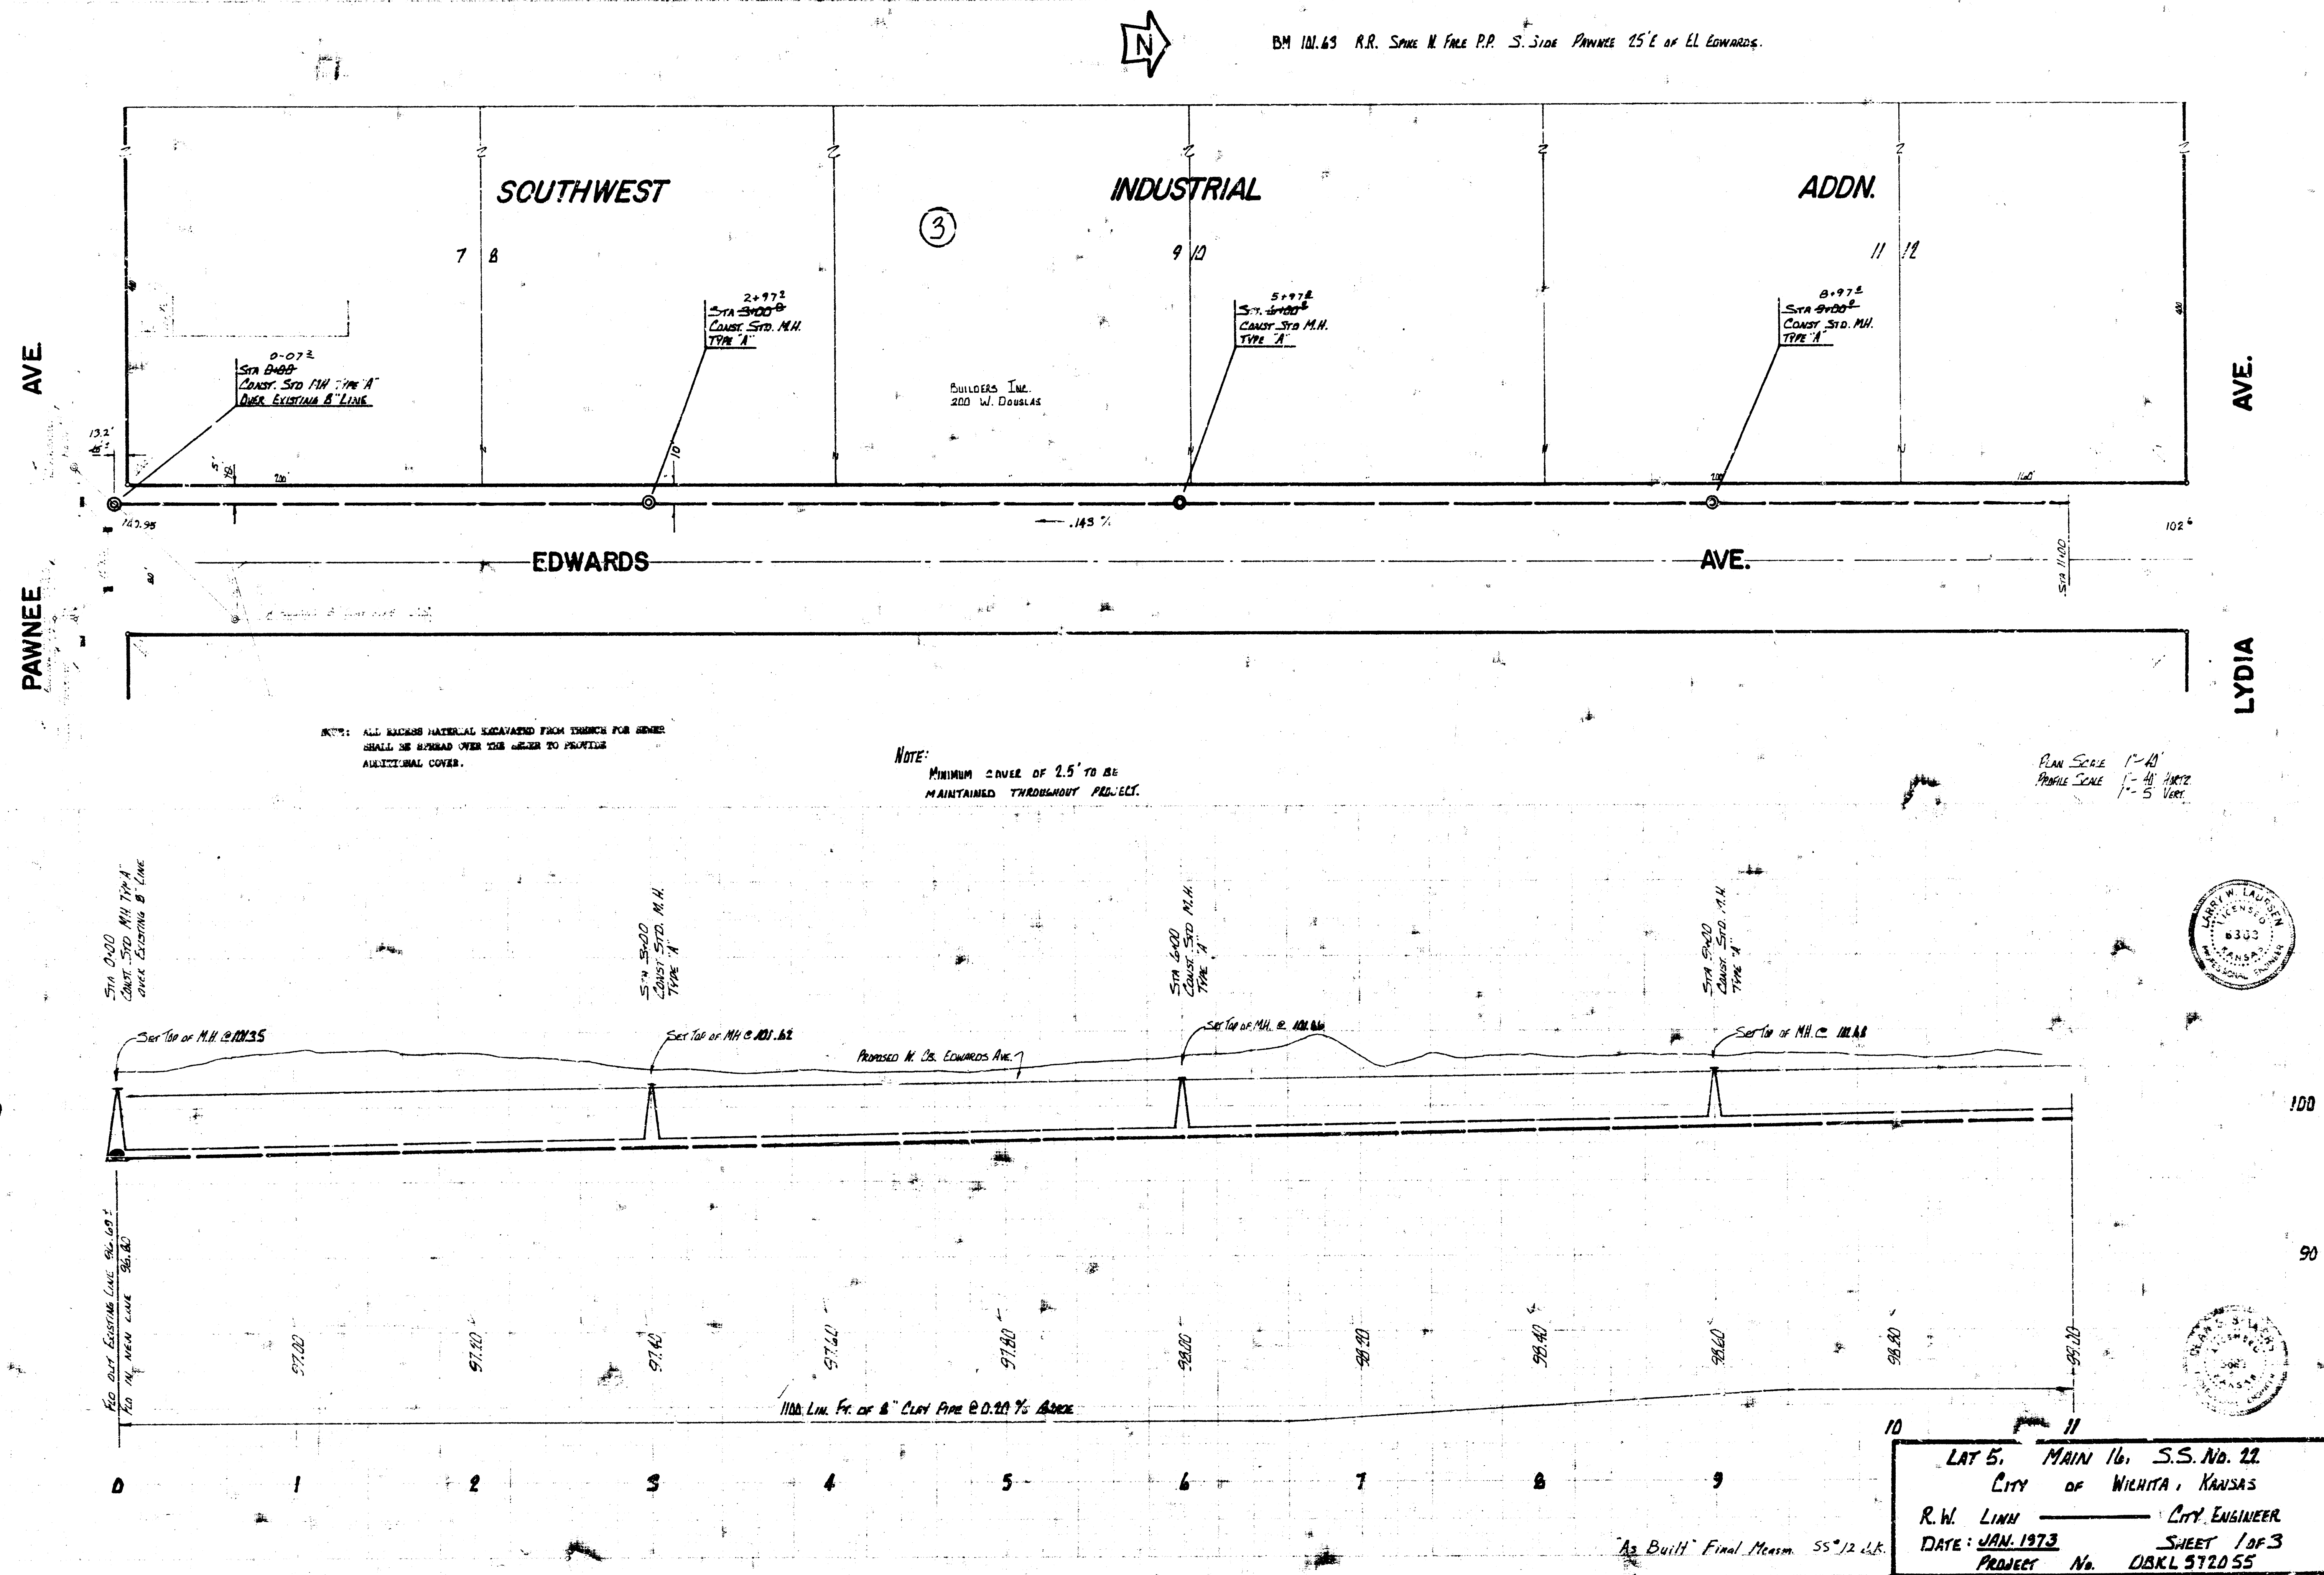

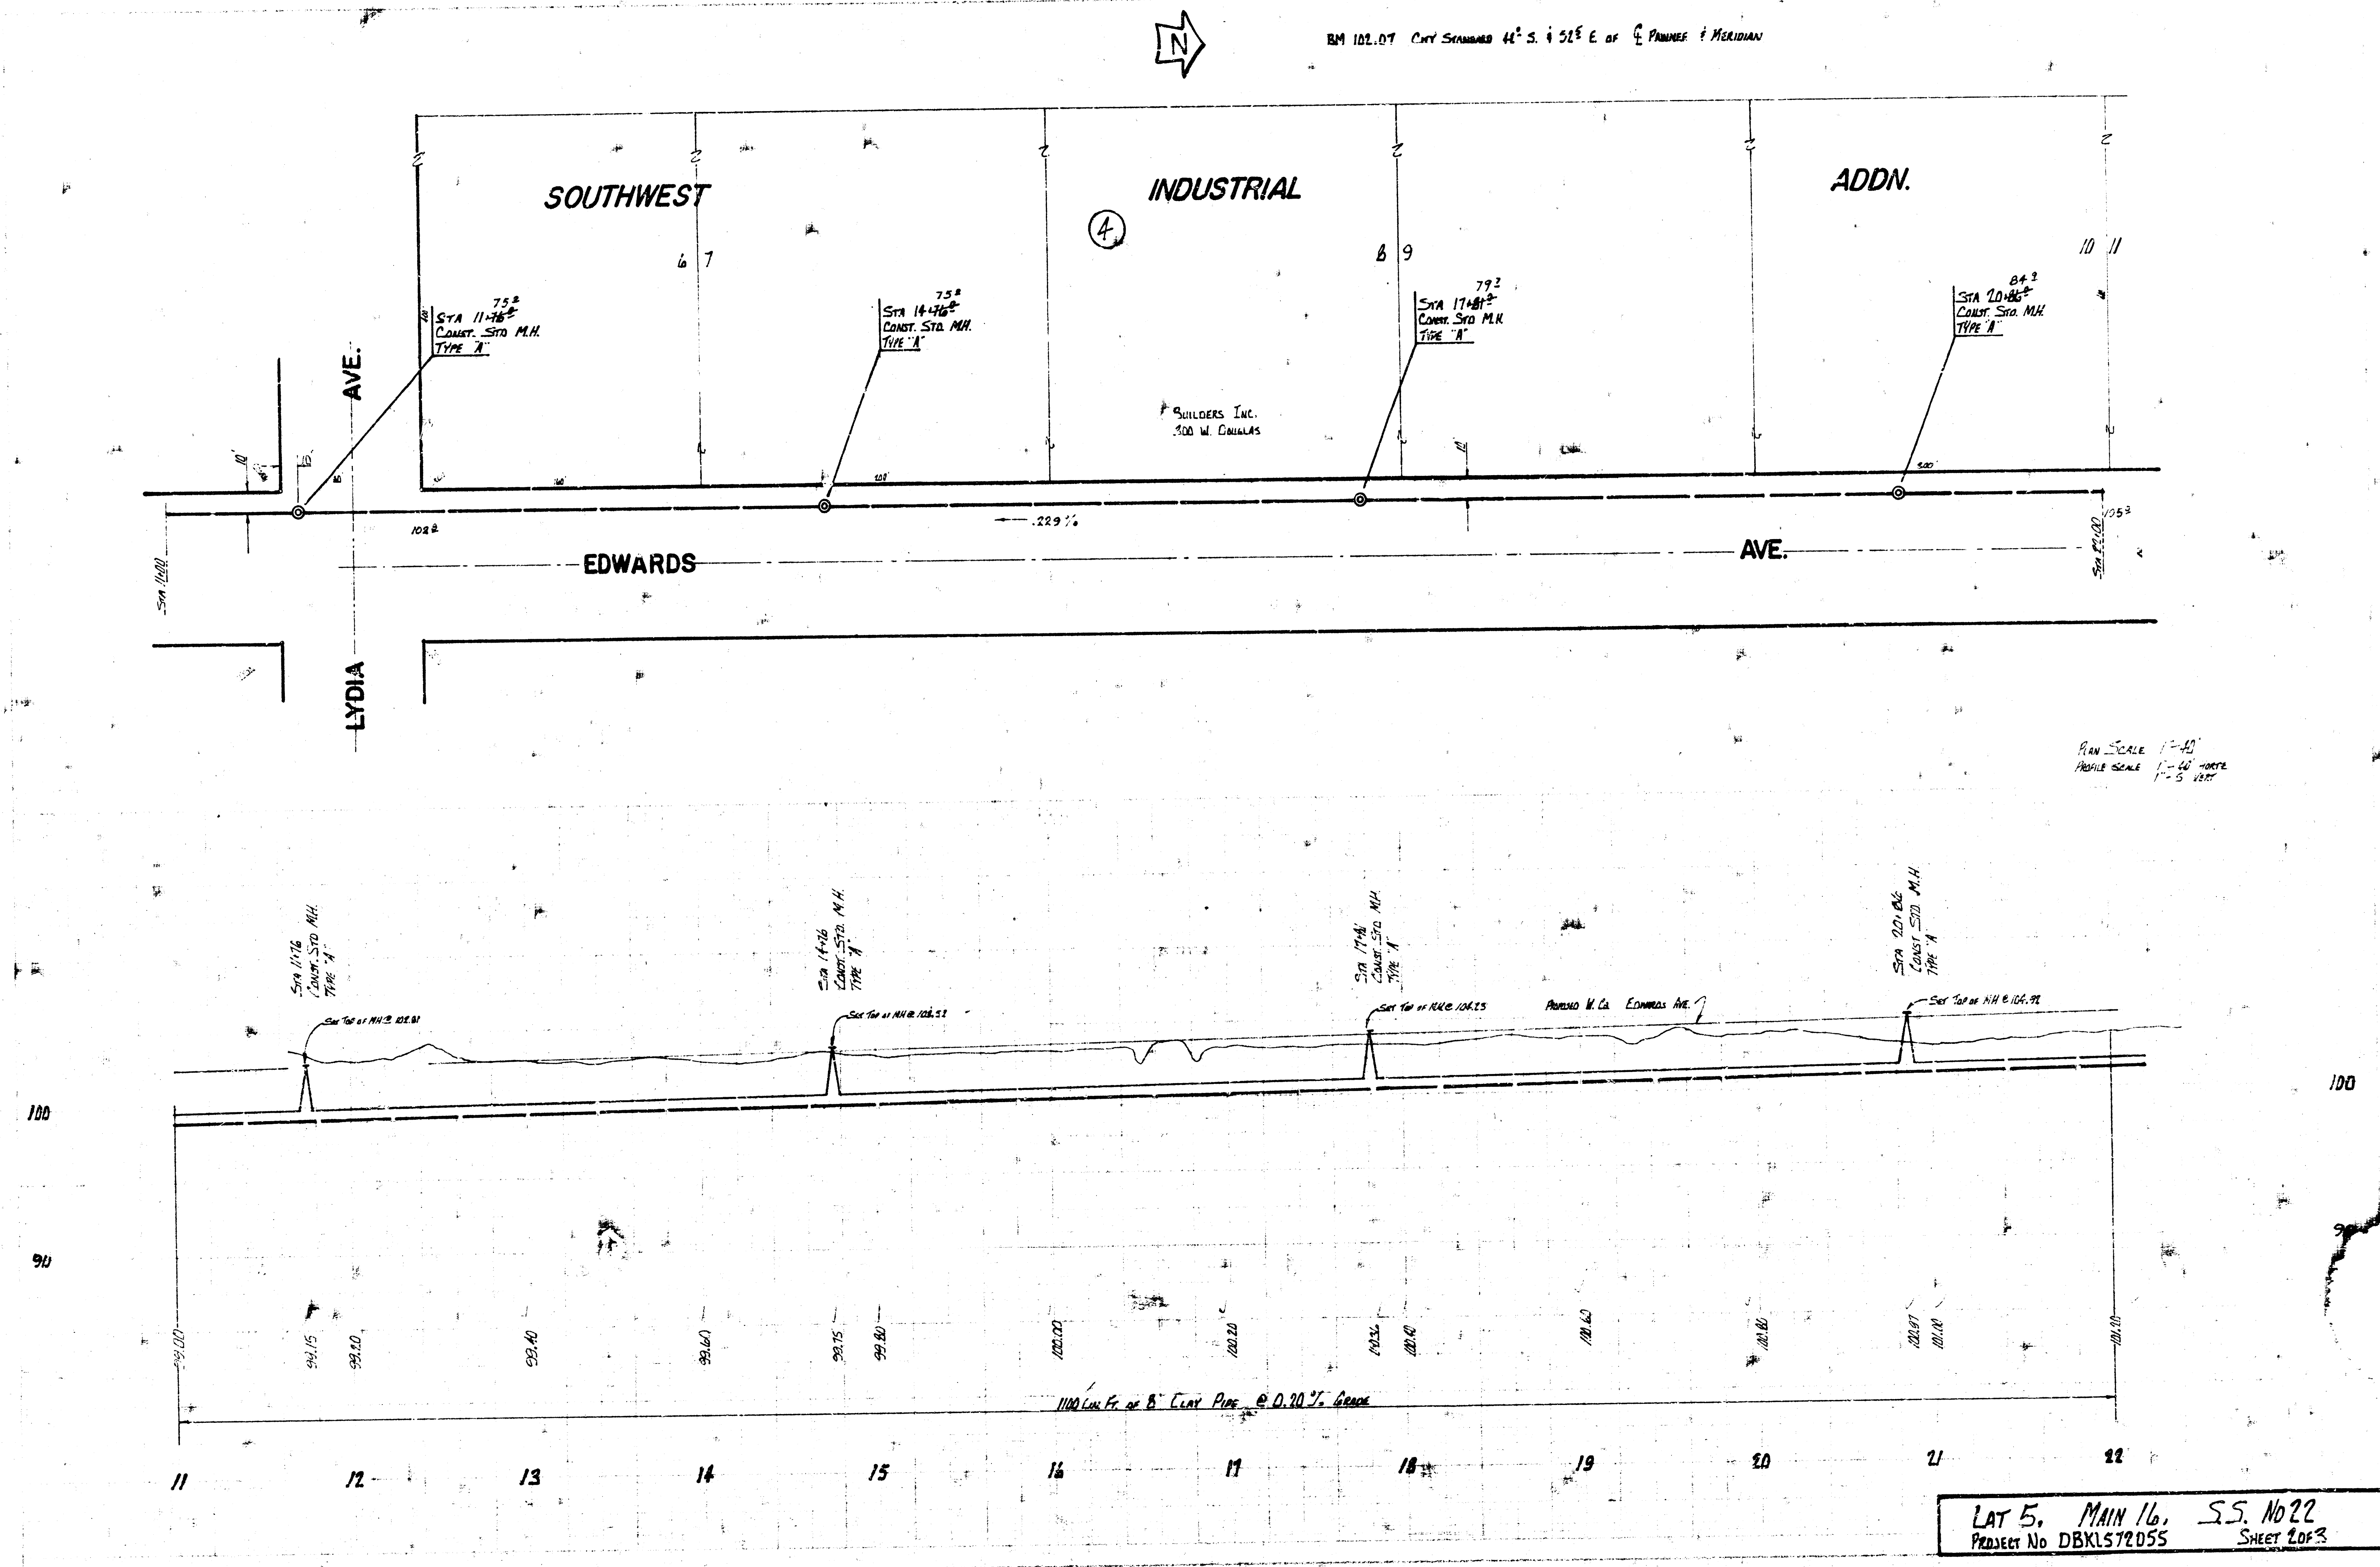

BM 105.15 RR SPIKE S-SIDE HLP. S-SIDE MAY 125' ± E OF EL EDWARDS

PLAN SCALE 1" = 40'
PROFILE SCALE 1" = 40' HORIZ
1" = 5' VERT.

PROJECT No DBKLS12055 SHEET 3 OF 3