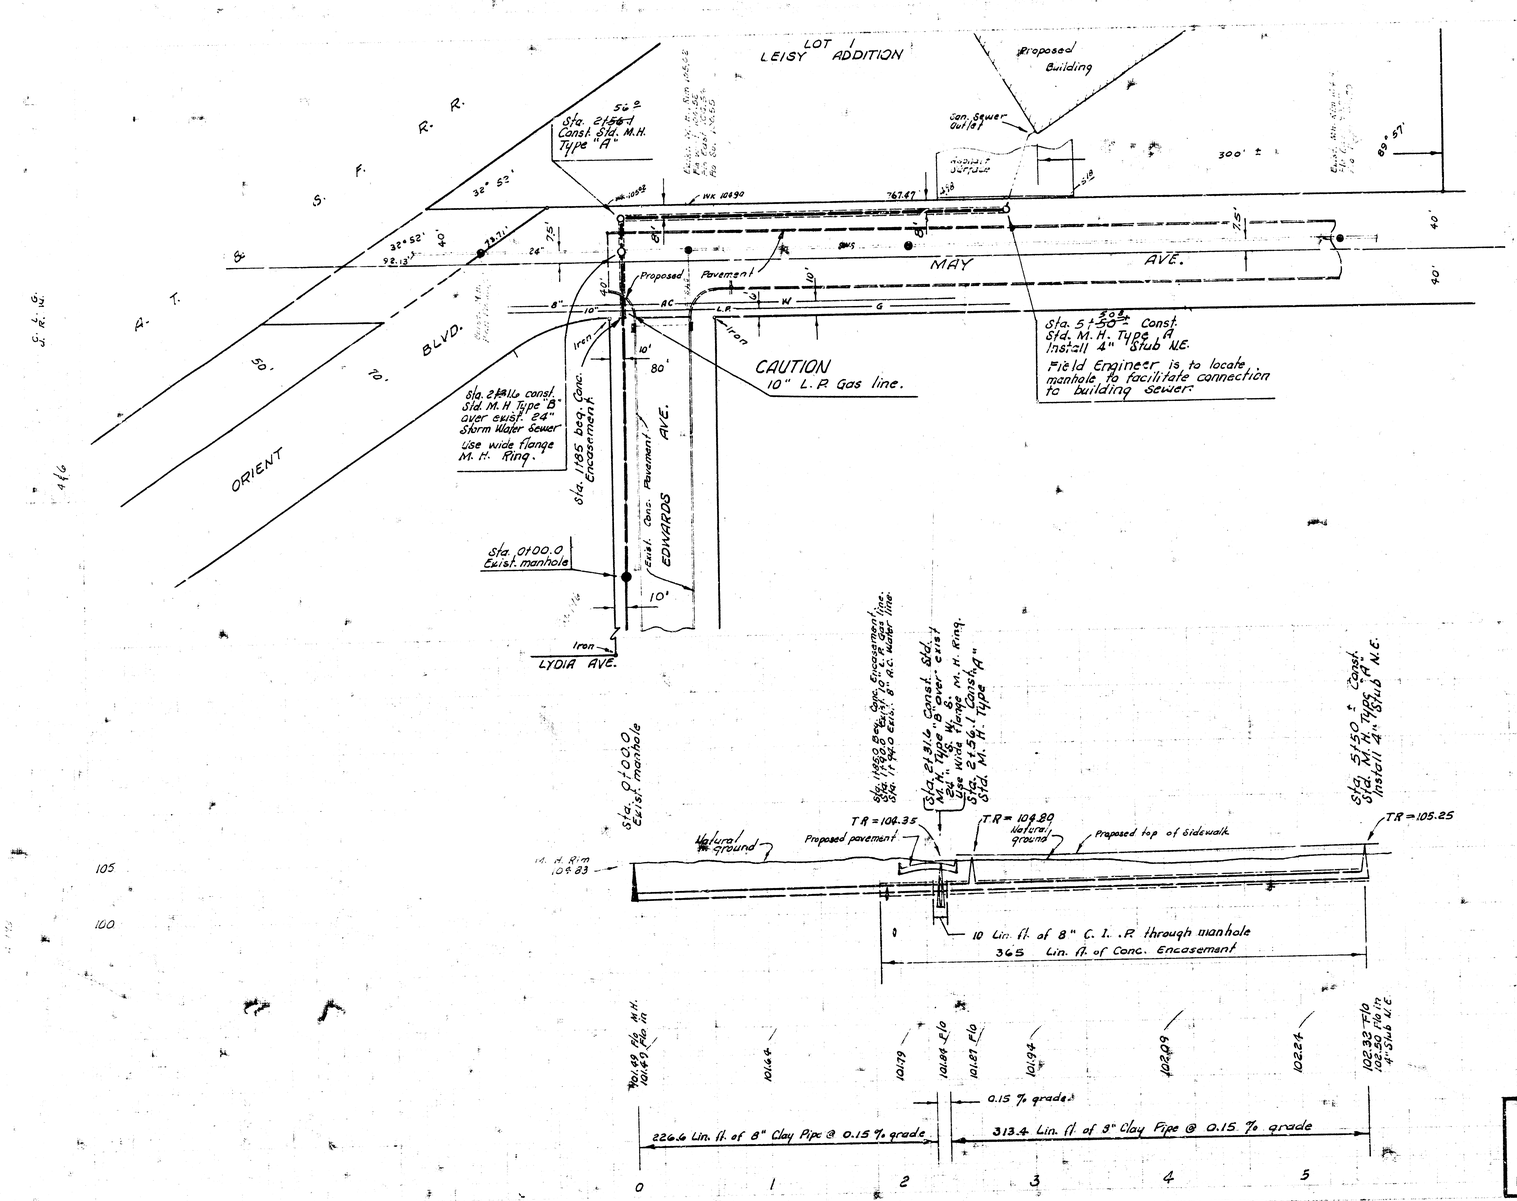

N

Plan Scale 1" = 40'
Profile Scale 1" = 40' Horz.
1" = 5' Vert.

B. M. 104.49 "+" on east curb of Edwards 55± south of St. May.

DONALD E. SUNDGREN
LICENSED
5311
KANSAS
PROFESSIONAL ENGINEER

"As Built" Final Meas. S.S. lk. "S.

LAT. 6, MAIN 16, S. S. NO. 22
CITY OF WICHITA, KANSAS
R. W. LINN — CITY ENGINEER
DEC. 1973 PROJECT NO. DBKL 573053

E S