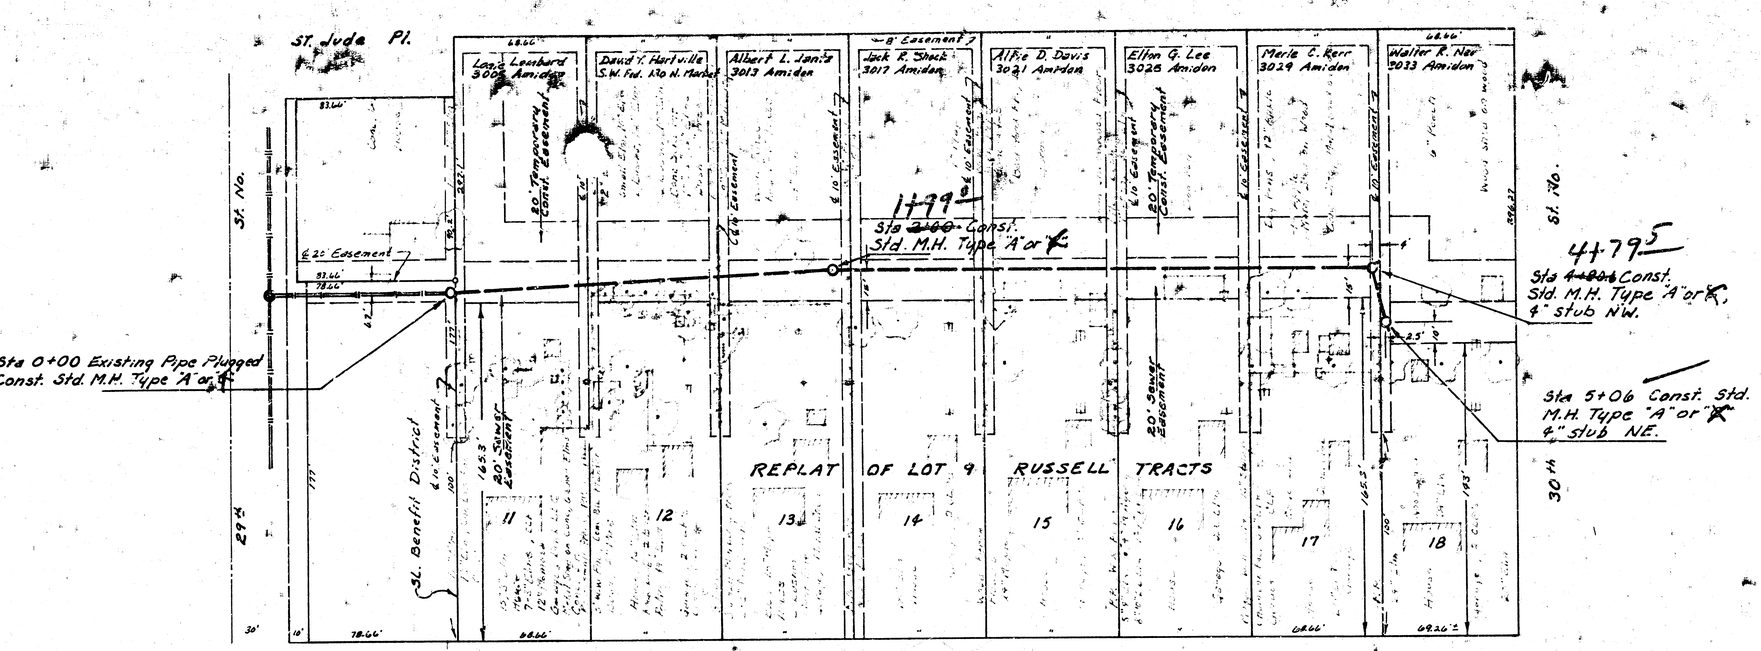

Plan Scale 1" = 40'
Profile Scale 1" = 40' Horz.
1" = 5' Vert.

NOTE: CONTRACTOR WILL BE REQUIRED TO GIVE A MINIMUM 24 HOUR NOTICE TO DEVELOPED PROPERTIES EFFECTED BY THE CONSTRUCTION OF THIS PROJECT.

B.M. 127.22 City Std. Disc 44.5'S and 40.8' W. of ℄ of Amidon & 29th St. No.

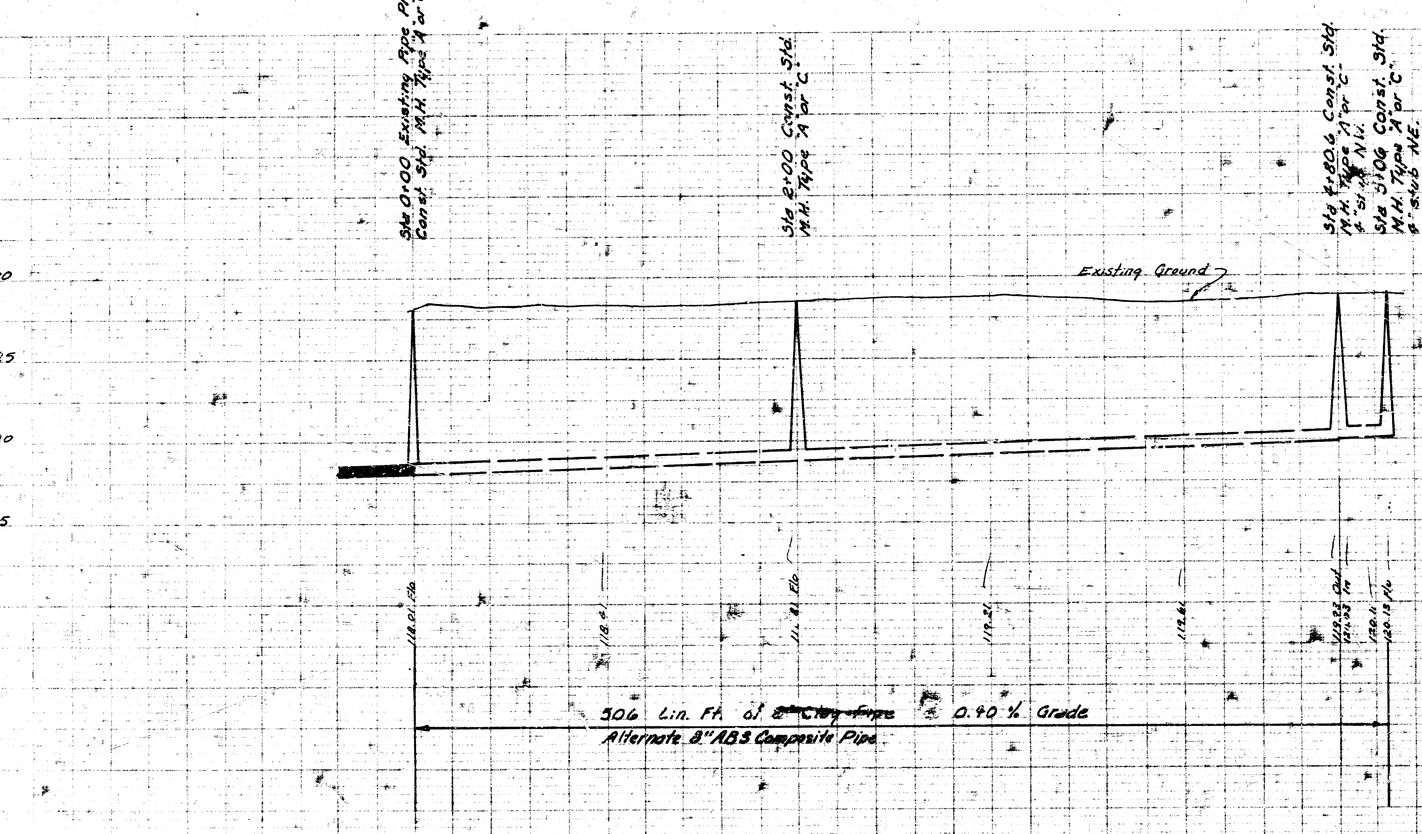

As Built 4-27-78

DONALD E. SCHNEIDER LICENSED 6311 KANSAS PROFESSIONAL ENGINEER

LAT 61, MAIN 17, S.S. NO. 22
CITY OF WICHITA, KANSAS
R. W. LINN — CITY ENGINEER
PROJECT NO. DBKL577024