

1/8" = 1' Plan  
1/4" = 1' Profile


1/8" = 1' Plan  
1/4" = 1' Profile

SCALE - 1" = 40' Plan  
1/4" = 1' Profile

Bench Marks: 136.36 City Std. Dec. 42'E and 34' N of  
E of Amidon & 33rd St. N.  
128.34 TBM East Rim Existing MH, Sta. 0+00  
of LAT. 66, MAIN 17, S.S. No. 22.



THE CONTRACTOR SHALL BE RESPONSIBLE FOR  
OBTAINING ALL NECESSARY PERMITS FROM  
THE CITY OF WICHITA, KANSAS, AND FOR  
OBTAINING ANY NECESSARY EASEMENTS  
AND CONVEYANCES FROM THE  
ADJACENT PROPERTY OWNERS. THE  
CONTRACTOR SHALL BE RESPONSIBLE FOR  
OBTAINING ALL NECESSARY PERMITS FROM  
THE CITY OF WICHITA, KANSAS, AND FOR  
OBTAINING ANY NECESSARY EASEMENTS  
AND CONVEYANCES FROM THE  
ADJACENT PROPERTY OWNERS.

As Bld'g  
J.L.L.  
9.82

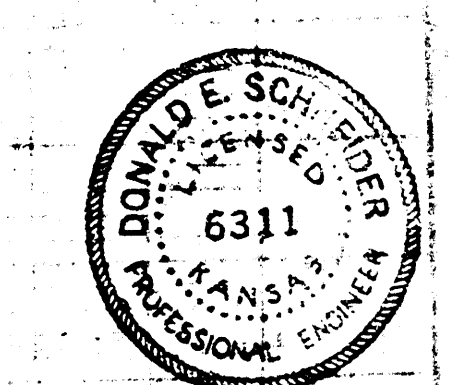

LAT. 66, MAIN 17, S.S. NO. 22  
CITY OF WICHITA, KANSAS  
J. W. BRUGGEMAN  
DIRECTOR OF ENGINEERING / CITY ENGINEER  
PROJ. NO. 488-78-245-60685-000-001

FILMED FROM THE BEST  
AVAILABLE COPY

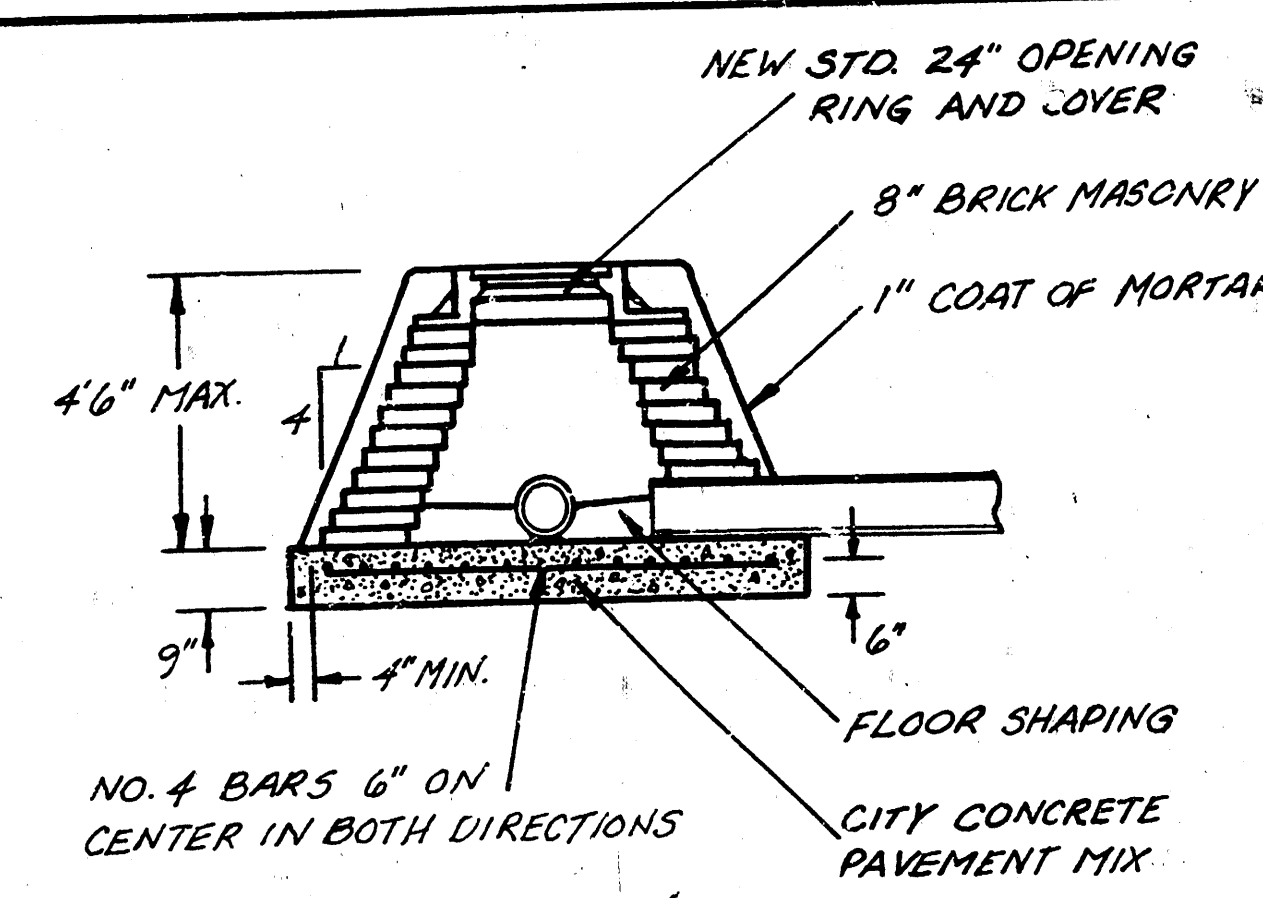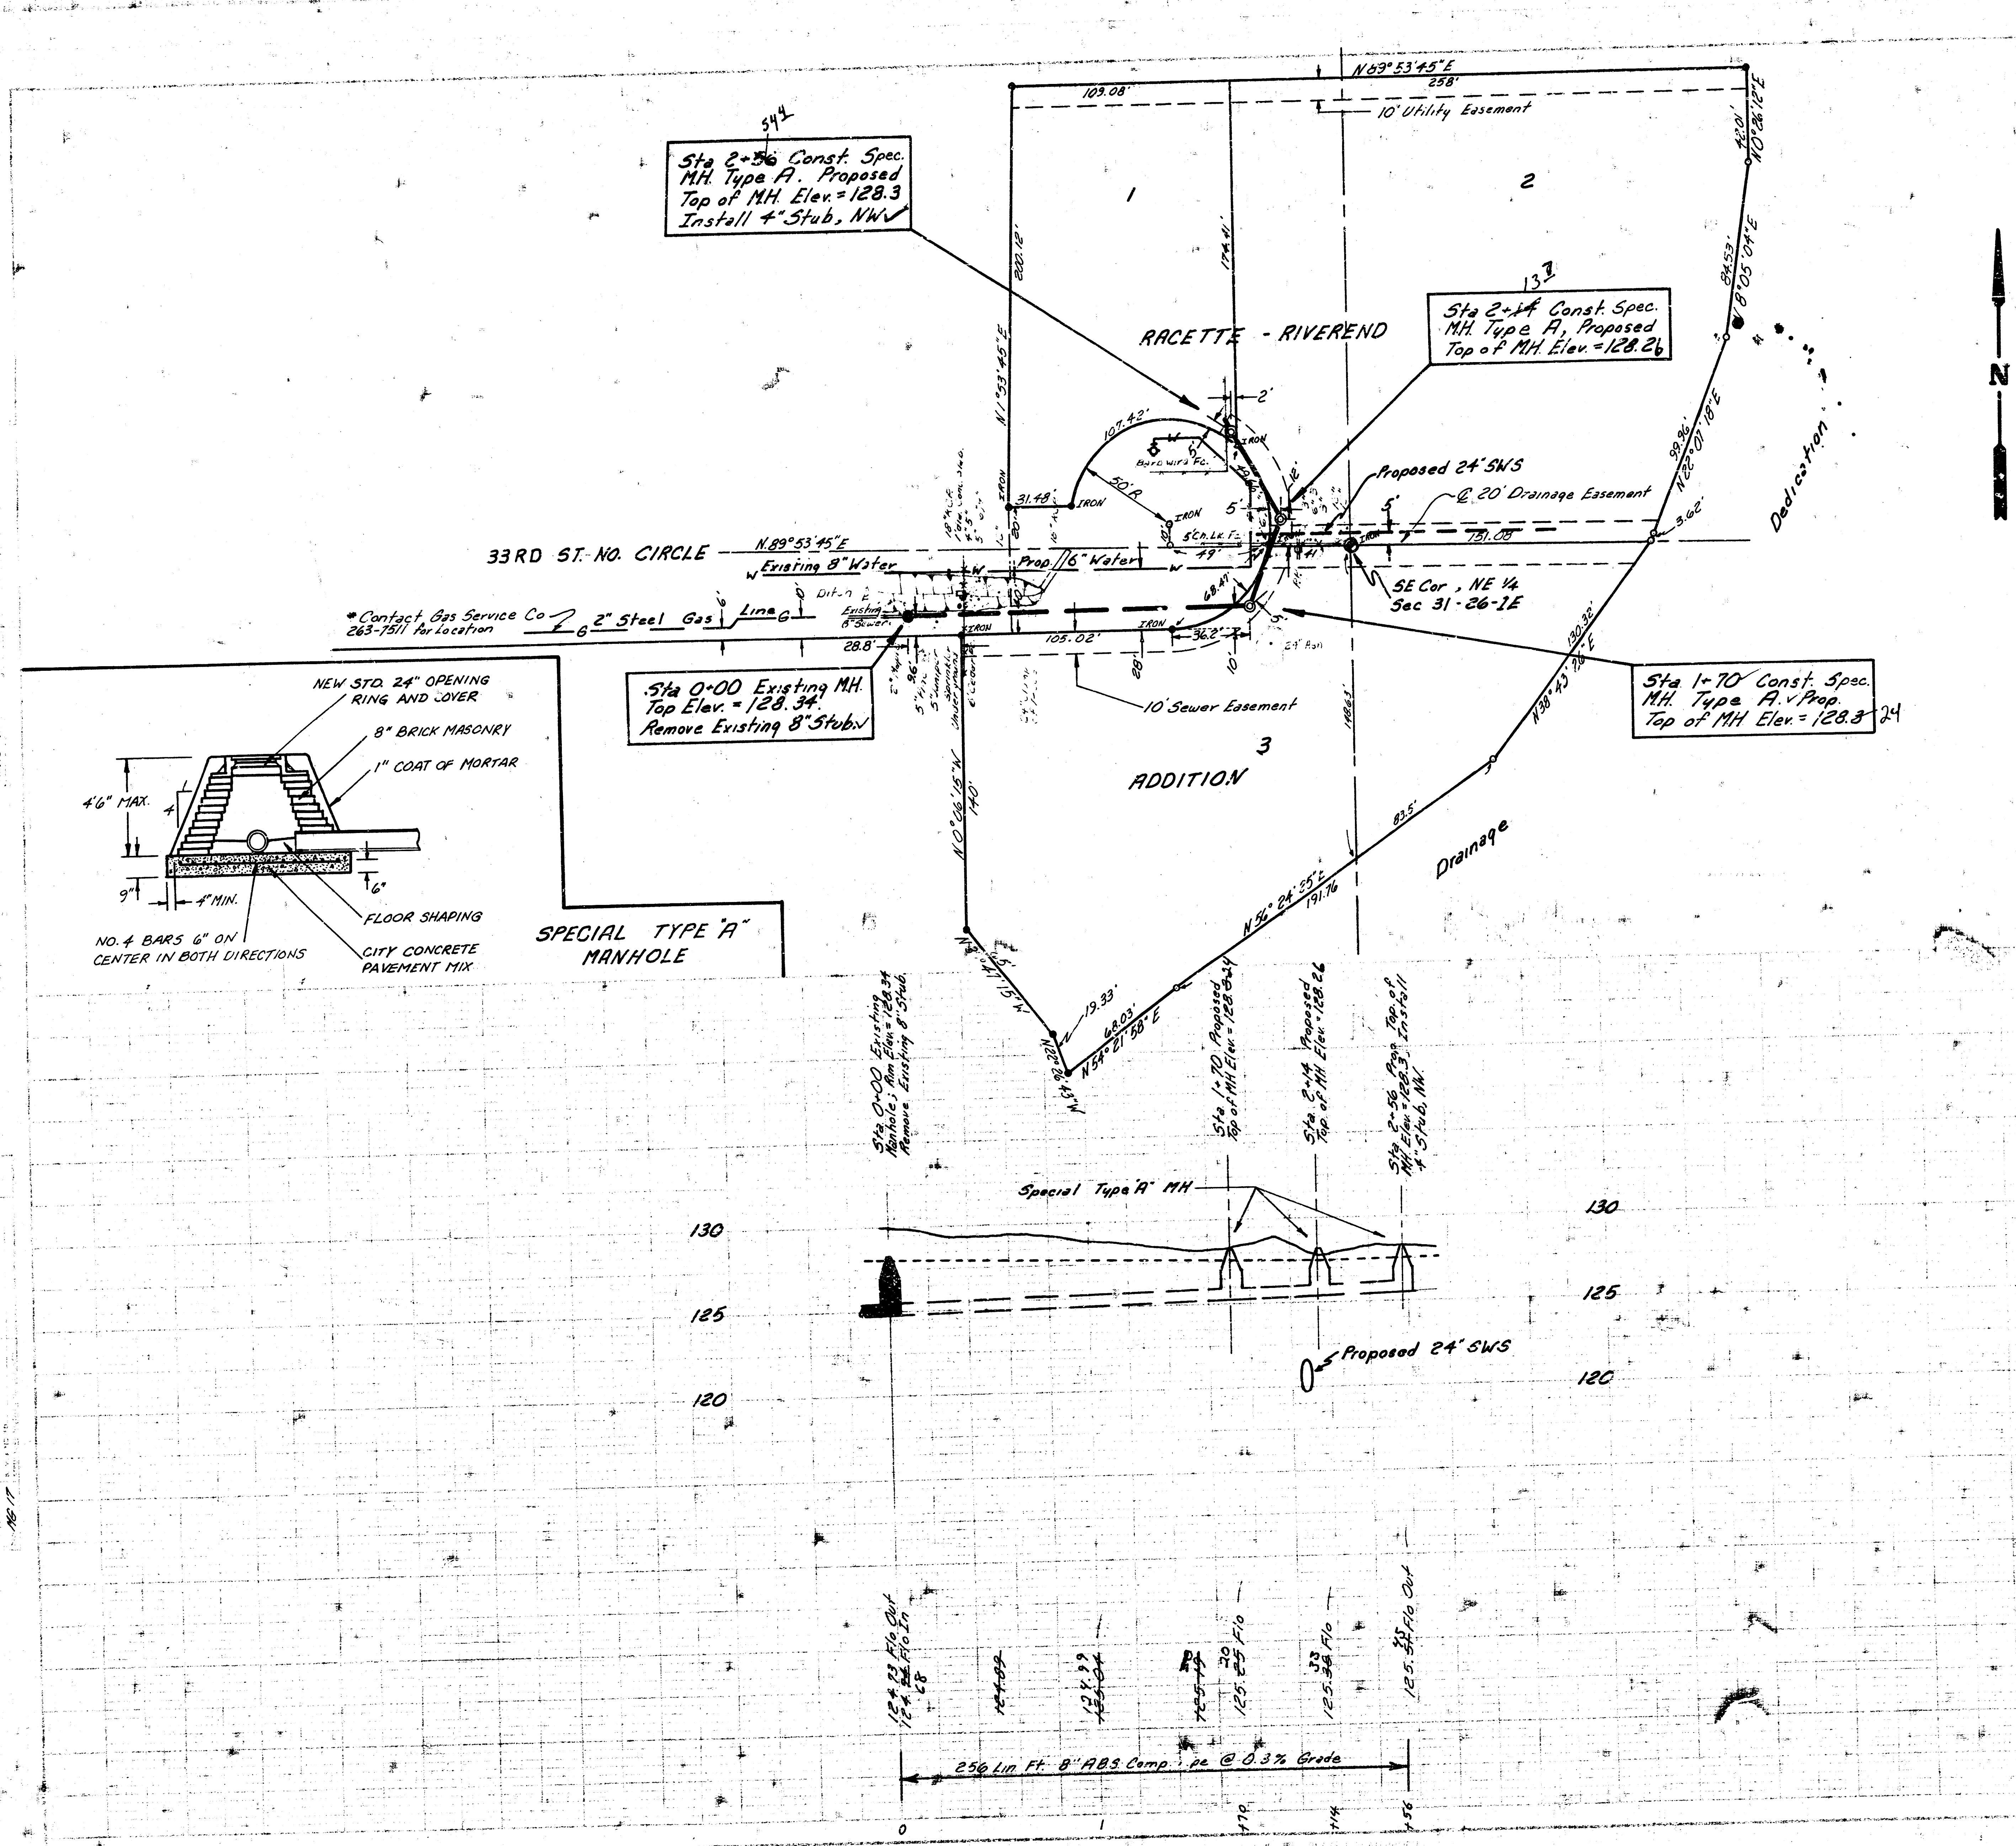

Sta 2+36 Const. Spec.  
MH Type A, Proposed  
Top of MH Elev. = 128.3  
Install 4" Stub, NW

Sta 2+44 Const. Spec.  
MH Type A, Proposed  
Top of MH Elev. = 128.26

Sta 0+00 Existing MH.  
Top Elev. = 128.34  
Remove Existing 8" Stub

Sta 1+70 Const. Spec.  
MH Type A, Proposed  
Top of MH Elev. = 128.3

Sta 0+00 Existing  
Manhole, Rem Elev. = 128.34  
Remove Existing 8" Stub

Sta 1+70 Proposed  
Top of MH Elev. = 128.34

Sta 2+36 Proposed  
Top of MH Elev. = 128.26

Sta 2+44 Proposed  
Top of MH Elev. = 128.26  
4" Stub, NW