



- B. M. 126.73 R.R. Spike on S. side P. Pole on N side 21st St. at E. 11th River Park Addn.
 B. M. 128.97 R.R. Spike on S. side P. Pole on N.W. cor. 21st St. and Hyacinth Lane.
 B. M. 126.15 "a" cut top E. curb Hyacinth at S. L. Cornelison
 B. M. 124.20 "a" cut top S. curb River Park Dr. 2' E. of W. L. Bullinger Dr.

Survey by J.F.G. Book No. J.F.G. 109
 Plan by J.W. Checked by

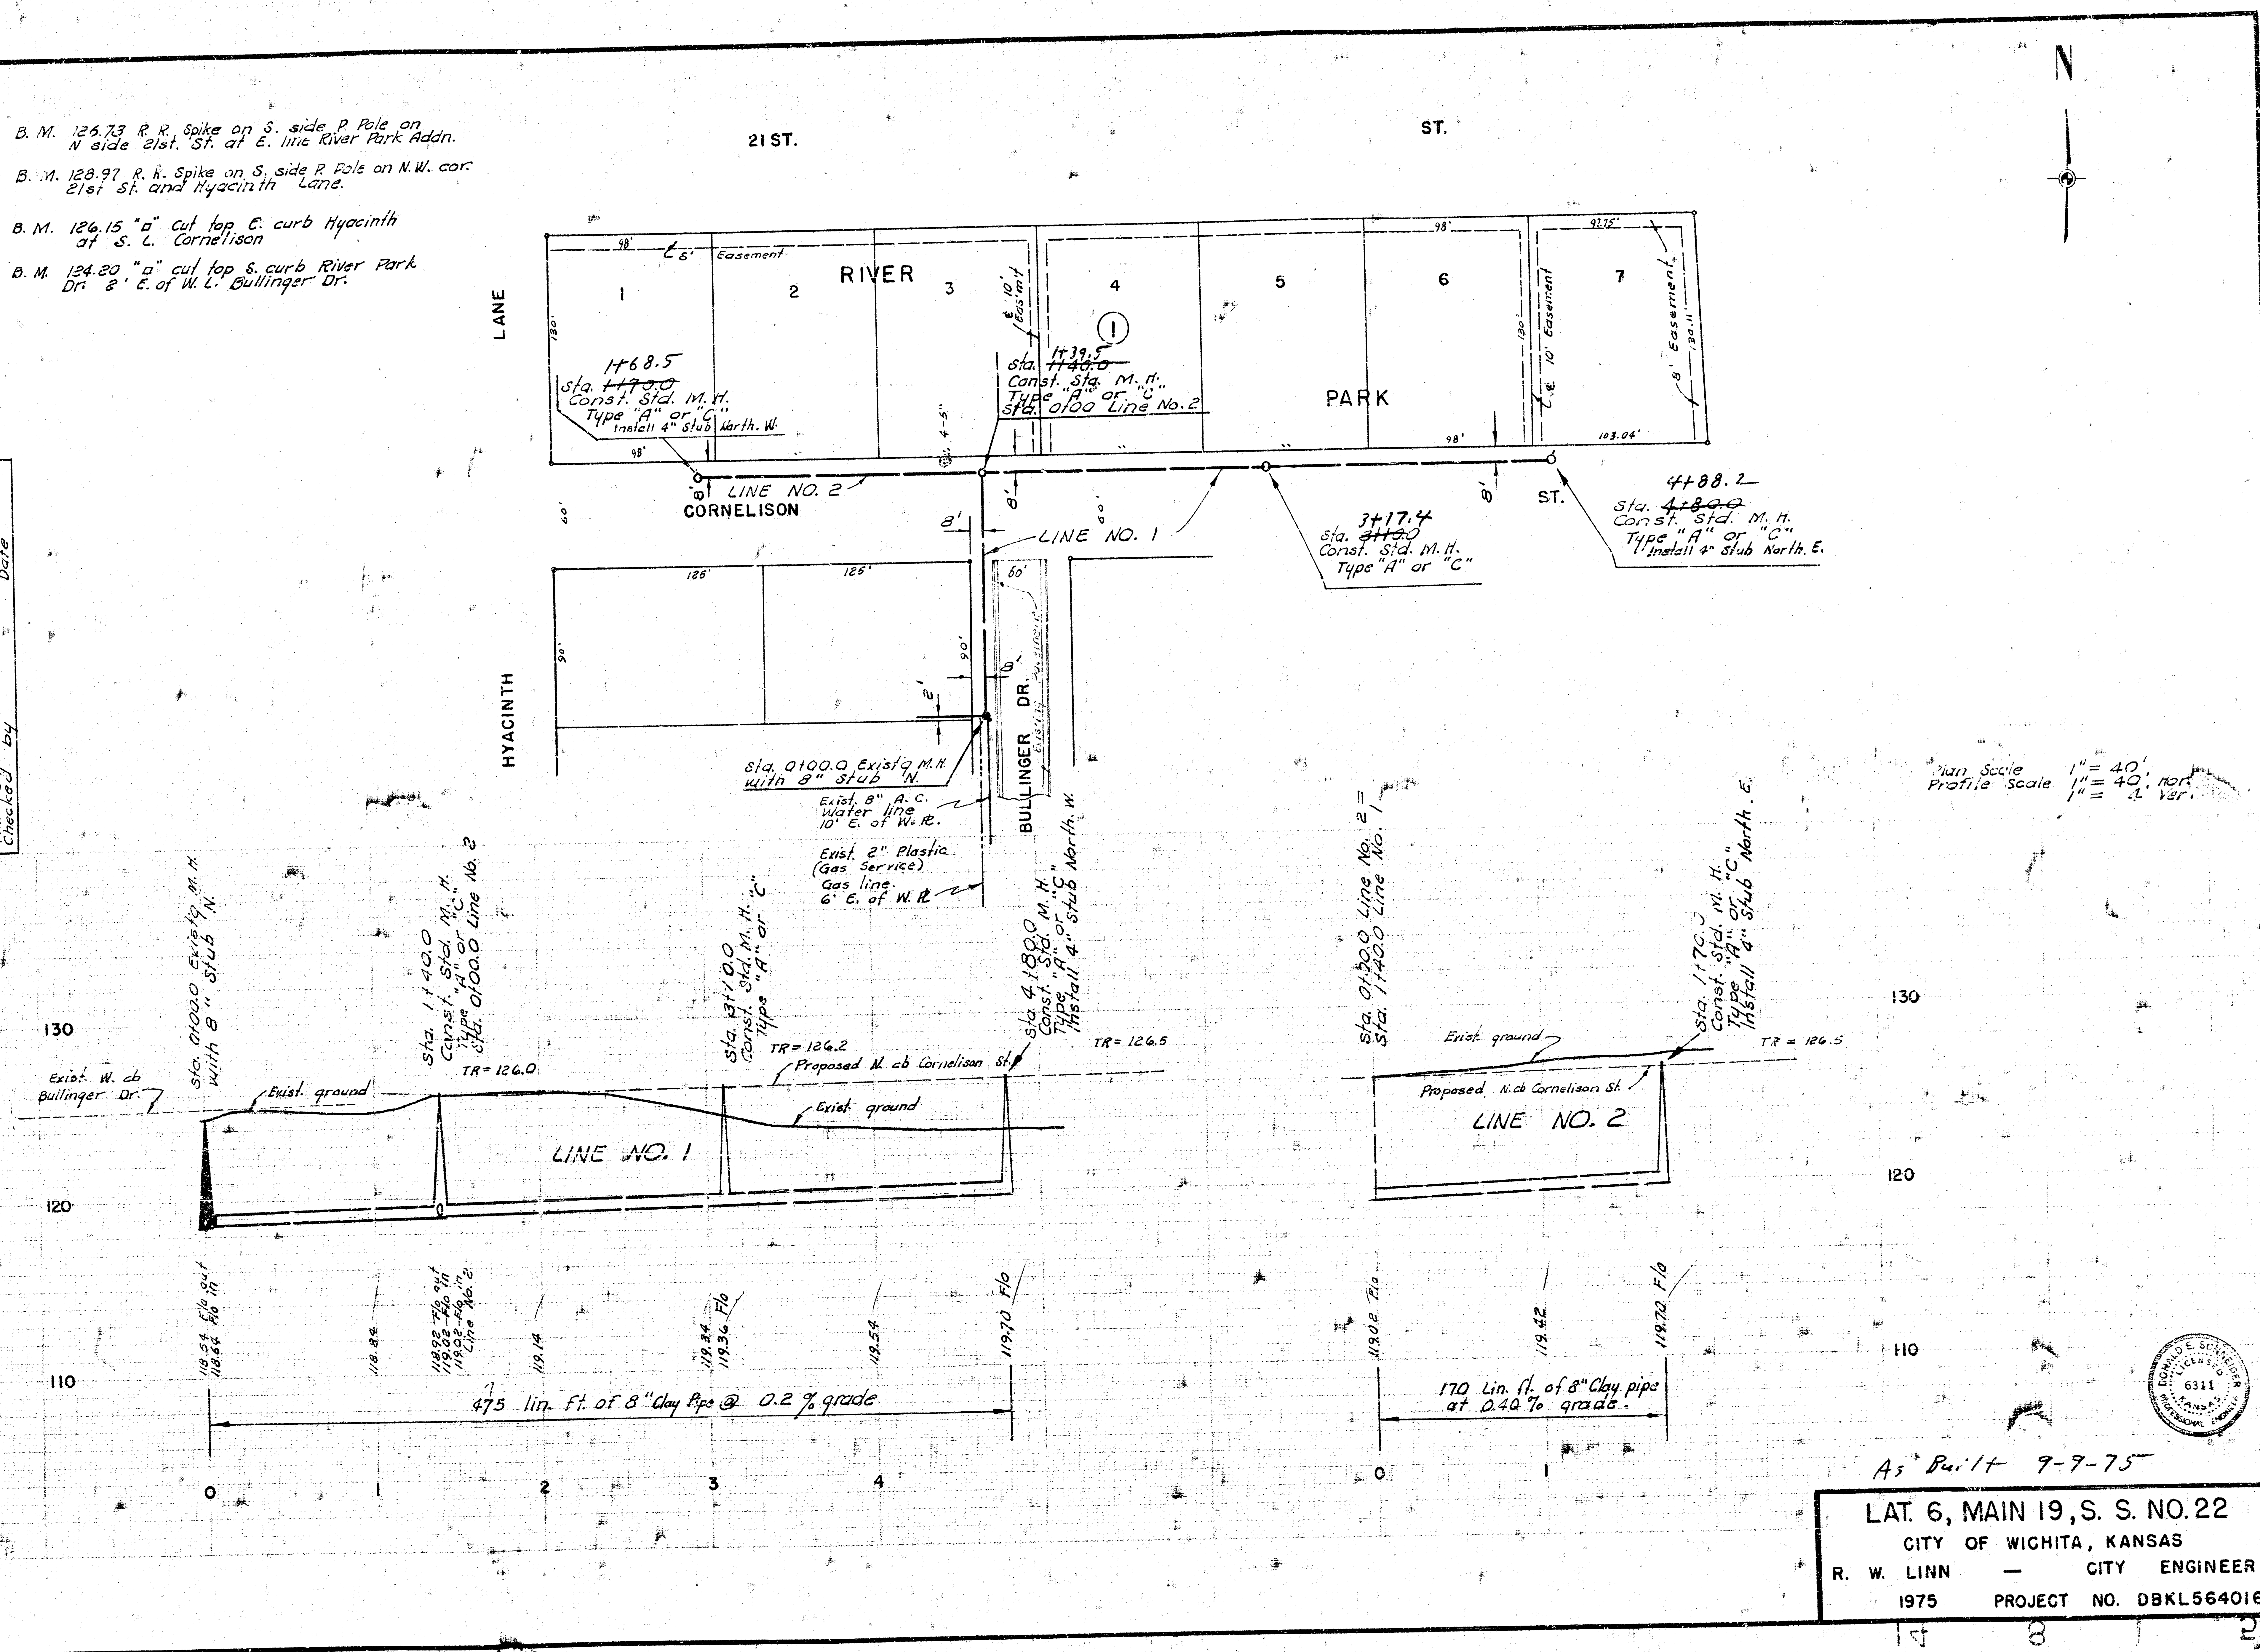

Plan Scale 1" = 40'
 Profile Scale 1" = 40' vert.

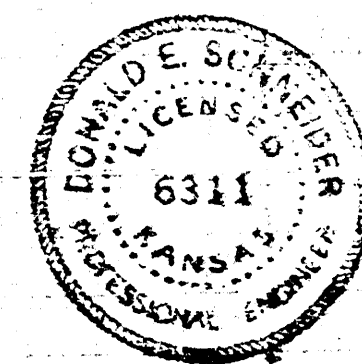

As Per 17 9-7-75

LAT. 6, MAIN 19, S. S. NO. 22
CITY OF WICHITA, KANSAS
R. W. LINN — CITY ENGINEER
1975 PROJECT NO. DBKL564016