
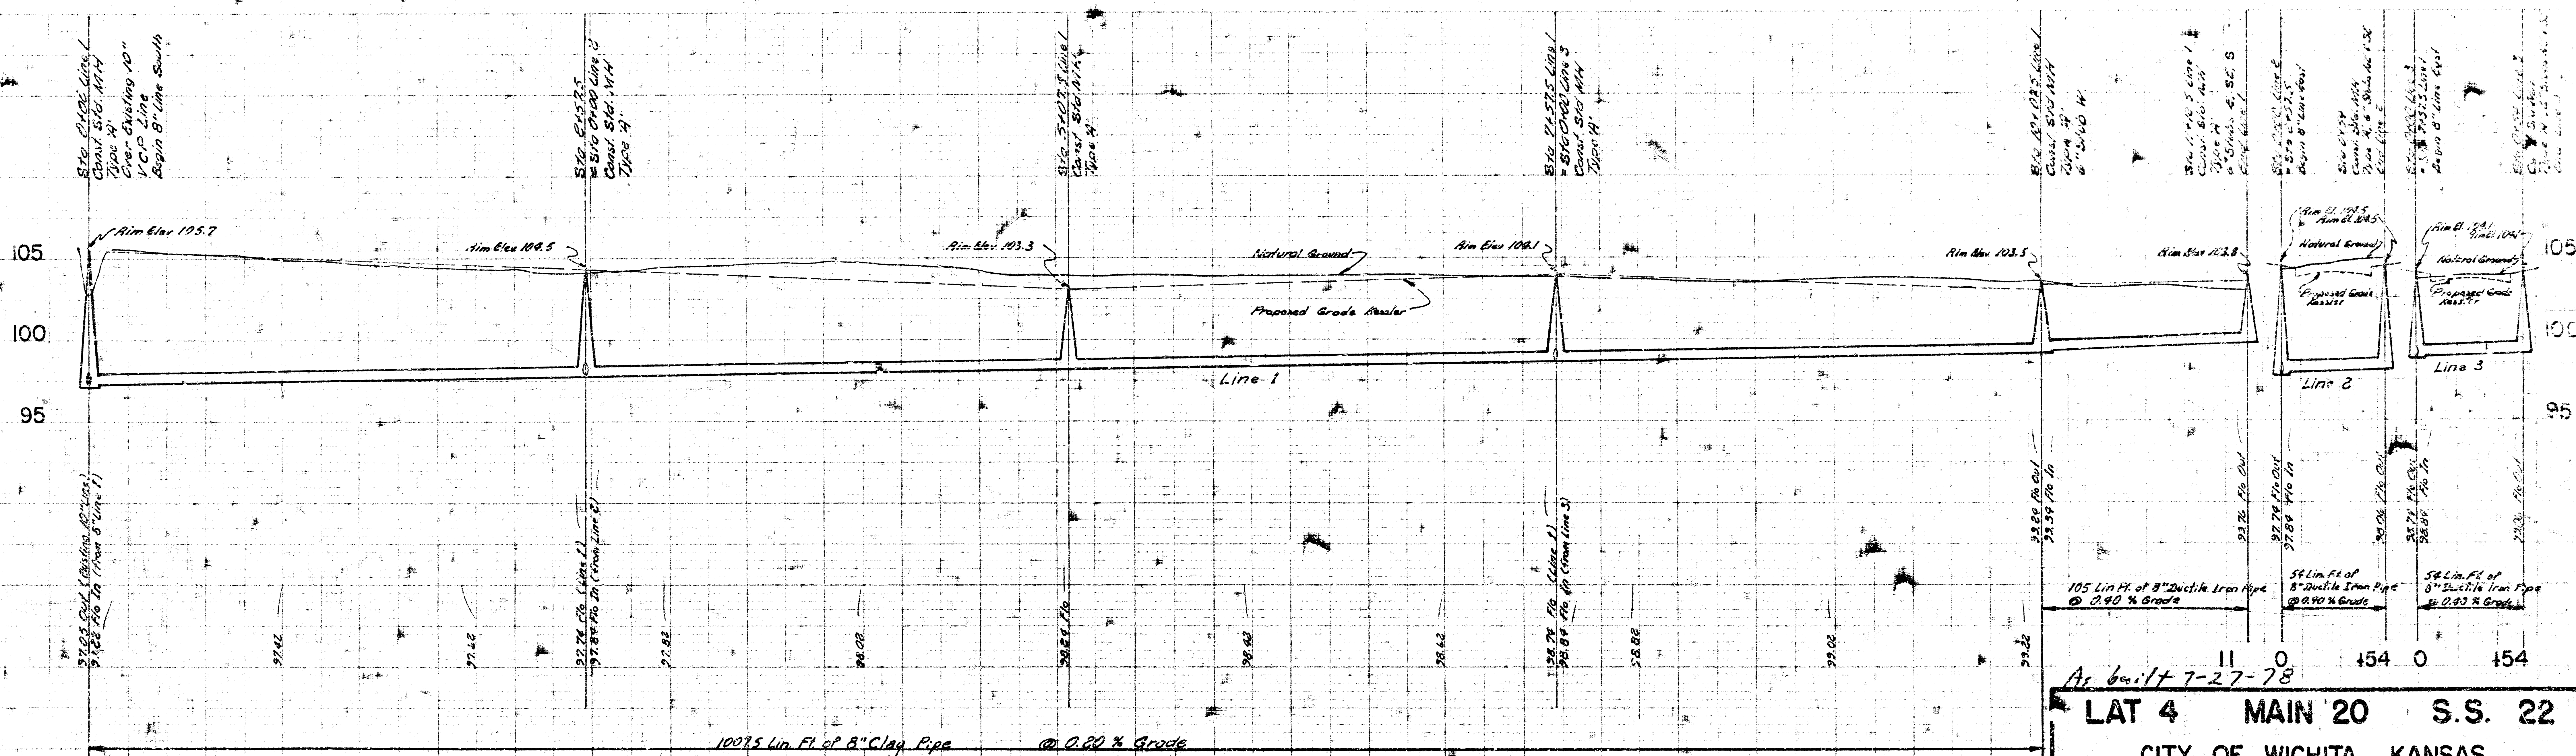


B.M. 106.39 USCGS Std. Disc. stamped "K 39 1934" at Intersection of Mo. Pac. RR & Santa Fe RR; Near West Street and
Park; 61' Southeast of Intersection and 47' South of C. Mo. Pac. RR.

Plan Scale: 1" = 40'
Profile Scale: 1" = 40' Horiz.
1" = 5' Vert.

DRAINAGE

DEDICATION

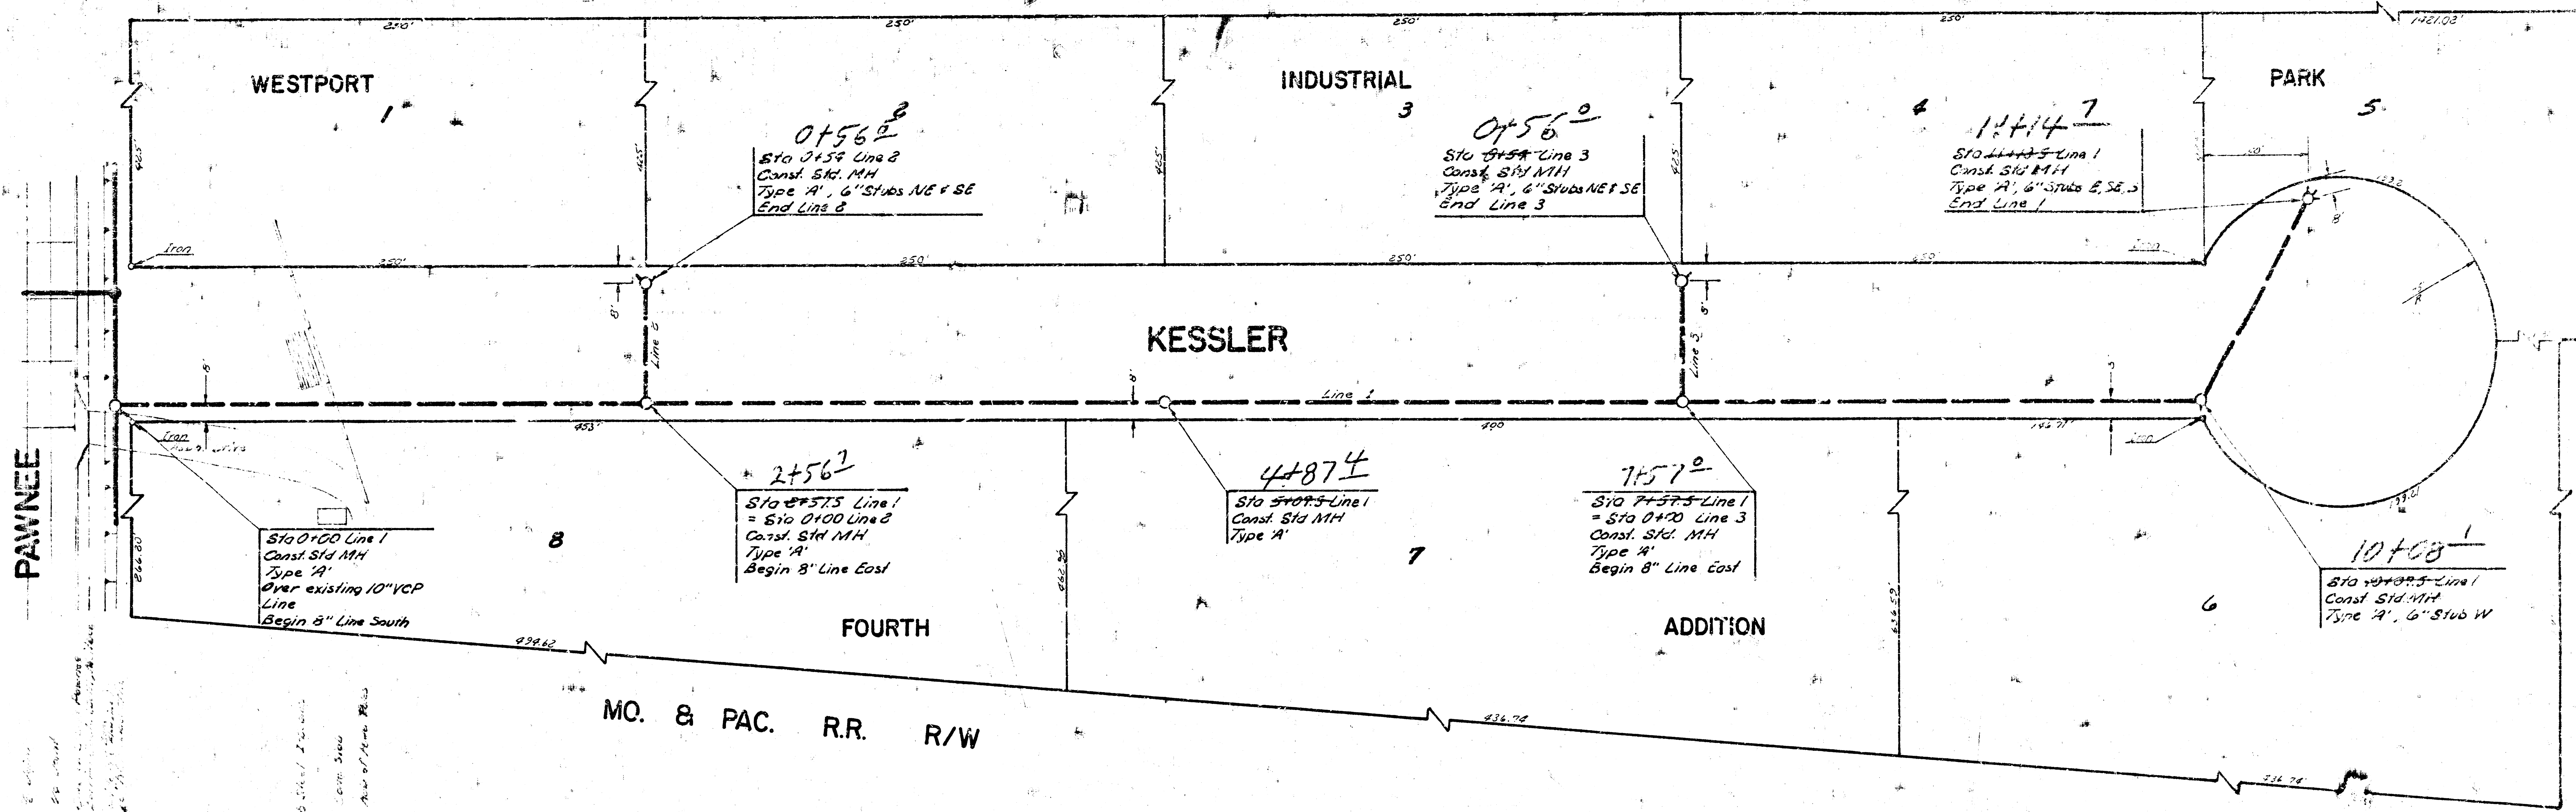

As built 7-27-78
LAT 4 MAIN 20 S.S. 22
CITY OF WICHITA, KANSAS
R.W. LINN
CITY ENGINEER