

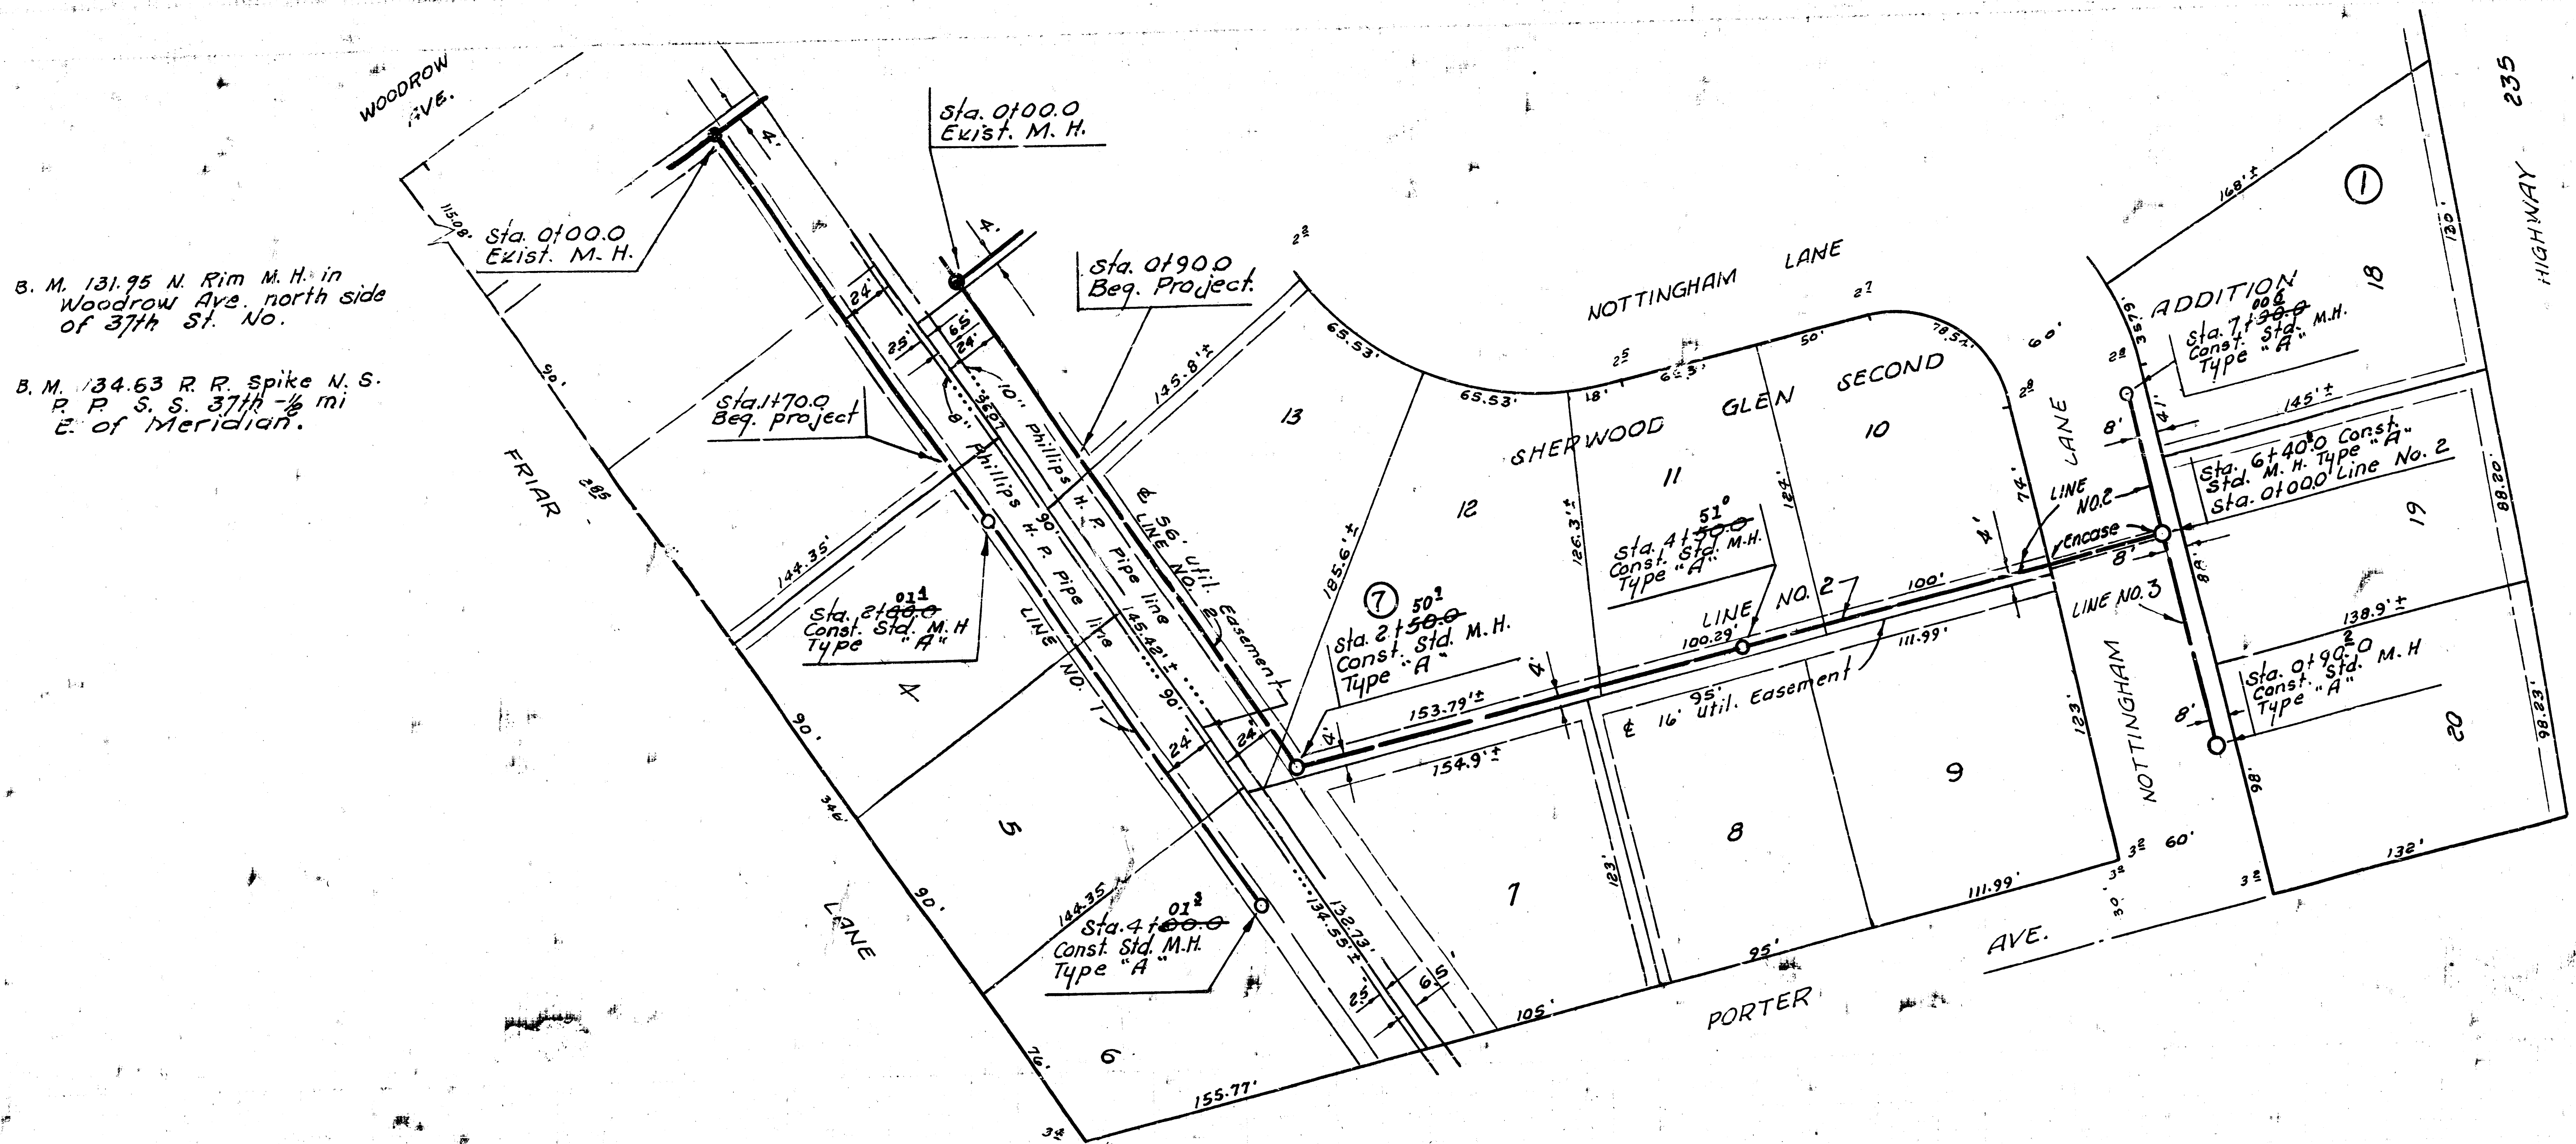


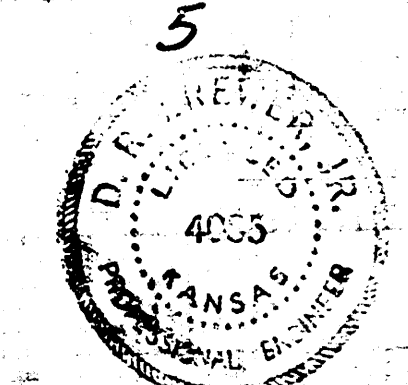

Plan Scale 1" = 40'
 Profile Scale 1" = 5' Vert

NOTE:
 Contractor to provide
 a minimum of 30 inch
 cover over sanitary
 sewer.

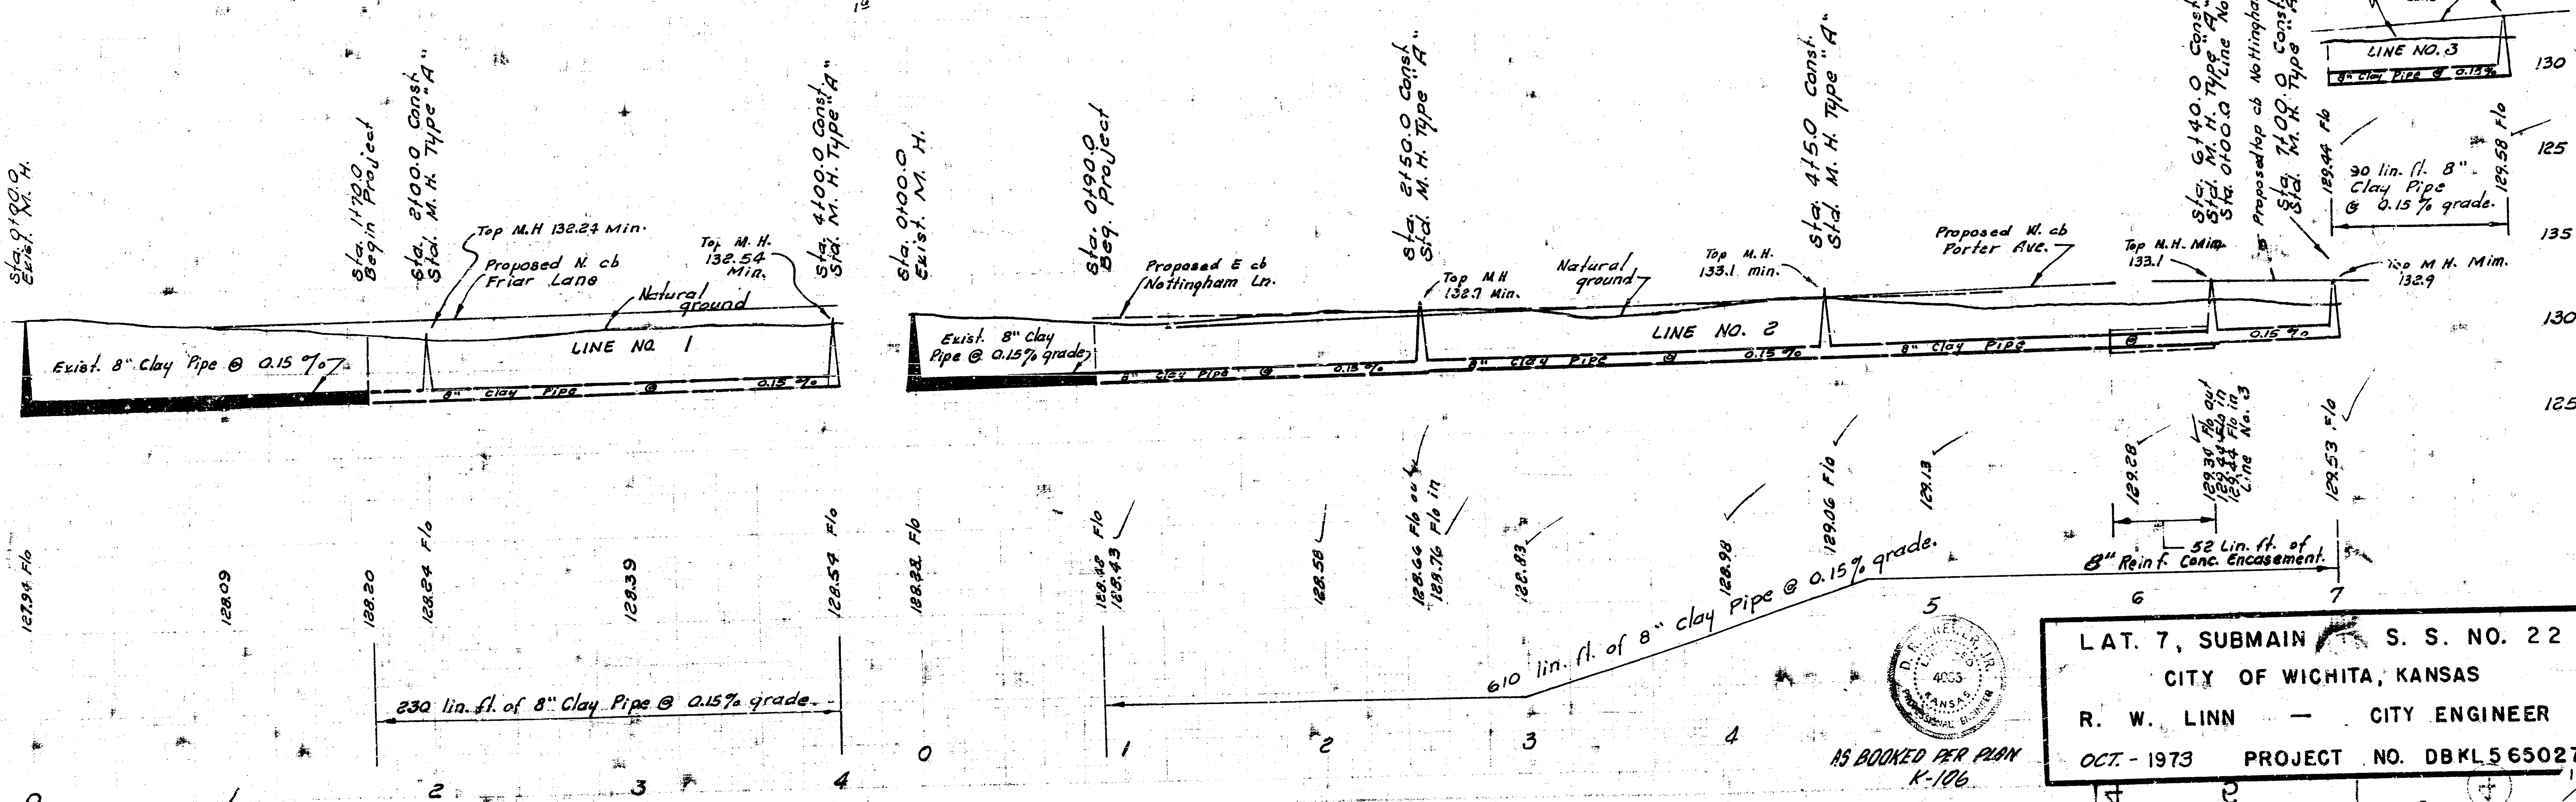

L.A.T. 7, SUBMAIN S. S. NO. 22
 CITY OF WICHITA, KANSAS
 R. W. LINN — CITY ENGINEER
 OCT. - 1973 PROJECT NO. DBKL565027

No Gas in or under