



B.M. 98.51 "D" top of curb North-return
 N.E. corner 33rd St. So. & Leonine
 B.M. 100.68 "D" top of curb East-return
 S.E. corner 31st St. So. & Kessler
 B.M. 103.75 City Std. disc 52'E. & 43'N.
 of E. of 31st St. So. & West St.

R.L.K. 2/7
 R. Loomis

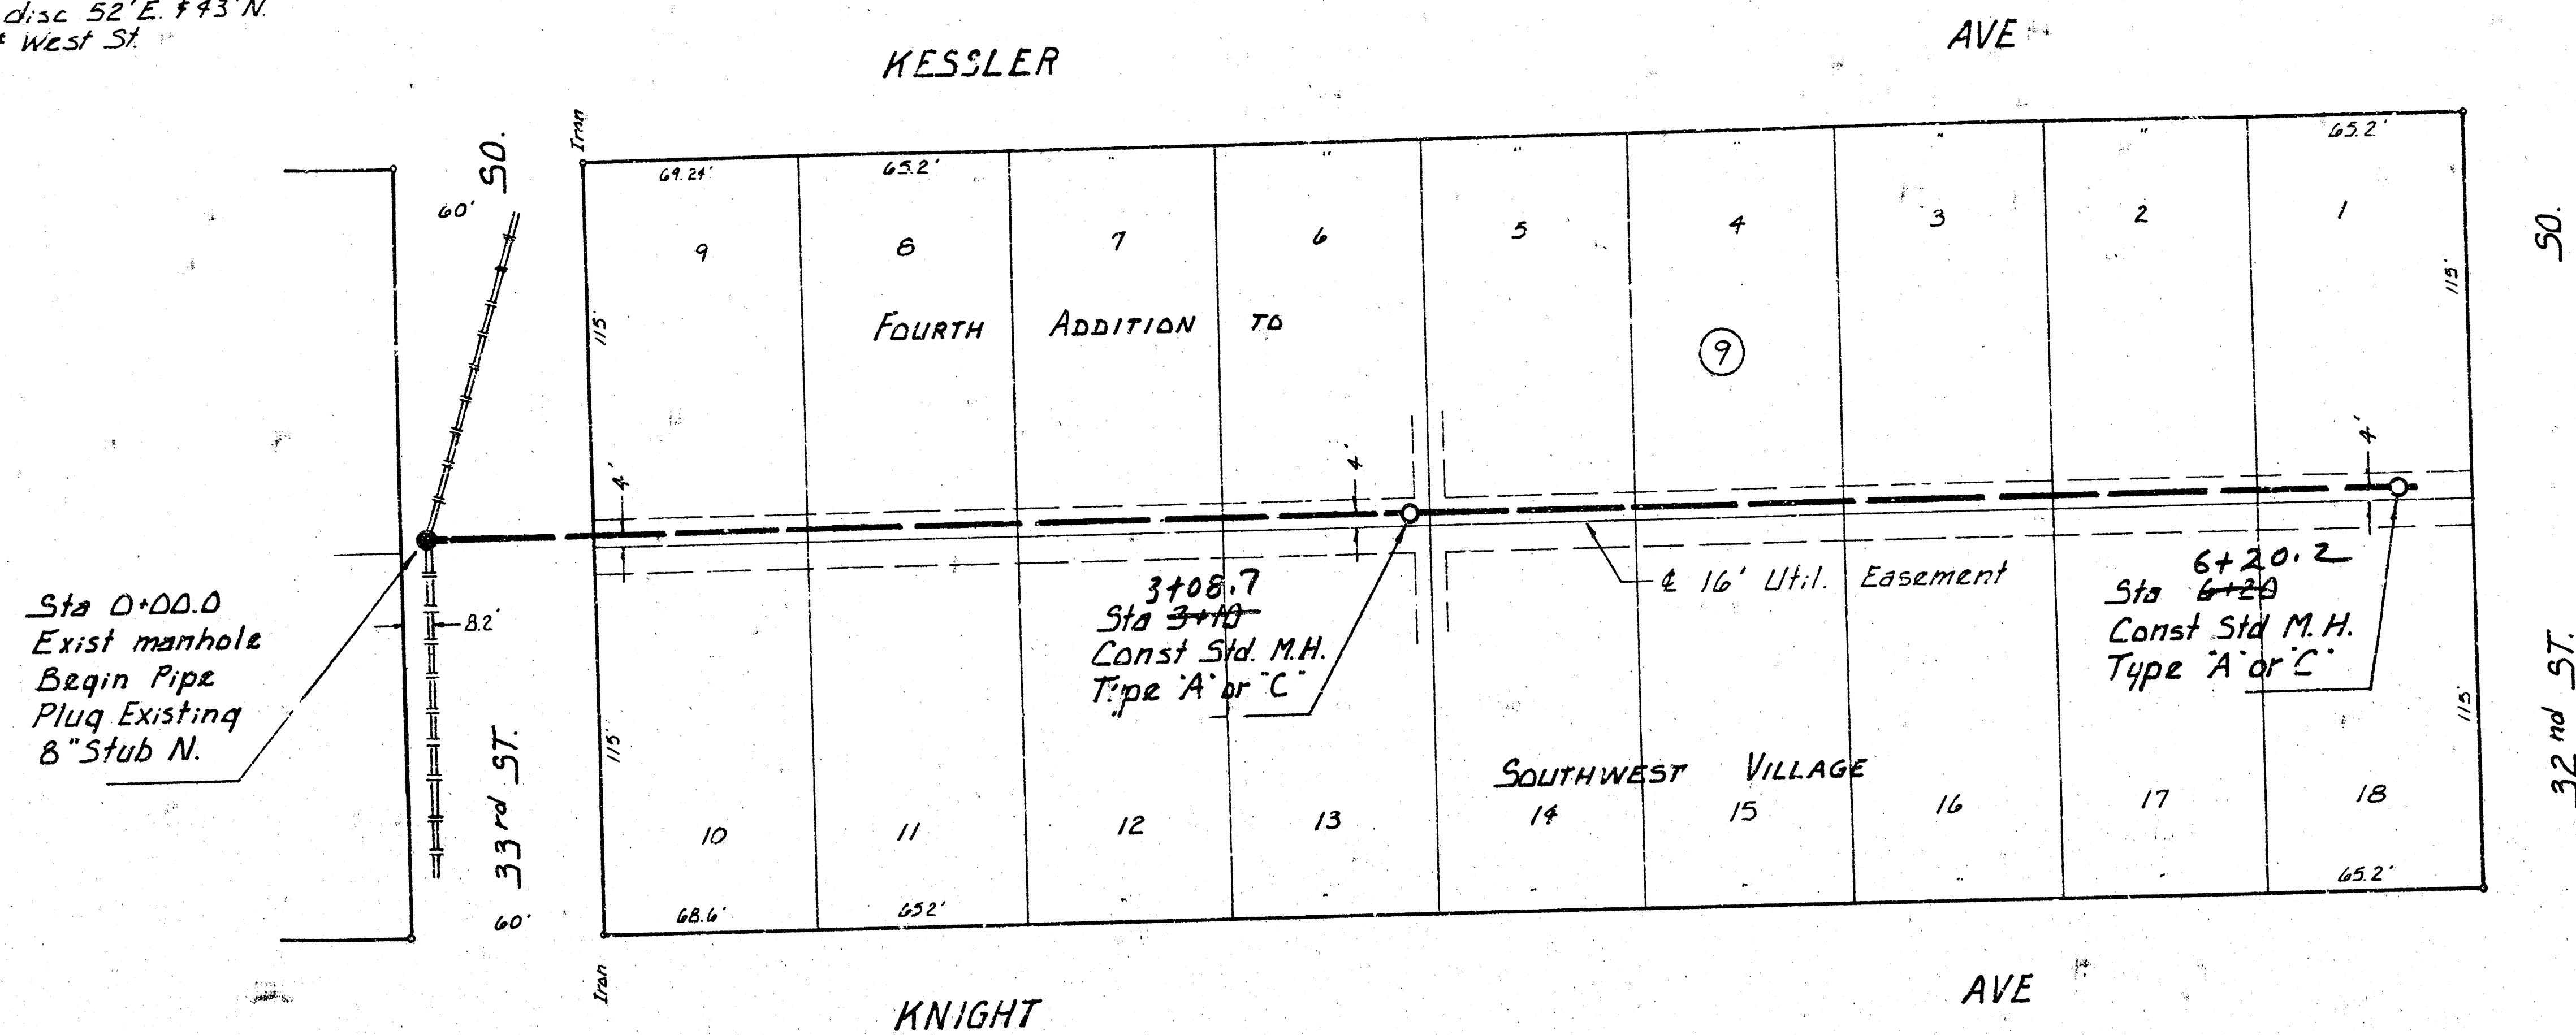

Plan Scale 1"=40'
 Profile Scale 1"=40' Horiz.
 1"=5' Vert.

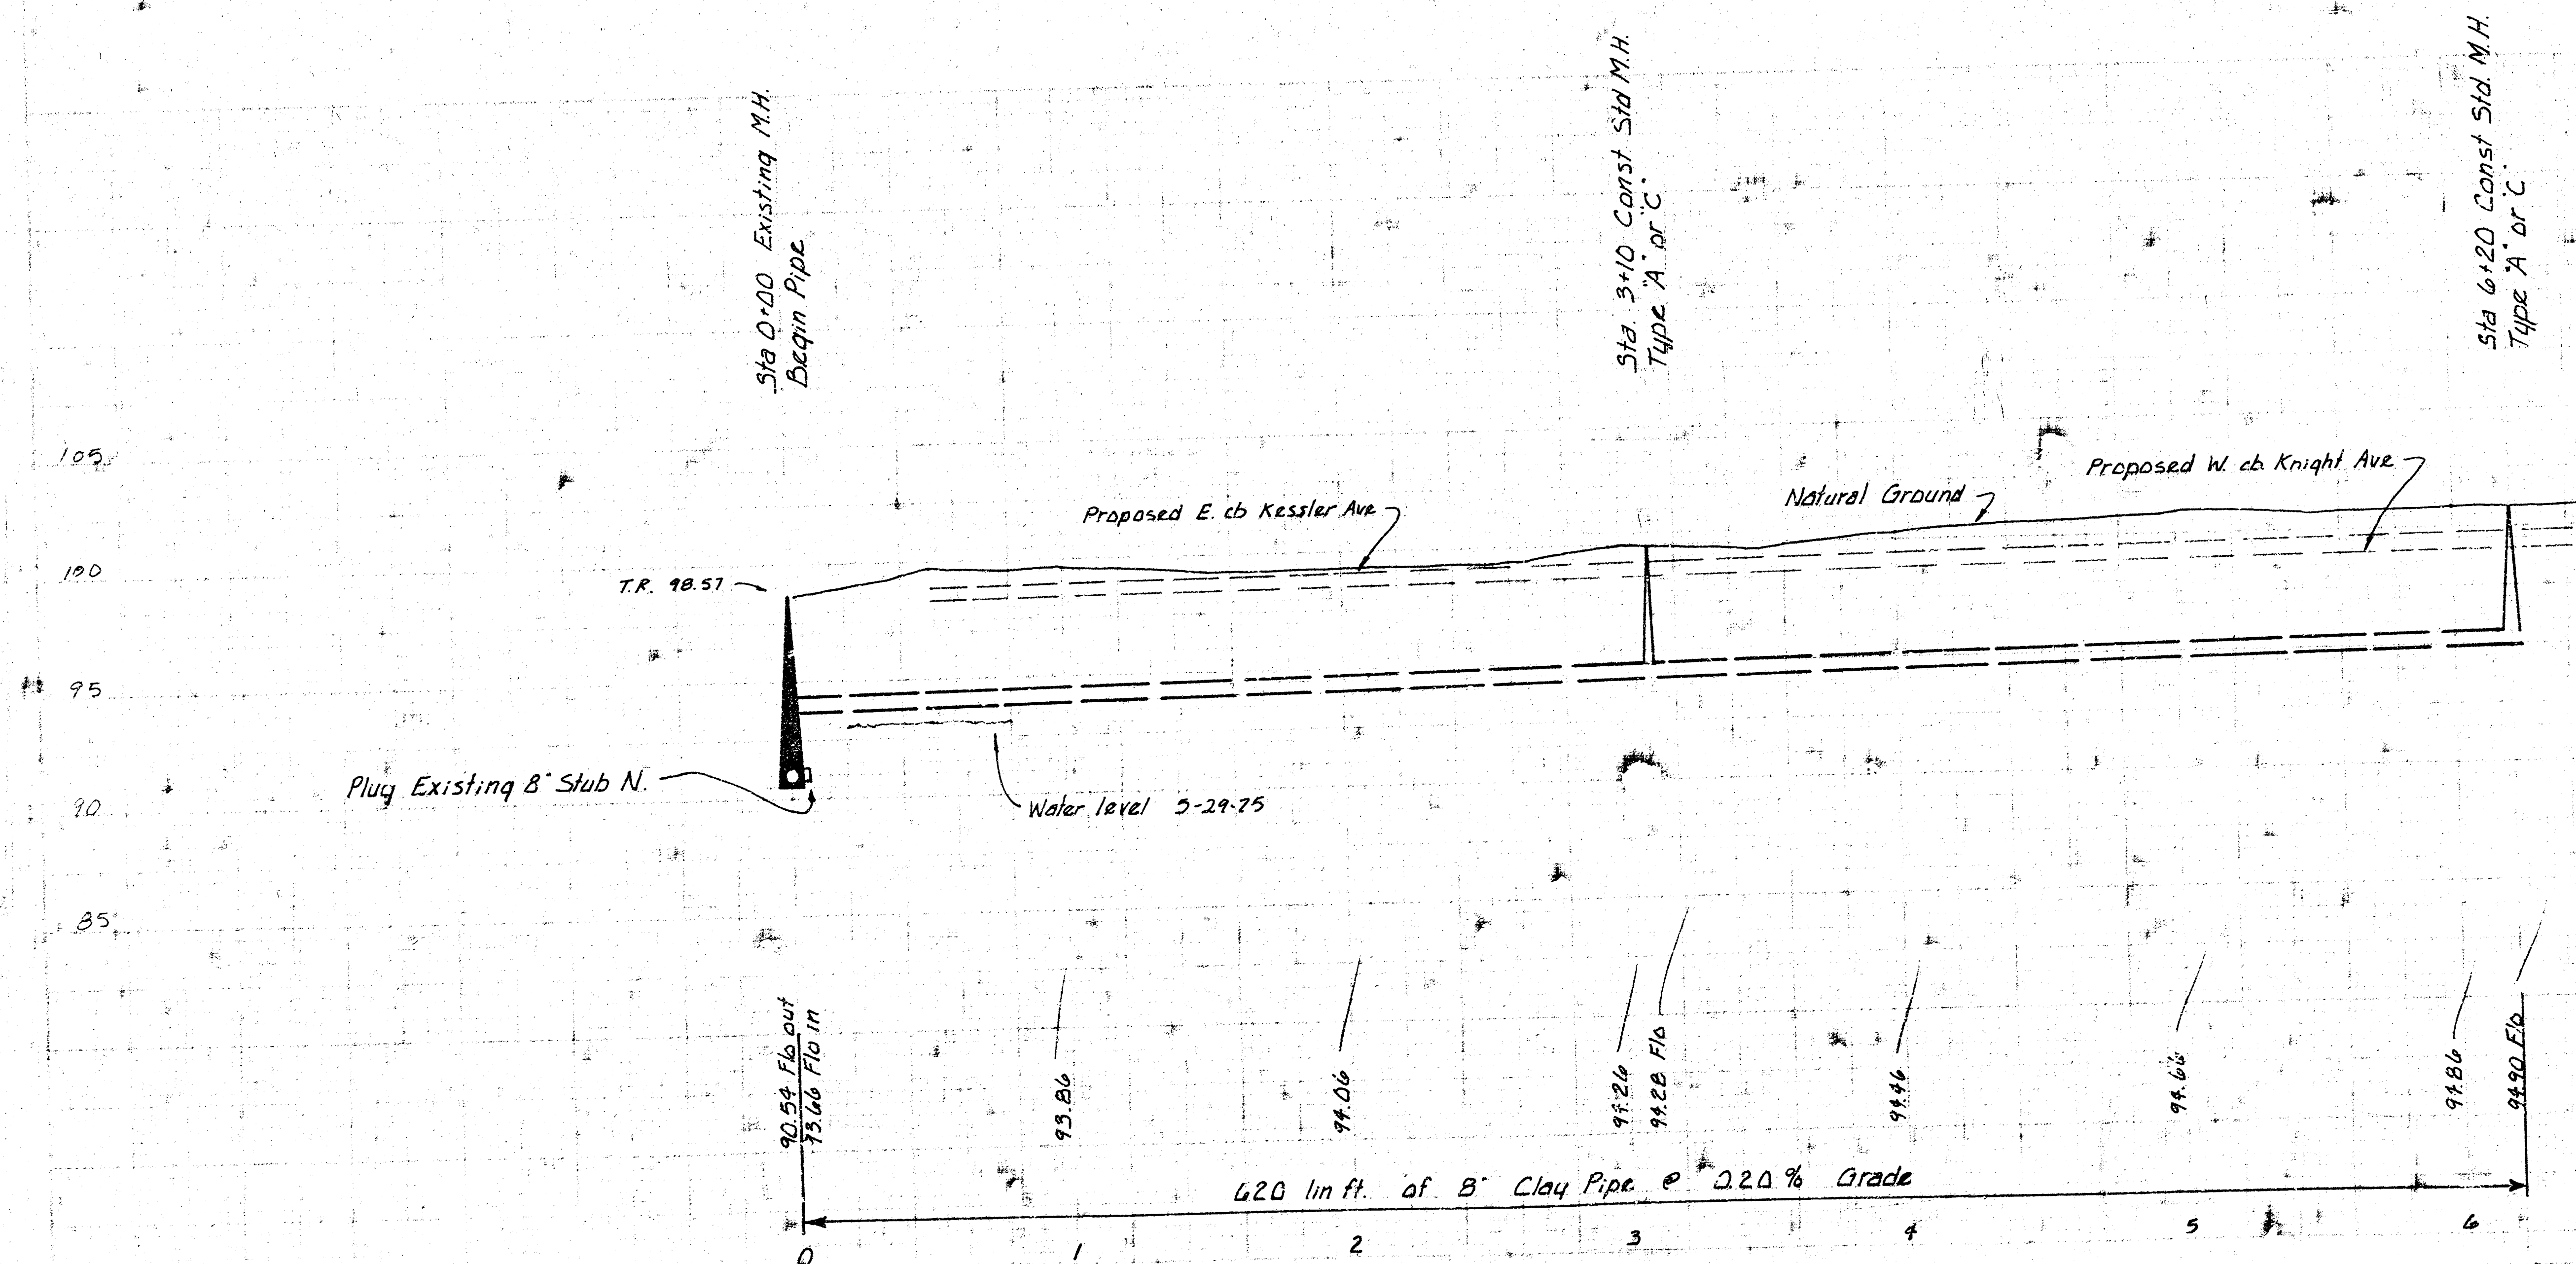

LAT. 3, MAIN 23, S.S. NO 22
 CITY OF WICHITA, KANSAS
 R. W. LINN — CITY ENGINEER
 PROJECT NO. DBKL574101 1/2

