
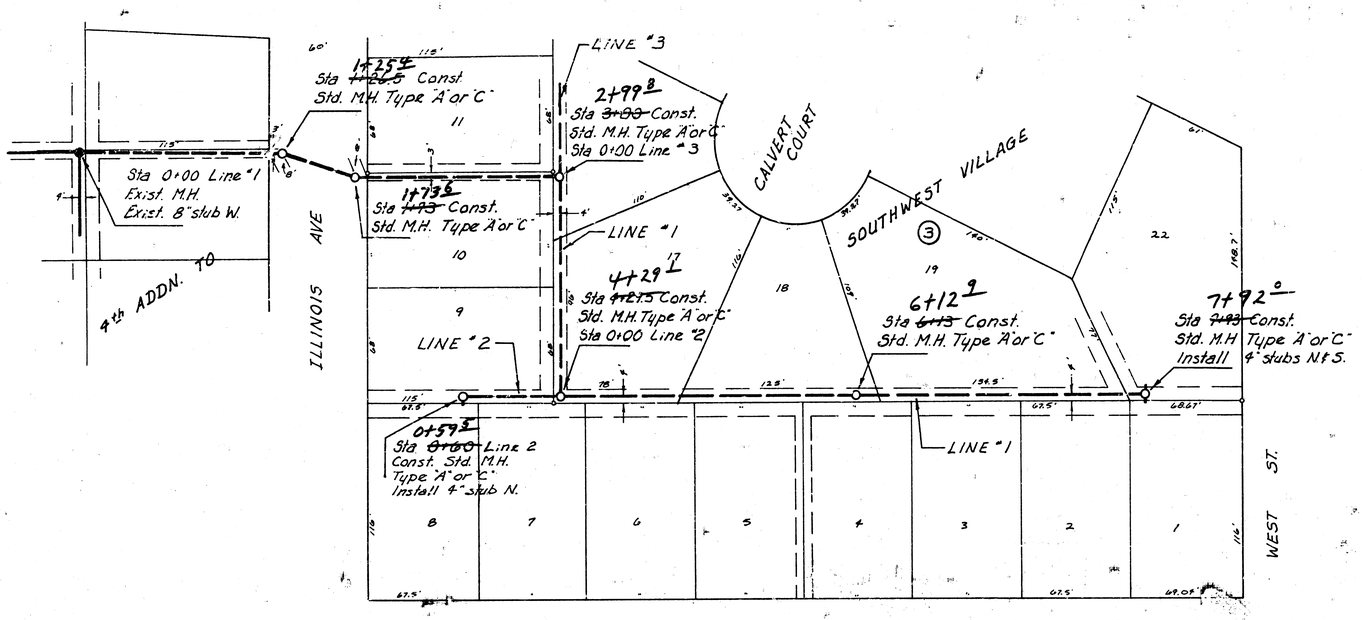


PLAN SCALE 1" = 40'
PROFILE SCALE 1" = 40' HORZ.
1" = 5' VERT.

B.M. 103.47 City Std. 33' E & 4' S. of
E West St. & 31st St. So.

B.M. 100.80 "O" cut on N.W. corner of
East Headwall to R.C.B. just N. of
81 By-Pass South of 31st St. on West St.

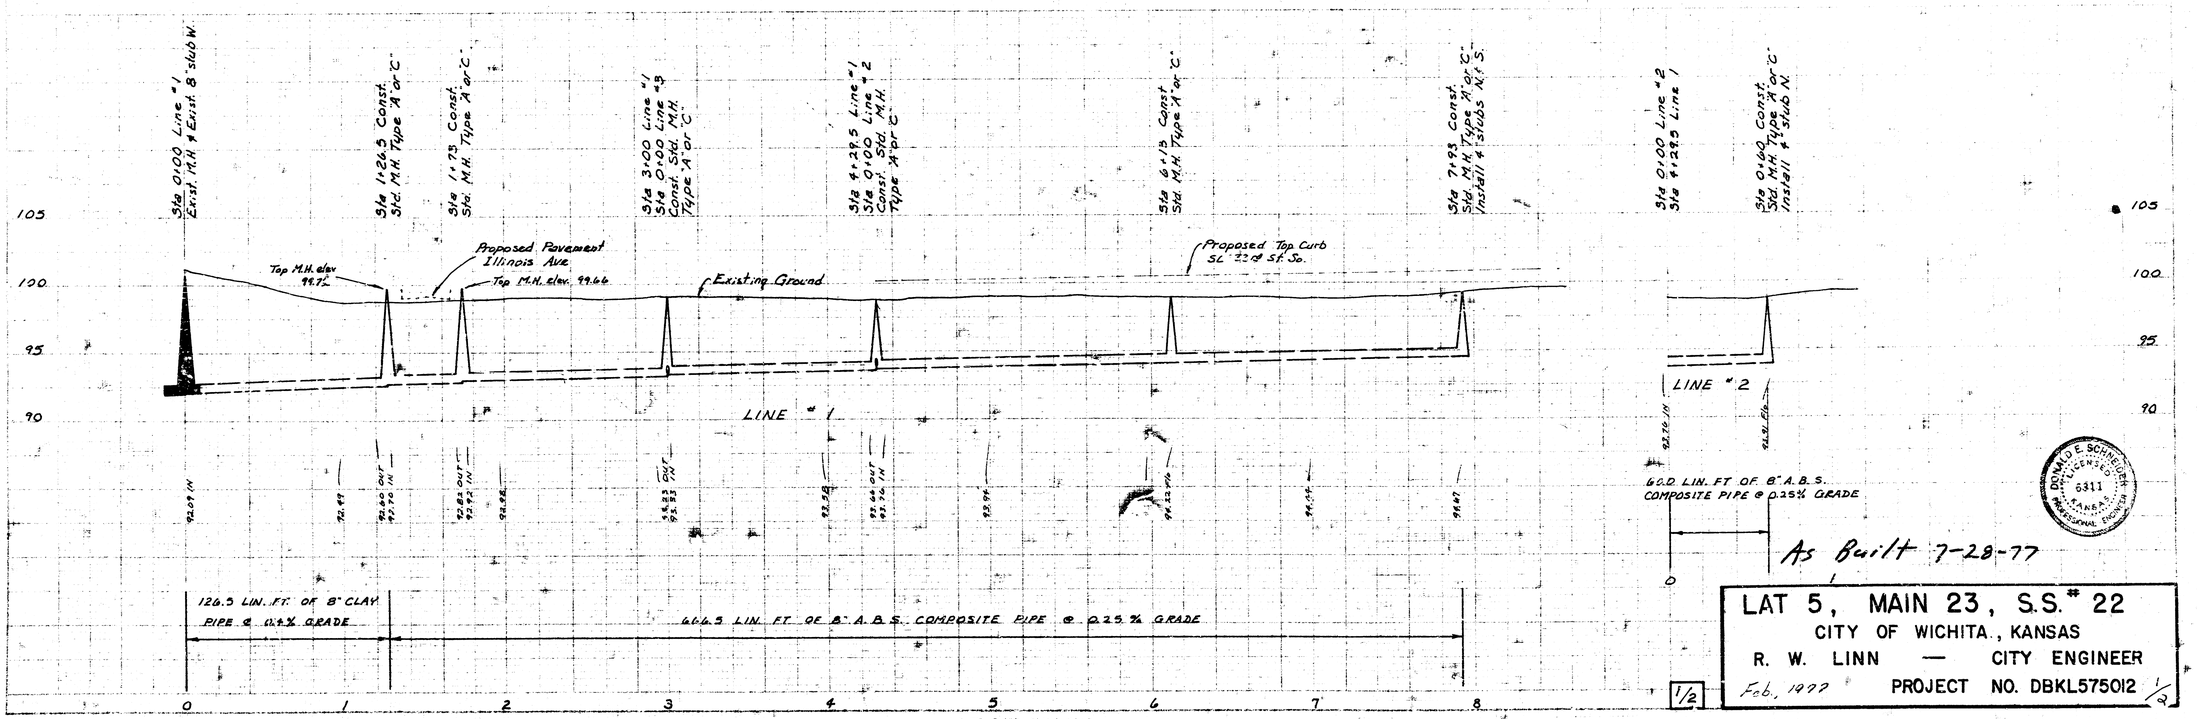

DONALD E. SCHNEIDER
LICENSED
6311
KANSAS
PROFESSIONAL ENGINEER

As Built 7-28-77


LAT 5, MAIN 23, S.S.# 22


CITY OF WICHITA., KANSAS

R. W. LINN — CITY ENGINEER

Feb. 1977 PROJECT NO. DBKL575012

1/2

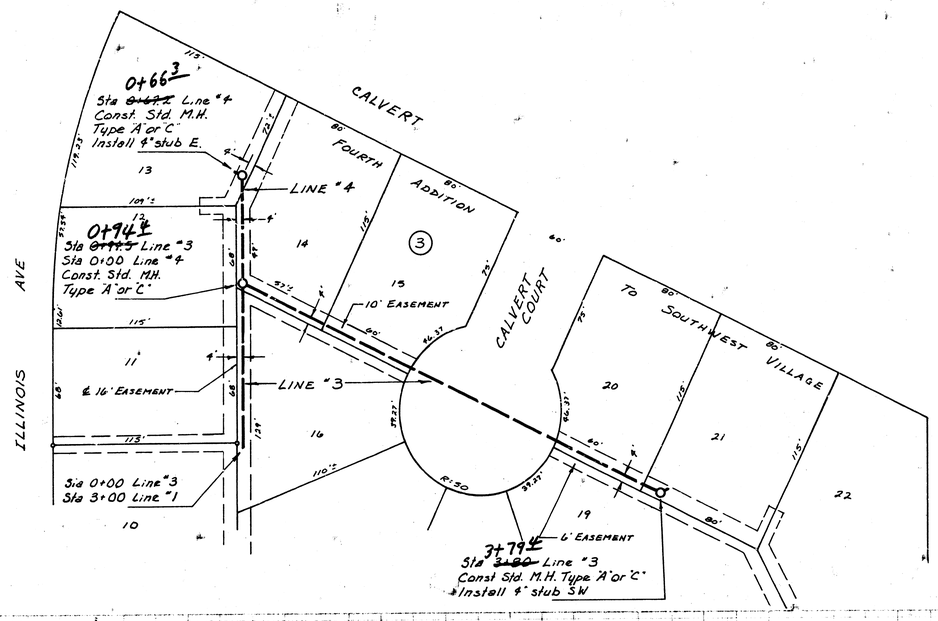

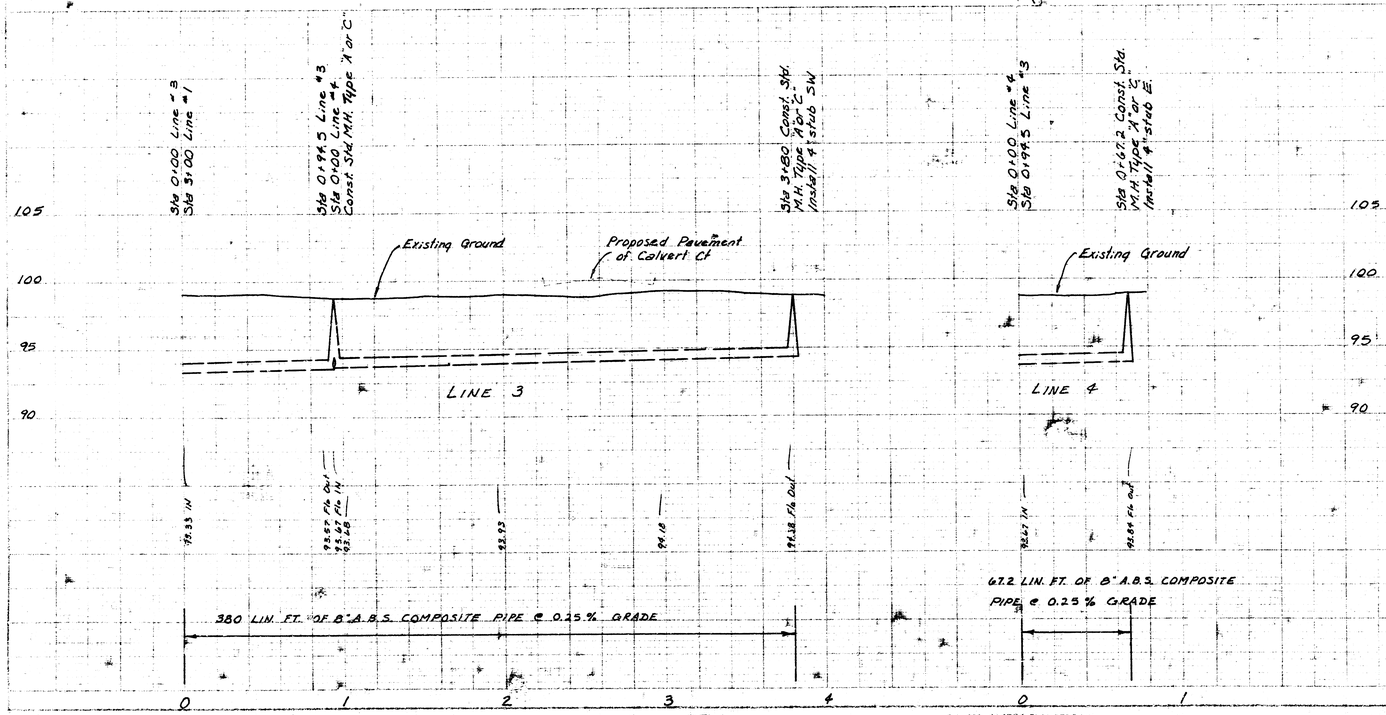

LAT 5, MAIN 23, S.S. #22
Feb, 1977 PROJECT NO. DBKL575012

2/2

14 10 3 17