


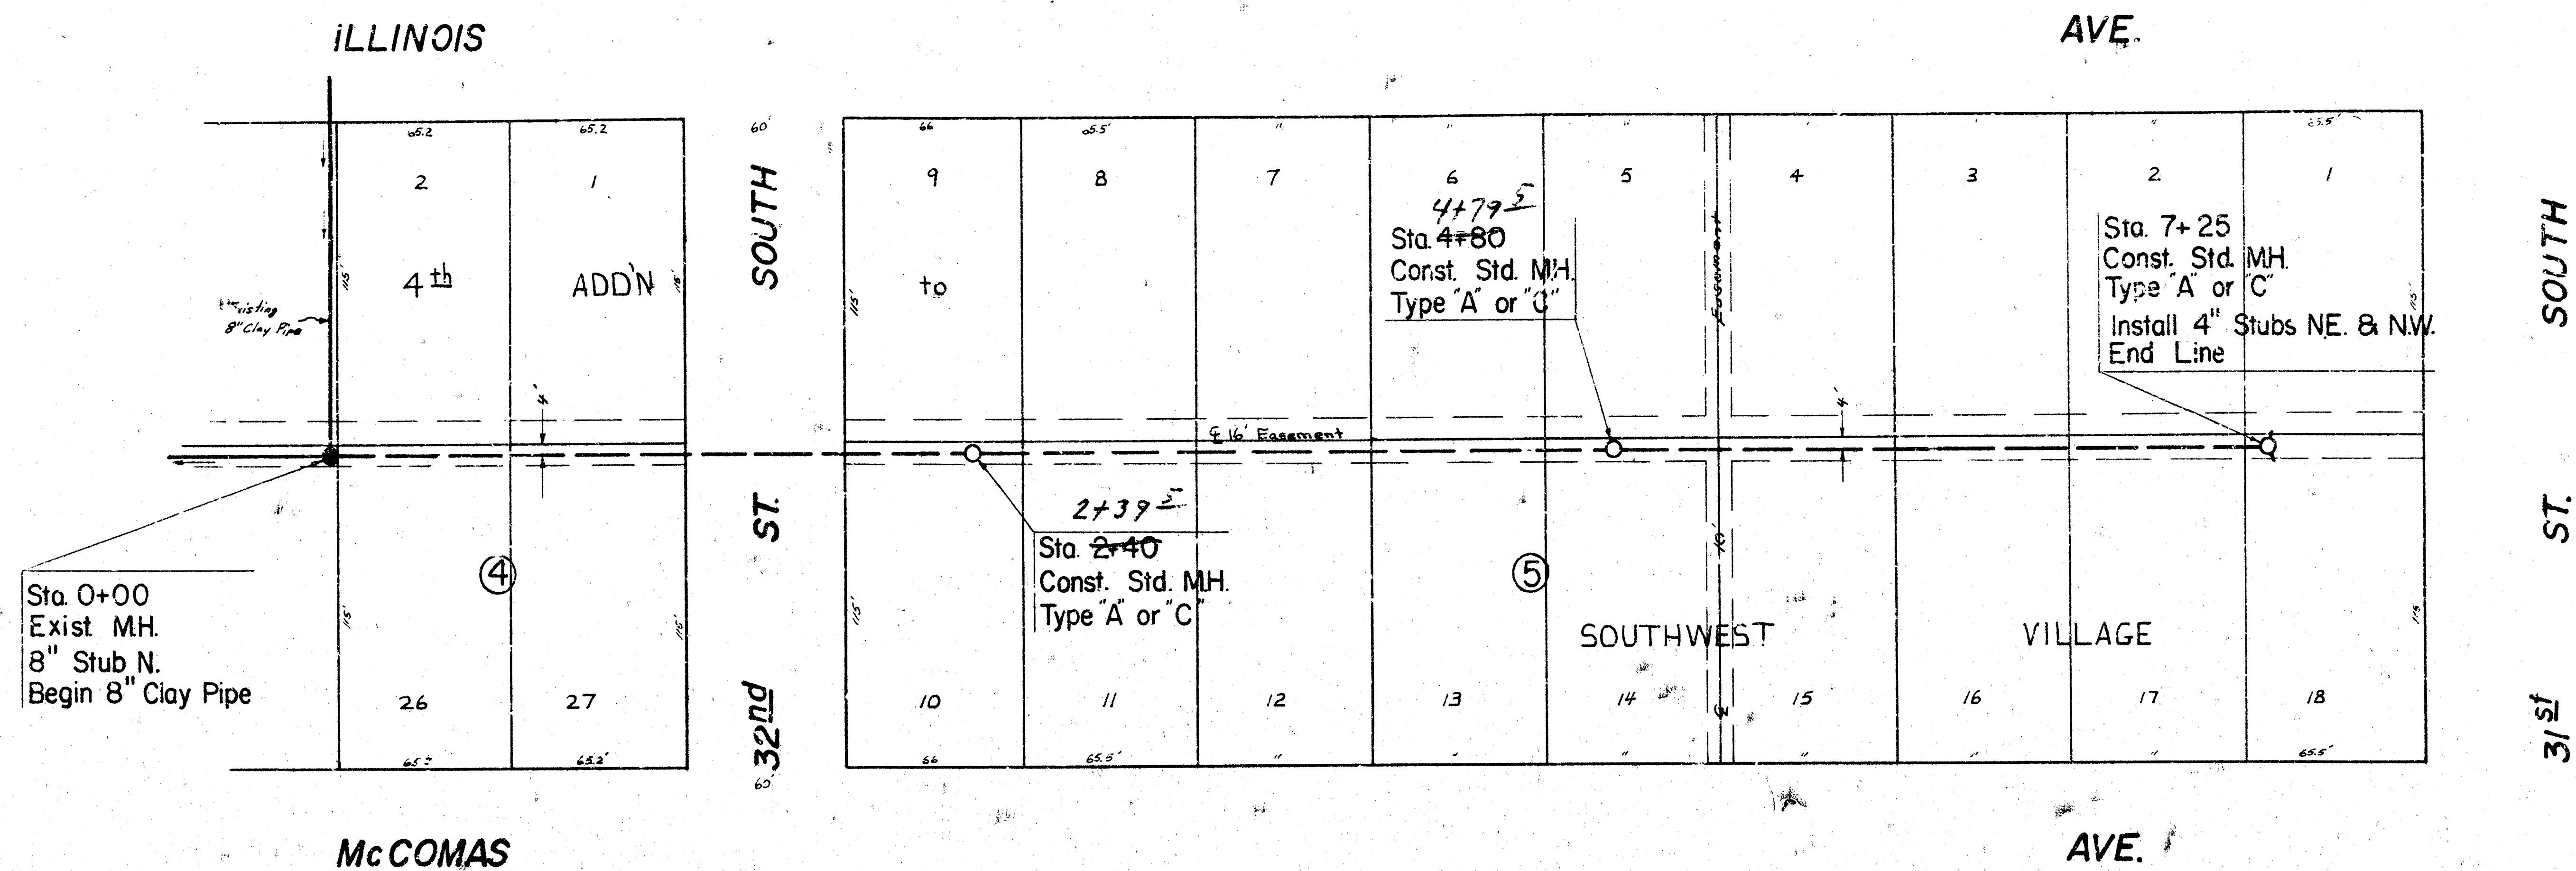

Plan Scale: 1" = 40'
Profile Scale: 1" = 40' Horiz.
1" = 5' Vert.

BM 100.68 " + " on top of curb at the east end of return SE corner of Kessler Ave. and 31ST St. South

