


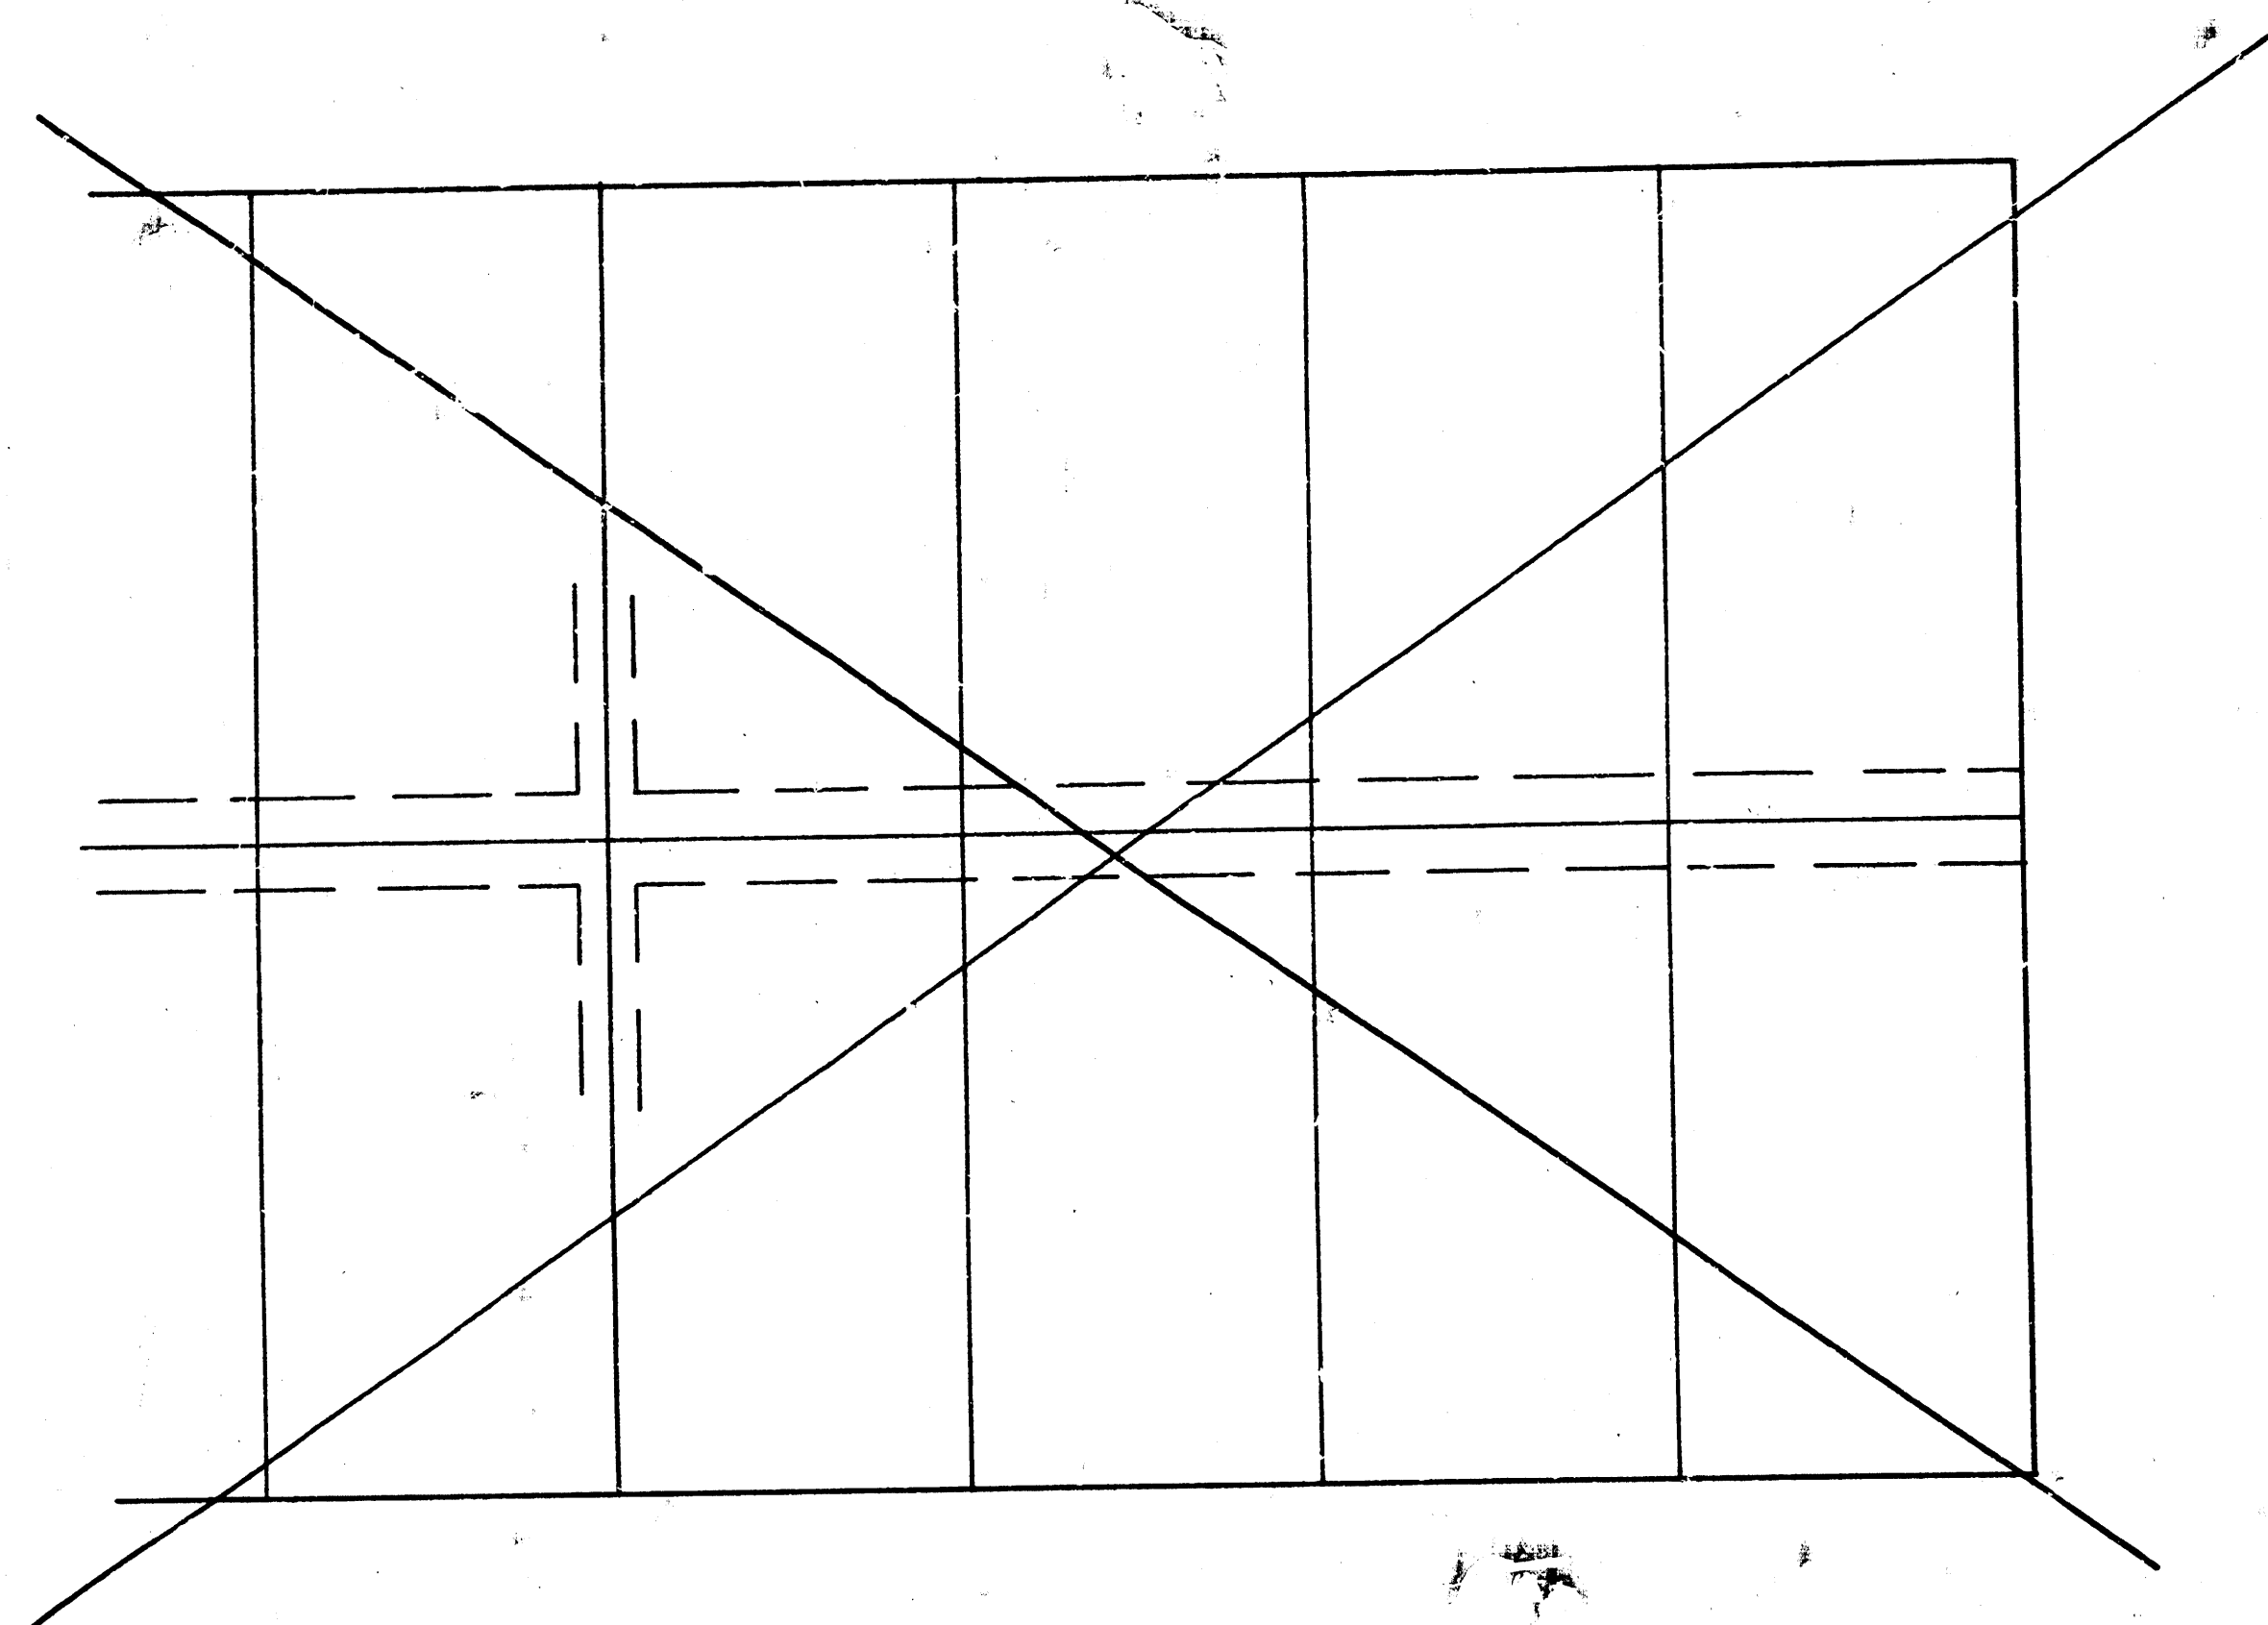


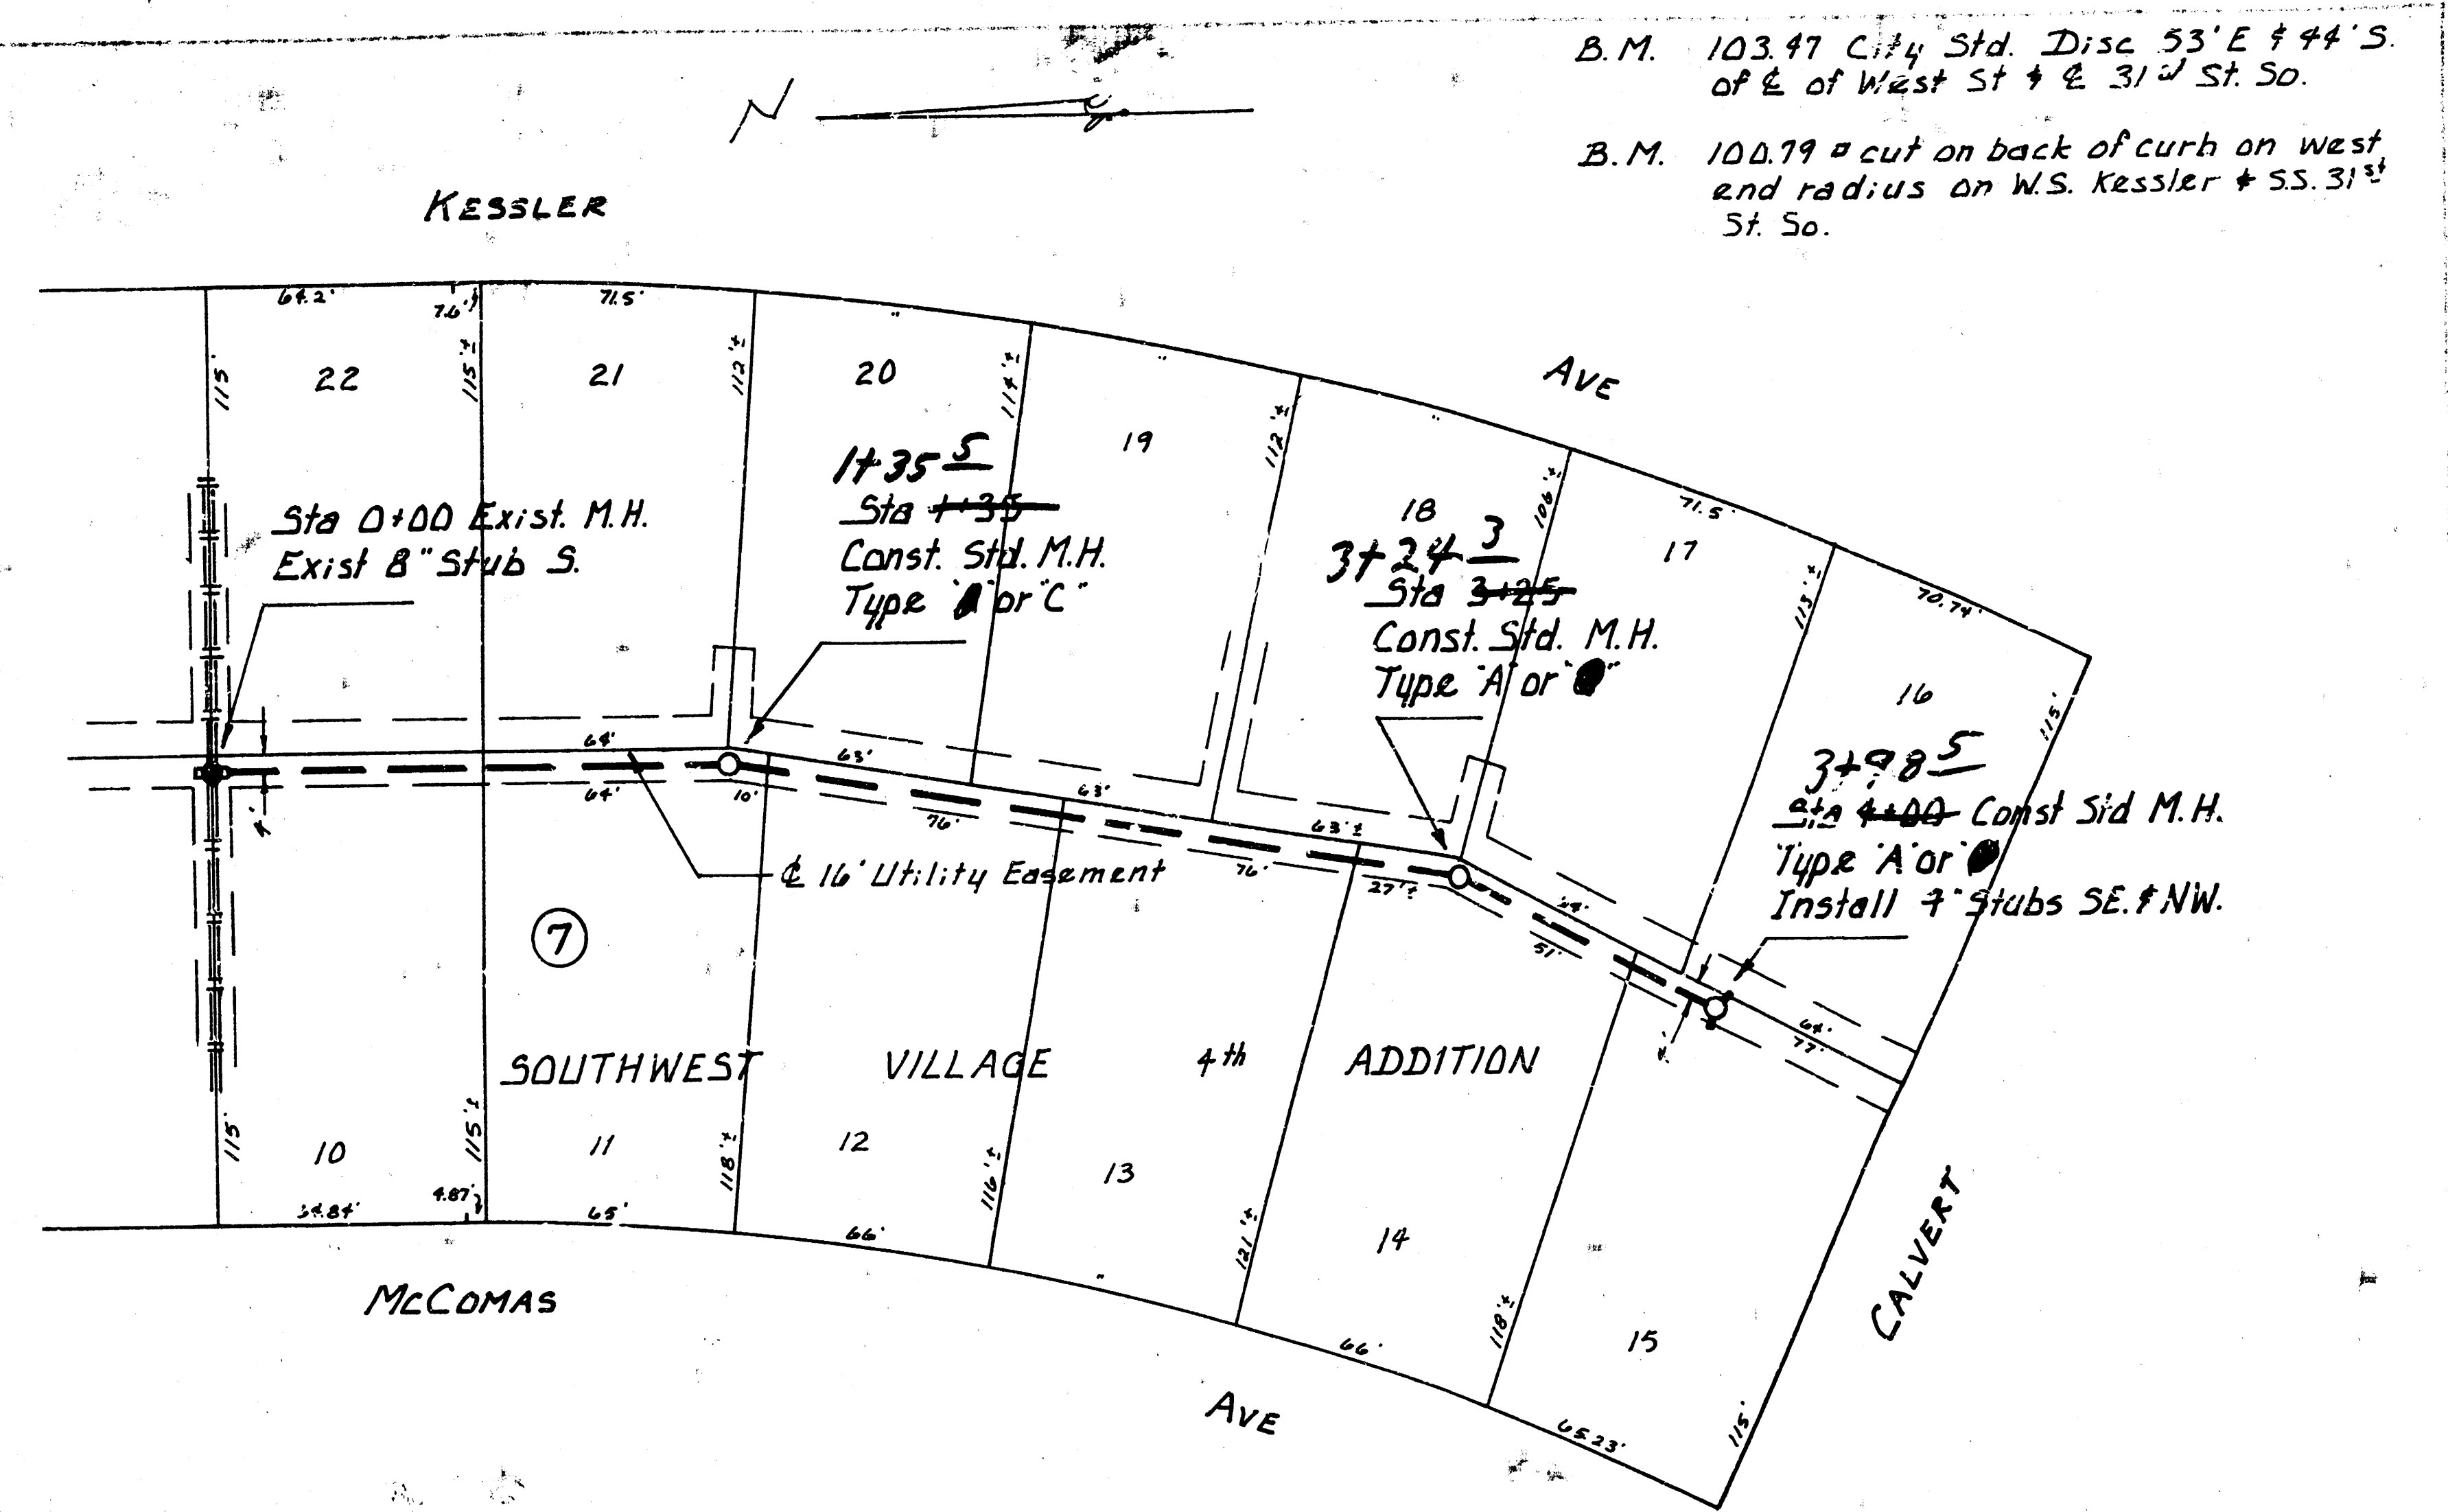

Since APR 29 81
 Plan R. Linn
 Ex.
 Checked

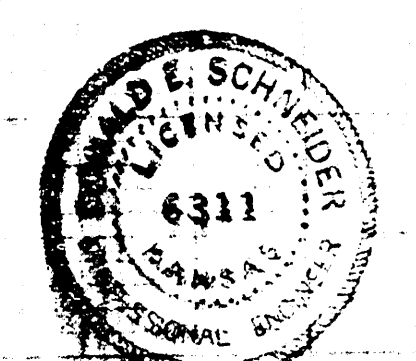

Plan Scale 1"=40'
 Profile Scale 1"=40' horiz.
 1"=5' Vert.

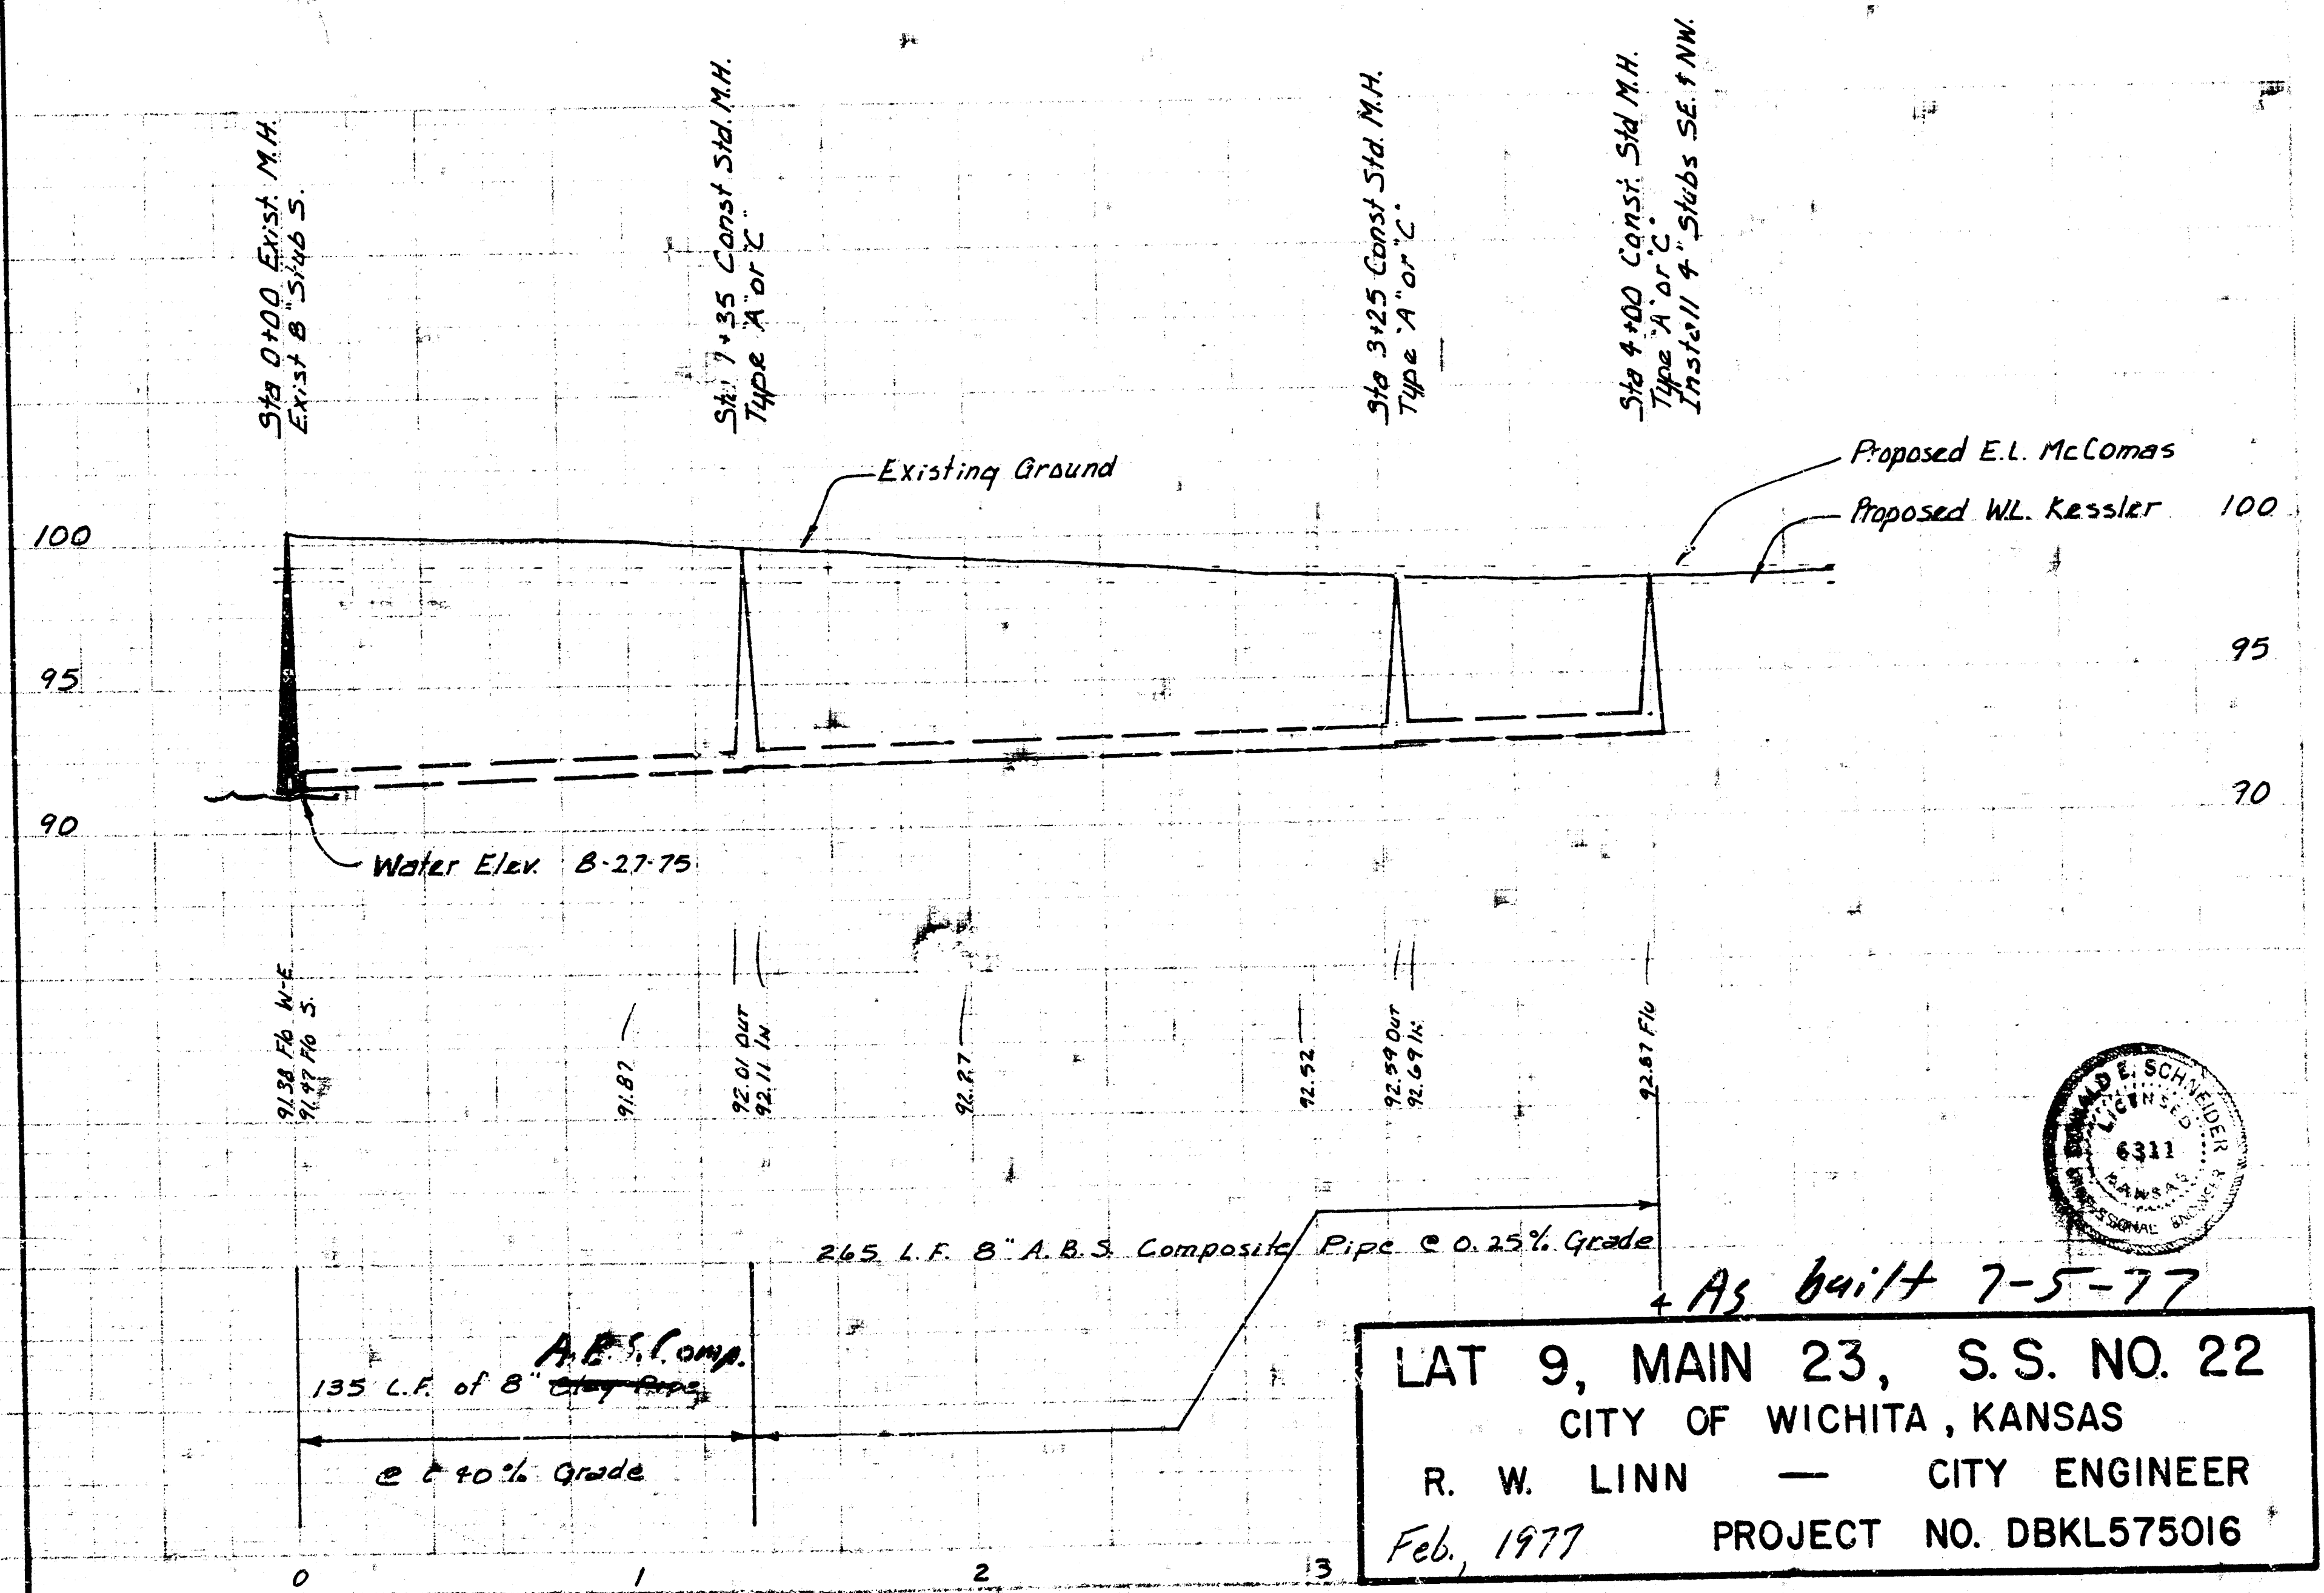

14 10 3 18 1/2