


A.R. 69
R. Loomis

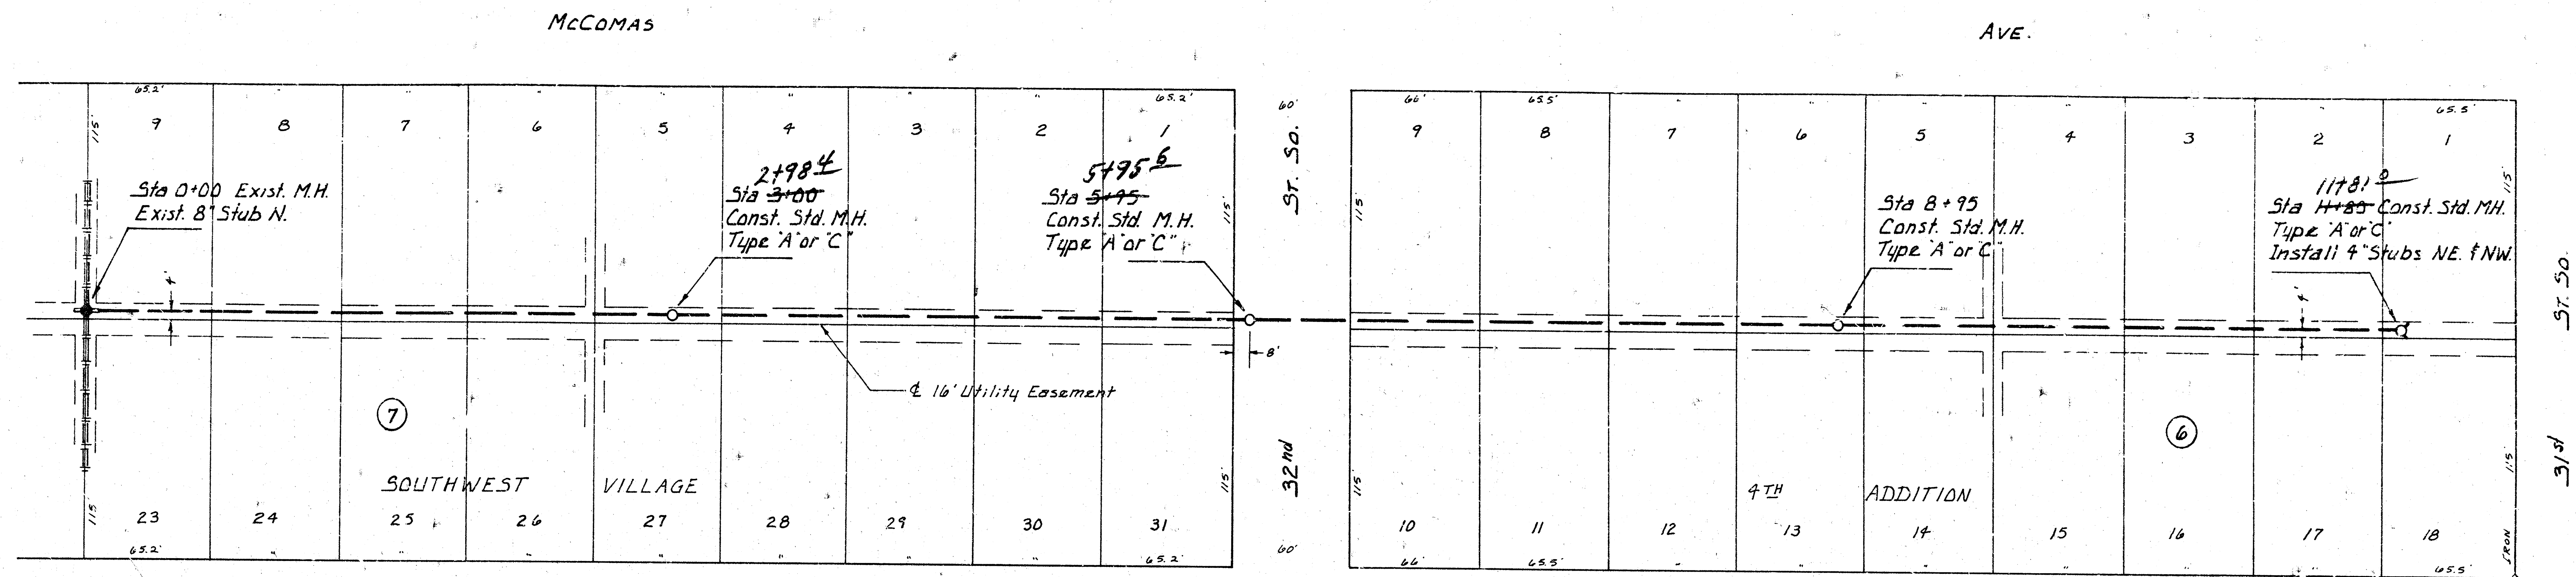

Kessler

AVE.

B.M. 103.47 City Std. Disc 53'E & 44'S
of C. of West St & 31st St. So.

B.M. 100.79 a cut on back of curb on West end
radius on W.S. Kessler & S.S. 31st St. So.

Scale Plan 1"=40'
Profile 1"=40' horz
1"=5' Vert.

