


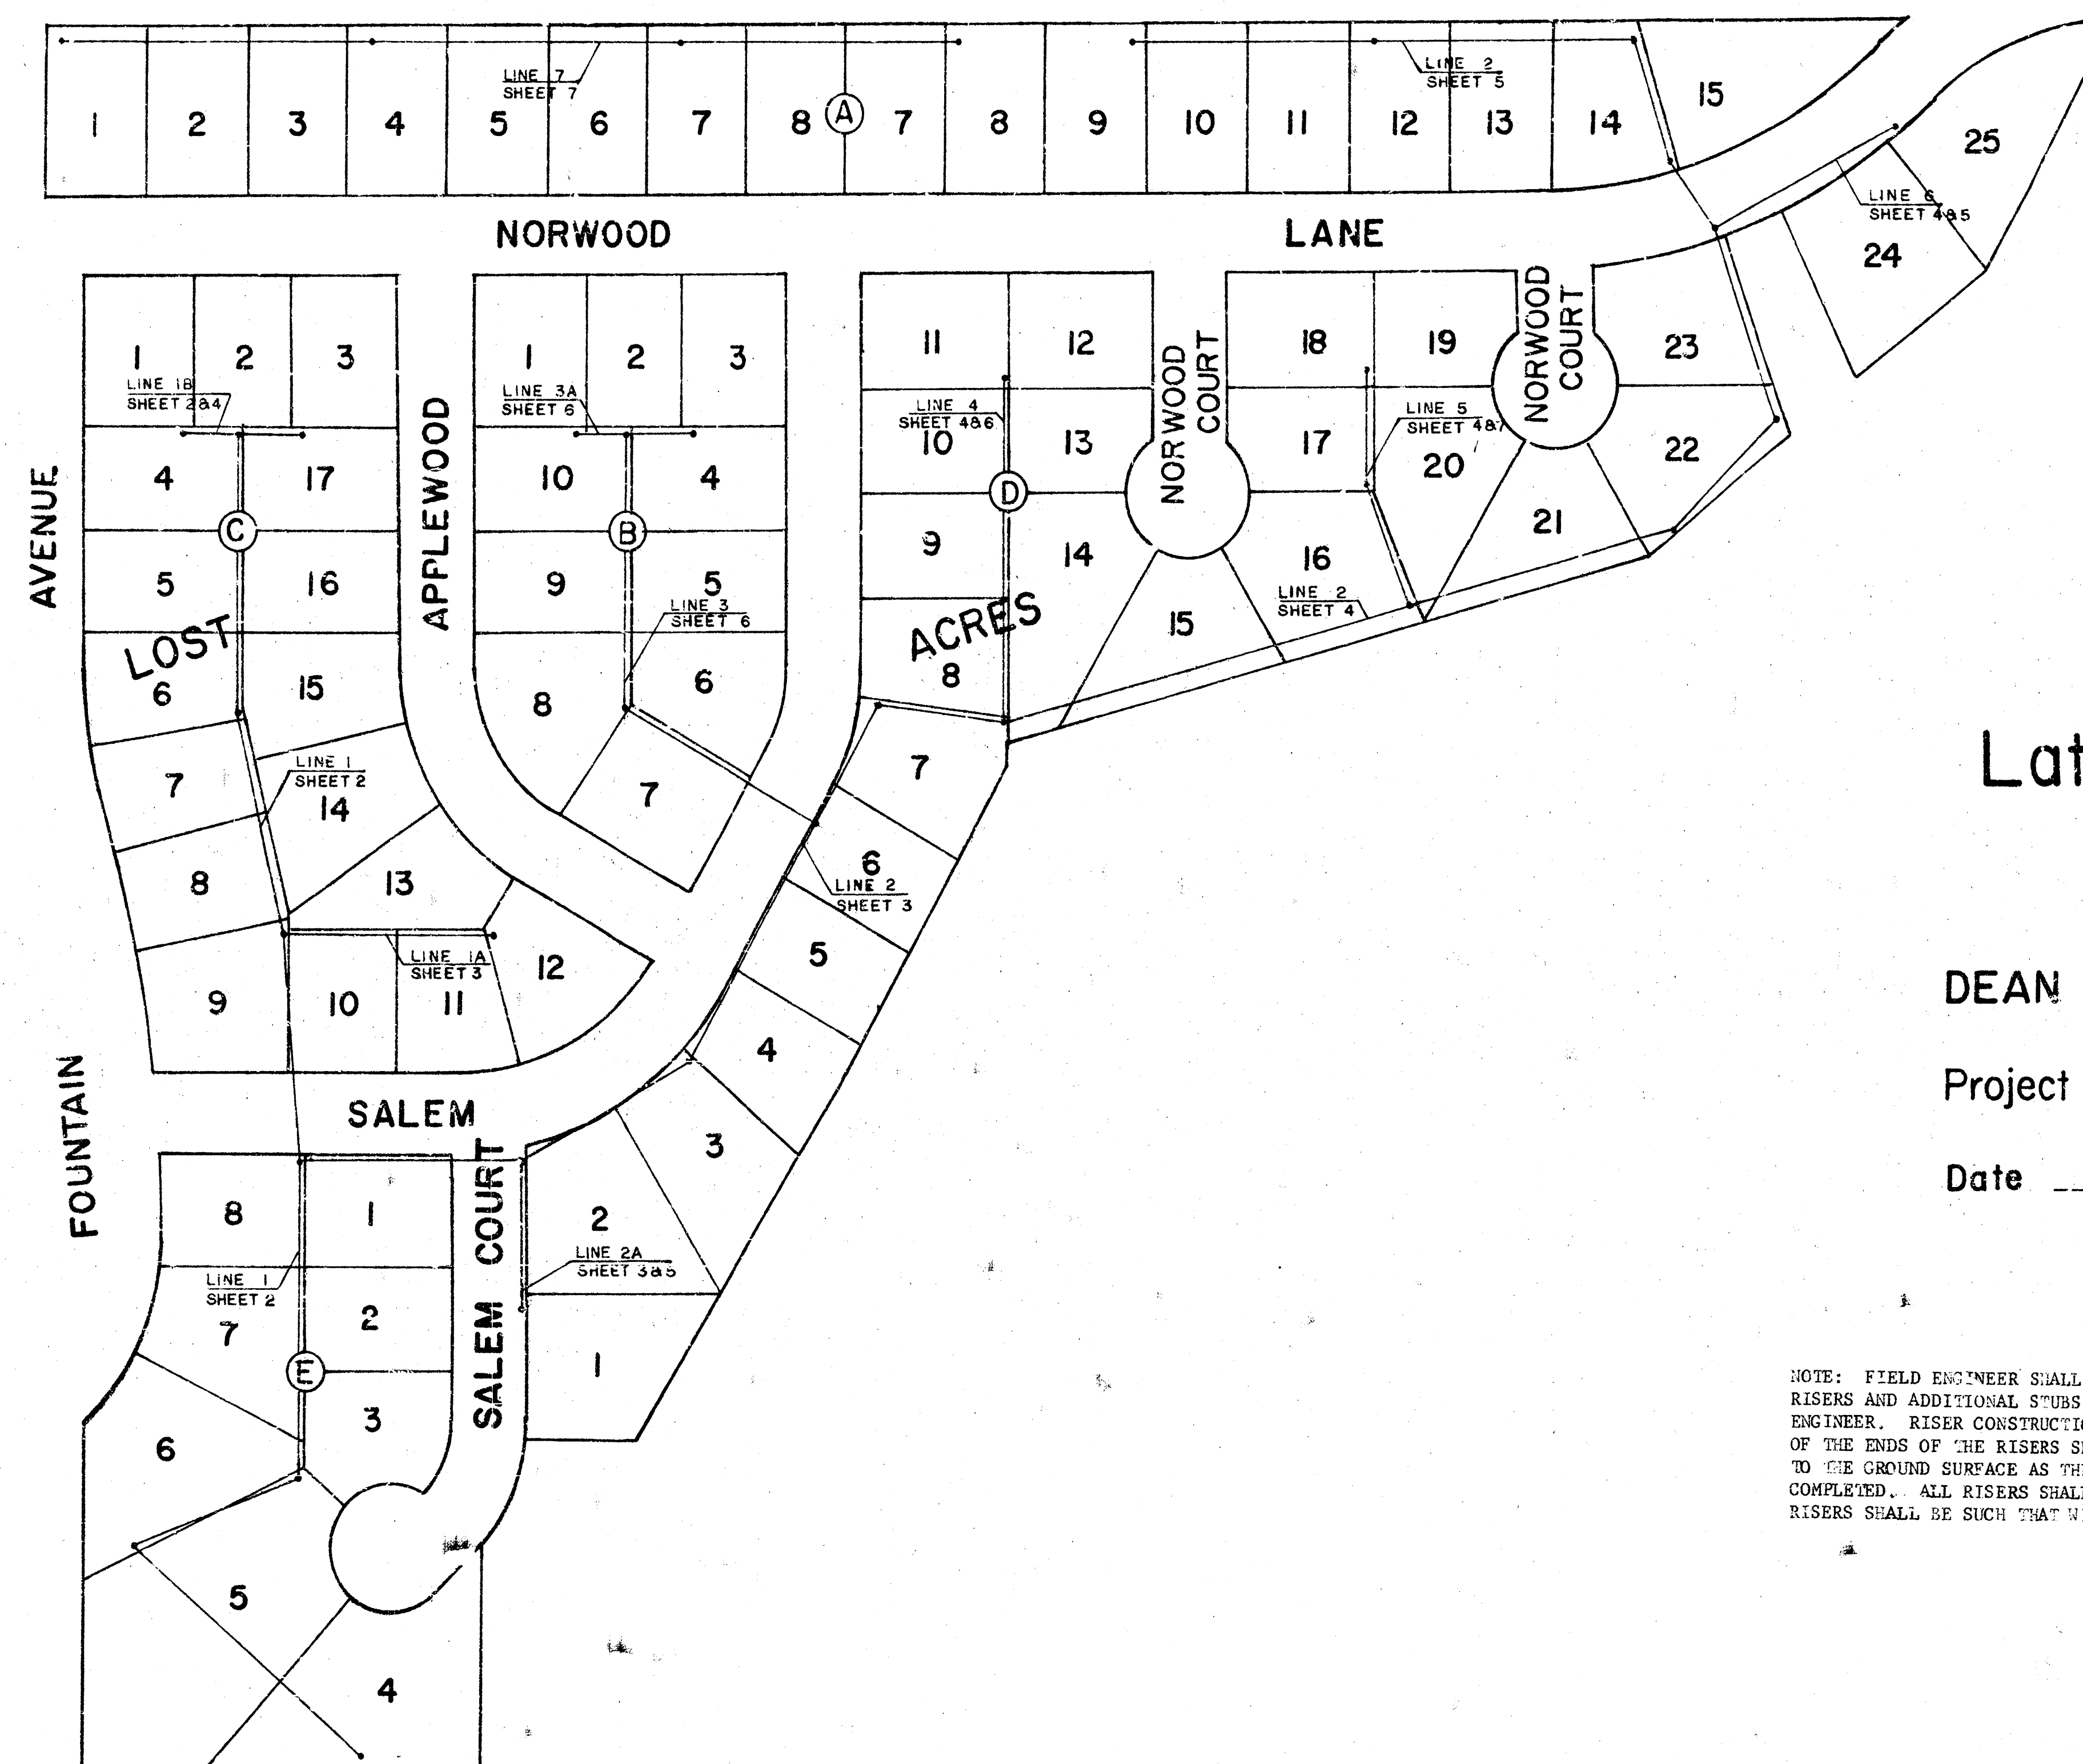

Lateral 38, Sanitary Sewer No. 23

City of Wichita, Kansas

DEAN SELLERS

City Engineer

Project No. : 468-76-245-80597-000-000-001



Date _____


NOTE: FIELD ENGINEER SHALL SET TOPS OF MANHOLES TO MATCH PROPOSED FINISHED GRADE AS DETERMINED BY THE DEVELOPER. RISERS AND ADDITIONAL STUBS SHALL BE INSTALLED ON THIS PROJECT TO SERVE INDIVIDUAL LOTS WHEN ORDERED BY THE FIELD ENGINEER. RISER CONSTRUCTION SHALL CONFORM TO THE REQUIREMENTS AS SHOWN ON STANDARD RISER DETAIL SHEET. LOCATIONS OF THE ENDS OF THE RISERS SHALL BE MARKED BY FASTENING GREEN PLASTIC COLORED TAPE TO THE END OF THE RISER AND BROUGHT TO THE GROUND SURFACE AS THE EXCAVATION IS BACKFILLED SUCH THAT THE COLORED TAPE WILL BE VISIBLE WHEN THE PROJECT IS COMPLETED. ALL RISERS SHALL BE CONSTRUCTED USING S.D.R. 23.5 A.B.S. OR P.V.C. PIPE. ELEVATIONS OF STUBS AND TOPS OF RISERS SHALL BE SUCH THAT WILL FACILITATE CONNECTION OF BASEMENT DRAINS WHEN THESE LOTS ARE DEVELOPED.

279
11.10
D.C. PULLEY
J.D. MURPHY
D.D. 108




BM 159264 City St. 29th and OLIVER
BM 16010 Brass Sd. N.E. Cor. Highway 2nd Bridge N of 29th St
BM 159815 S. Rim of M.H. in NORWOOD and FOUNTAIN


29th St

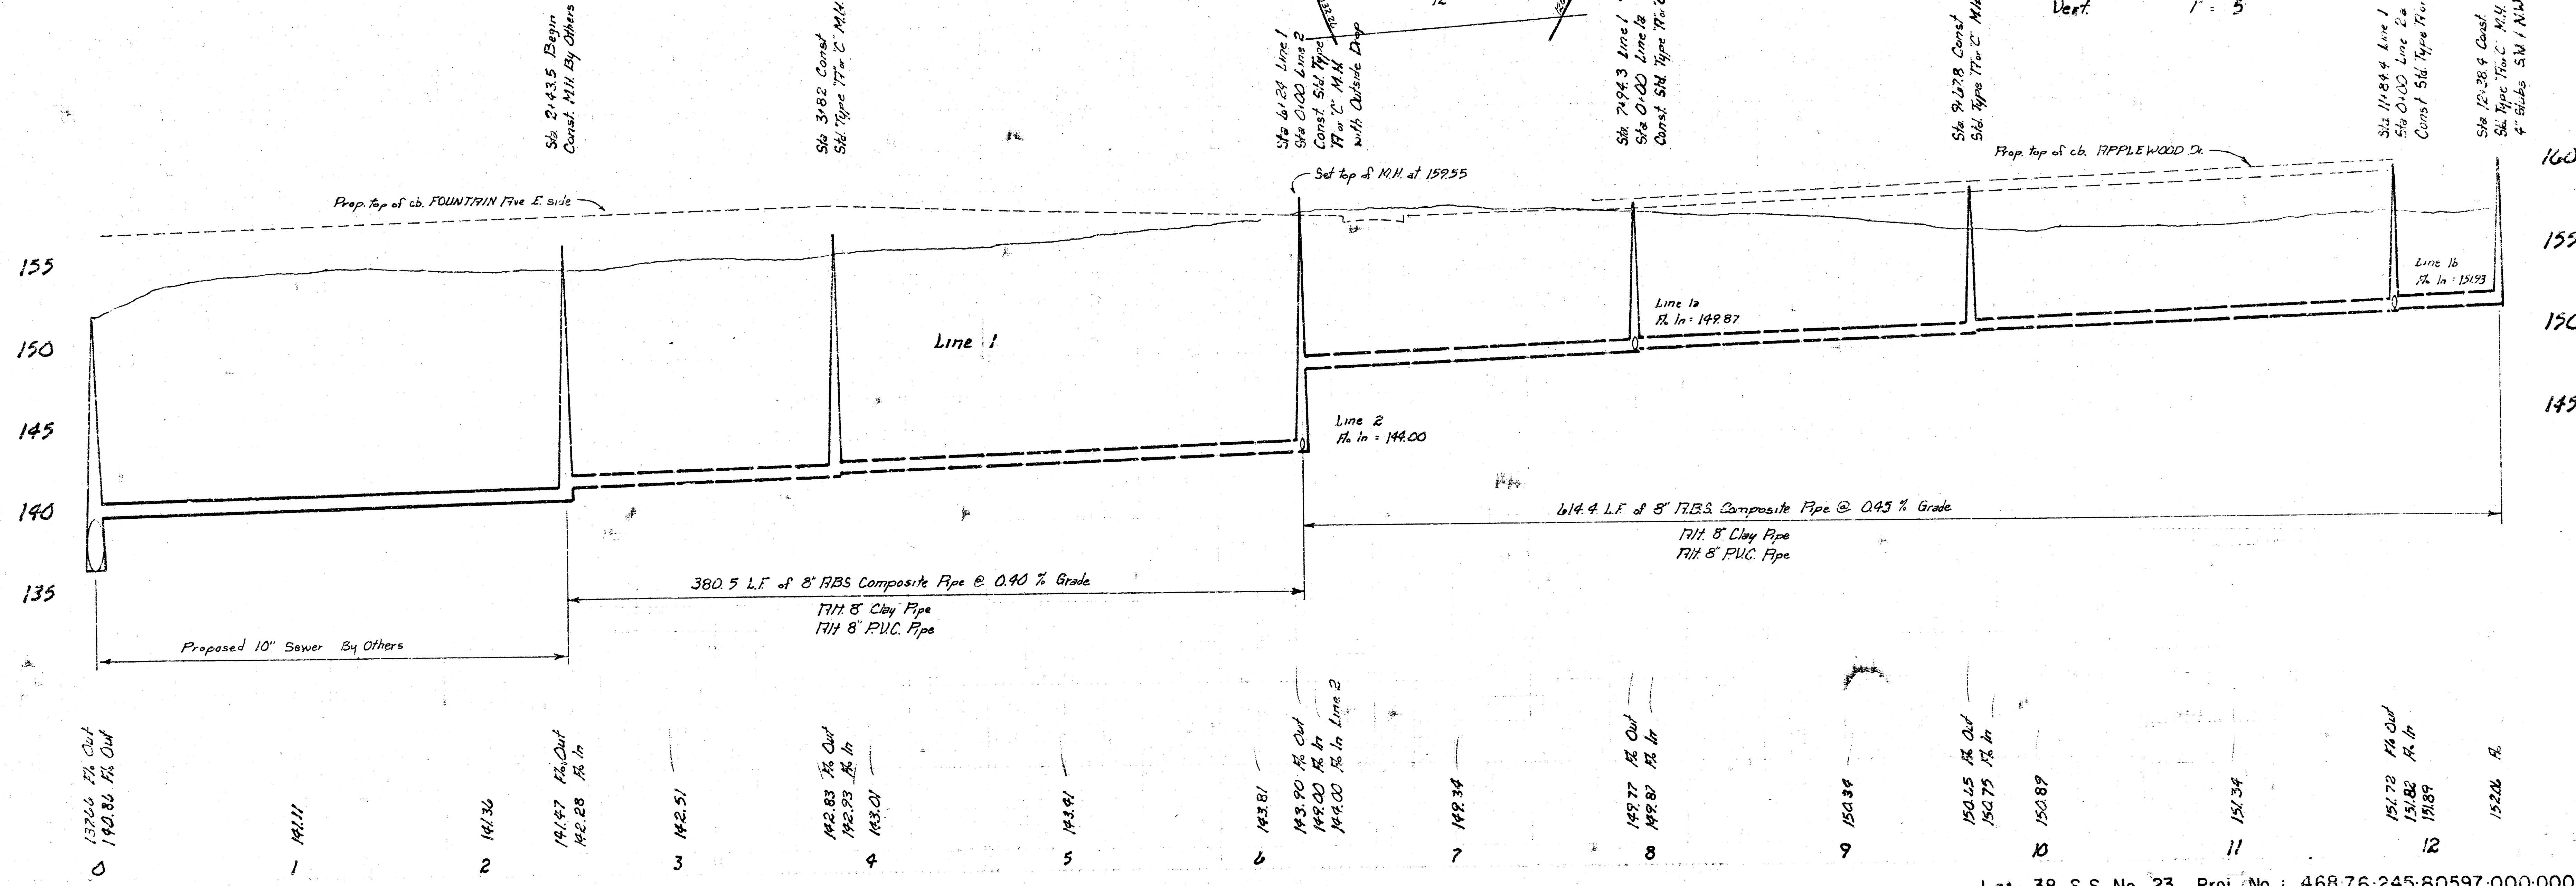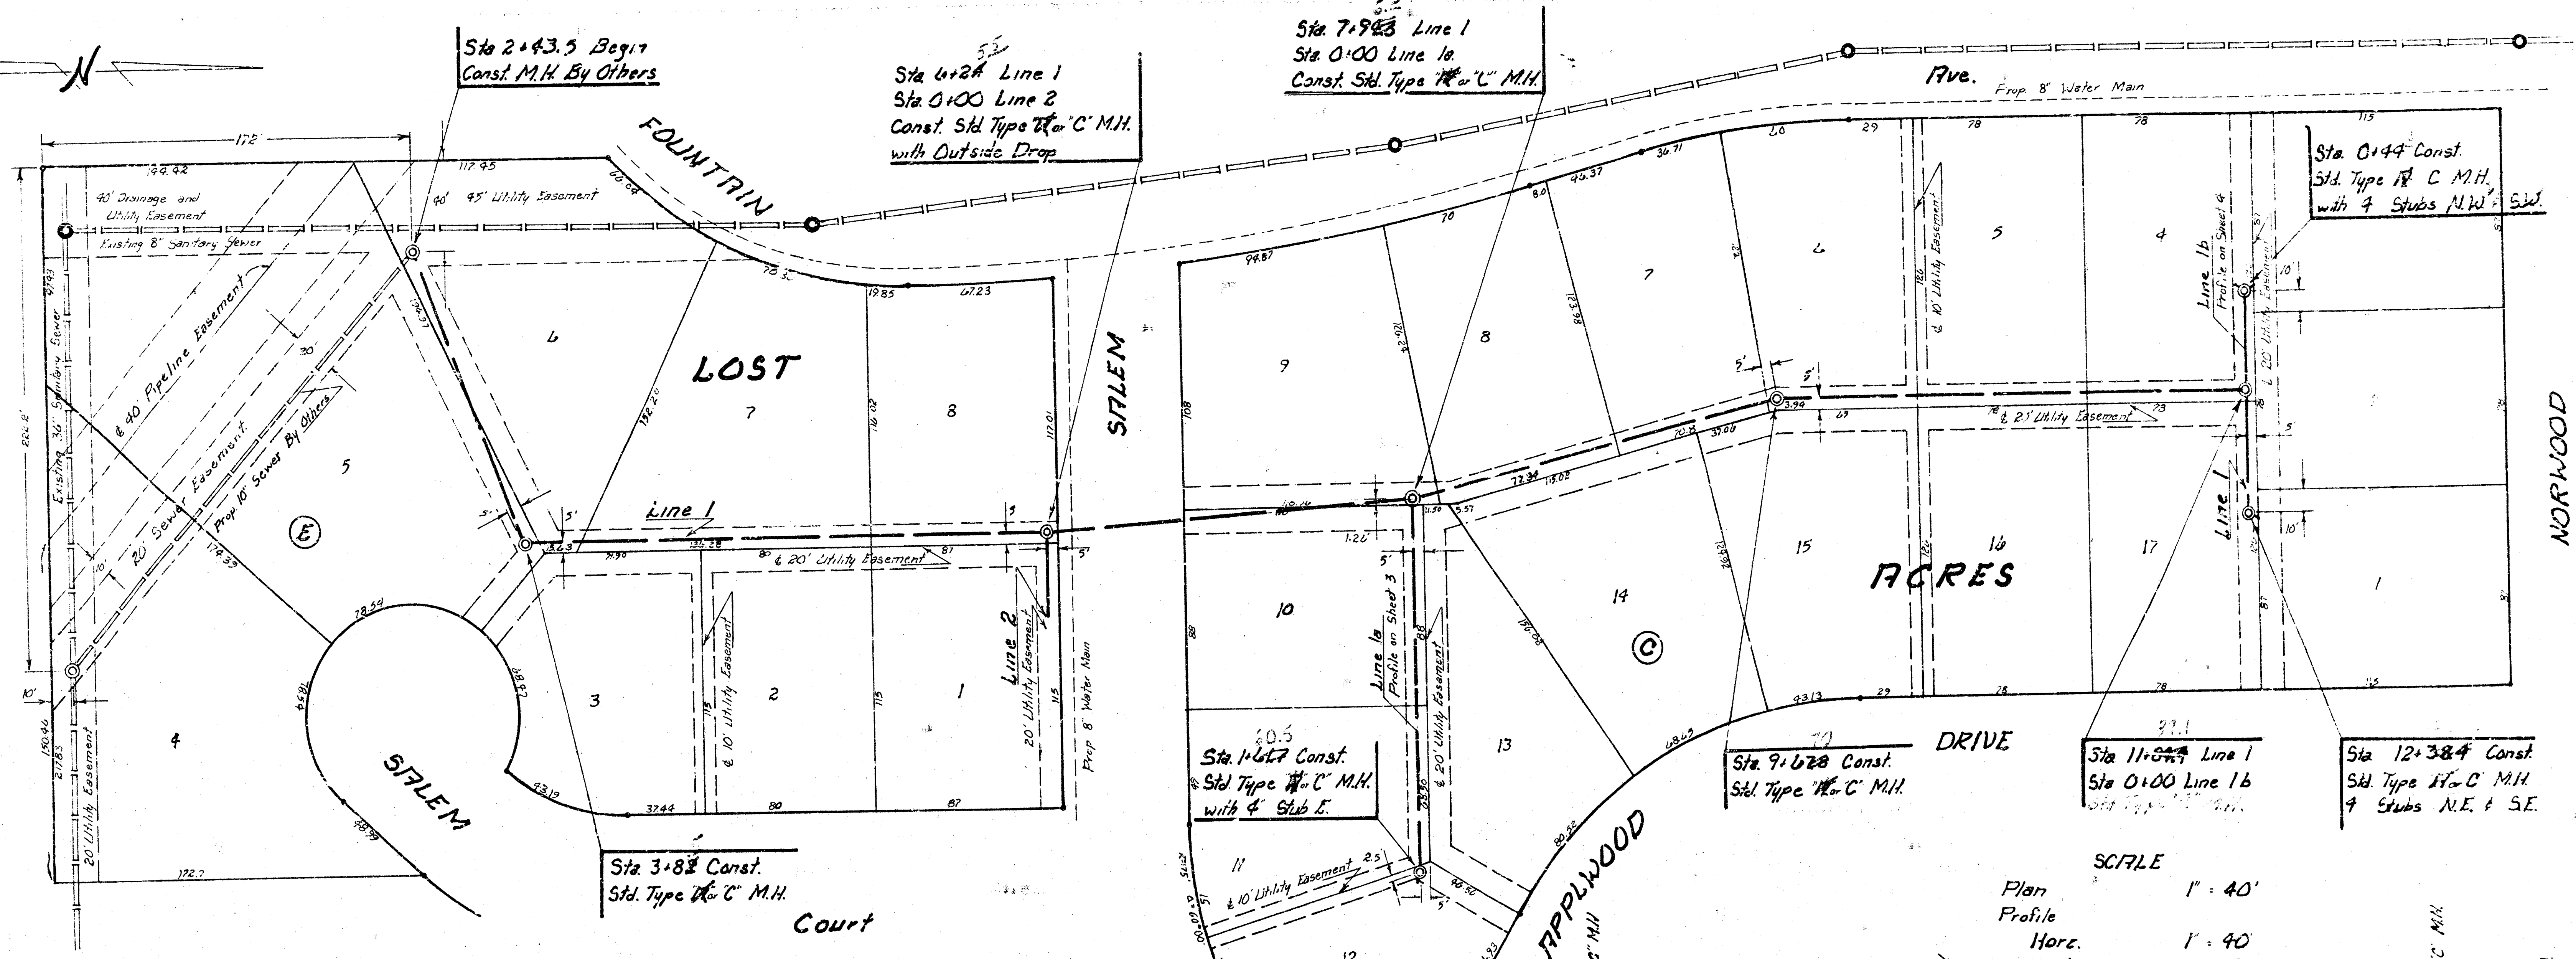


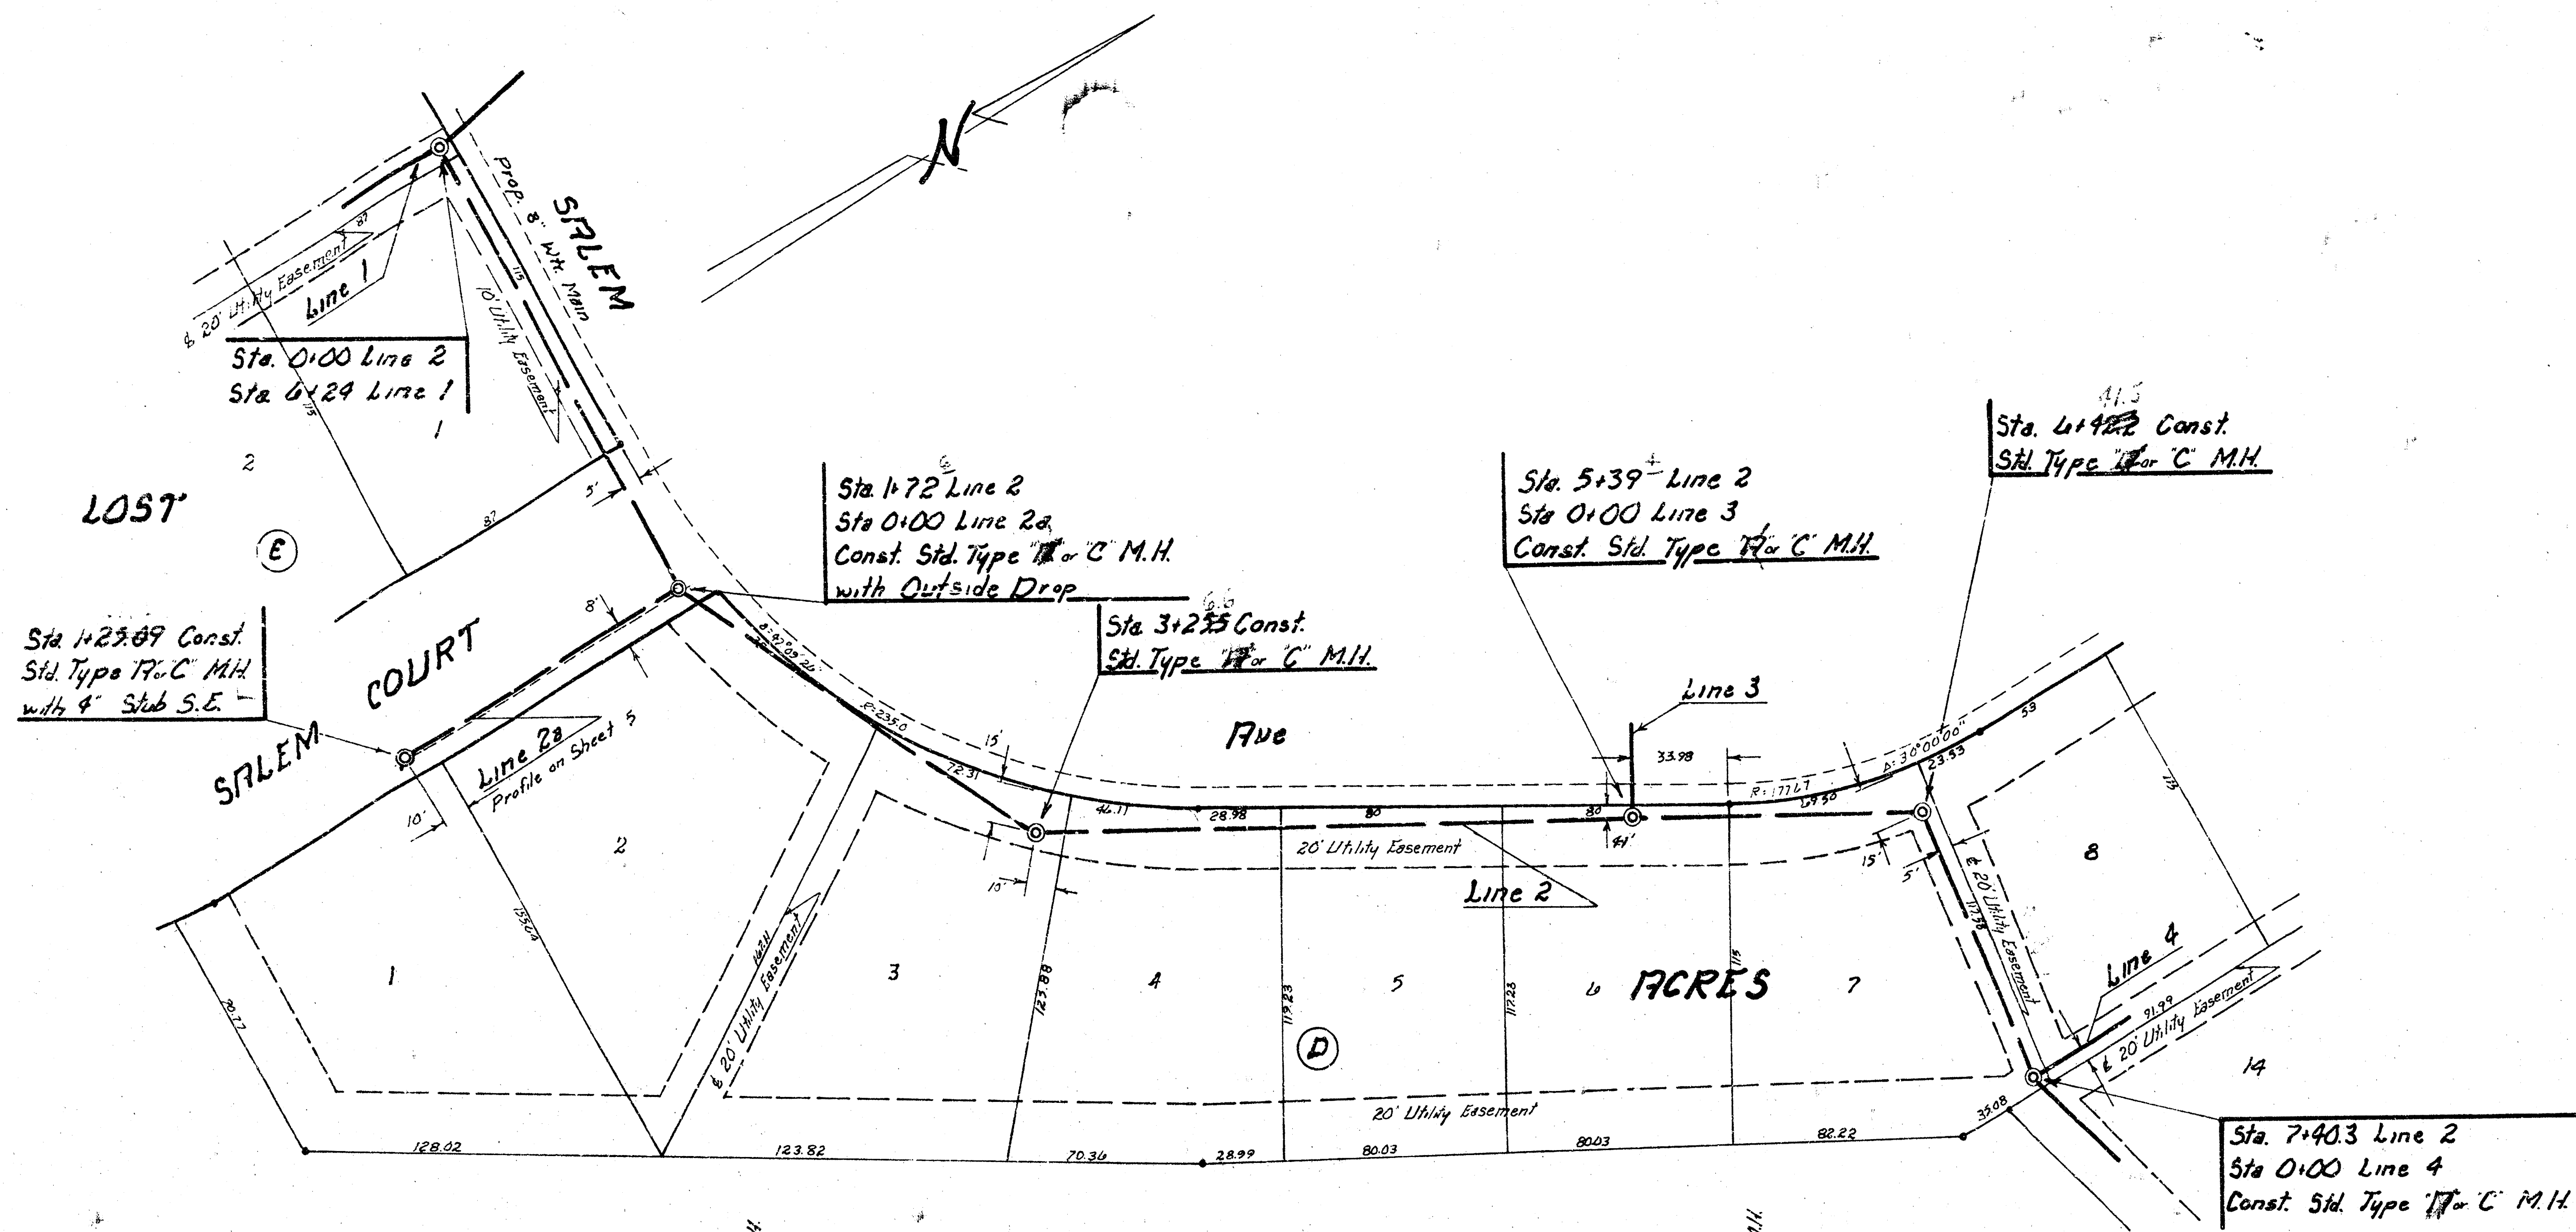

SCALE
 Plan 1" = 40'
 Profile 1" = 40'
 Horiz. 1" = 40'
 Vert. 1" = 5'

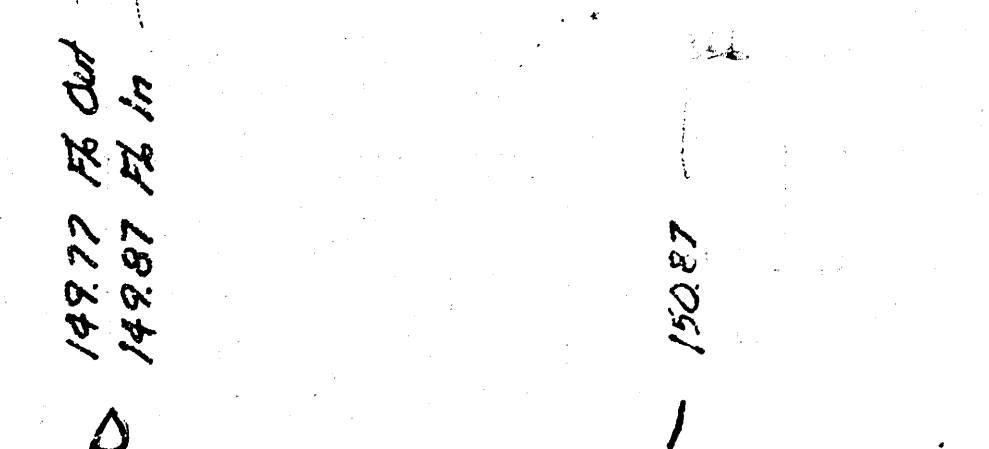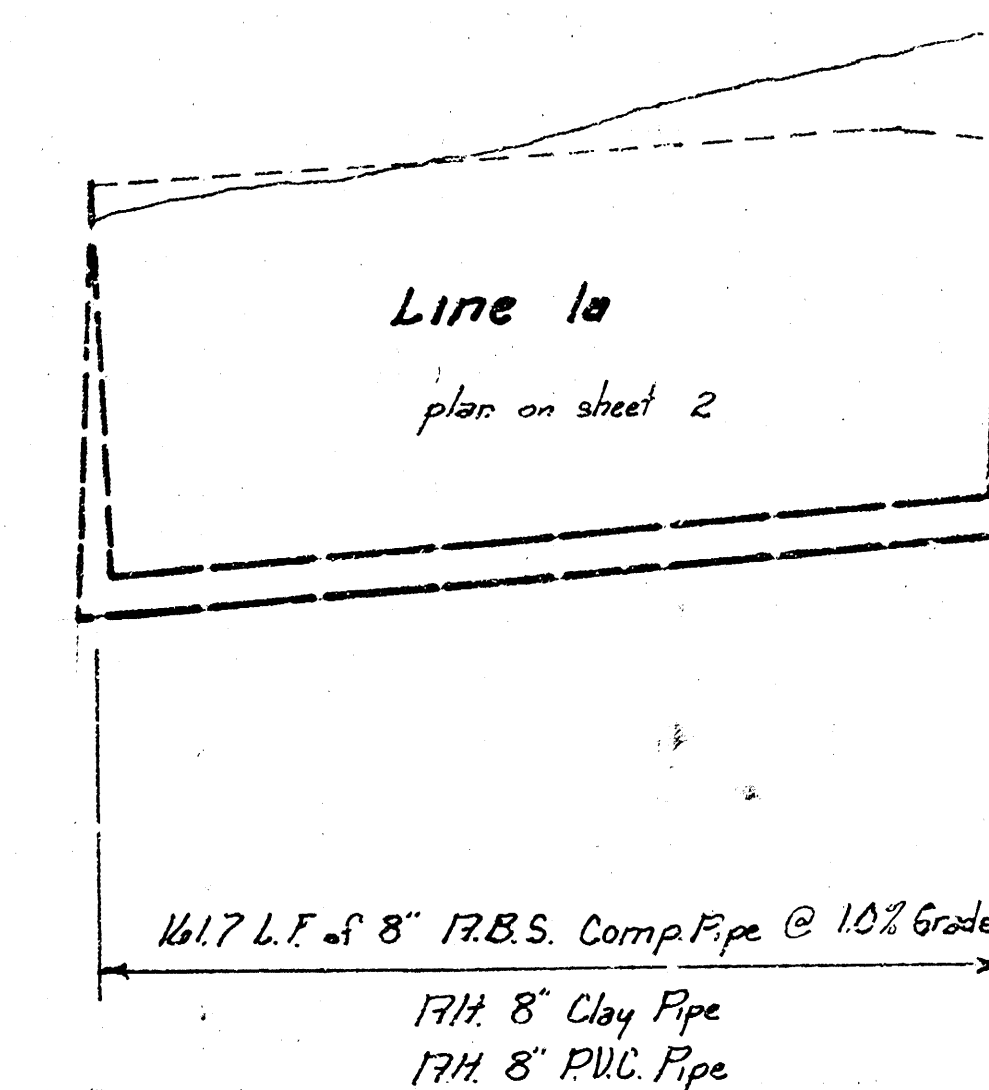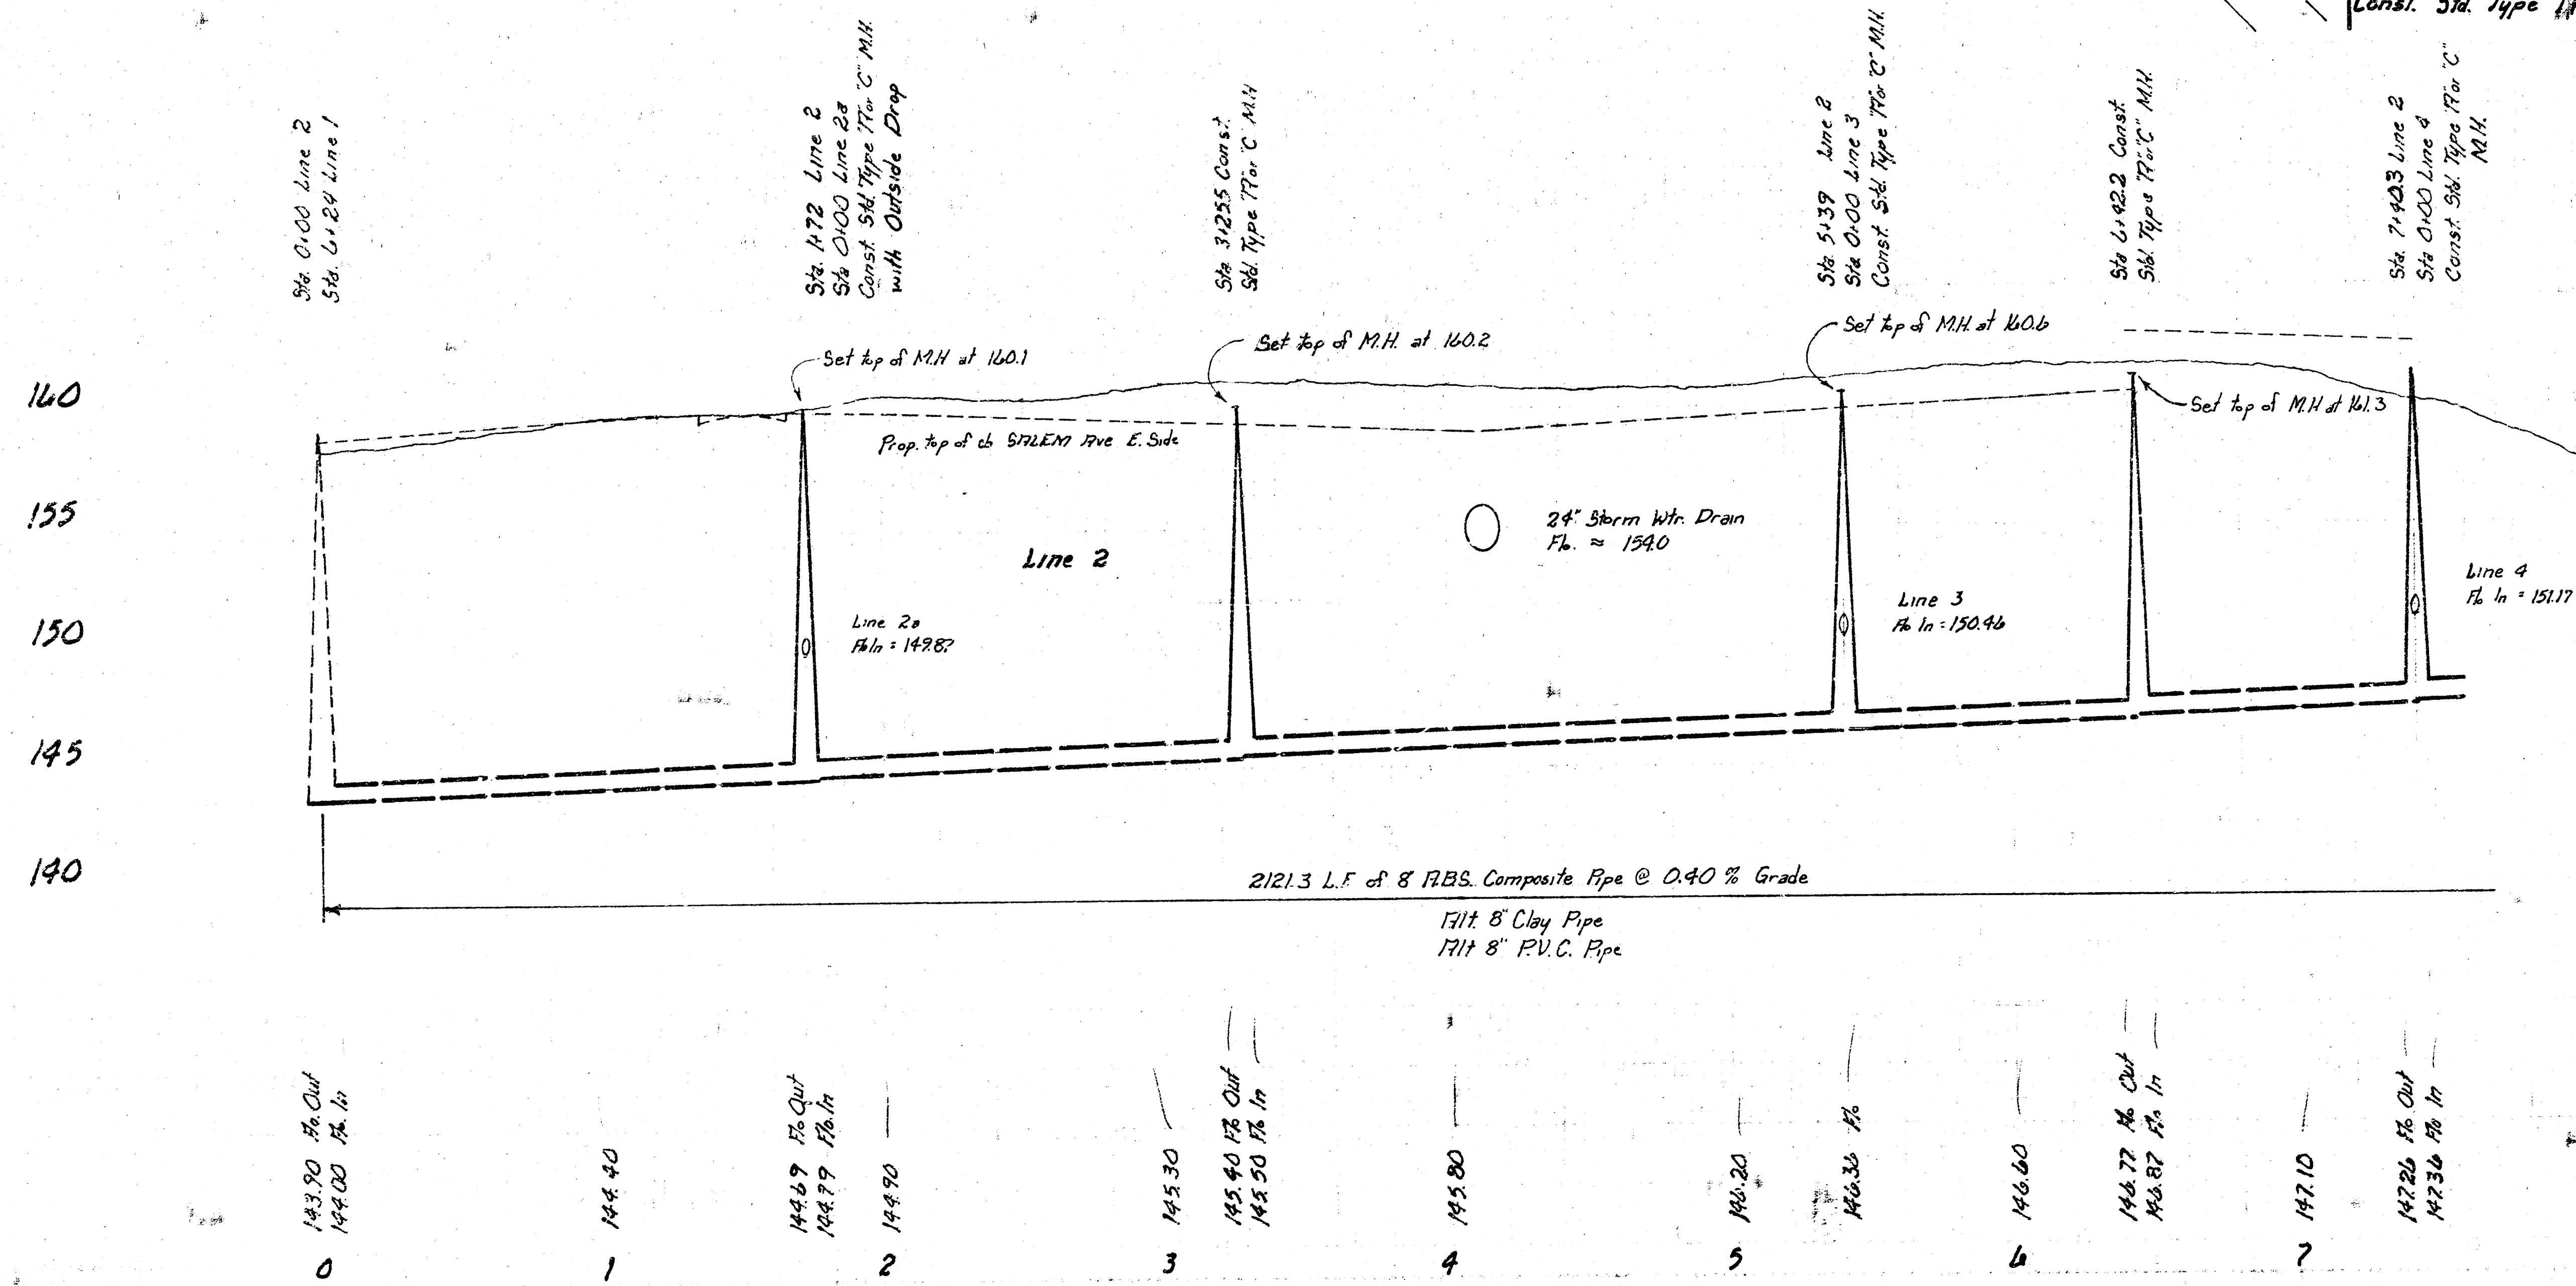

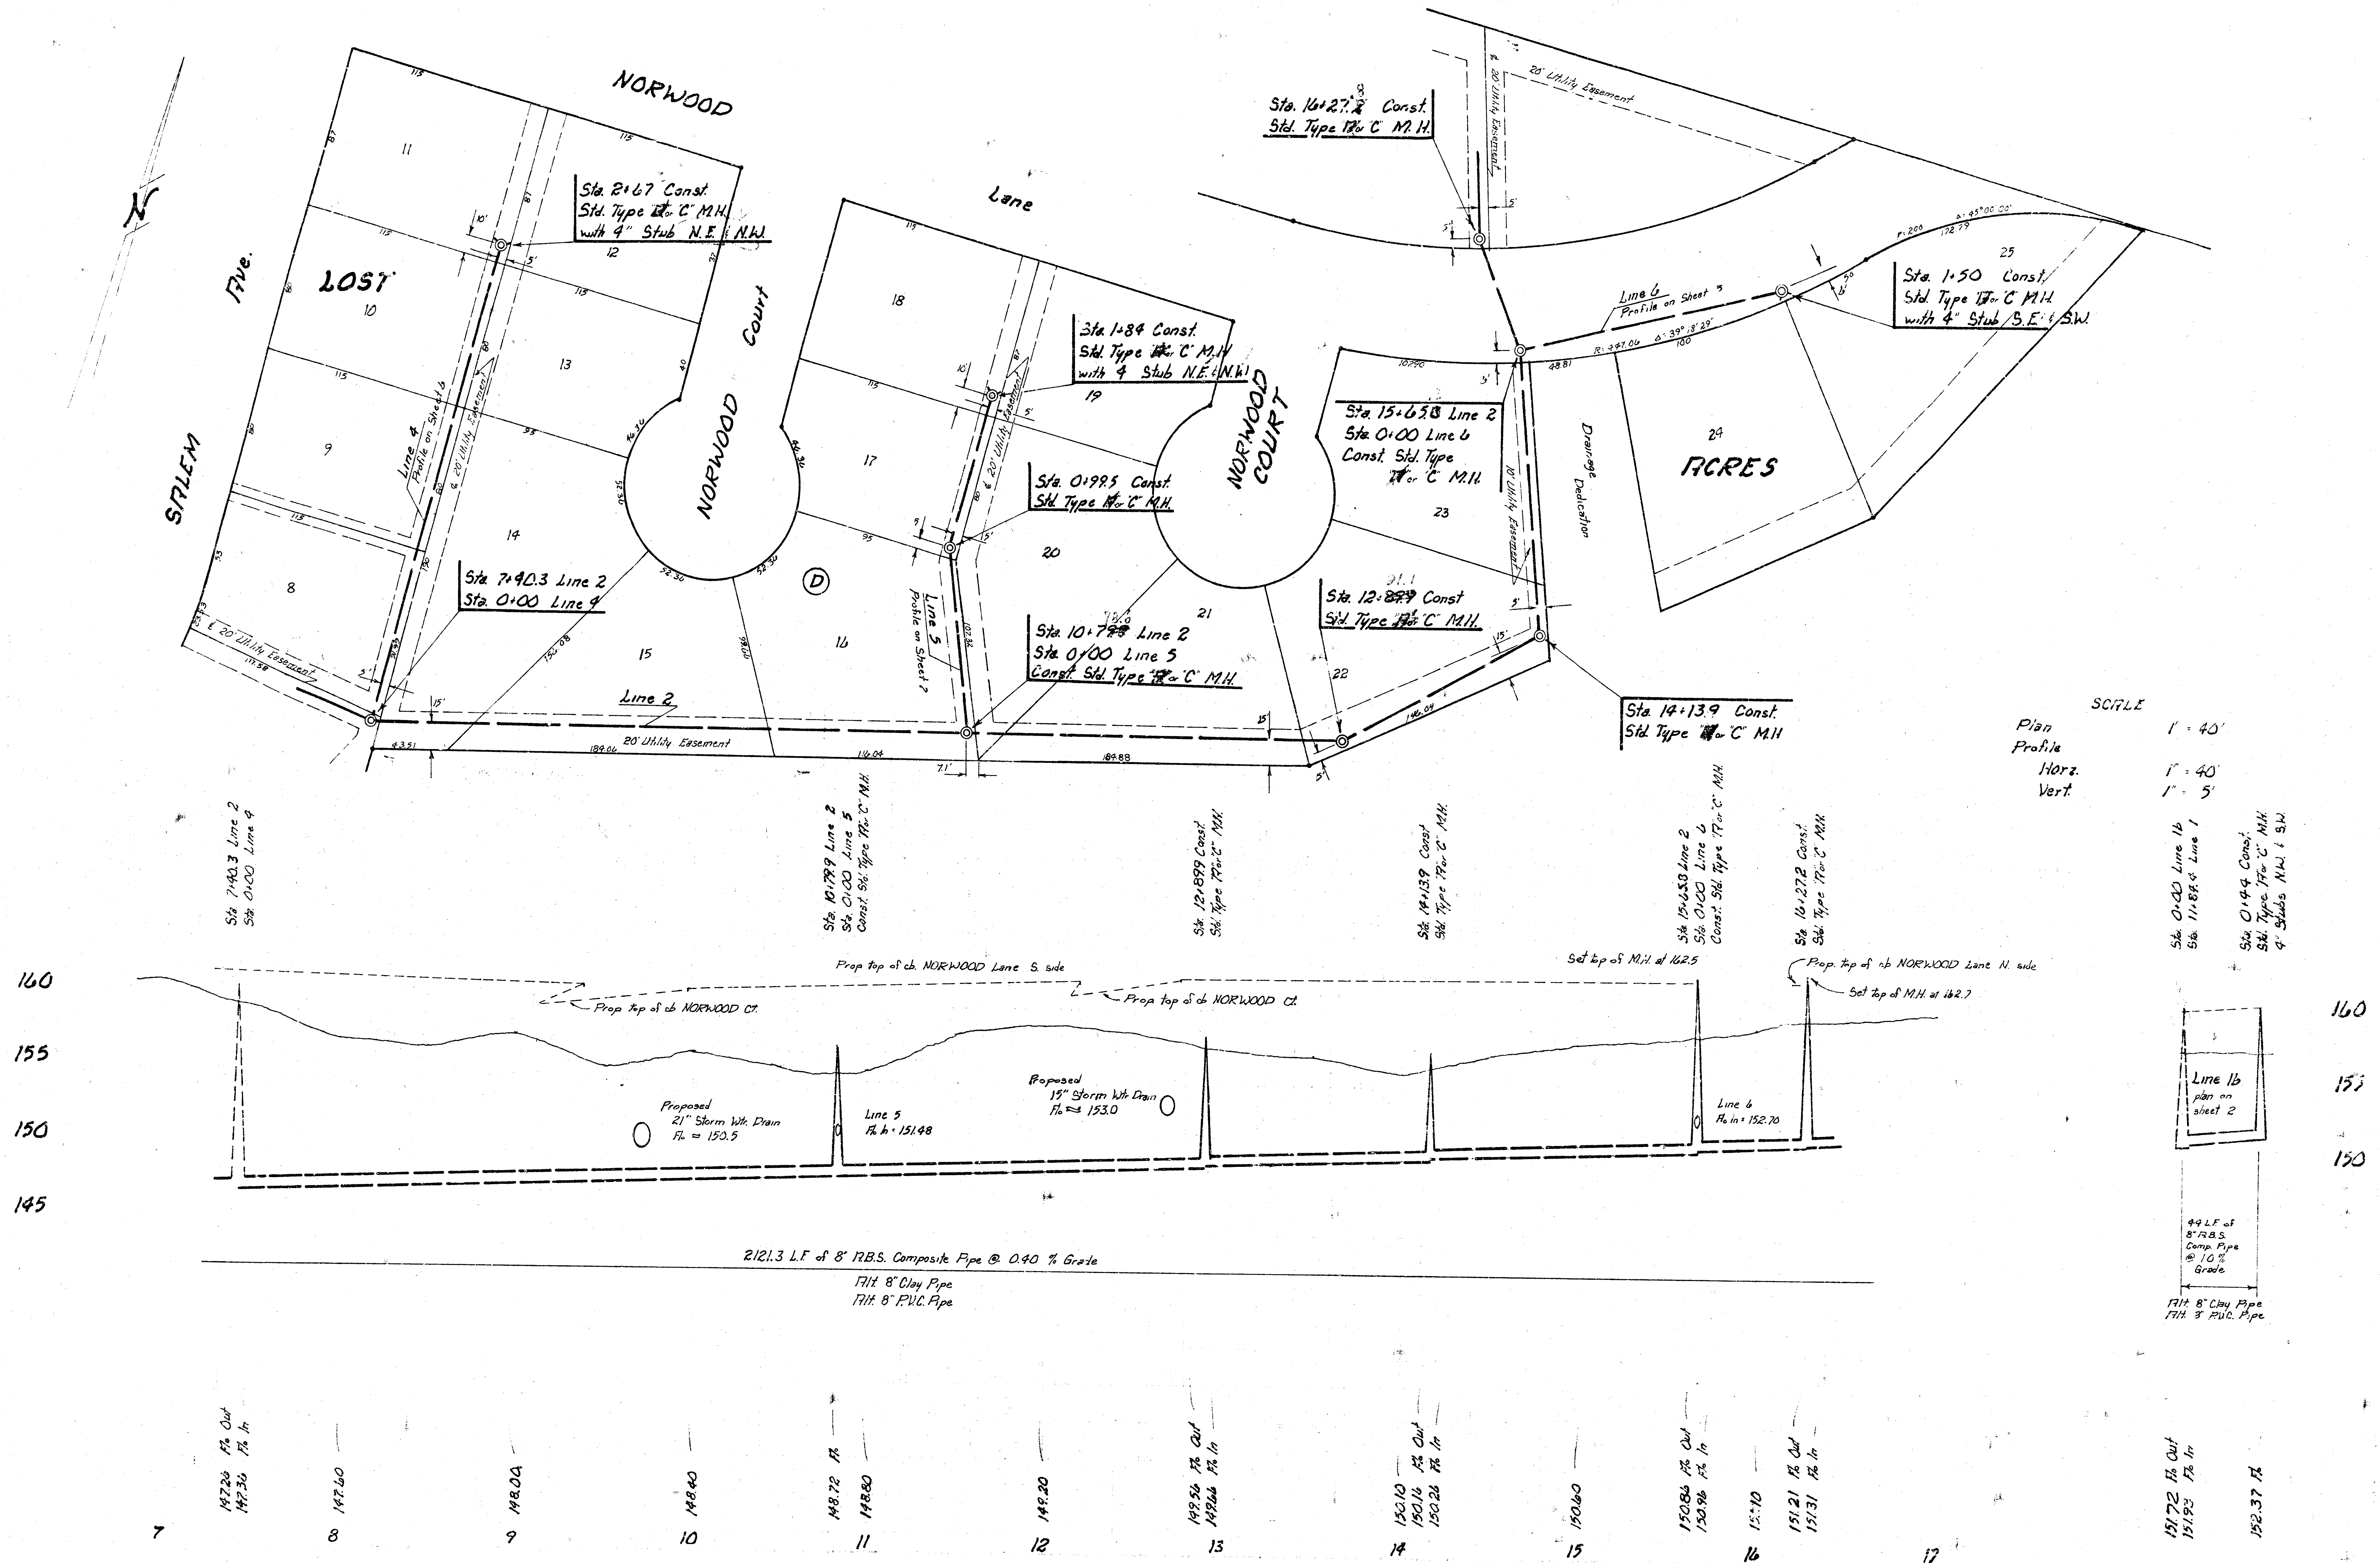

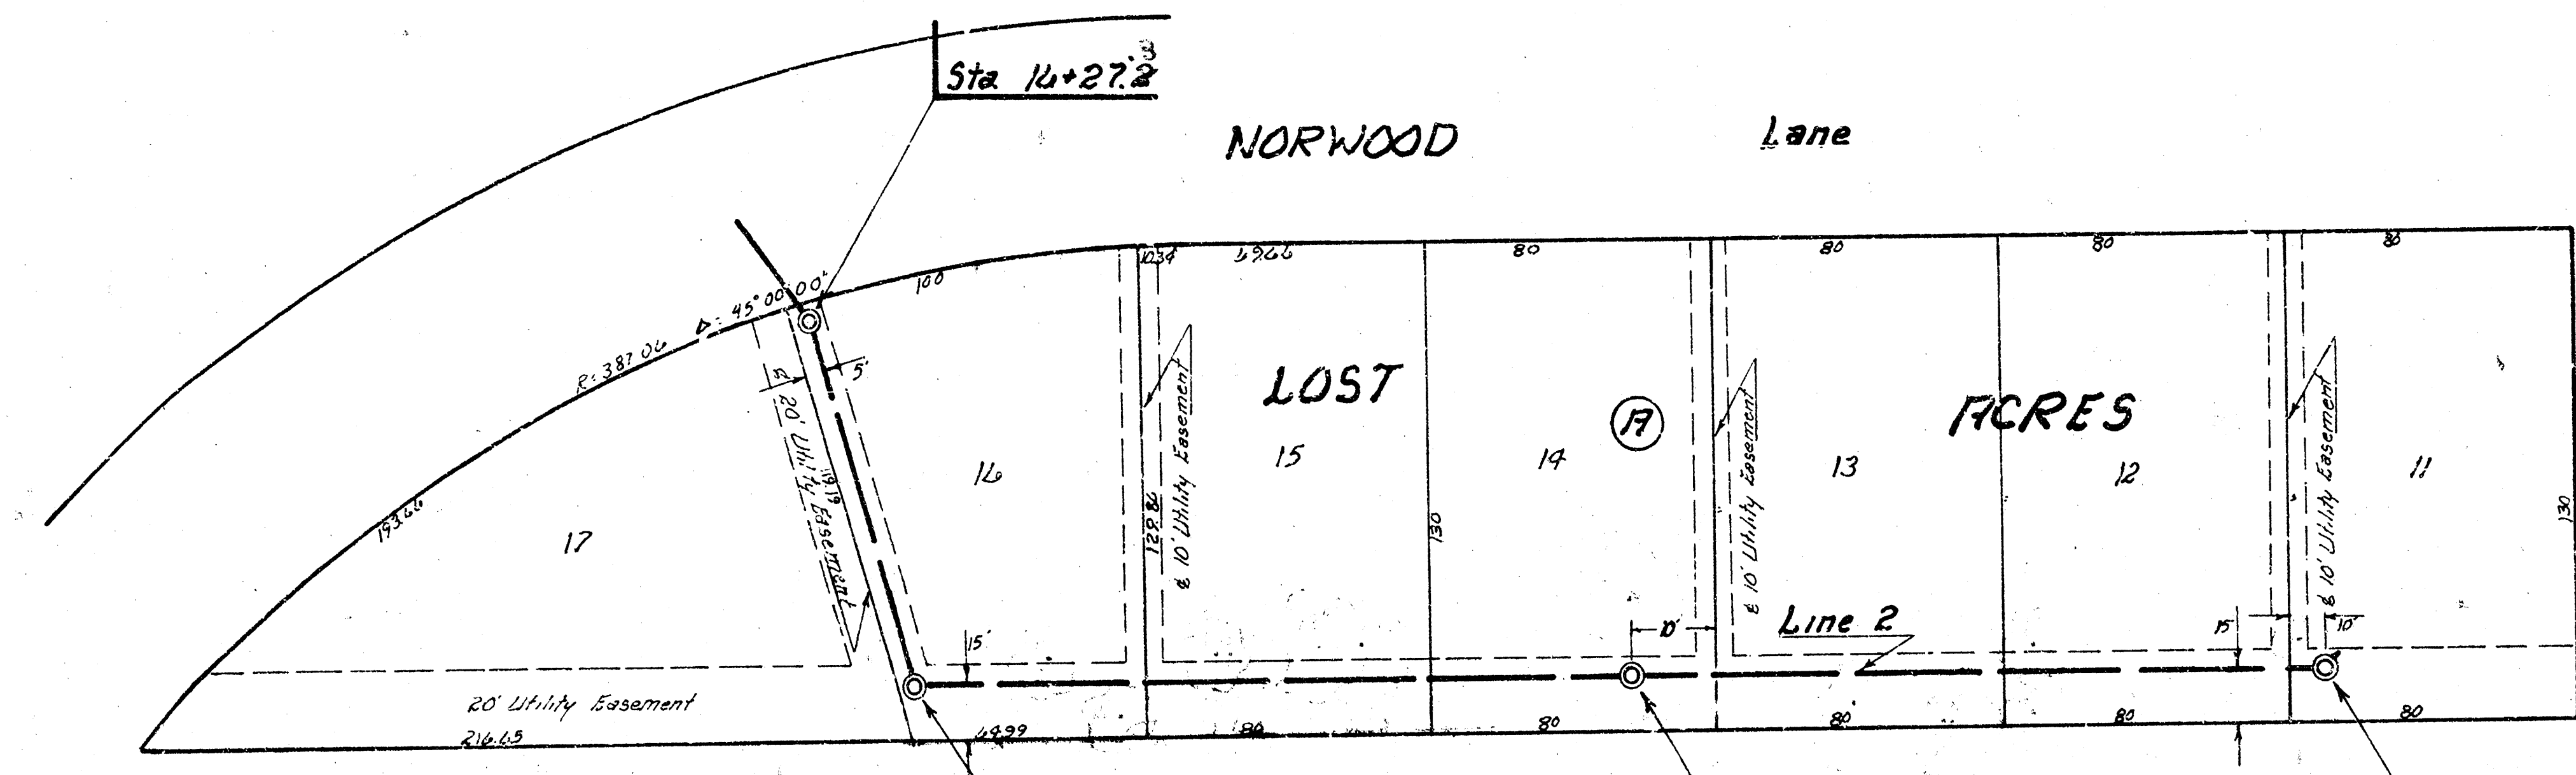


Sta. 16+27.2 Const.
Std. Type 17" C M.H.

Sta. 17+27.2 Const.
Std. Type 17" C M.H.

Sta. 19+27.2 Const.
Std. Type 17" C M.H.

Std. Type 17" C M.H.
4' Stubs S.W.

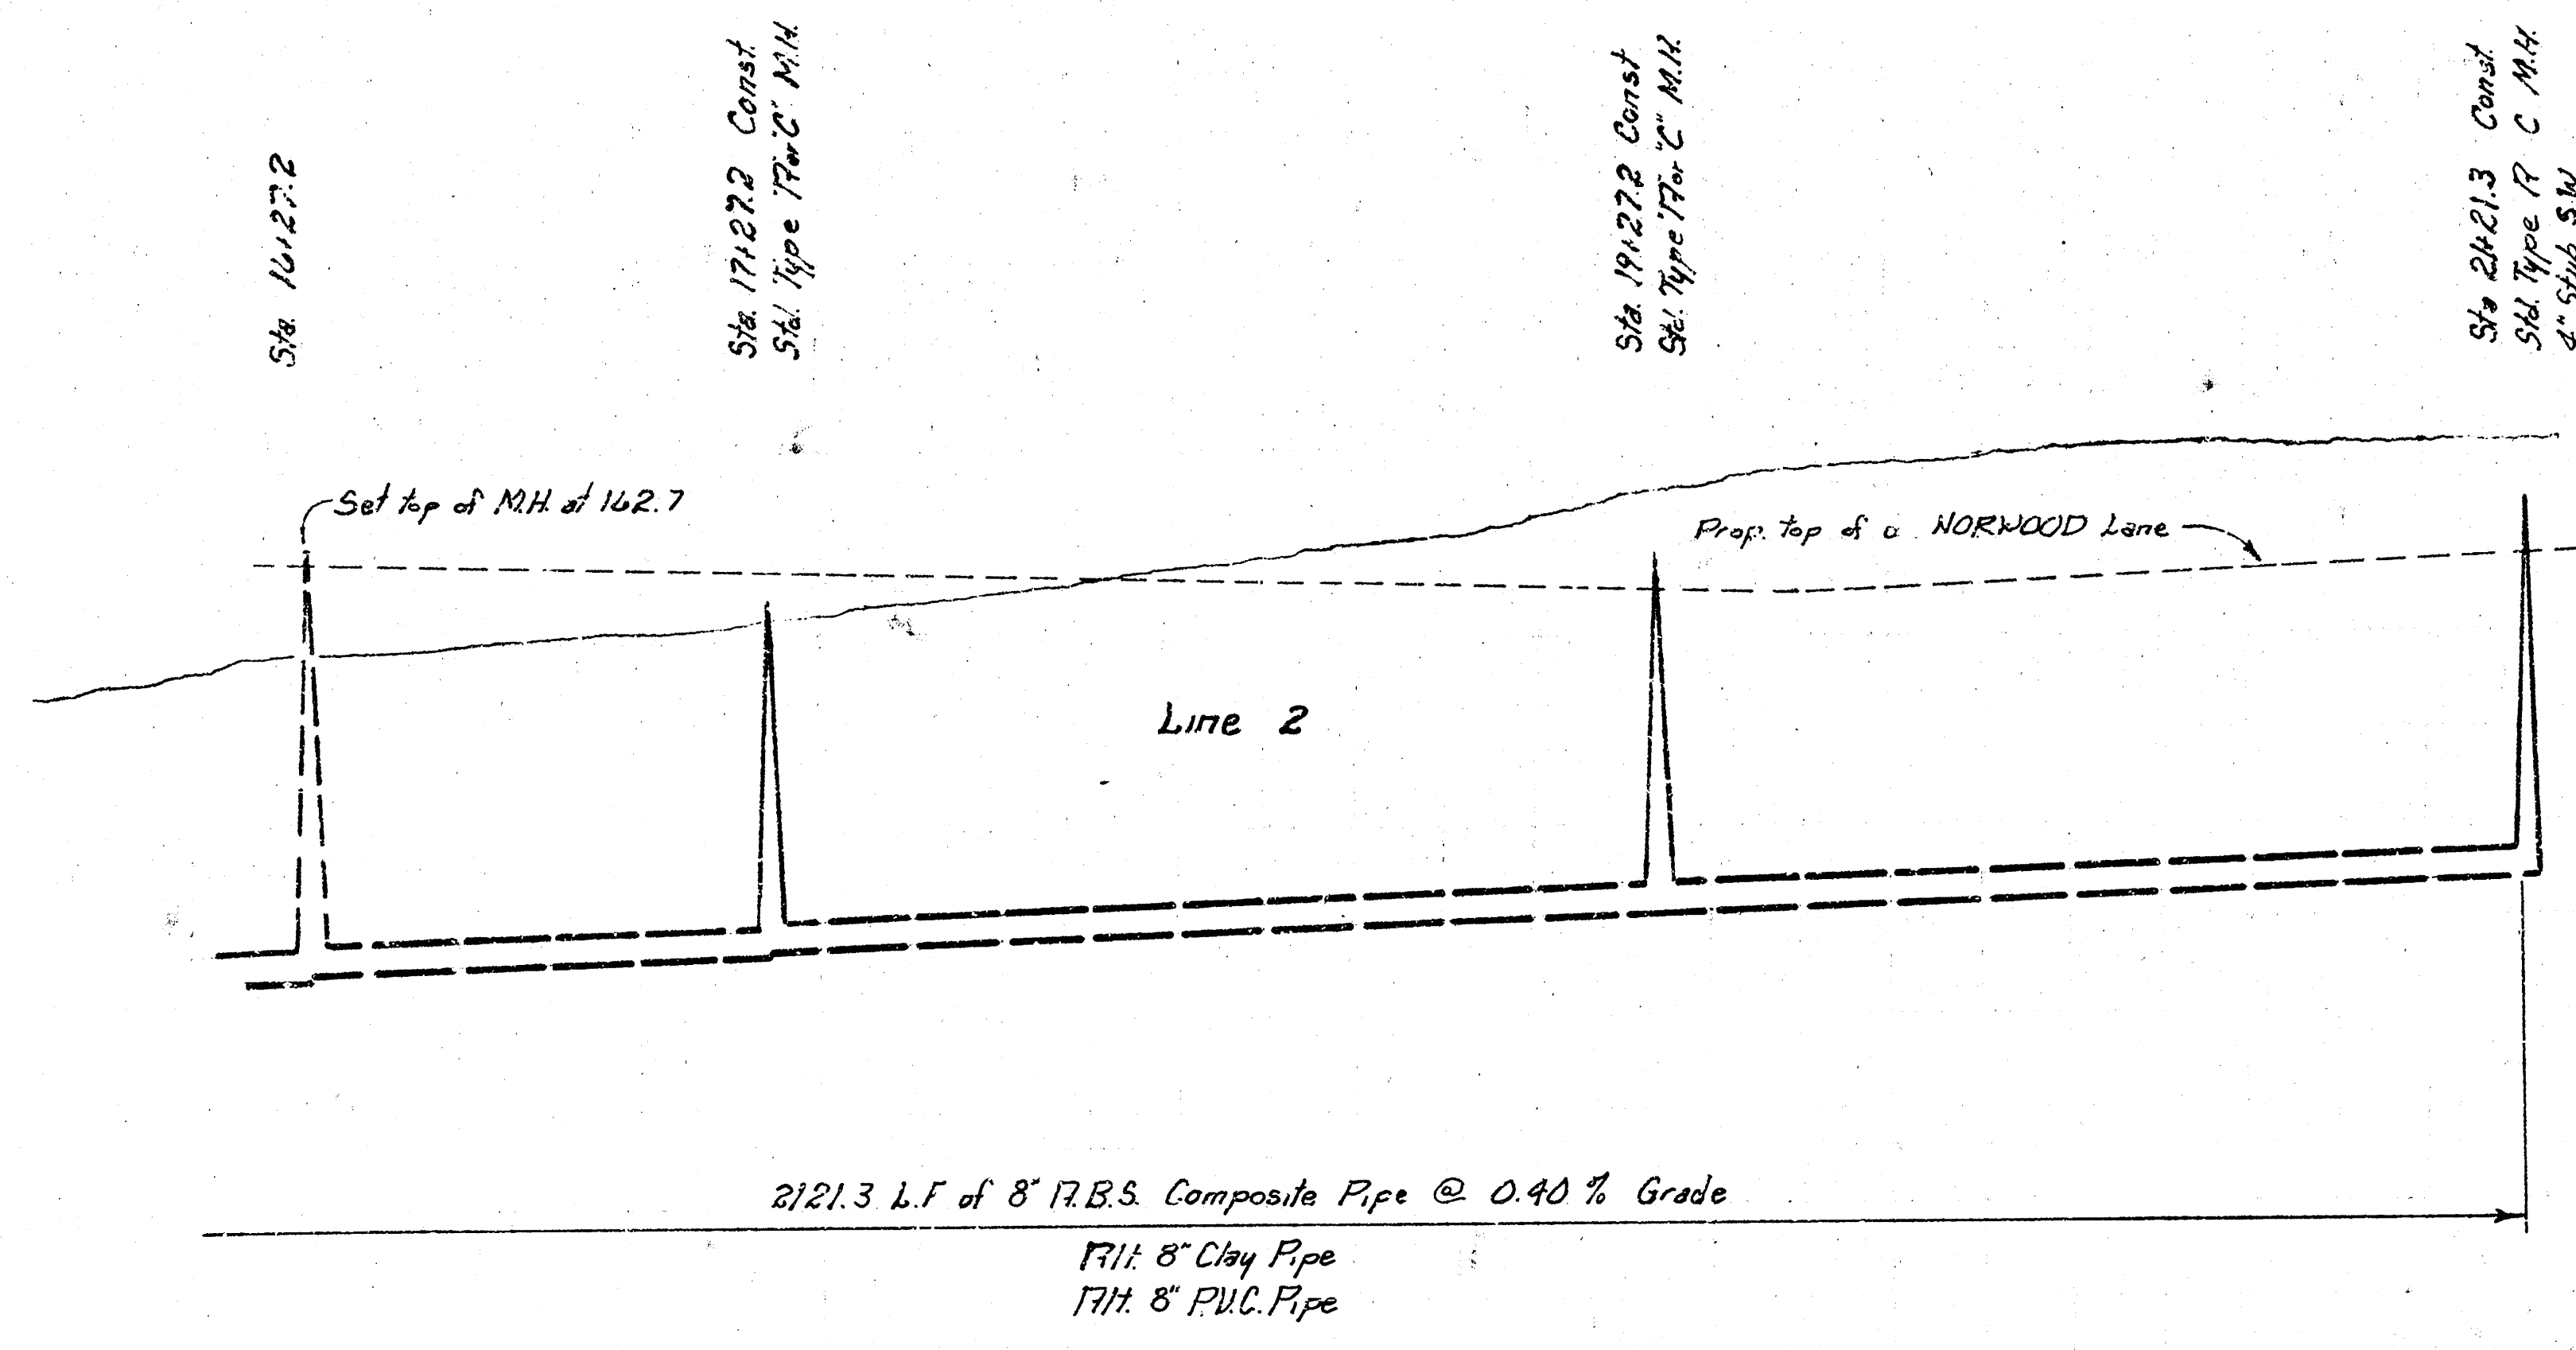

151.21 F.L. Out
151.31 F.L. In

151.60

151.71 F.L. Out
151.81 F.L. In

152.10


152.50

152.61 F.L.

152.90

153.30


153.39 F.L.

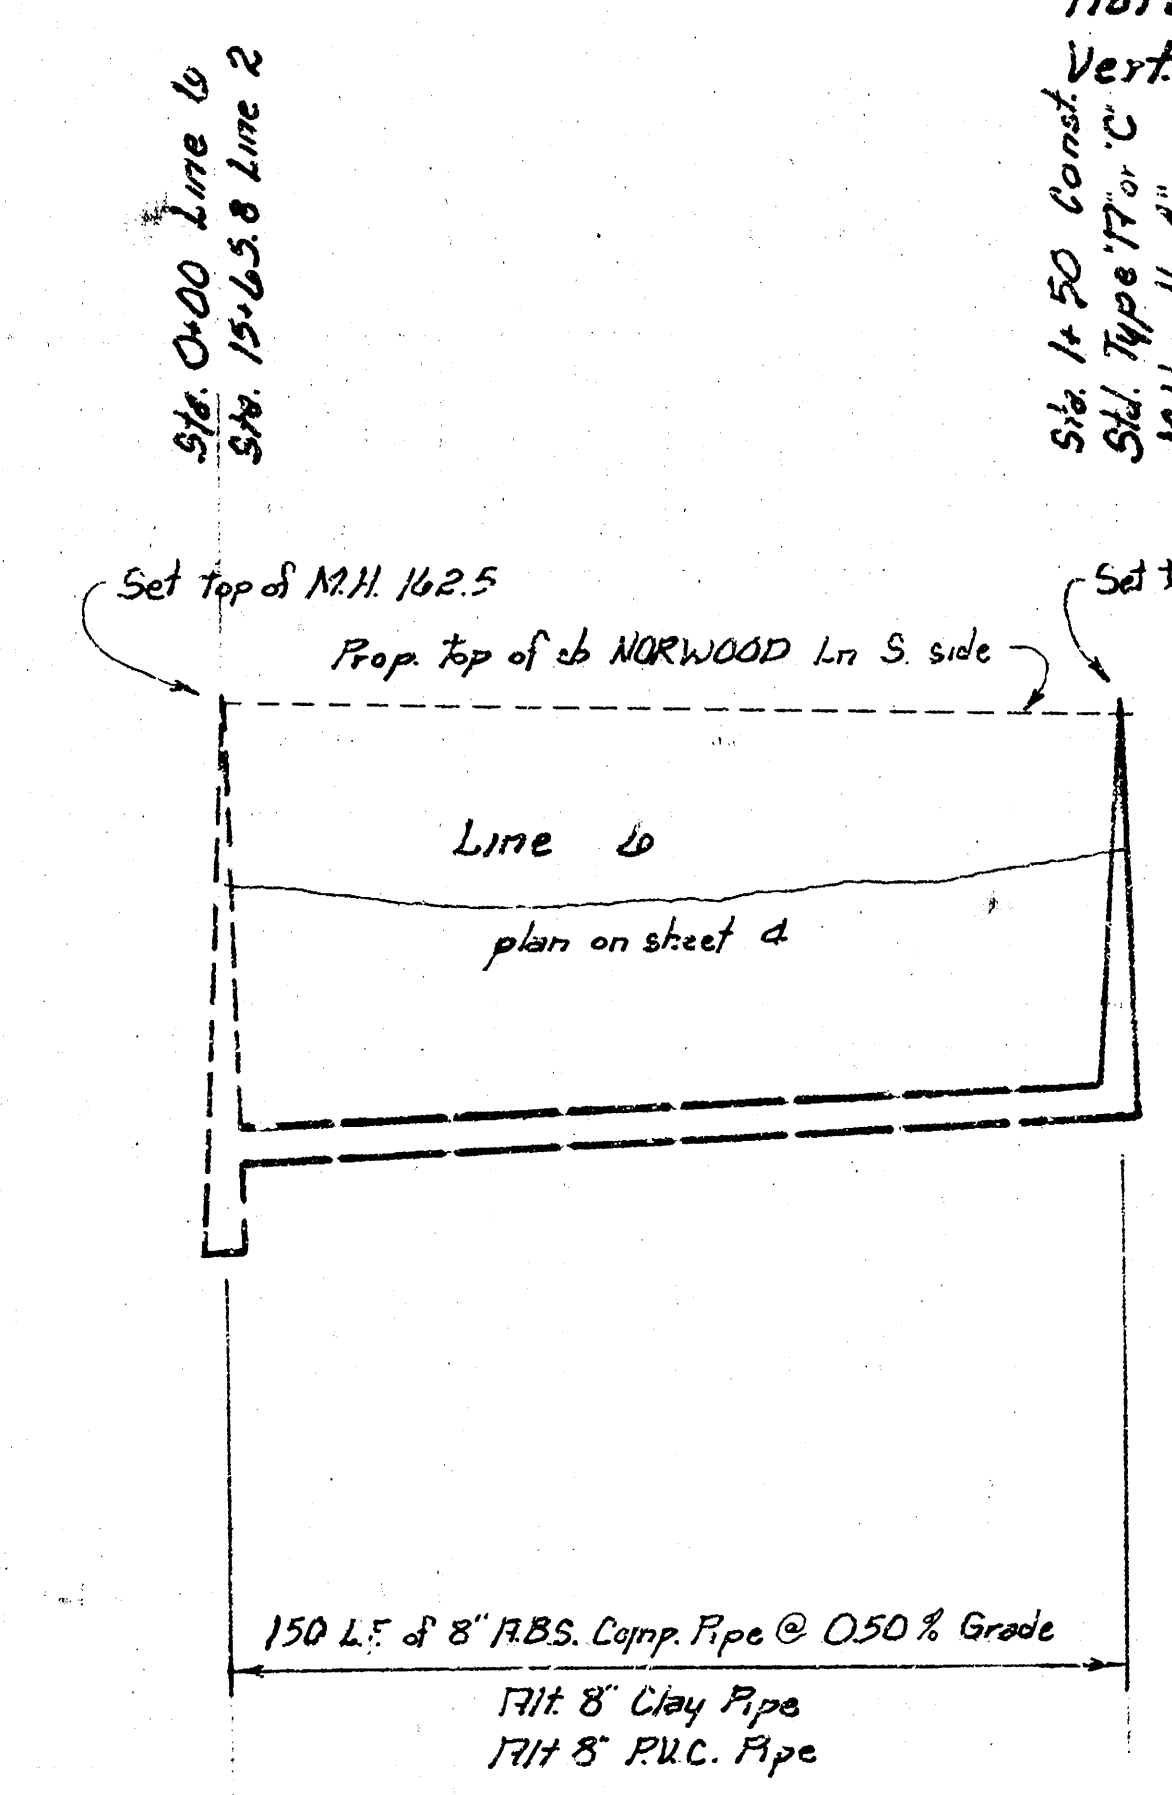

150.86 F.L. Out
152.70 F.L. In

153.20

153.45 F.L.

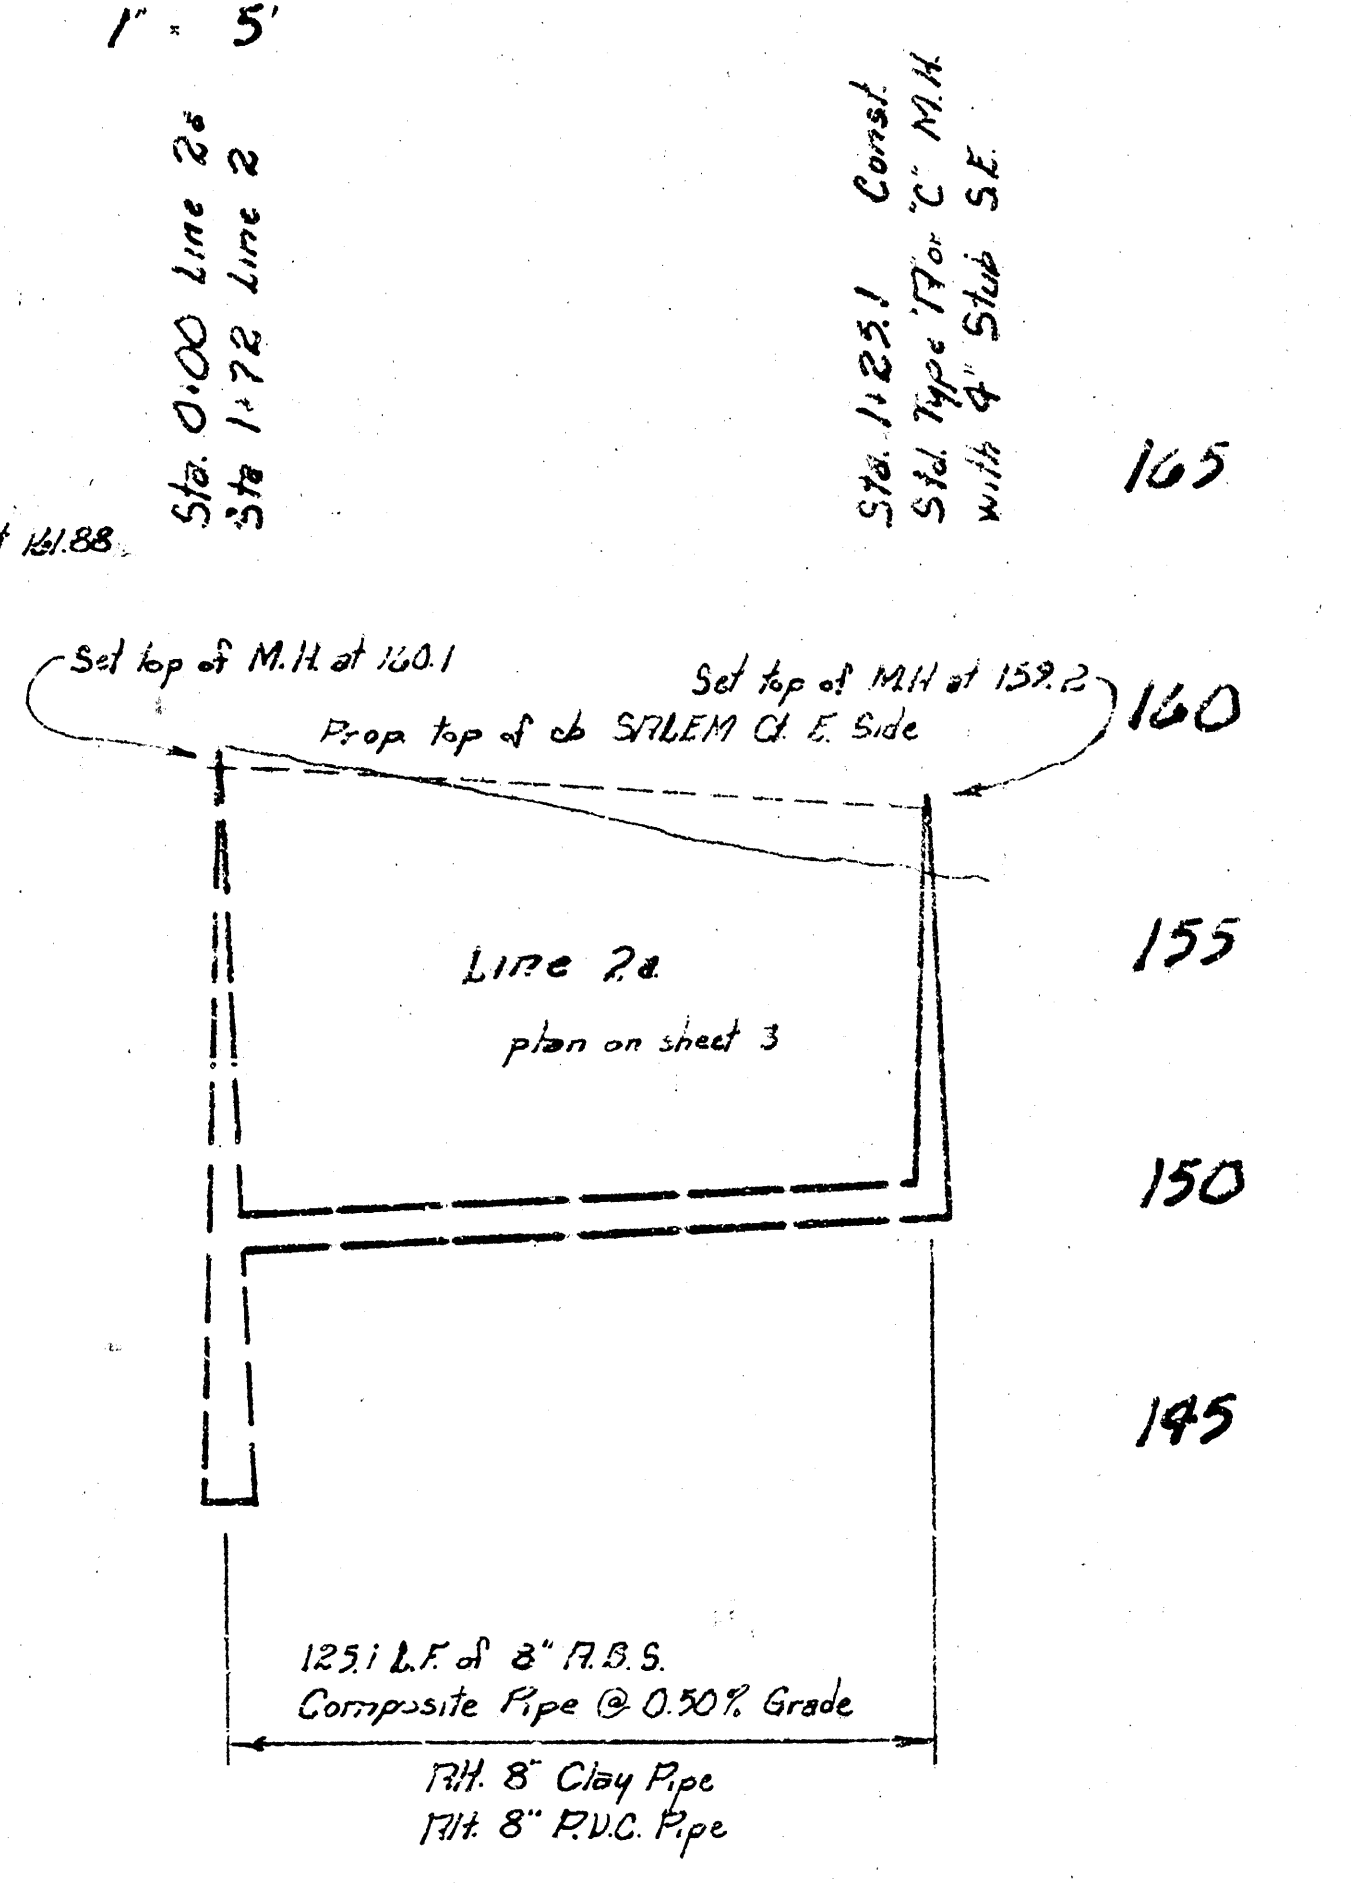

149.69 F.L. Out
149.87 F.L. In

150.37

150.50 F.L.



Scale
Plan 1" = 40'
Profile 1" = 40'
Vert. 1" = 5'

Sta. 16+27.2 Const.
Std. Type 17" C M.H. with 4' Stubs S.W.




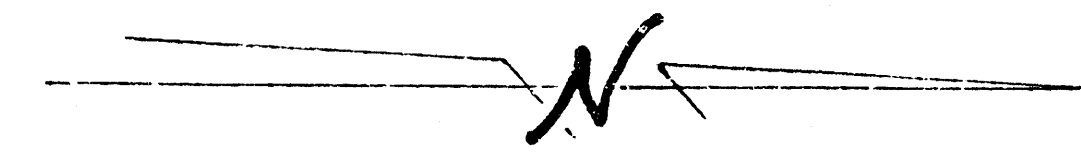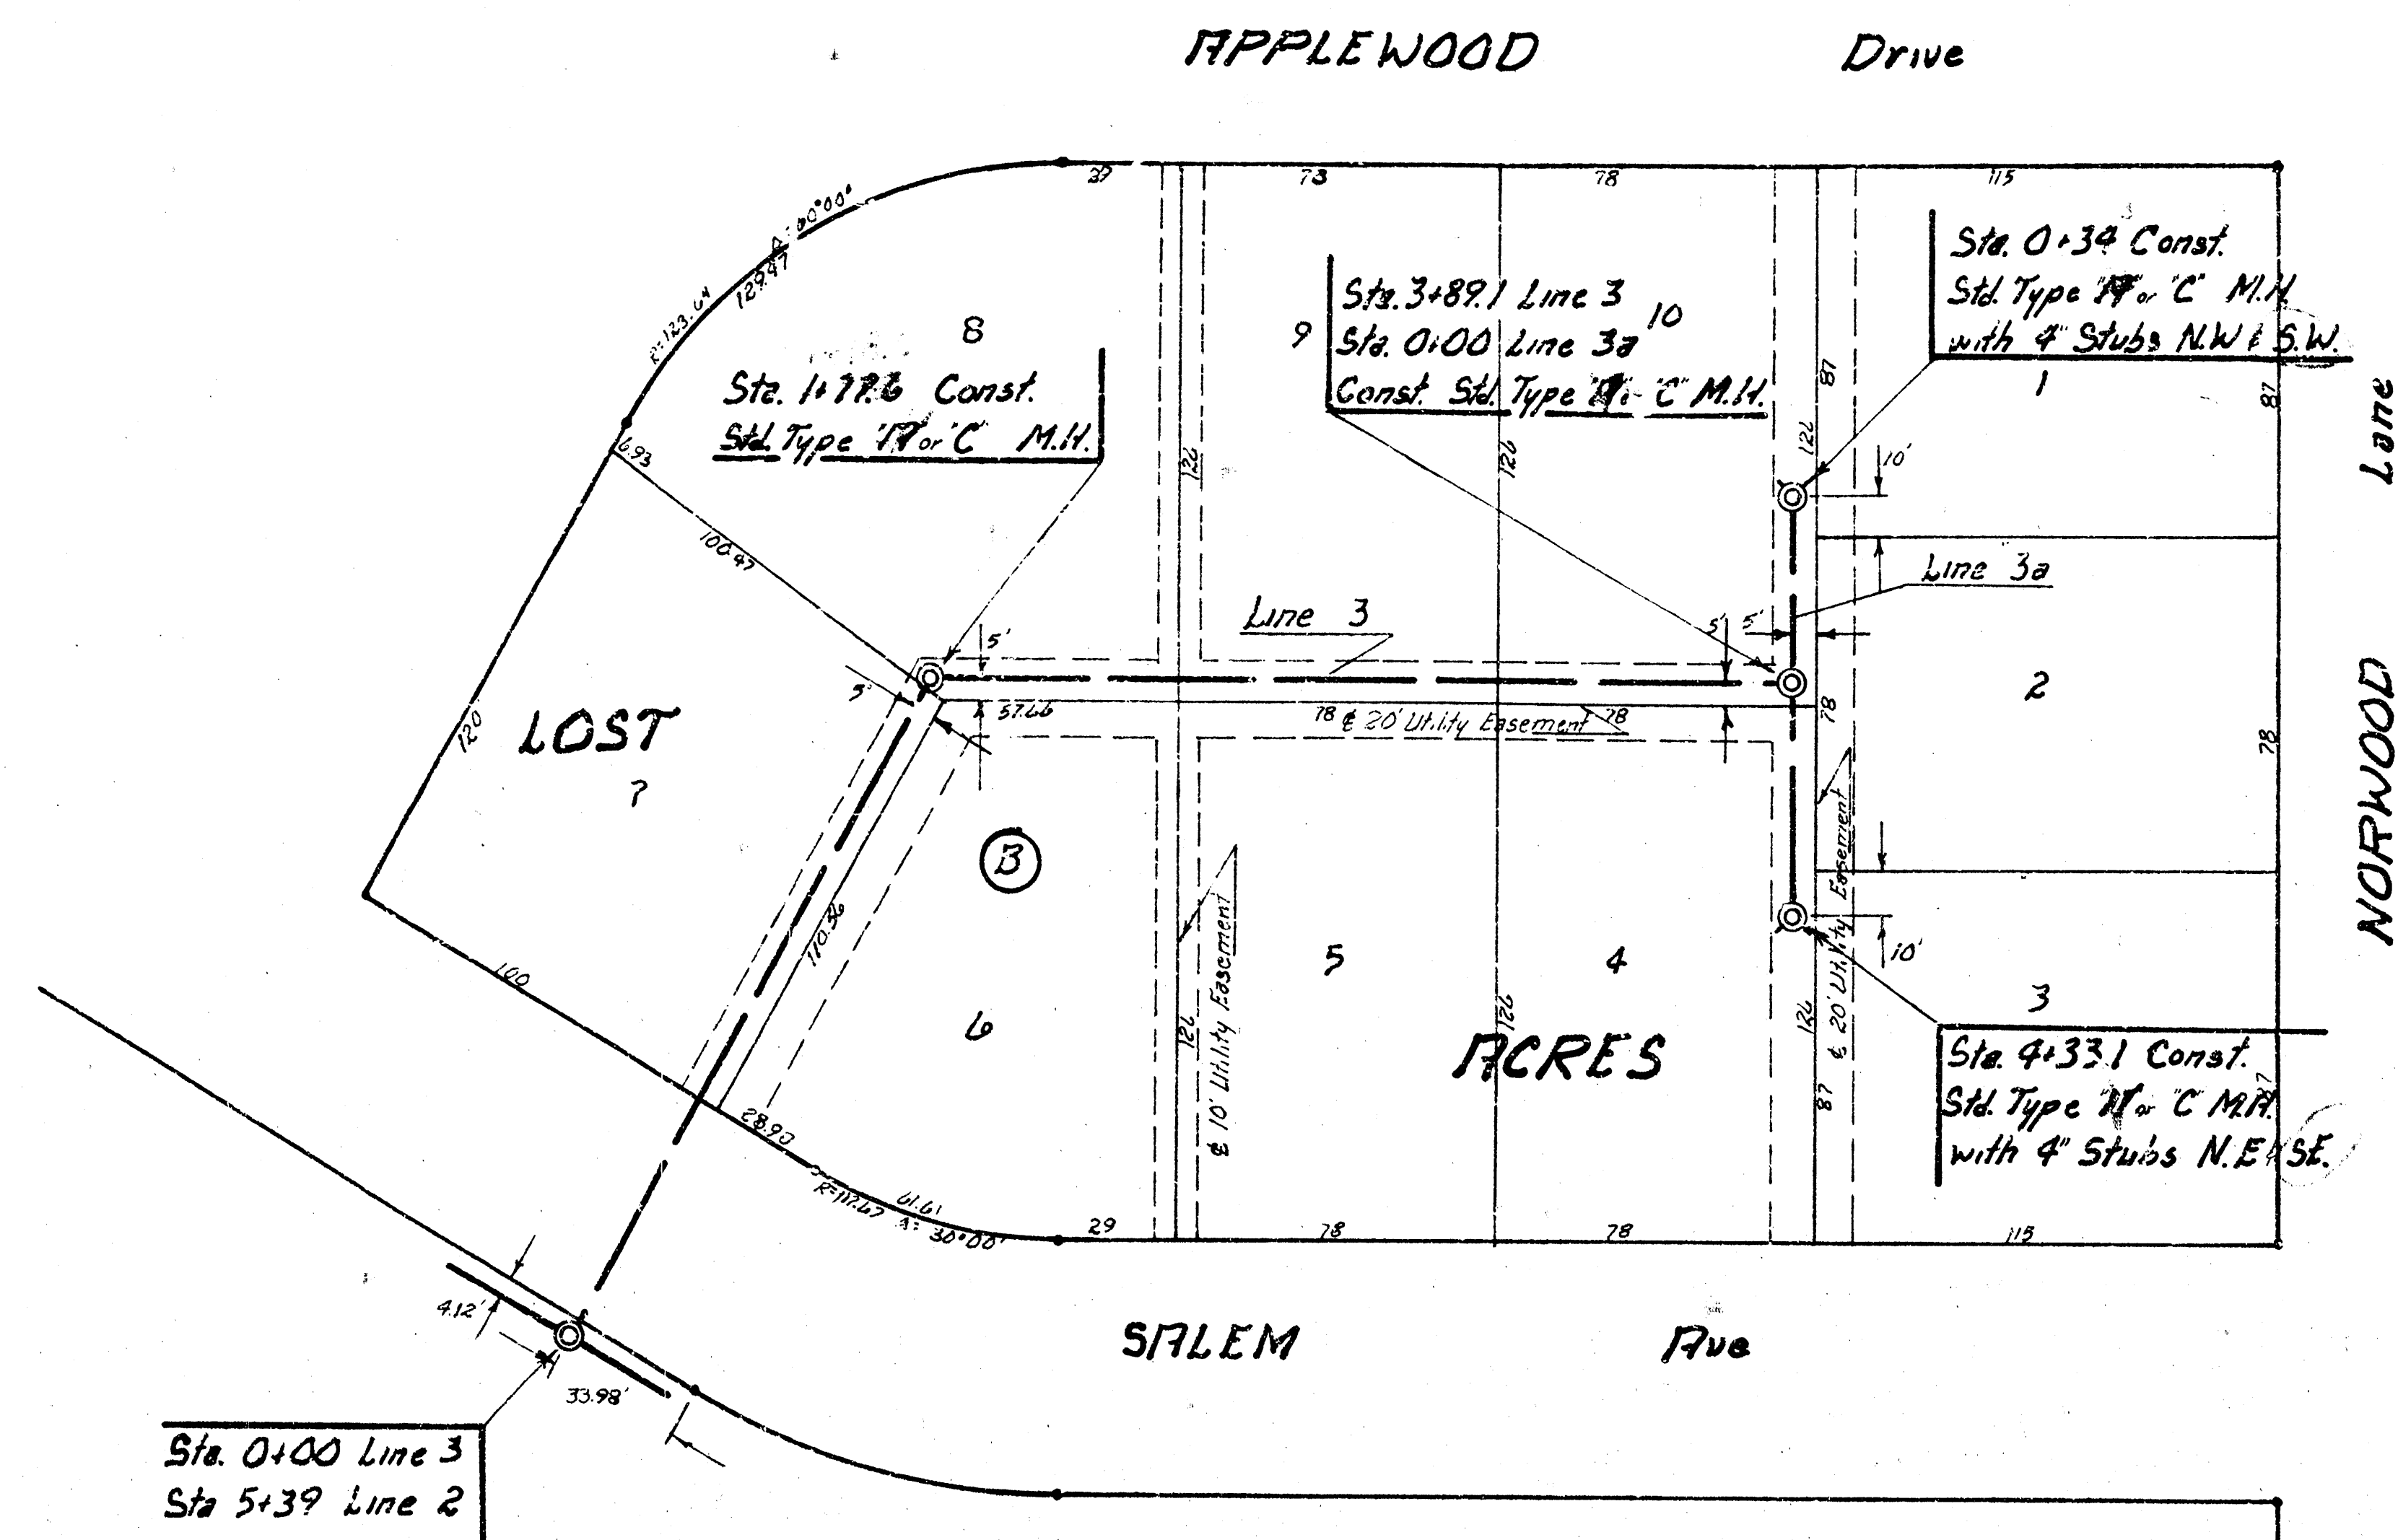

SCALE
Plan 1" = 40'
Profile 1" = 40'
Vert. 1" = 5'

