
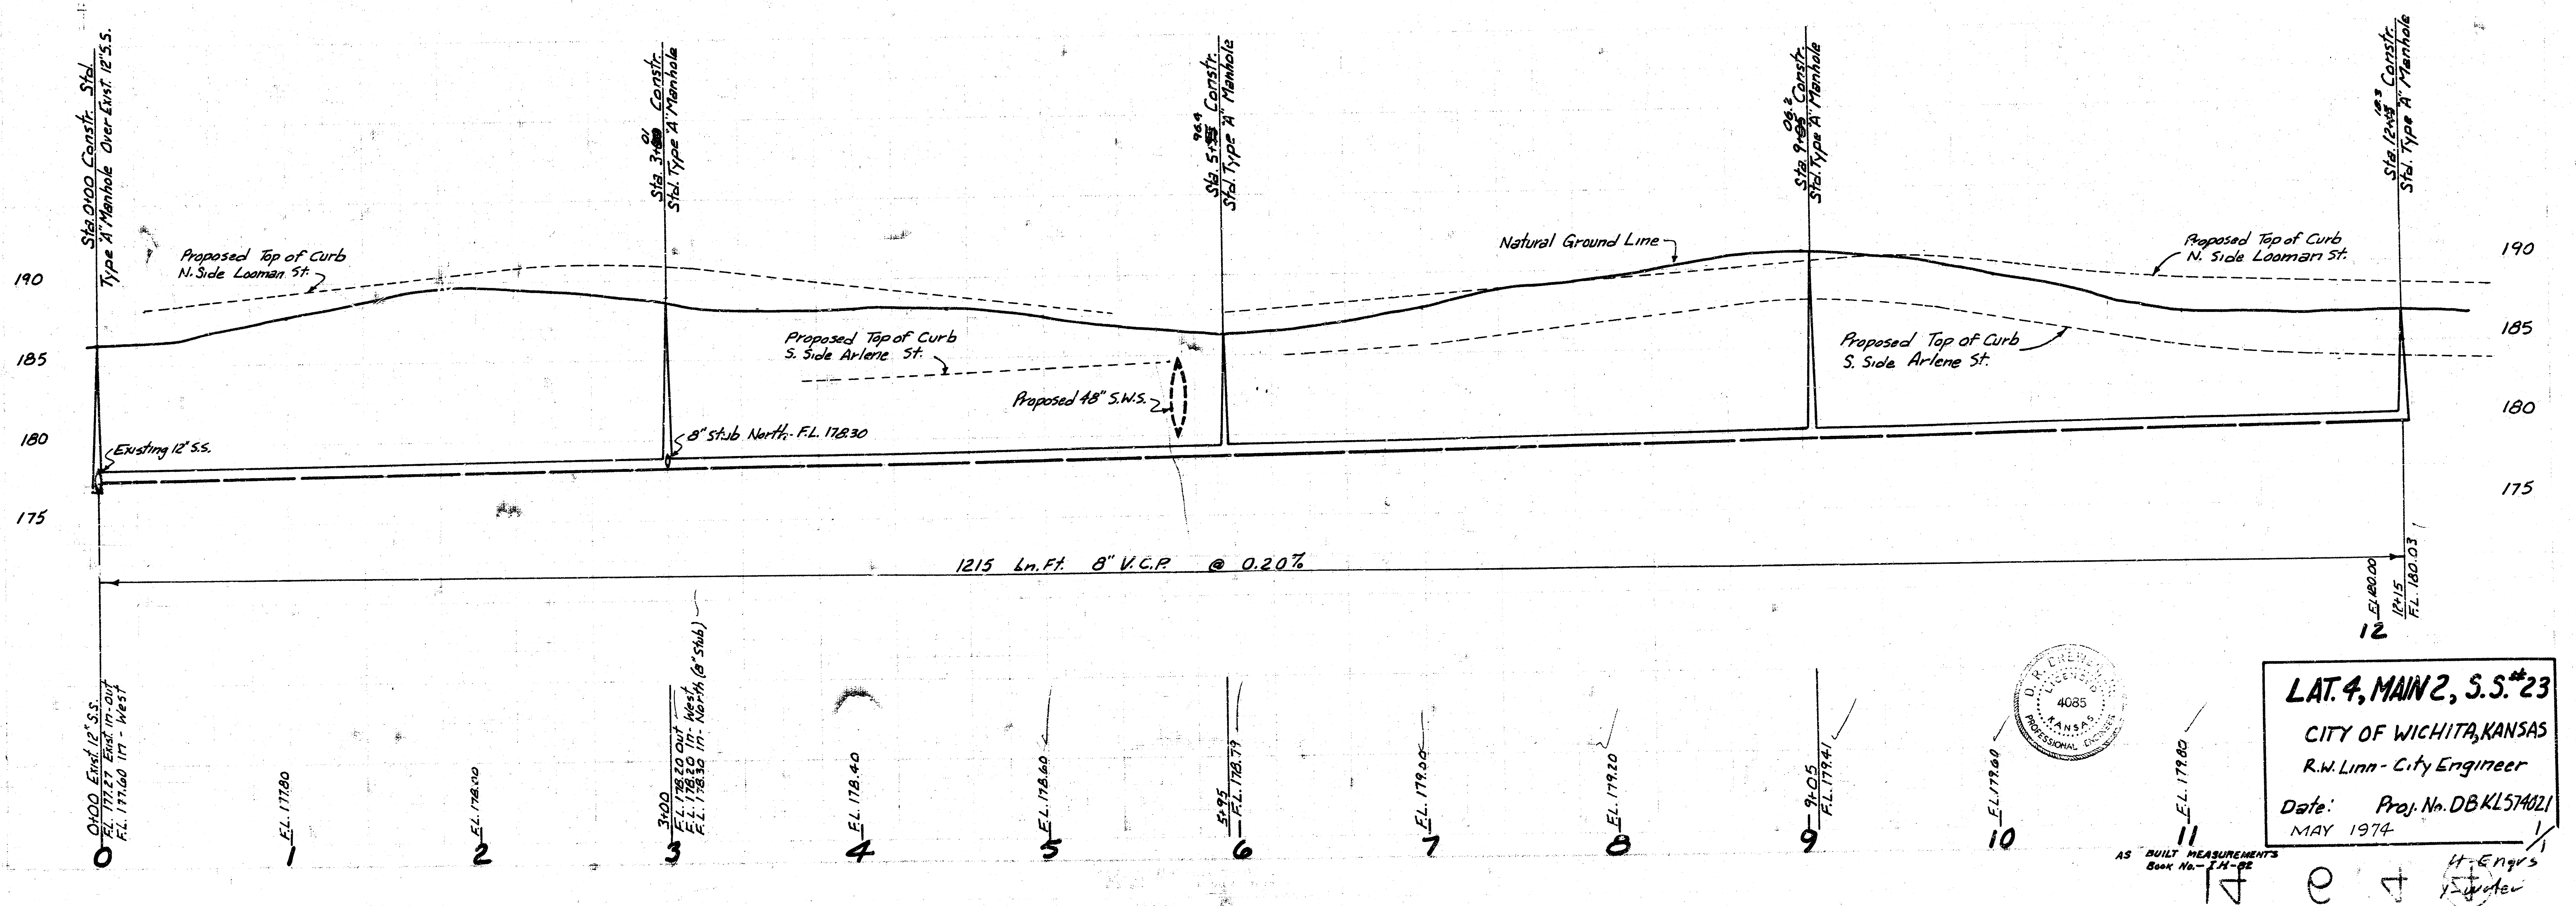


BM=174.49 - City Std. 44' W. of E. Oliver Ave. & 32' N. of E.A.C. Amt W. on 25th St. N.
 BM=183.79 - "2" Cut Top Curb W.S. Oliver, 1st. curb st. N. of S.L. Arlene ext.
 BM=186.33 - S.W. Corner Conc. Parch. Ho. at 4914 E. 24th St. N.

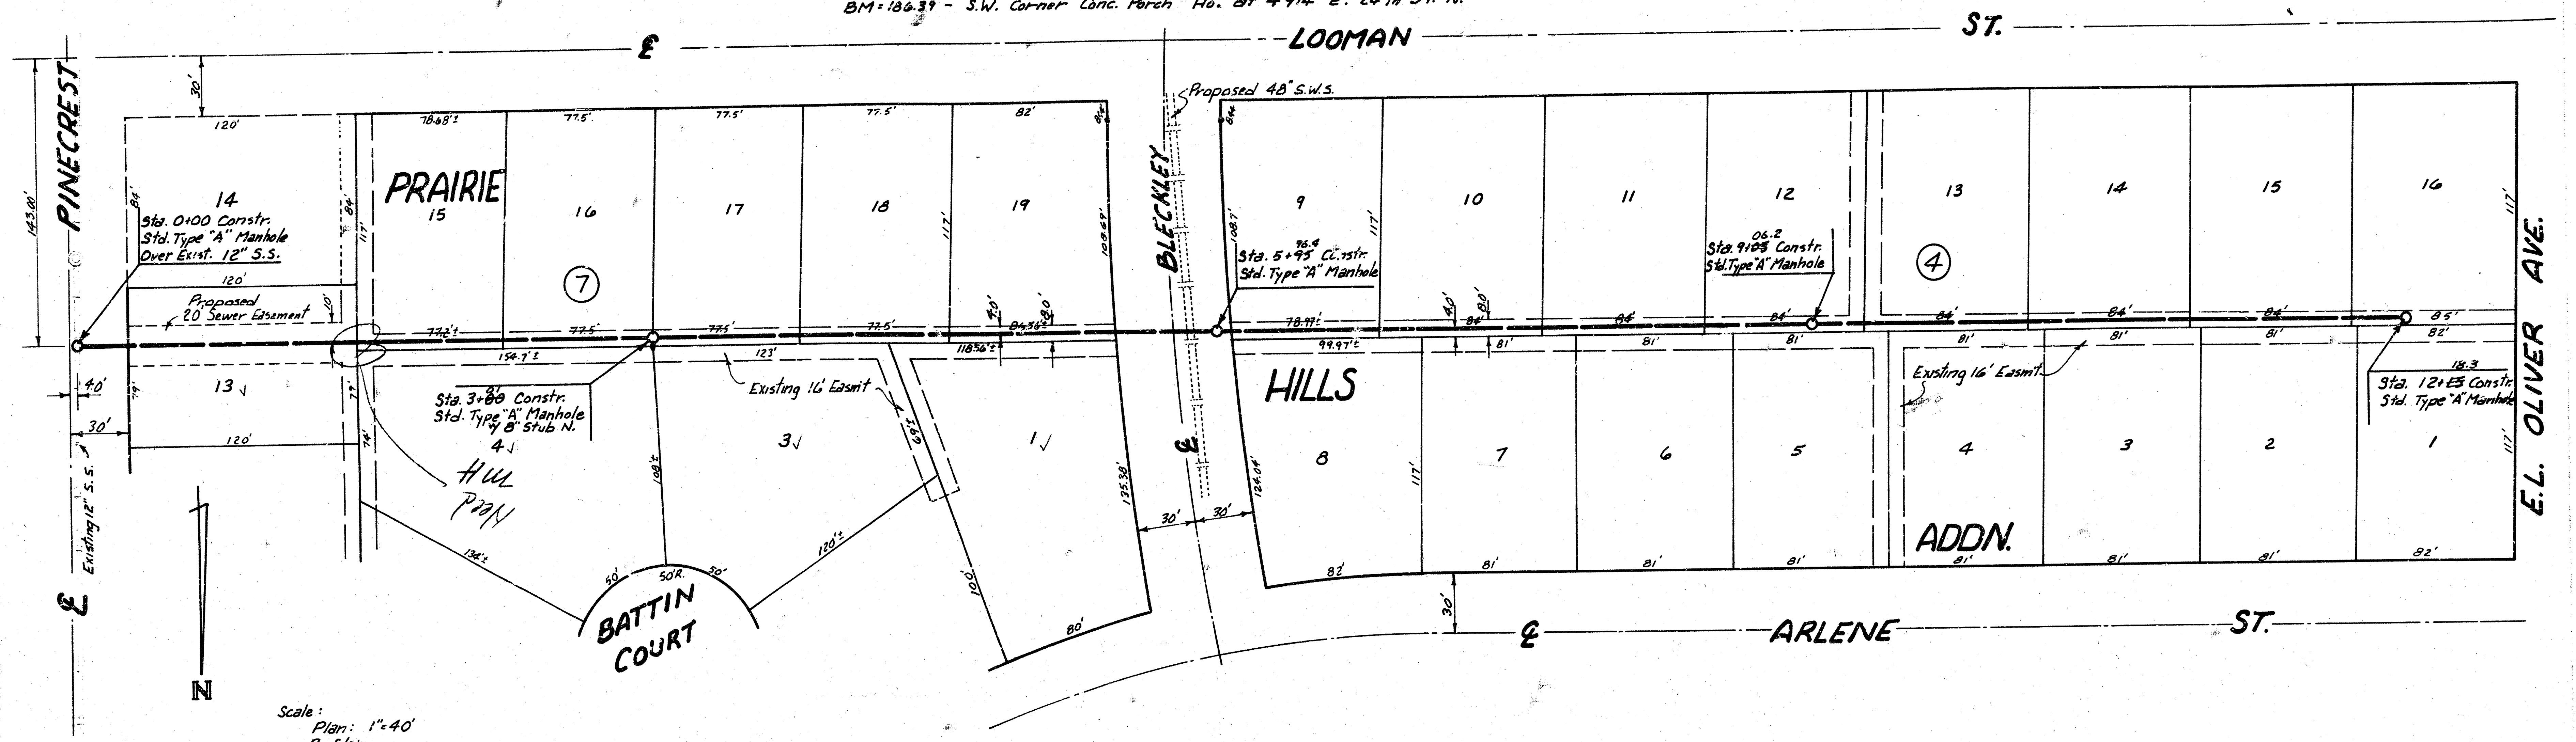

LAT. 4, MAIN 2, S.S. #23
 CITY OF WICHITA, KANSAS
 R.W. Linn - City Engineer
 Date: May 1974
 Proj. No. DBKL574021

H. Eng'rs
 15-10-74