


PLAN	DATE
BY	
CHECKED	
NOTED	
NO.	


PROFILE	DATE
BY	
CHECKED	
NOTED	
NO.	

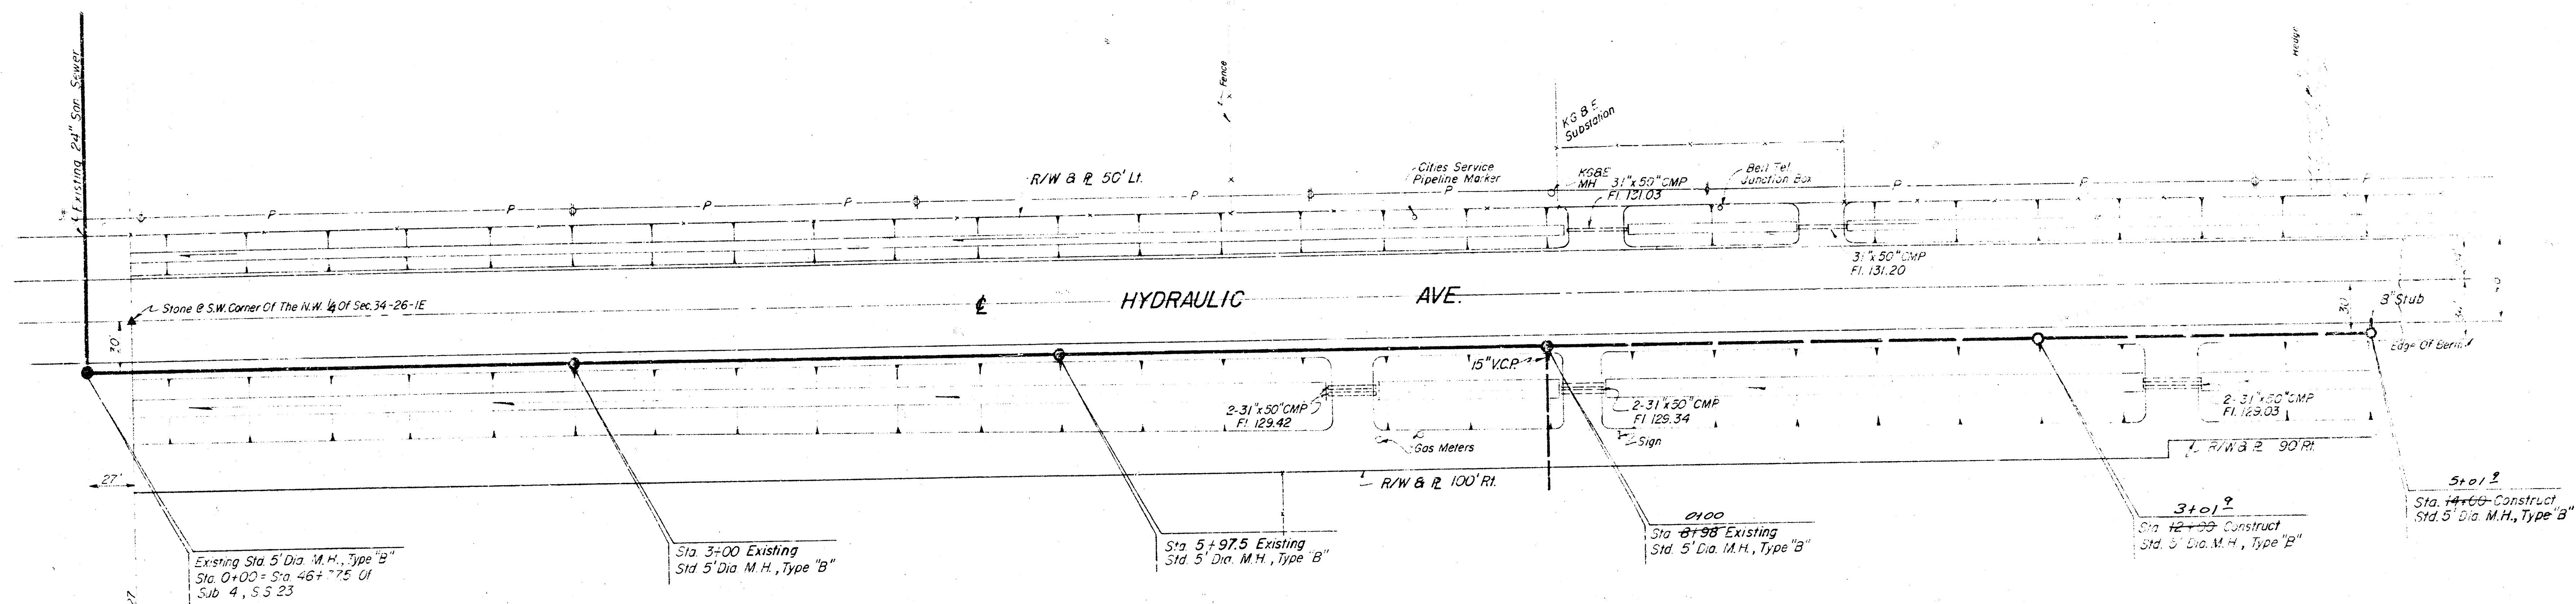

Project Bench Mark No. 1 - Top Of Existing Manhole Ring - Elev. 133.30

NOTE: Sand Fill And Flush


SCALE: Plan 1"=50'
Profile 1"=5'

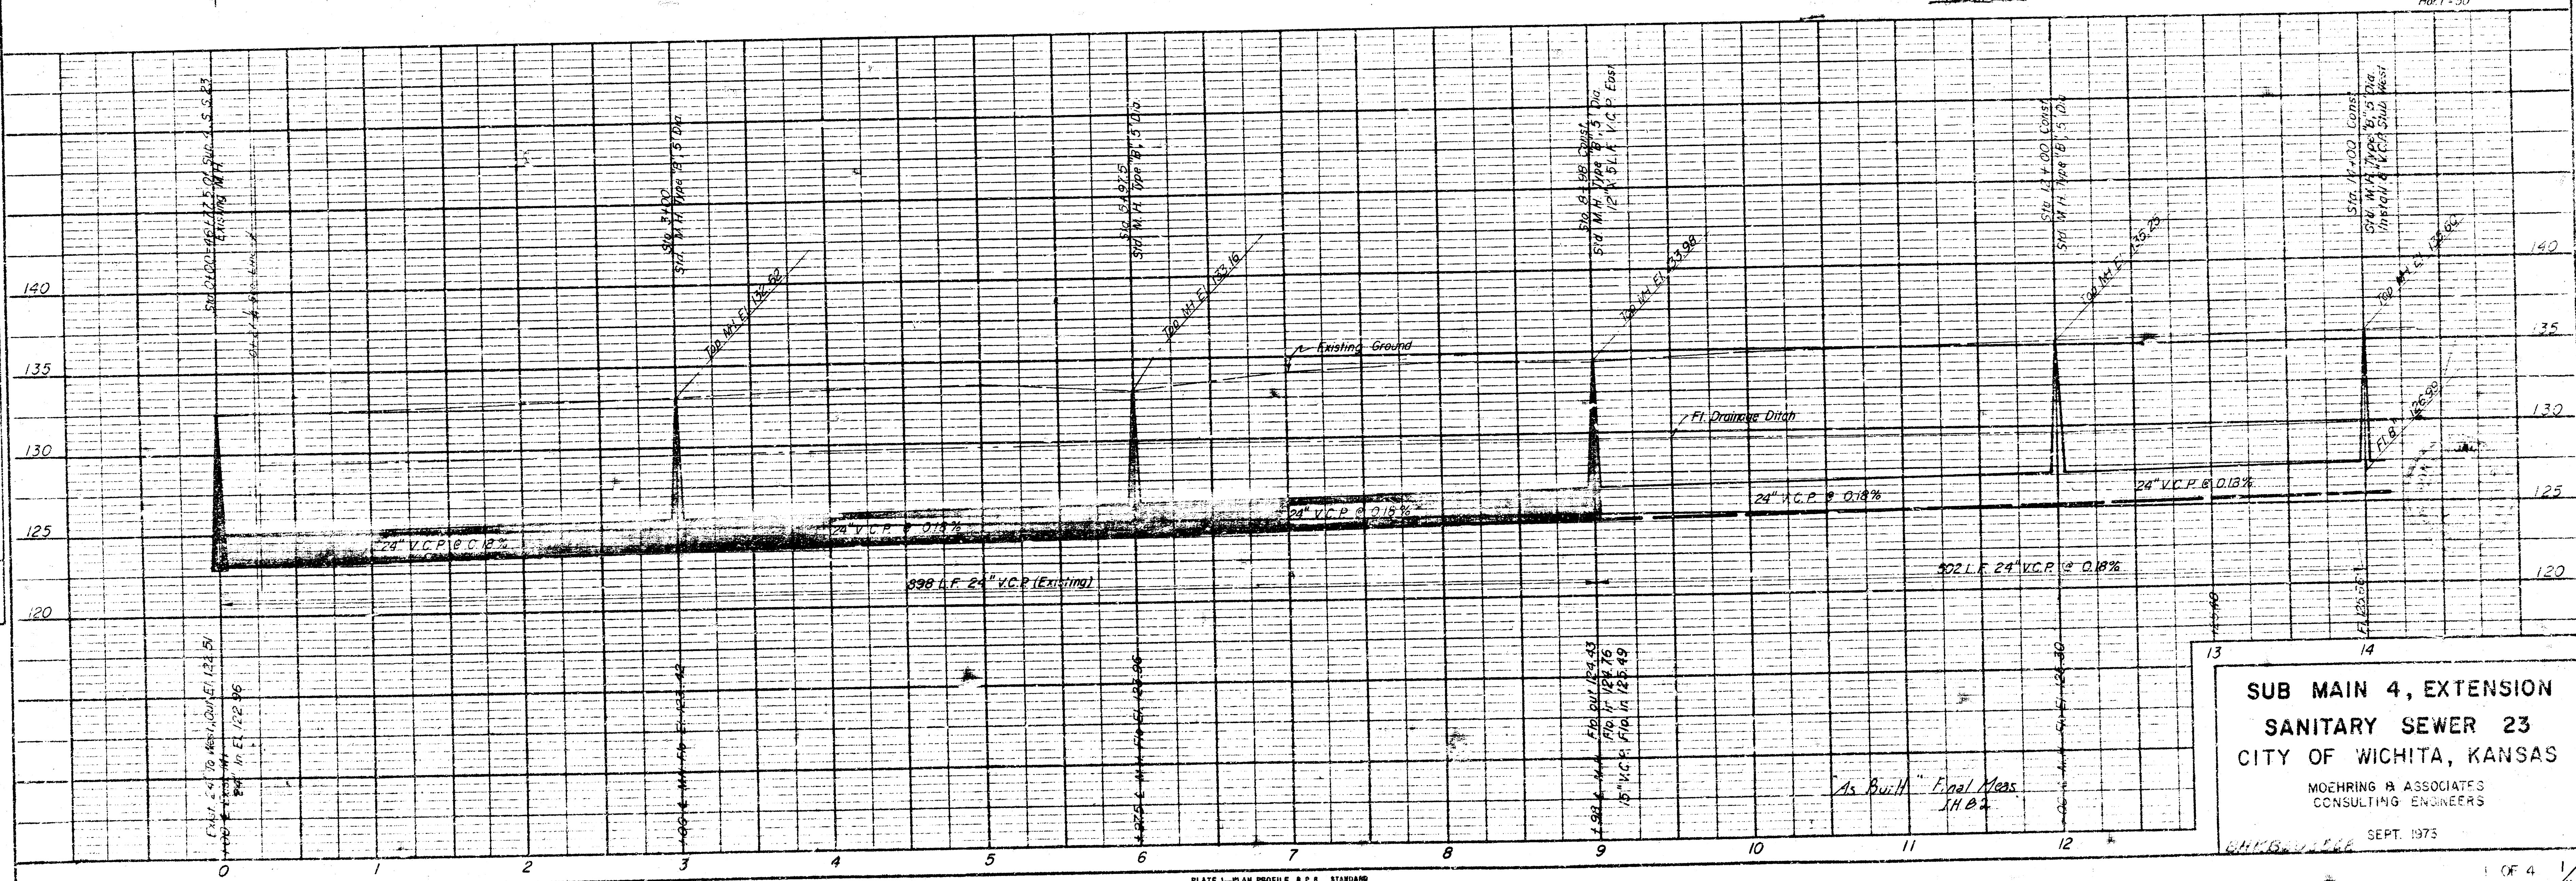

**SUB MAIN 4, EXTENSION
SANITARY SEWER 23
CITY OF WICHITA, KANSAS**
MOEHRING & ASSOCIATES
CONSULTING ENGINEERS
SEPT. 1975

PLAN	DATE	BY	CHECKED
NO.			

PROFILE	DATE	BY	CHECKED
NO.			

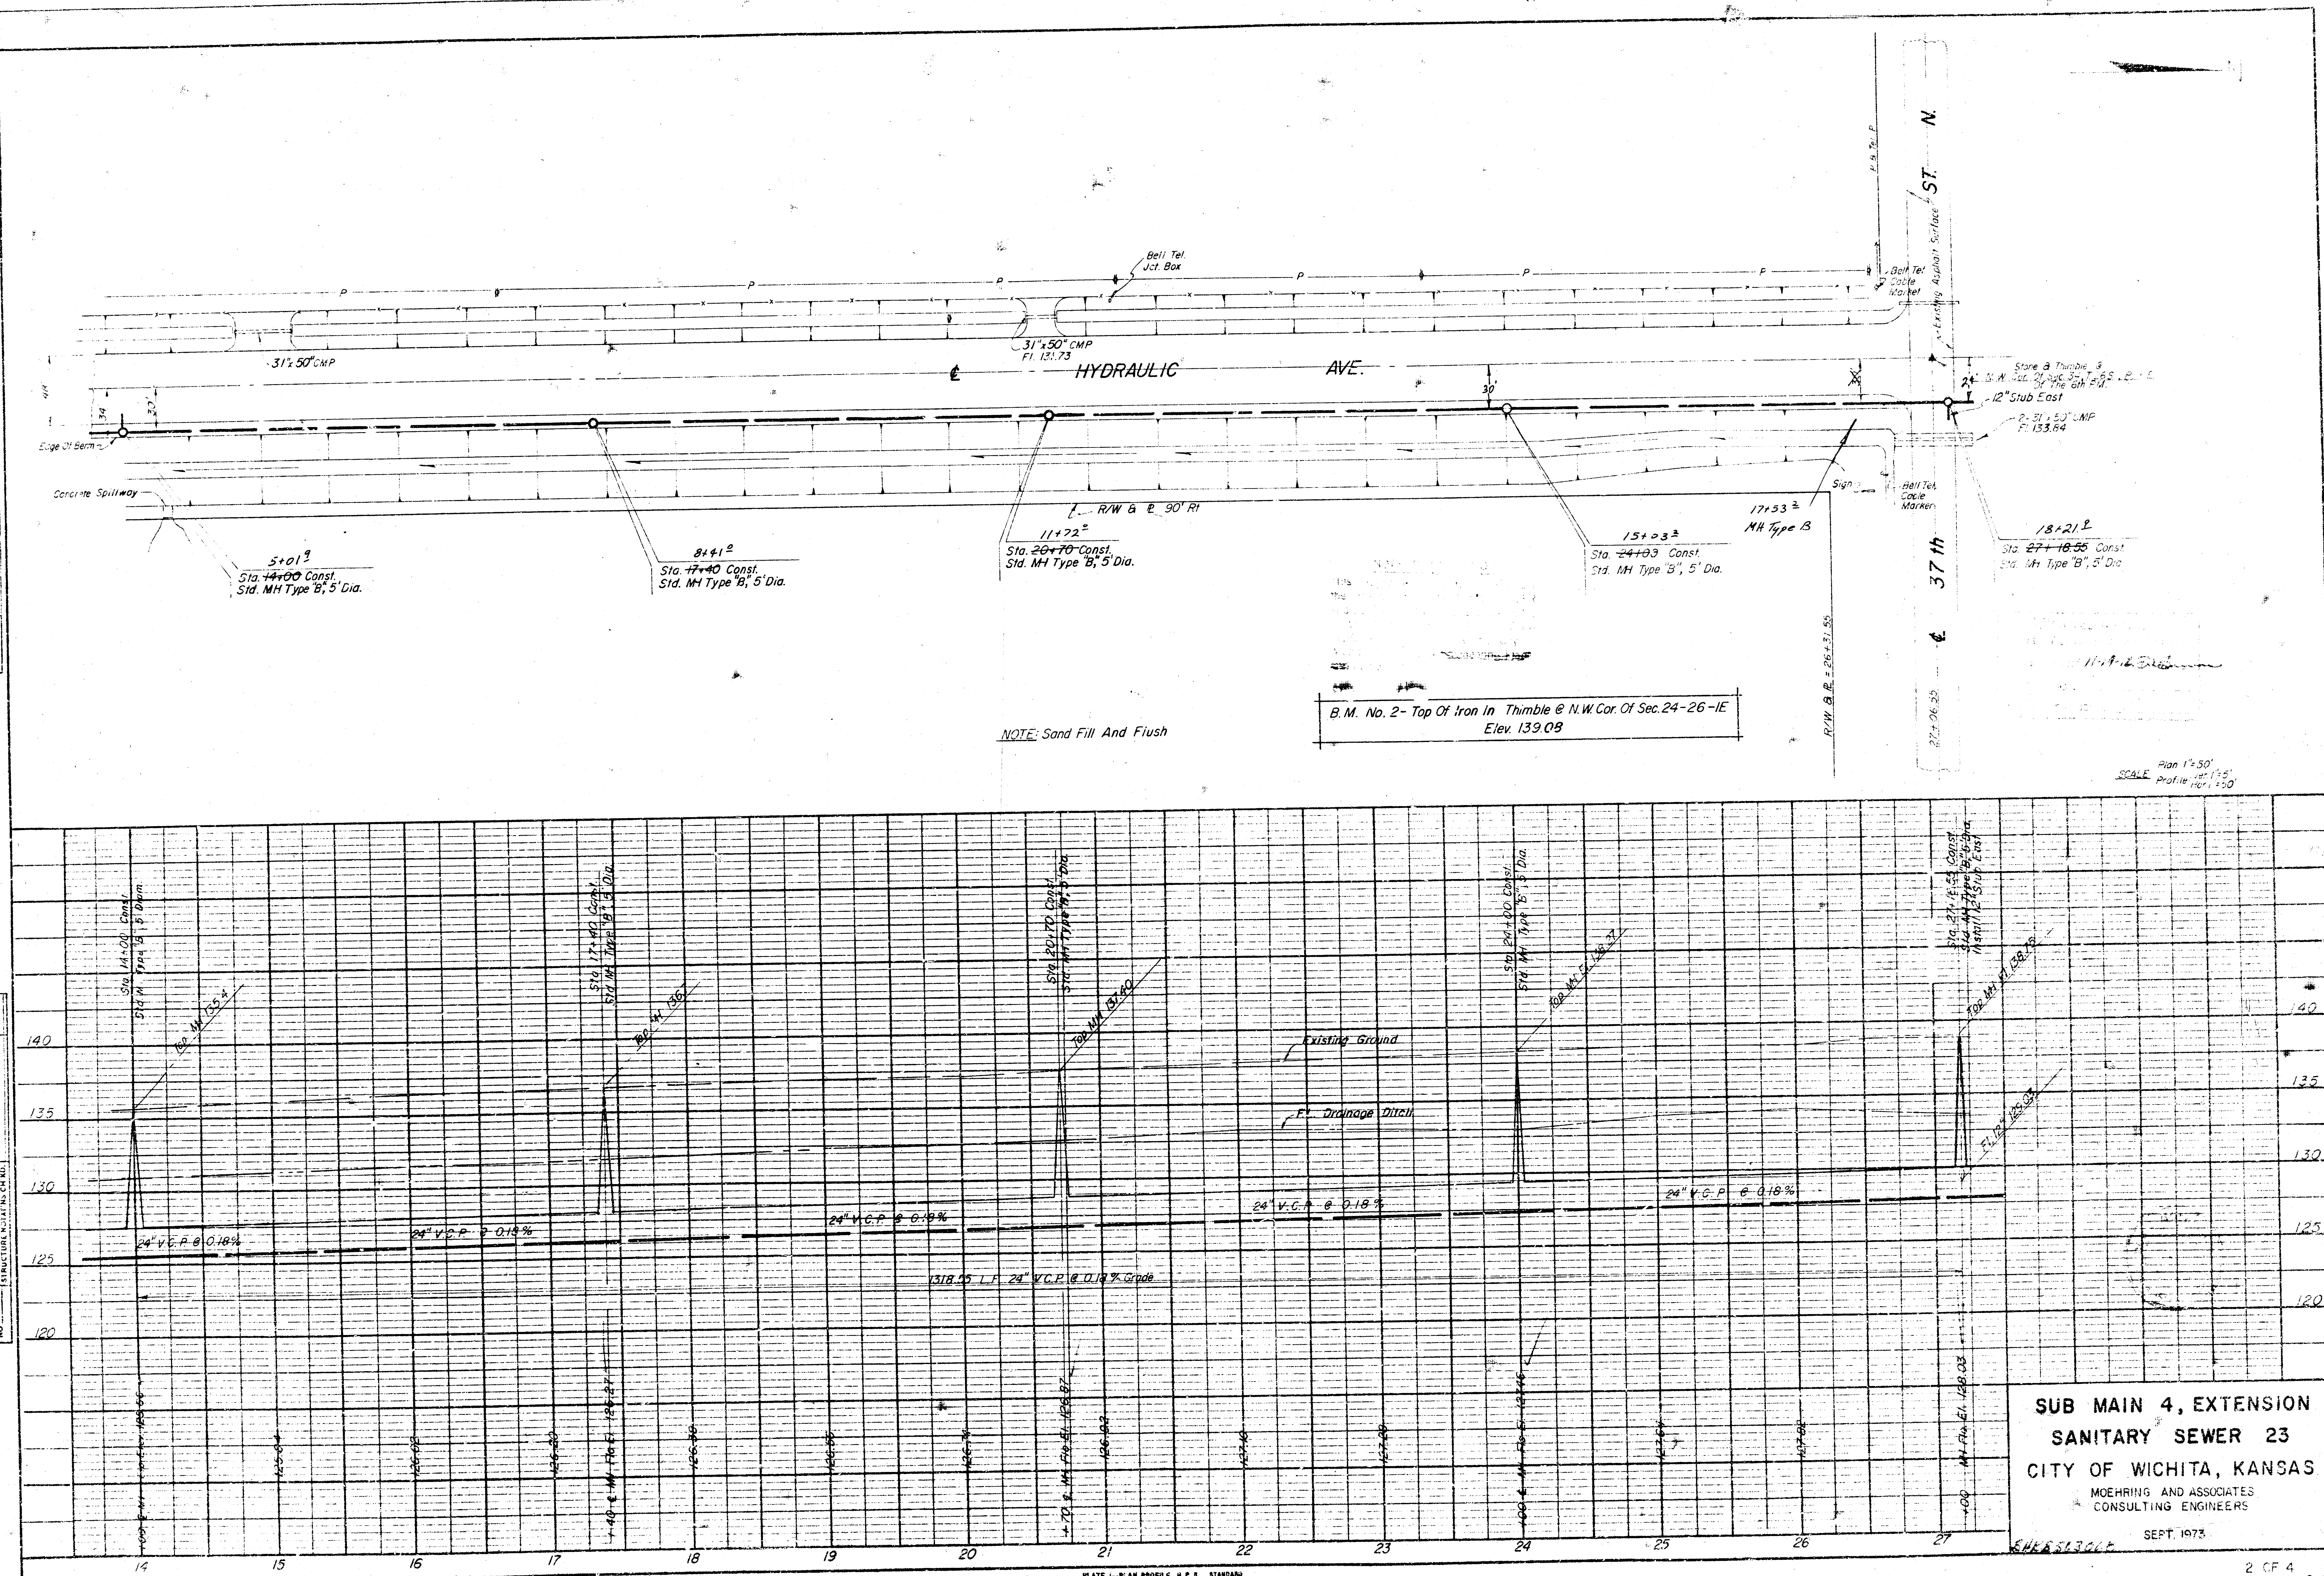



COUNTY OF SEDGWICK
HIGHWAY DEPARTMENT

1011 CHERRY STREET
WICHITA, KANSAS 67202
COUNTY ENGINEER
November 1, 1973
PHONE 268-1201

Mr. Don Moehring II
Brown Building
Wichita, Kansas

Dear Mr. Moehring,

This office has examined the plans for Sub Main 4, Extension
Sanitary Sewer 23, City of Wichita, Kansas. We have no objection
for its approval.

Very truly yours,

G. C. McLure, Jr., P. E.
Sedgwick County Engineer

G. C. McLure, Jr.
No. J. Graham
Engineering Aide II

PLAN	DATE
NO. 1	11/1/73
NO. 2	
NO. 3	
PROFILE	DATE
NO. 1	11/1/73
NO. 2	
NO. 3	
