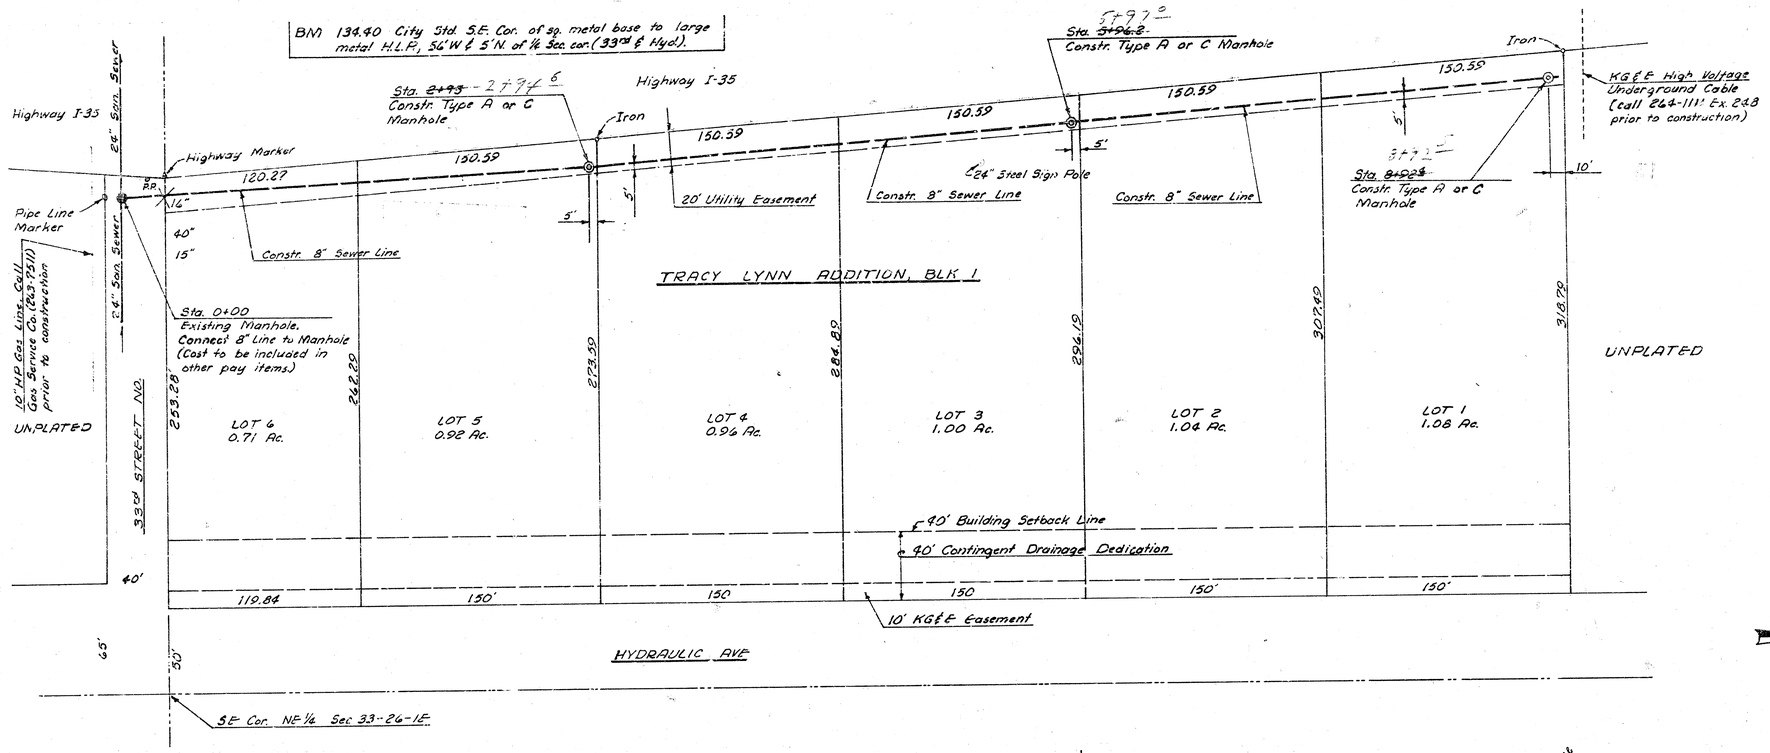

As built 1-4-77

LAT. 82, MAIN 4, S.S. #23
CITY OF WICHITA
R. W. LINN, CITY ENGINEER
DATE: Nov 1976
Project No. D8KL 574051
Sheet 1 of 1