B.M. 132.09 - City Std., 34' E. of ℄ of Arkansas Ave. & 2' So. of S.L. 37TH St. No.

B.M. 130.28 - R.R. Spike, N. Face P.P., W. Side Arkansas Ave. 115' ± So. of S.L. 36TH St. No.

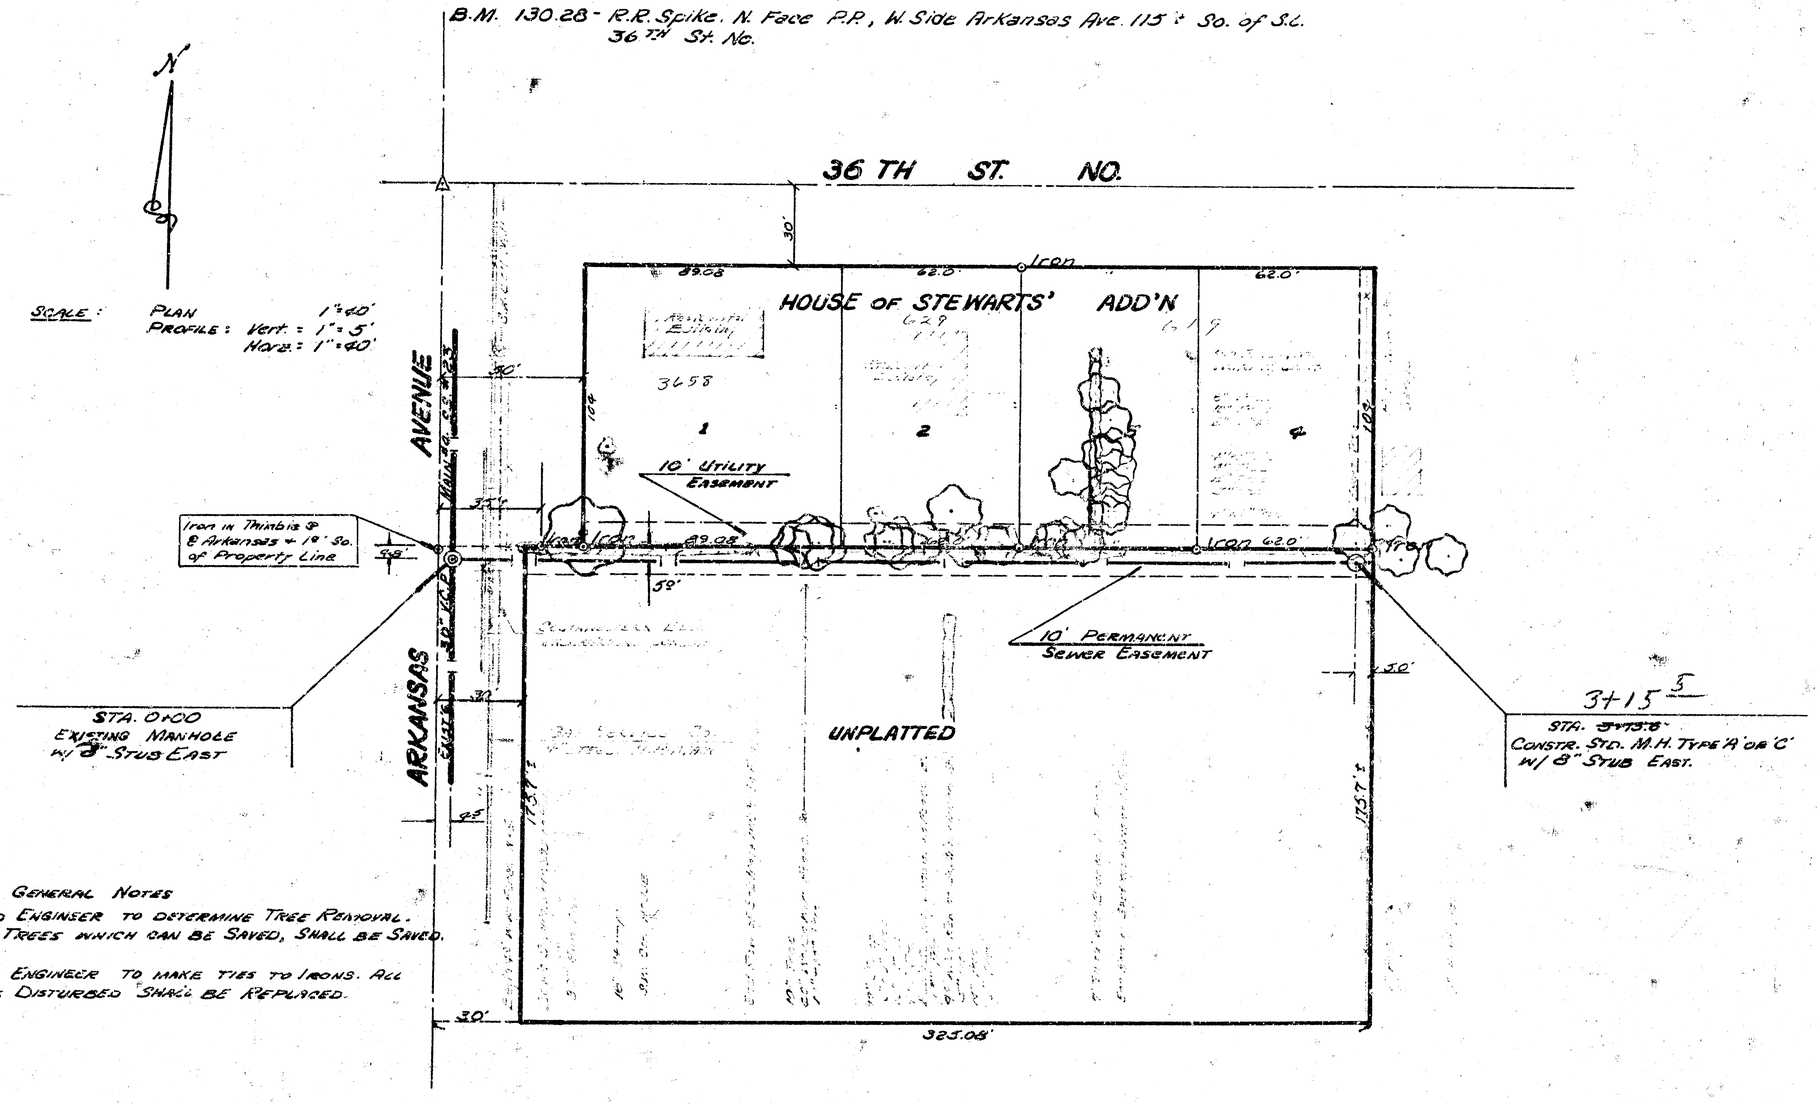

General Notes

1. Field Engineer to determine tree removal. 'ALL' trees which can be saved, shall be saved.
2. Field Engineer to make ties to irons. All irons disturbed shall be replaced.

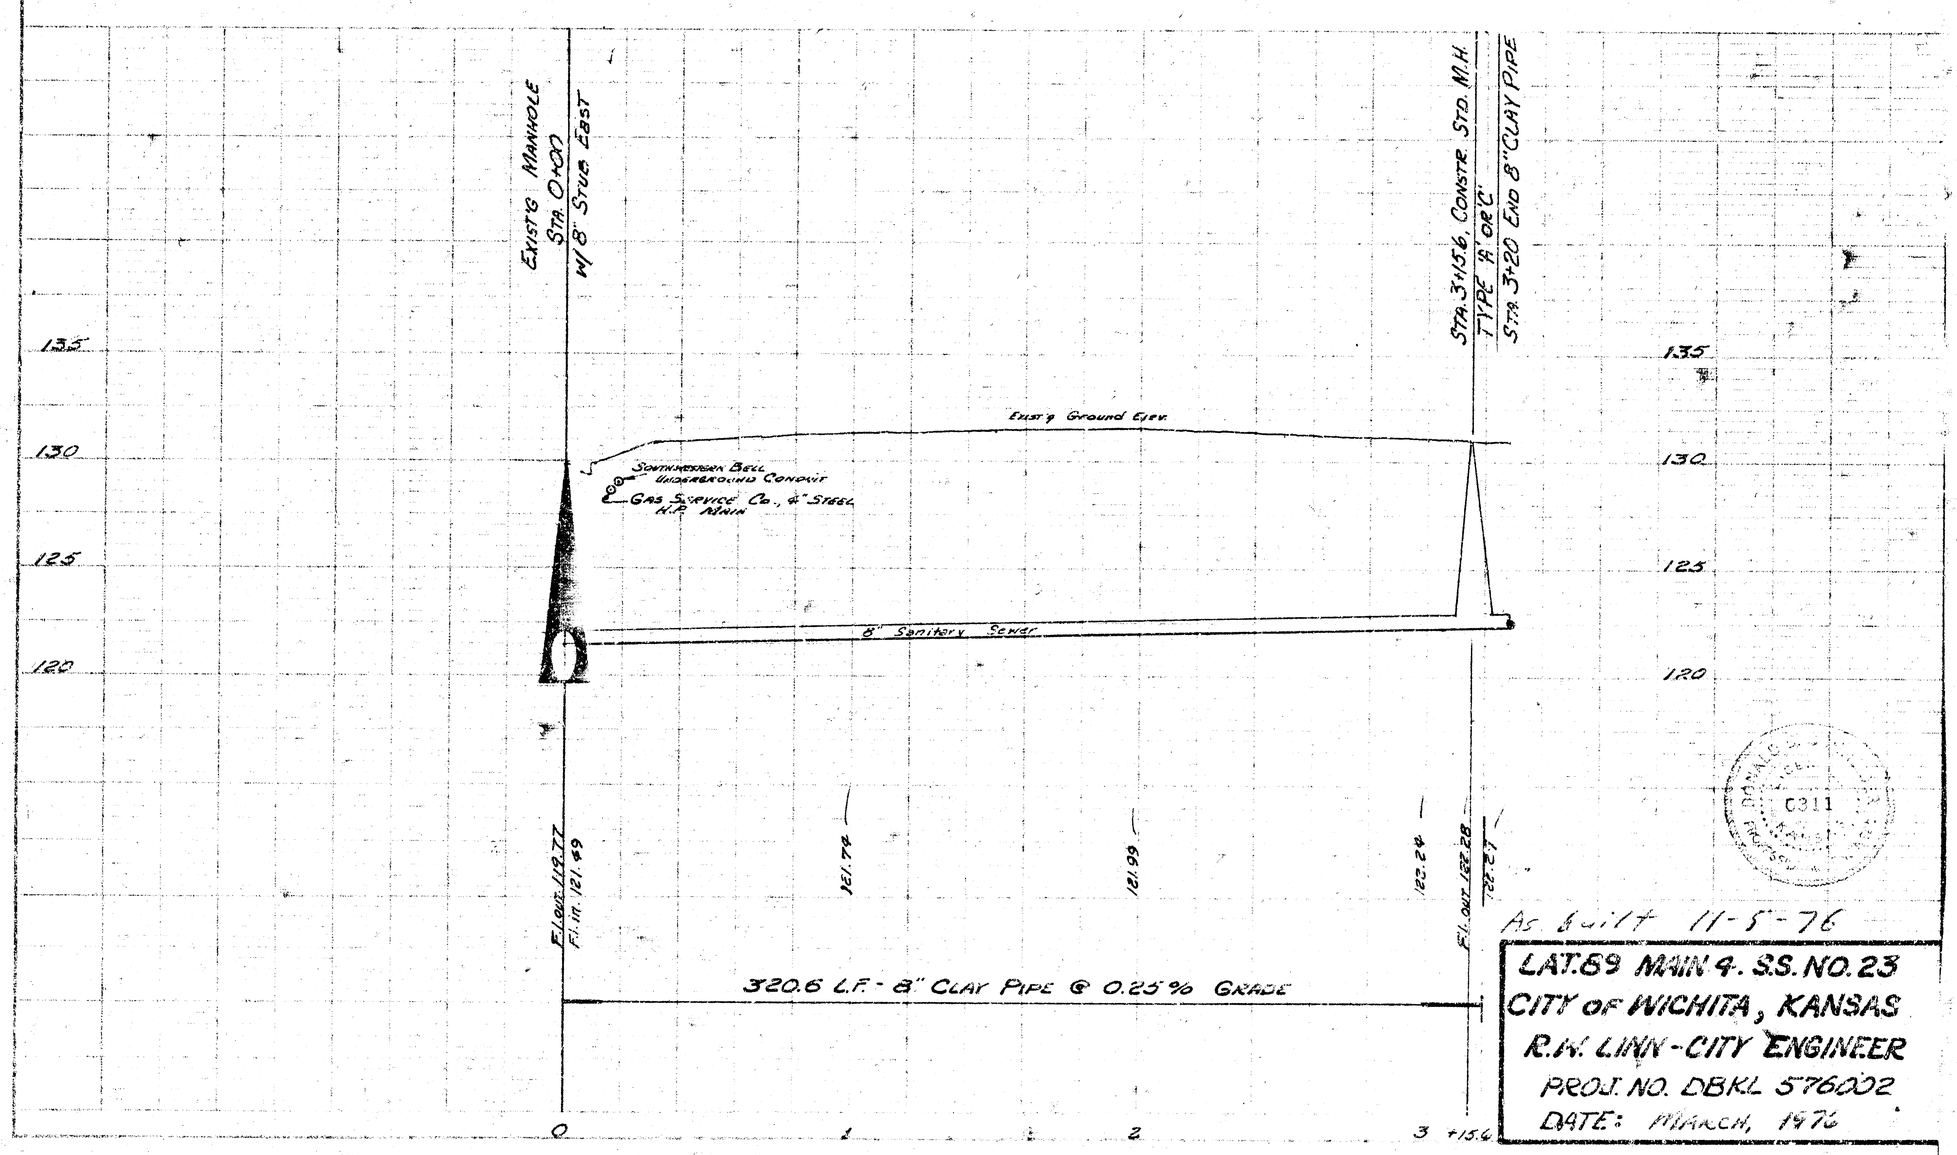

As Built 11-5-76

LAT. 69 MAIN & S.S. NO. 23
CITY OF WICHITA, KANSAS
R.W. LINN - CITY ENGINEER
PROJ. NO. DBKL 576002
DATE: MARCH, 1976

C311