



BM 129.81 City std. 32.0' S. of C of 33rd St. North going east & 22.0' E. of C of Arkansas
 BM 130.51 Top East Curb of Arkansas at South line of 32nd St. North being 29.5' south of thimble on C

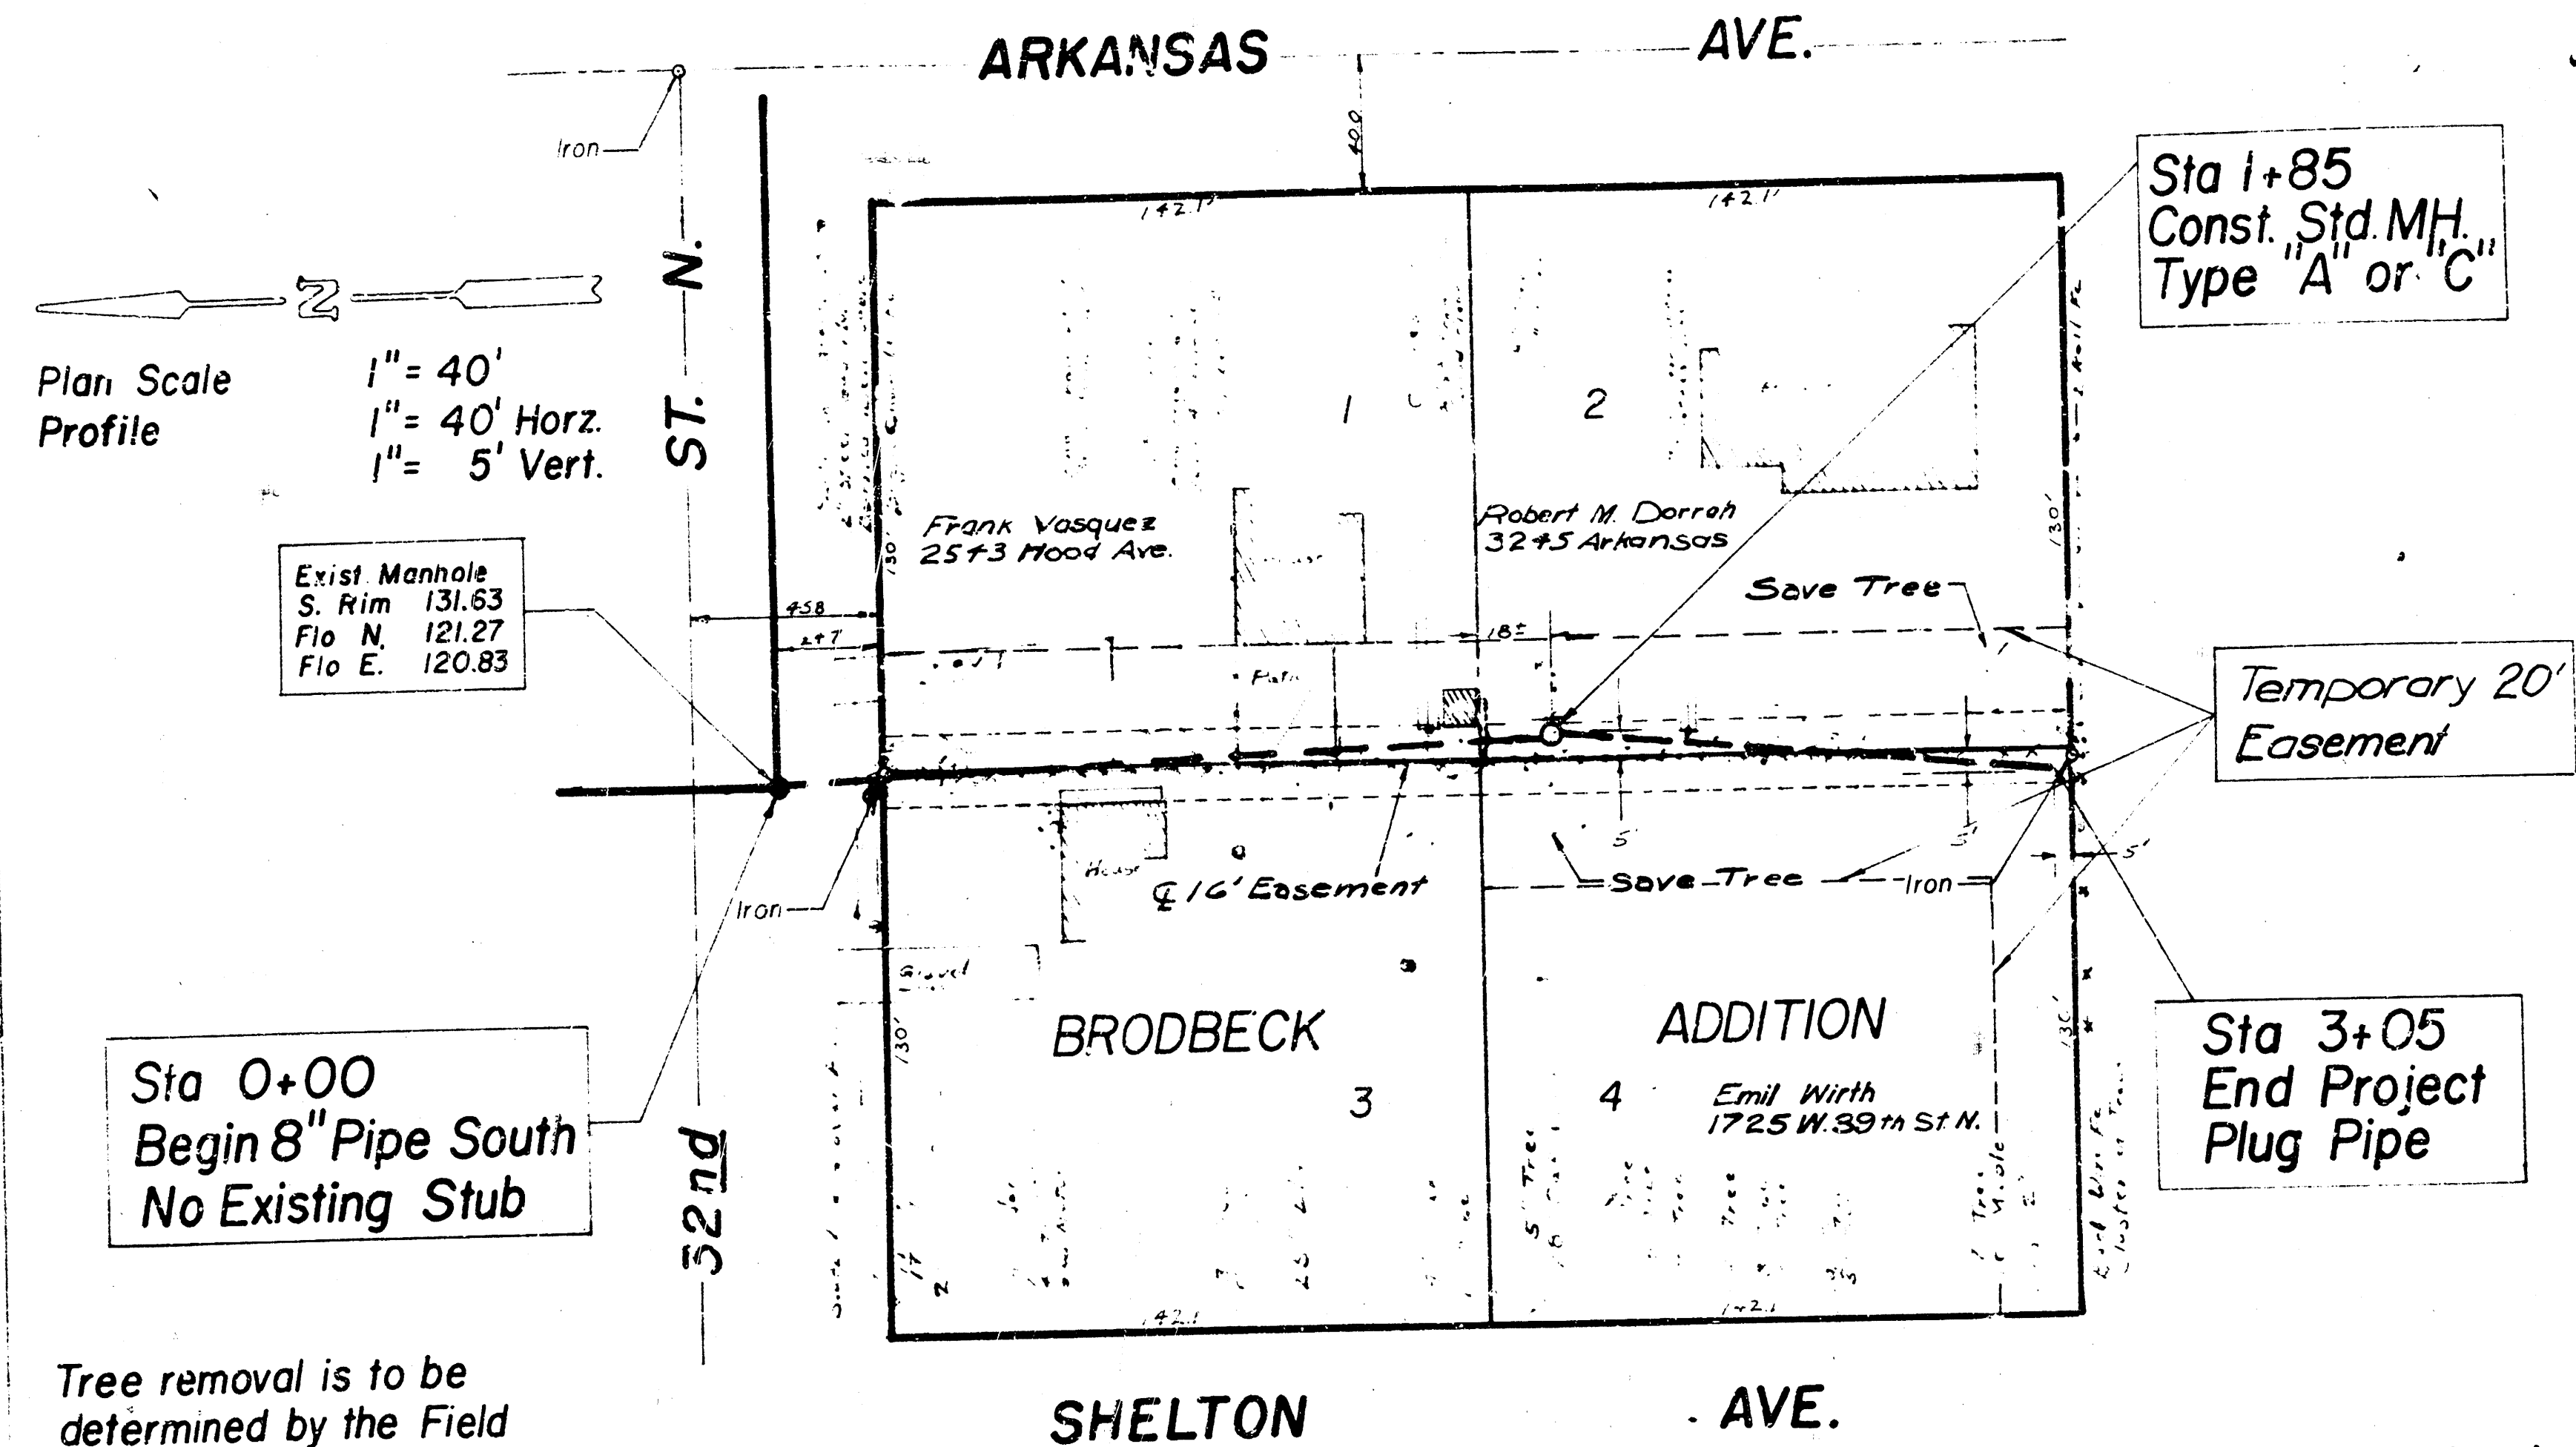

Tree removal is to be determined by the Field Engineer. All trees which can be saved will be saved.

Field Engineer to make 'ties' to all irons. Irons disturbed or destroyed are to be replaced.


BM 96.14 South East corner of porch at 3243 South Elizabeth
 BM 94.73 North West corner of porch at 1303 West 33rd Street South

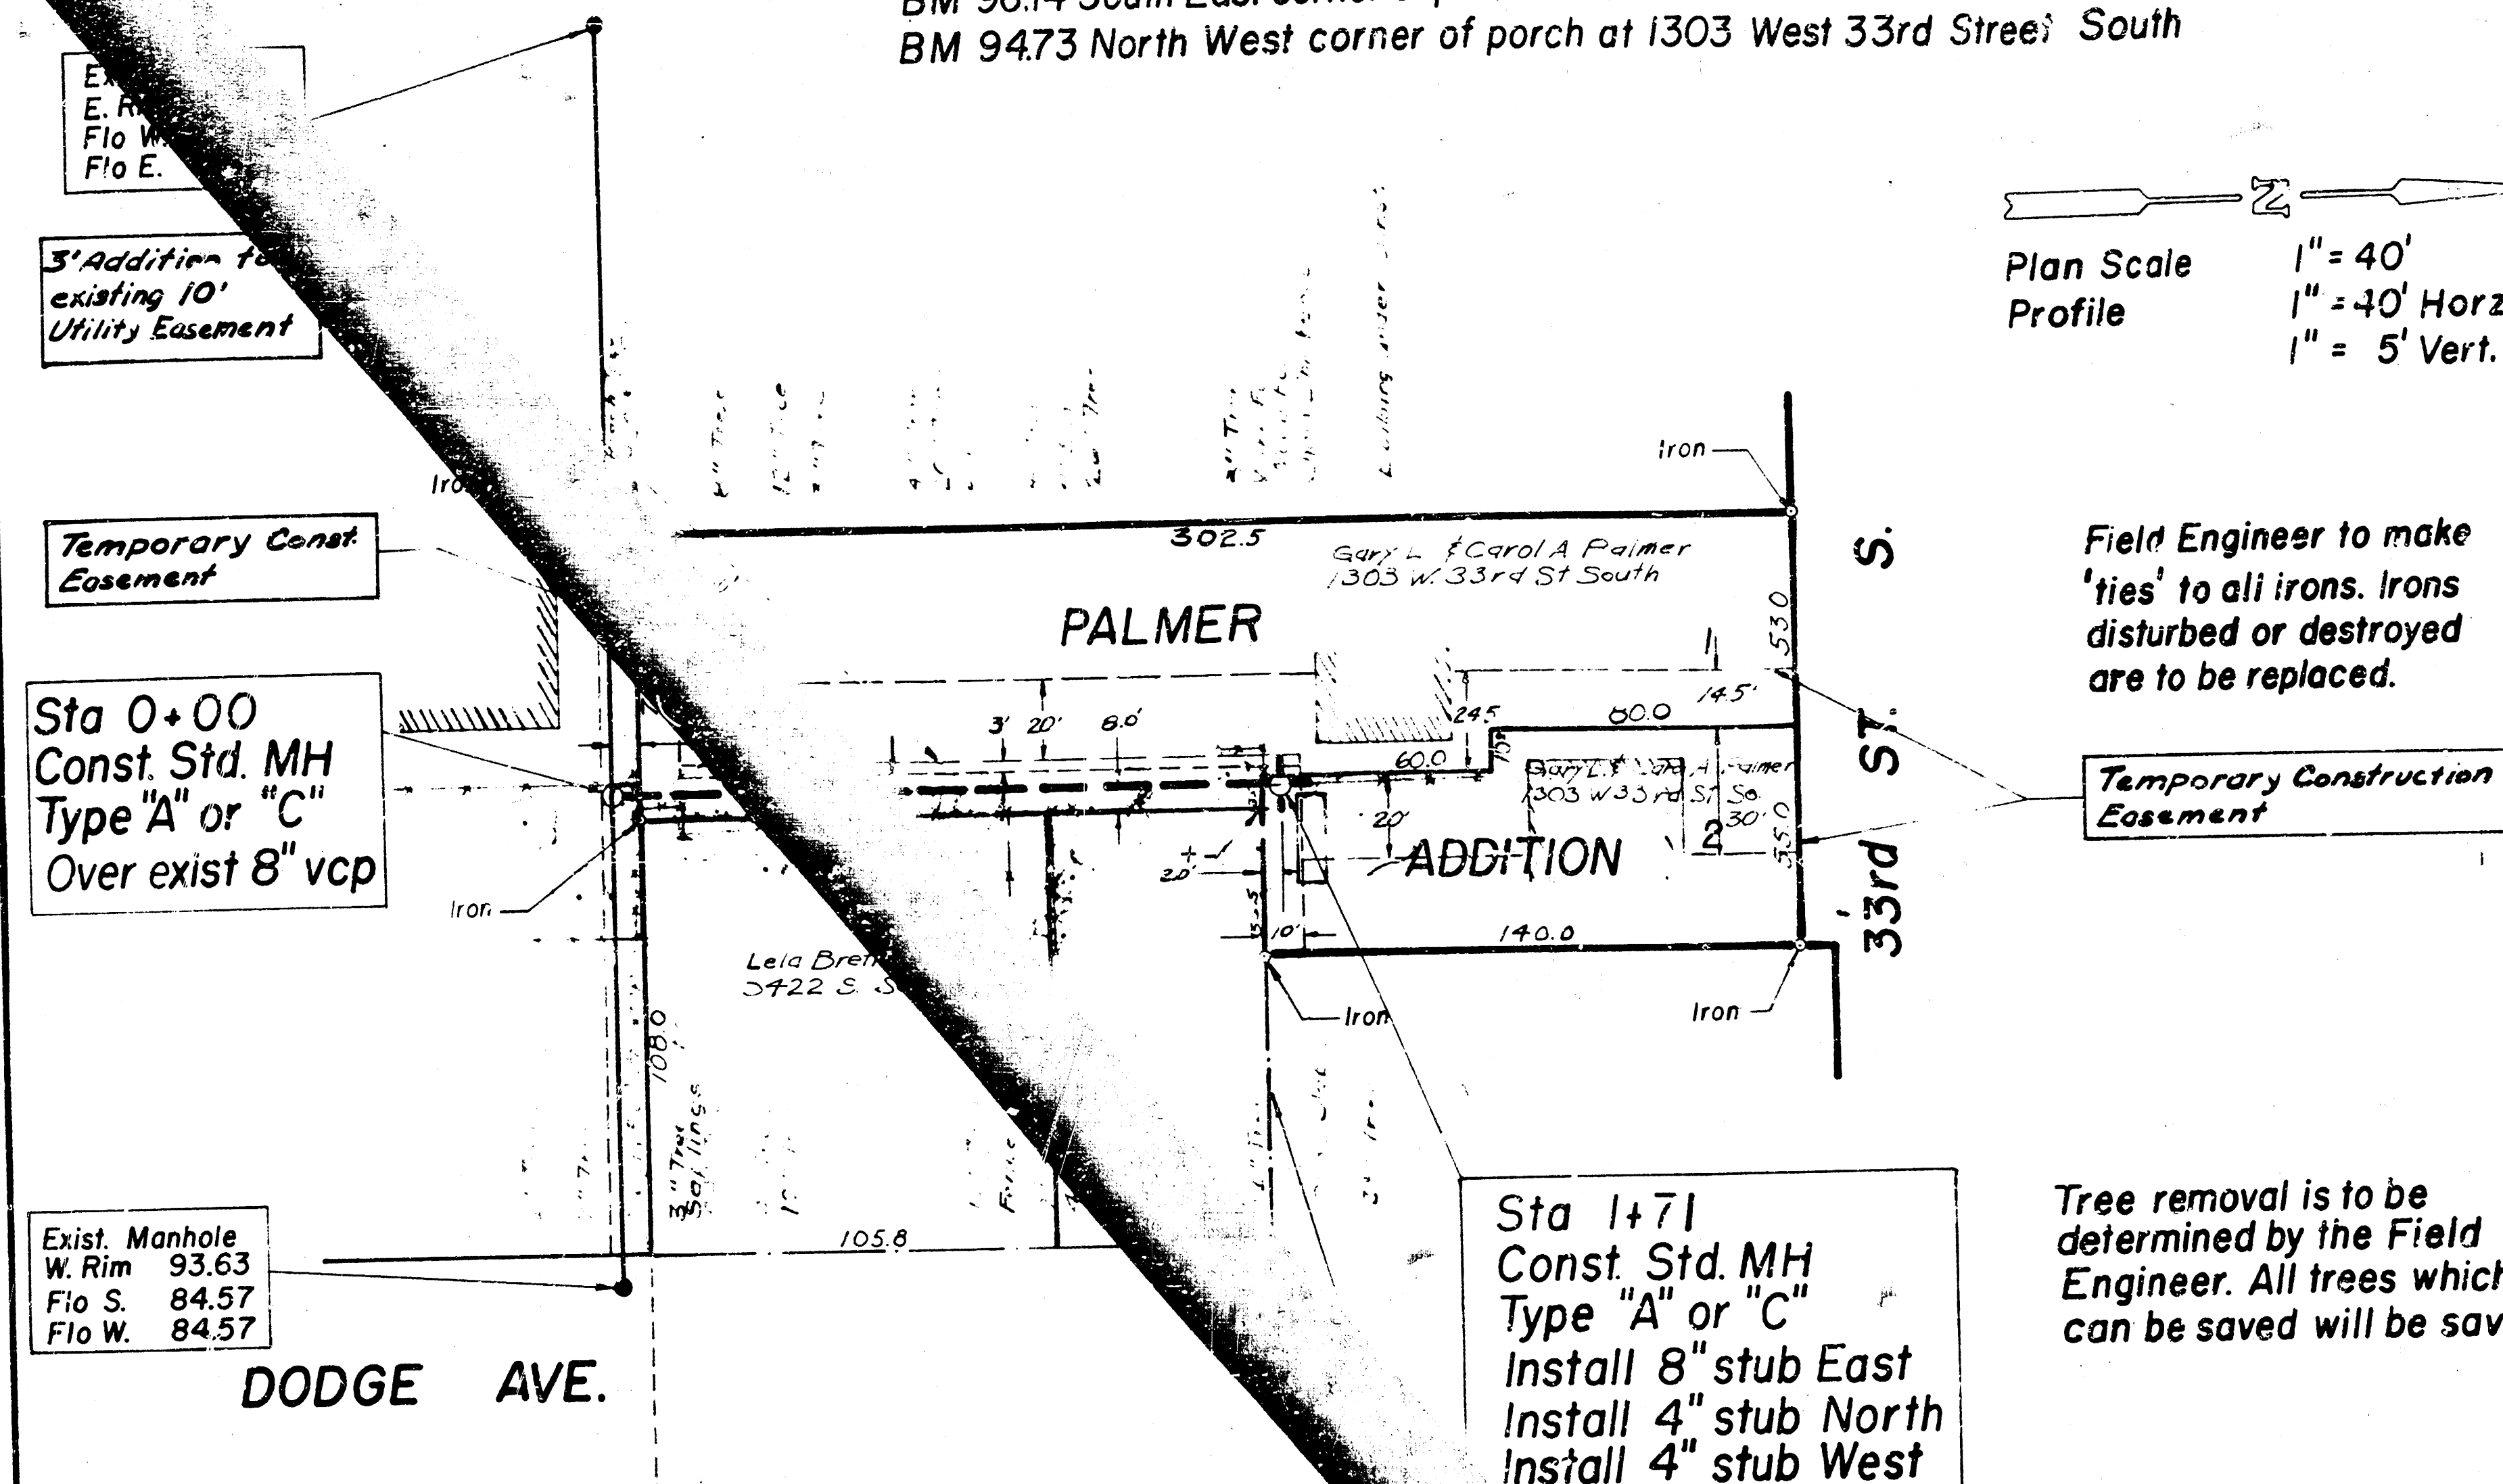


Field Engineer to make 'ties' to all irons. Irons disturbed or destroyed are to be replaced.

Temporary Construction Easement

Tree removal is to be determined by the Field Engineer. All trees which can be saved will be saved.

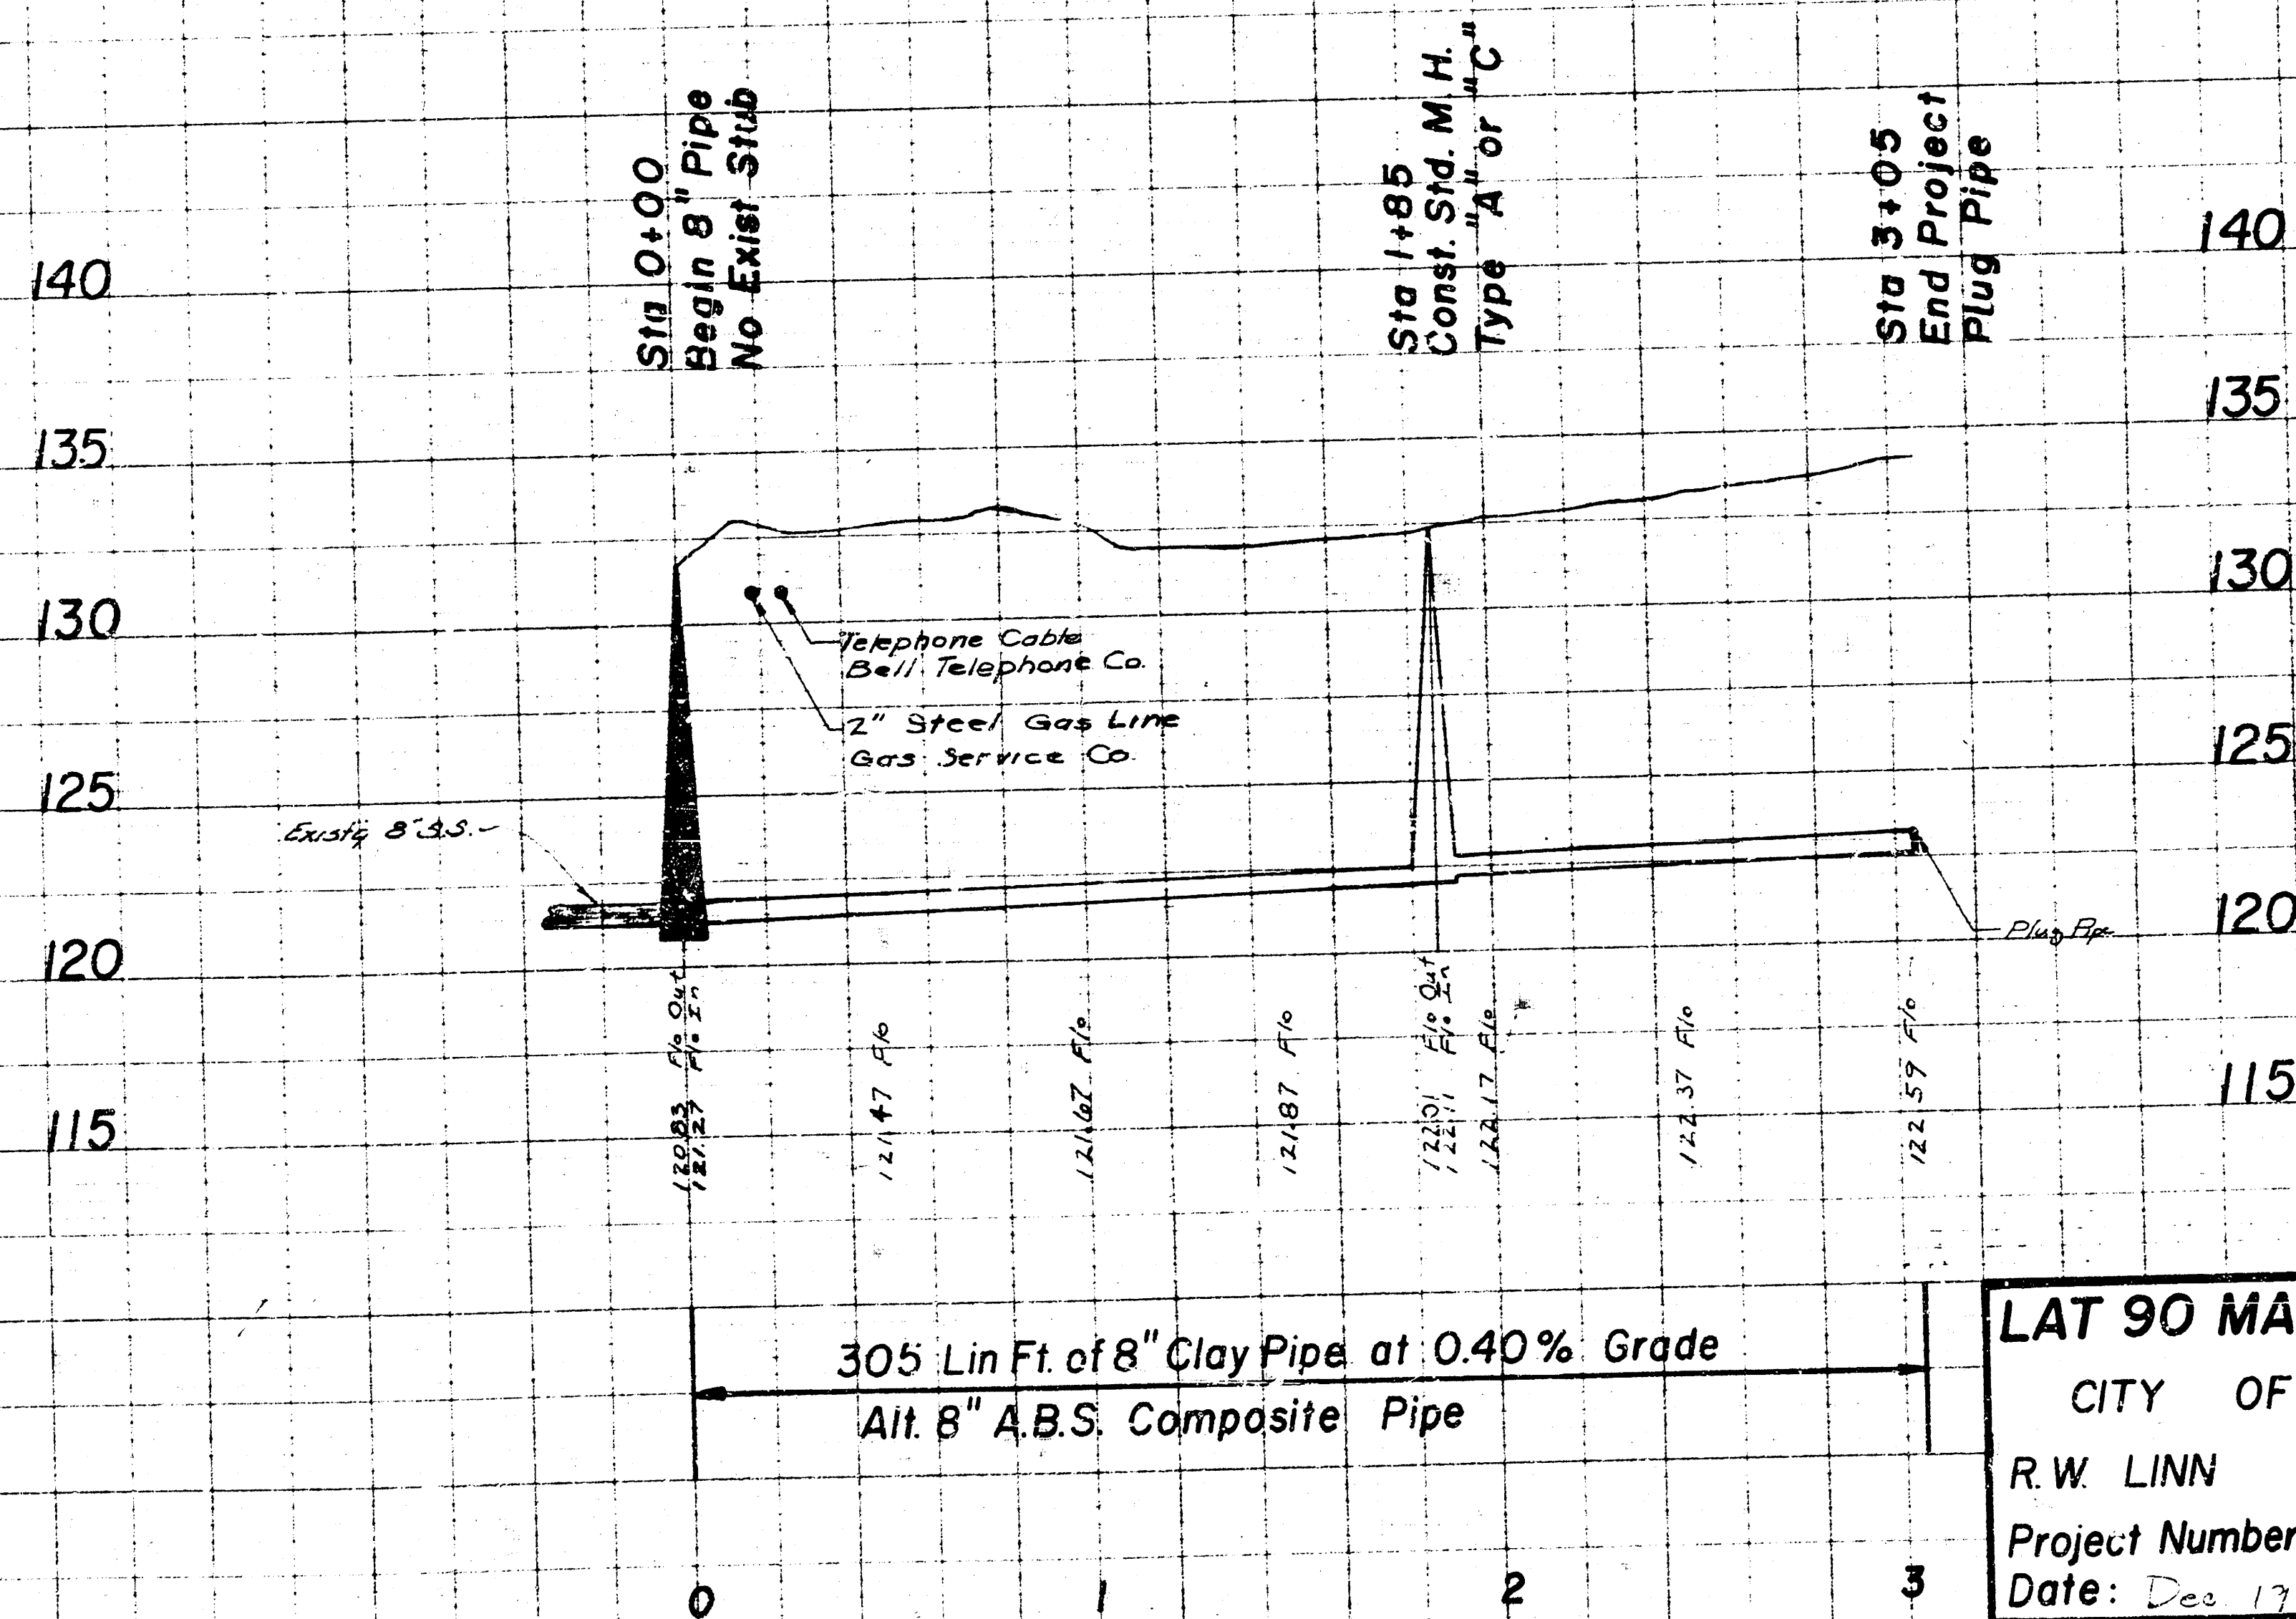

LAT 90 MAIN 4 SS 23
 CITY OF WICHITA
 R.W. LINN CITY ENGINEER
 Project Number DBKL576057
 Date: Dec 1976

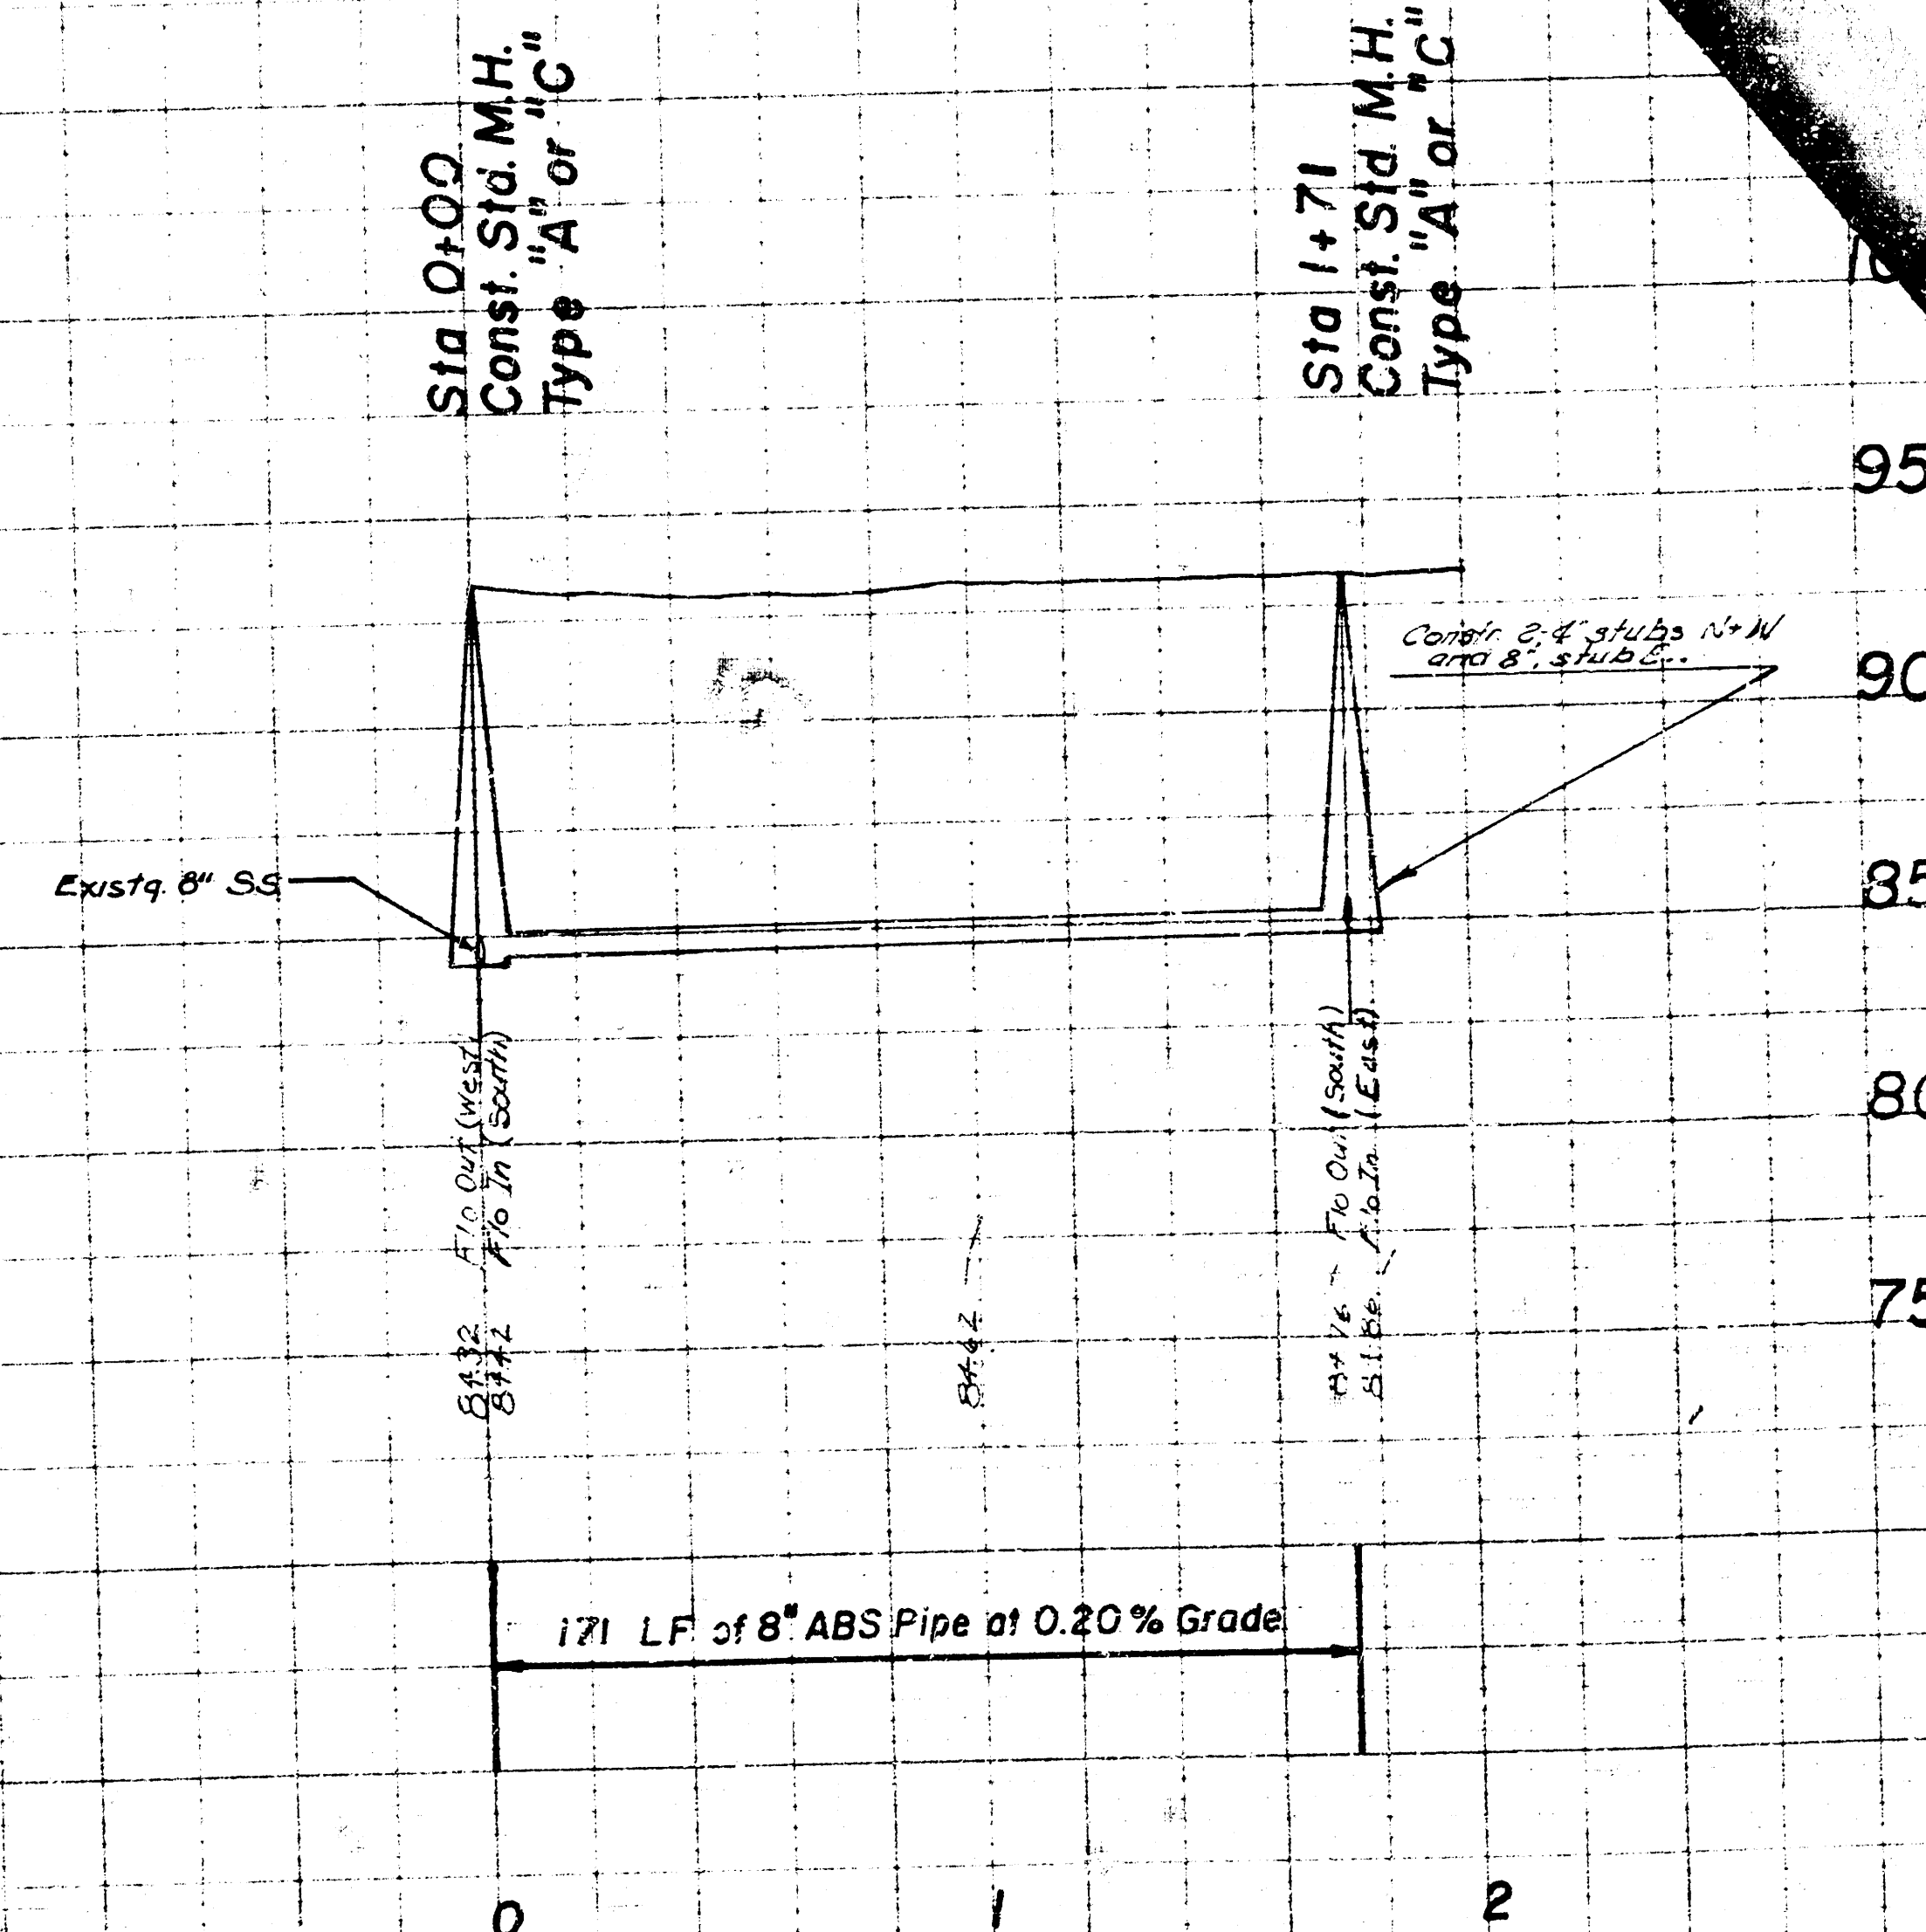

LAT 46, MAIN 2, SS. 22
 CITY OF WICHITA
 R.W. LINN CITY ENGINEER
 Project Number DBKL576052
 Date: Dec 1976