




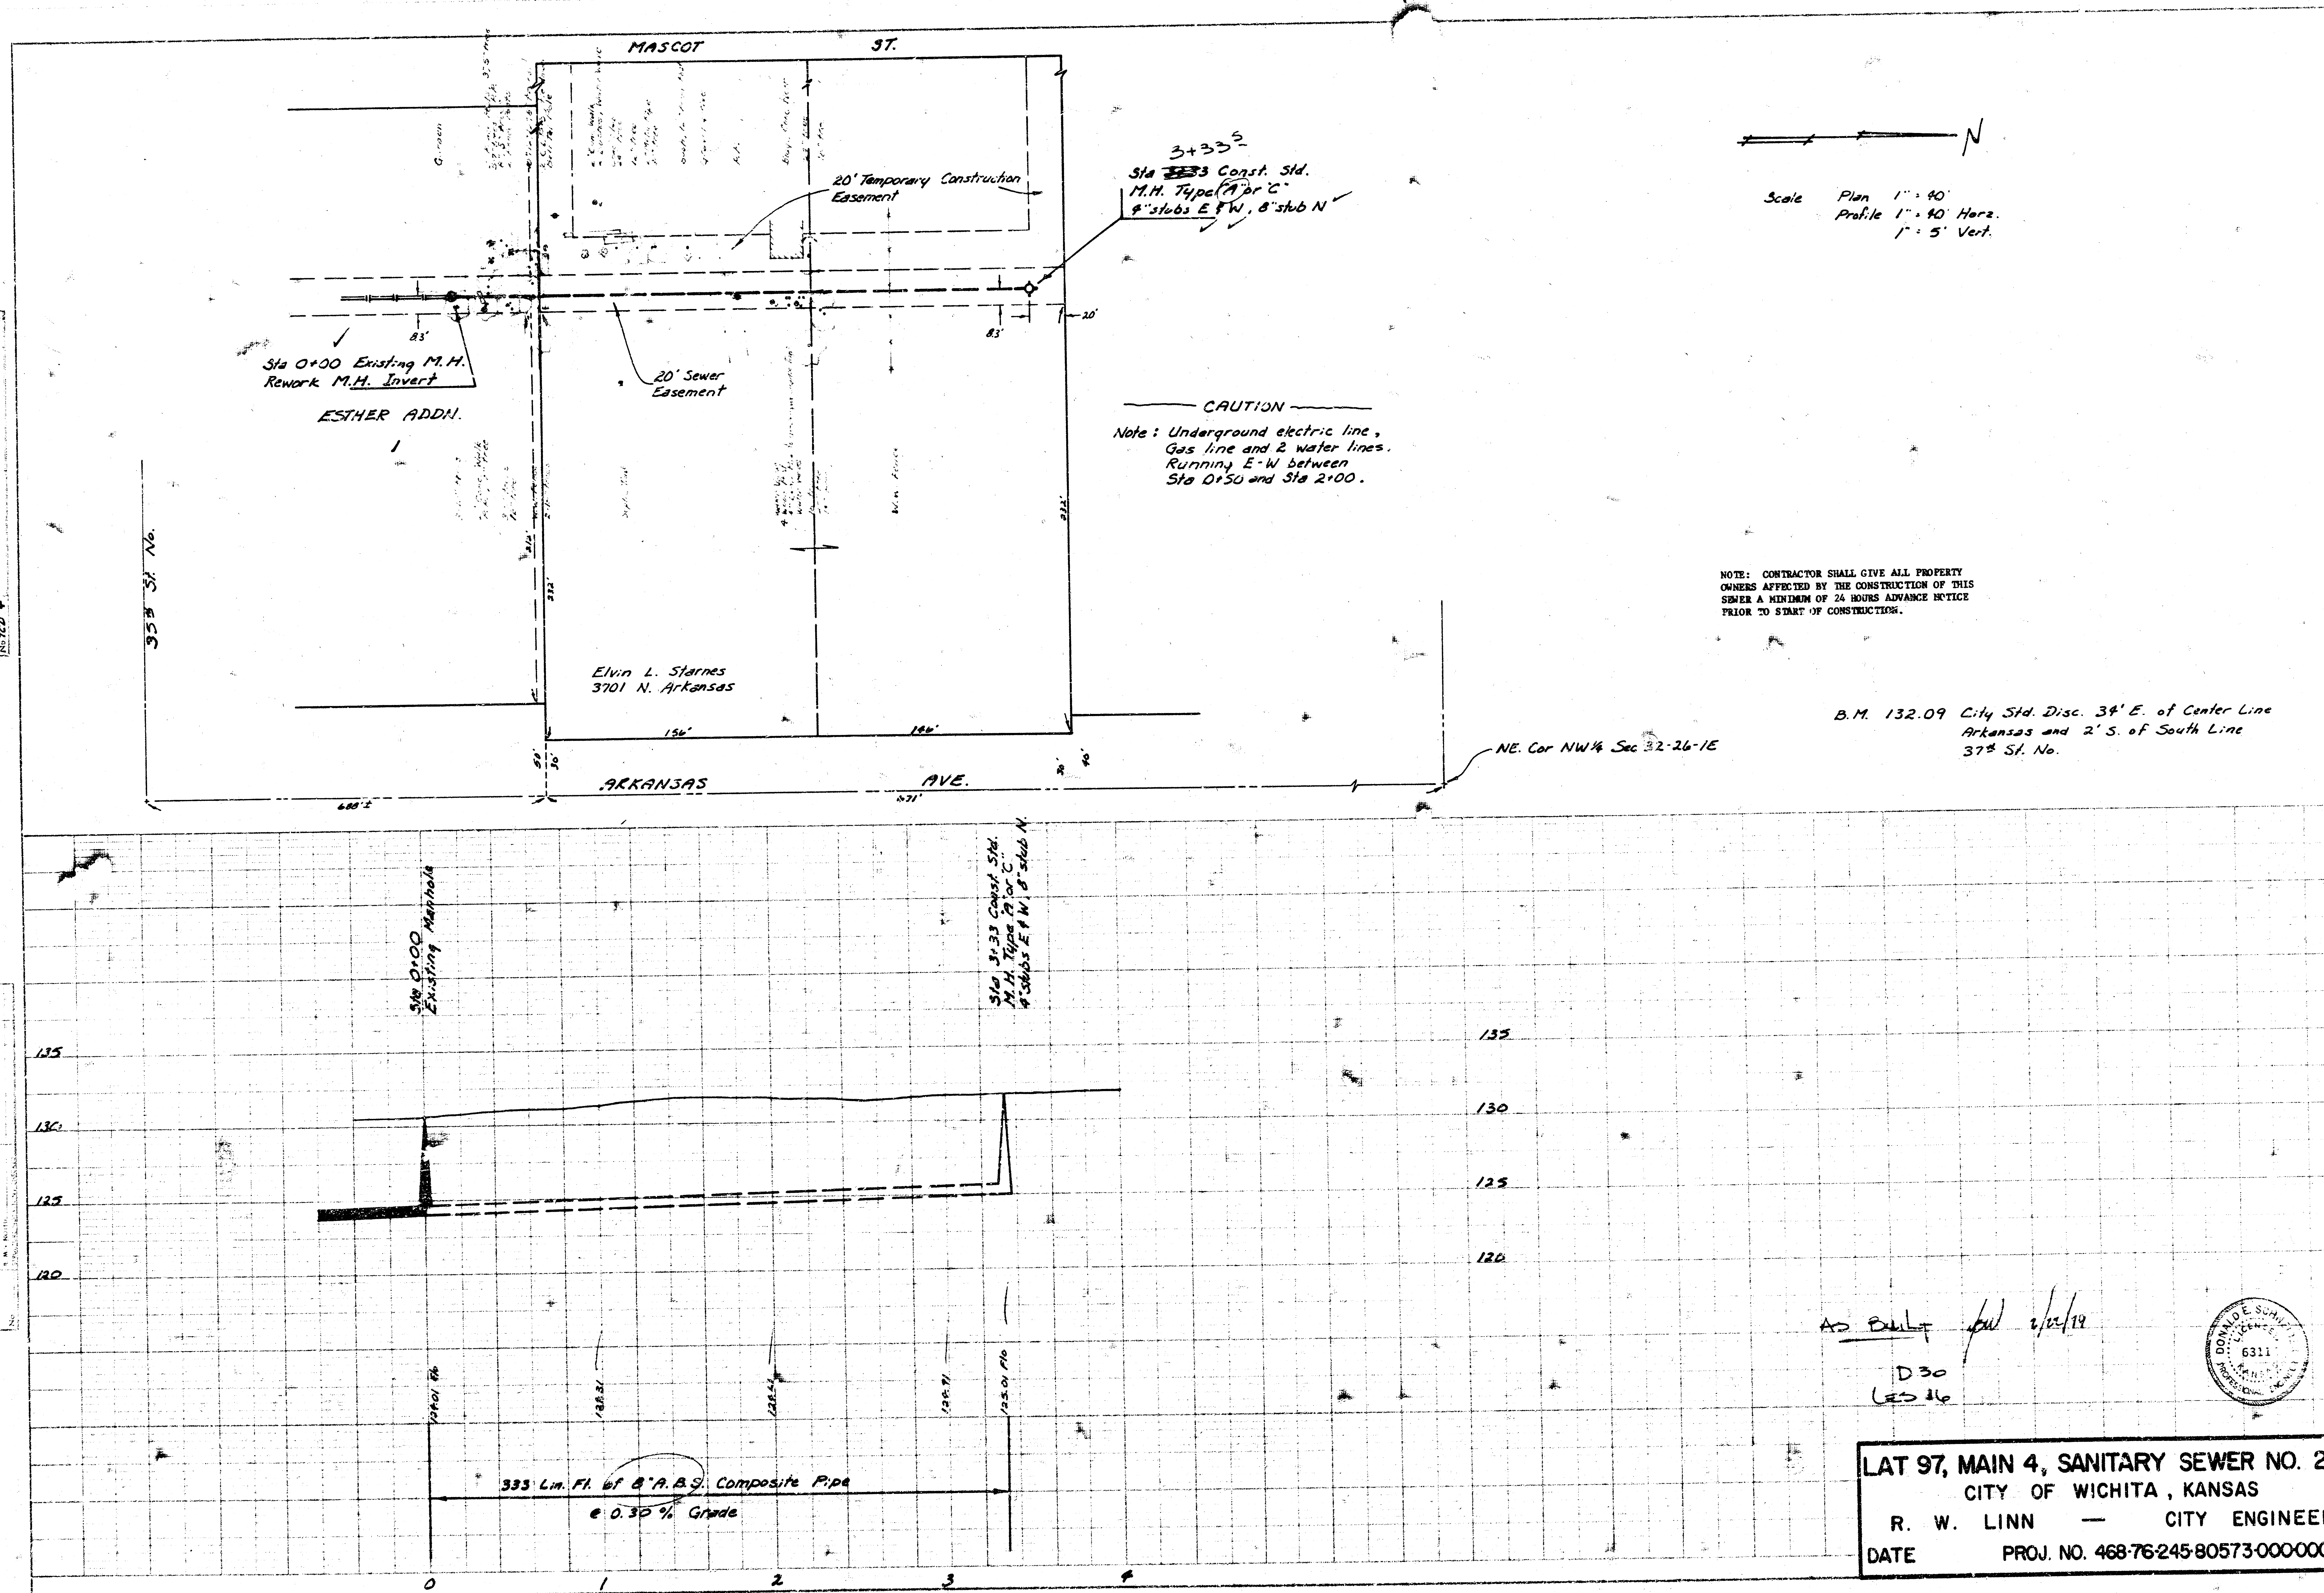

LAT 97, MAIN 4, SANITARY SEWER NO. 23
 CITY OF WICHITA, KANSAS
 R. W. LINN — CITY ENGINEER
 DATE PROJ. NO. 468-76-245-80573-000000001