


28/2 SLM007

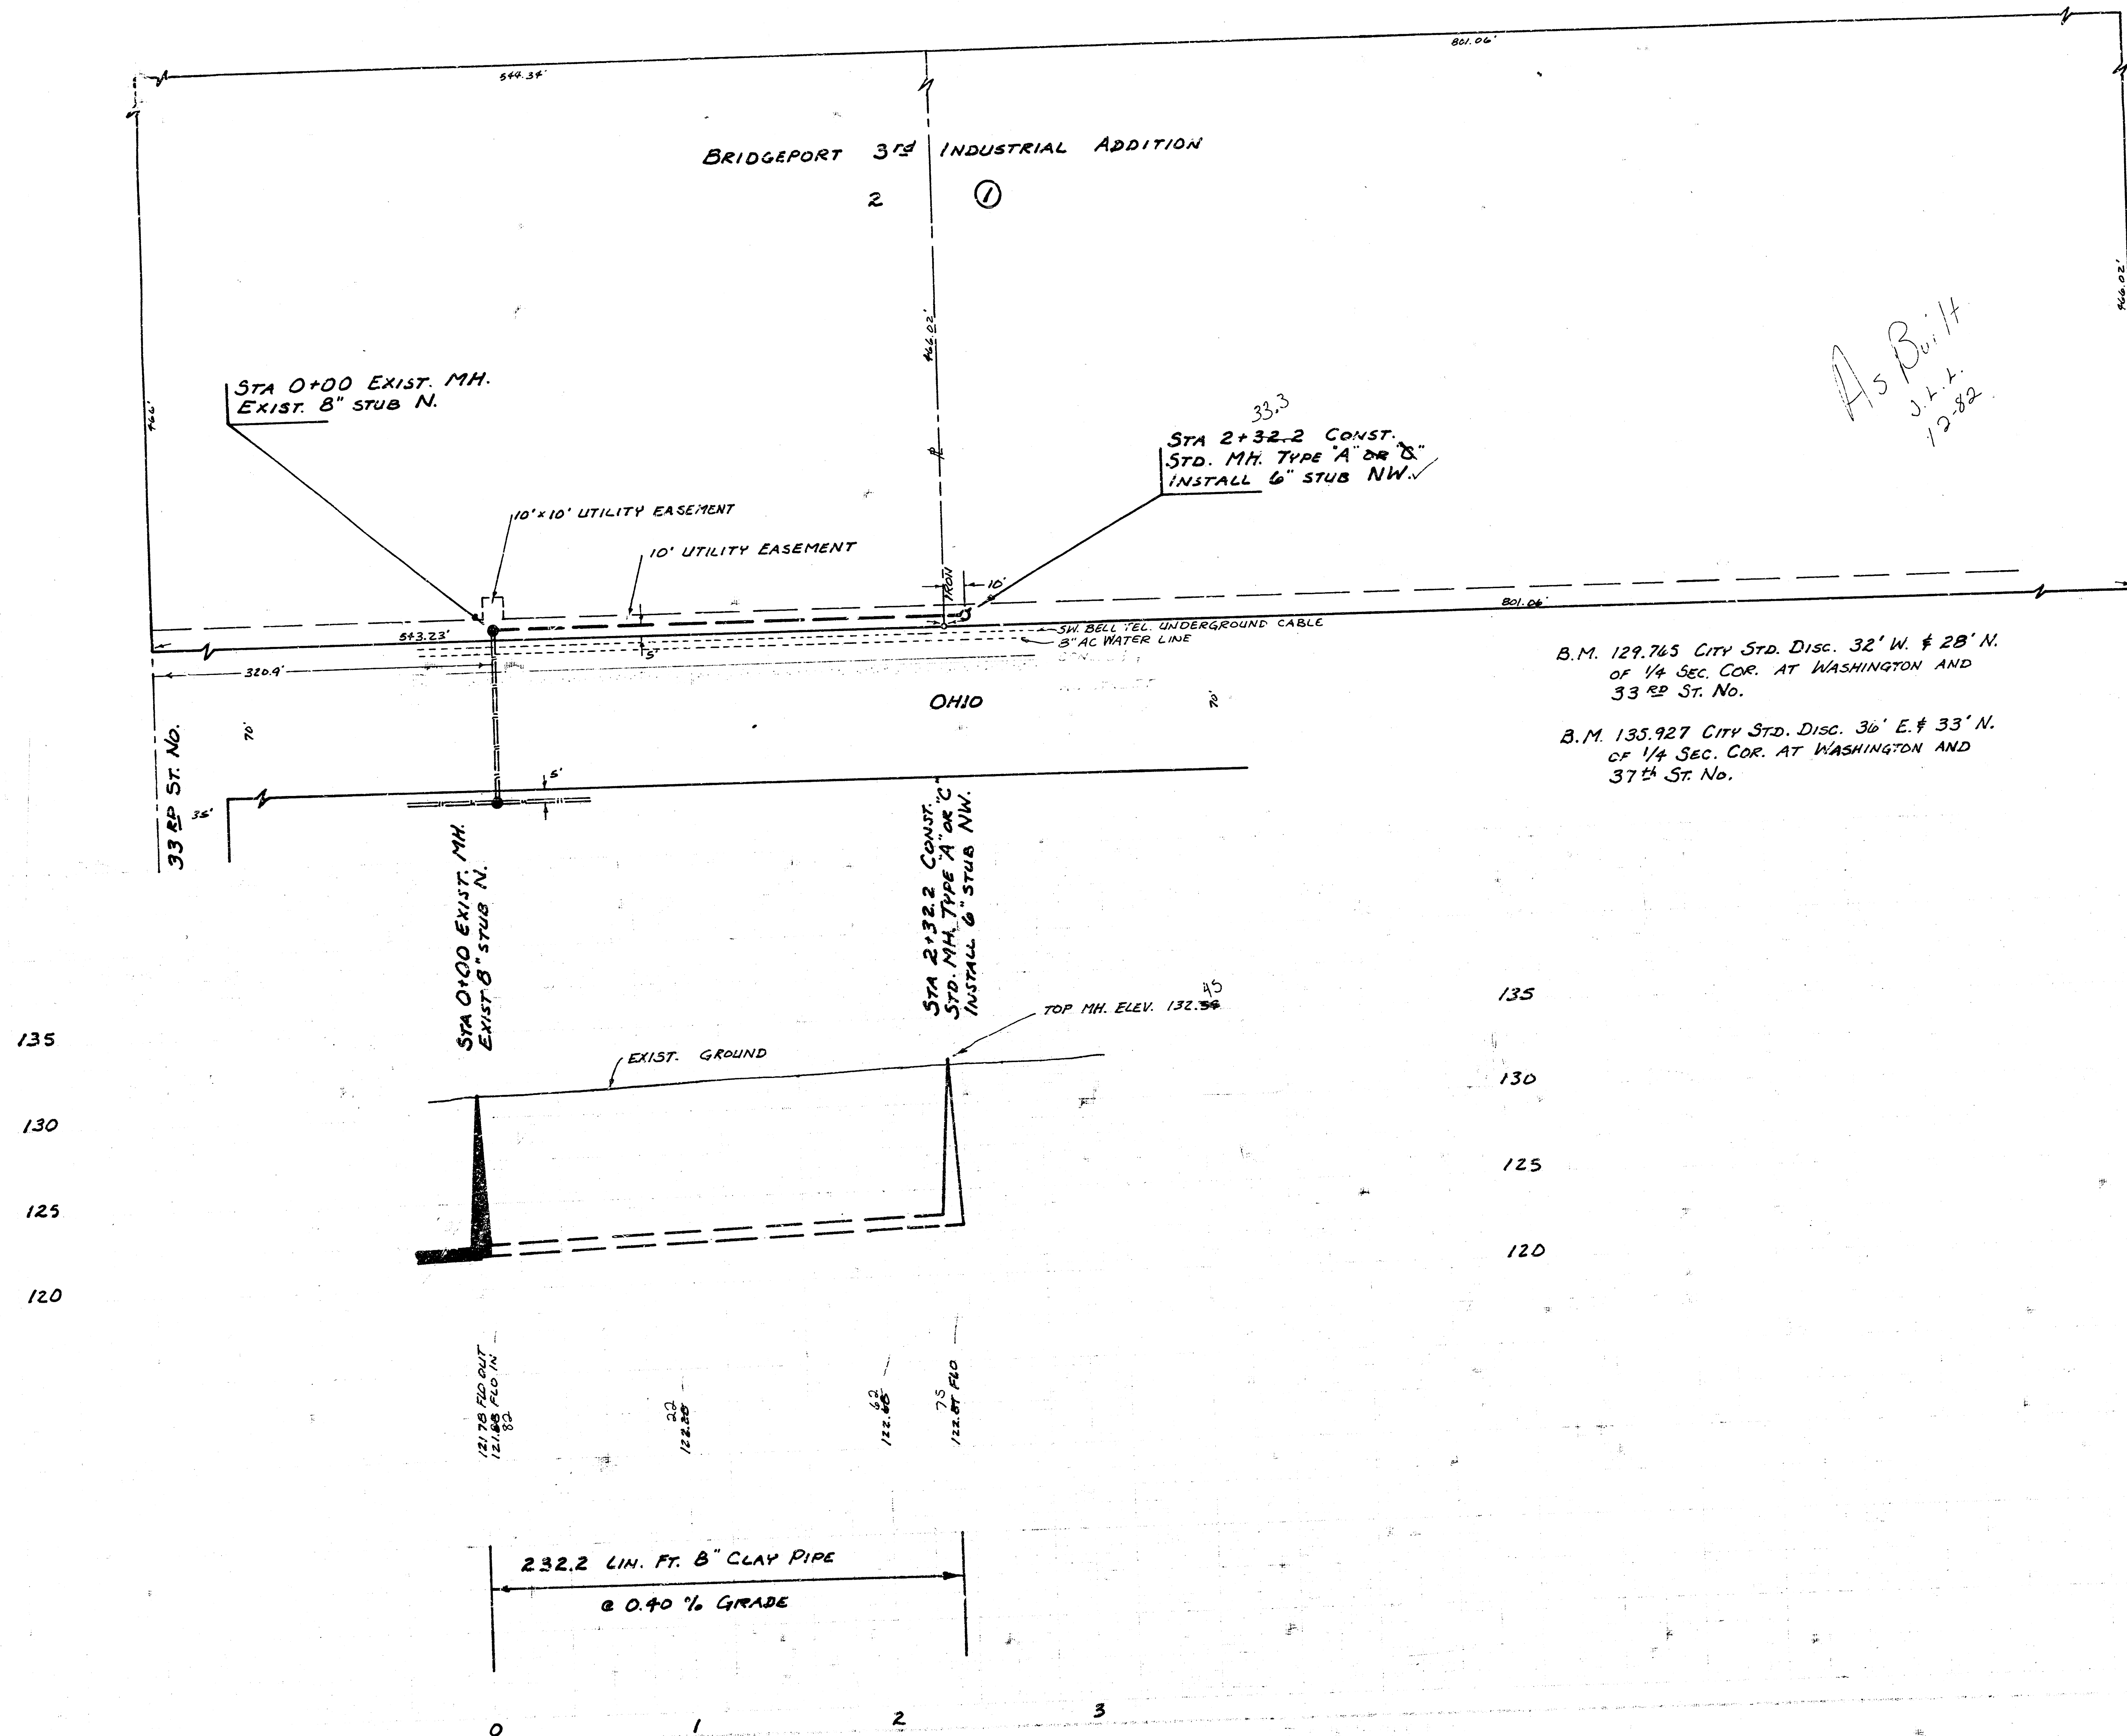


SCALE PLAN 1" = 40'
PROFILE 1" = 40' HORIZ.
1" = 5' VERT.

B.M. 129.765 CITY STD. DISC. 32' W. & 28' N.
OF 1/4 SEC. COR. AT WASHINGTON AND
33RD ST. NO.

B.M. 135.927 CITY STD. DISC. 36' E. & 33' N.
OF 1/4 SEC. COR. AT WASHINGTON AND
37TH ST. NO.

THE CONTRACTOR SHALL BE RESPONSIBLE
FOR PRESERVING PROPERTY IRONS. THE
CONTRACTOR SHALL BE REQUIRED TO RE-
ESTABLISH ANY PROPERTY IRONS WHICH
ARE DAMAGED OR DESTROYED BY HIS CON-
STRUCTION OPERATIONS. SUCH IRONS SHALL
BE RE-ESTABLISHED BY A LICENSED LAND
SURVEYOR OR A LICENSED PROFESSIONAL
ENGINEER IN ACCORDANCE WITH STATE LAWS.

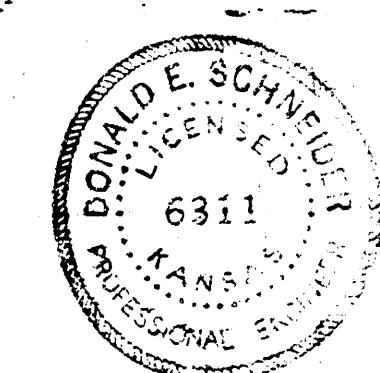

EXTENSION OF LAT. 102, MAIN 4, SANITARY SEWER #23
CITY OF WICHITA, KANSAS

R. W. DRUGGEMAN : DIRECTOR OF ENGINEERING / CITY ENGINEER
PROJ. NO. 468-76-245-81185-000-800-901

10 8 1 14 1/2

FIL MED FROM THE BEST