



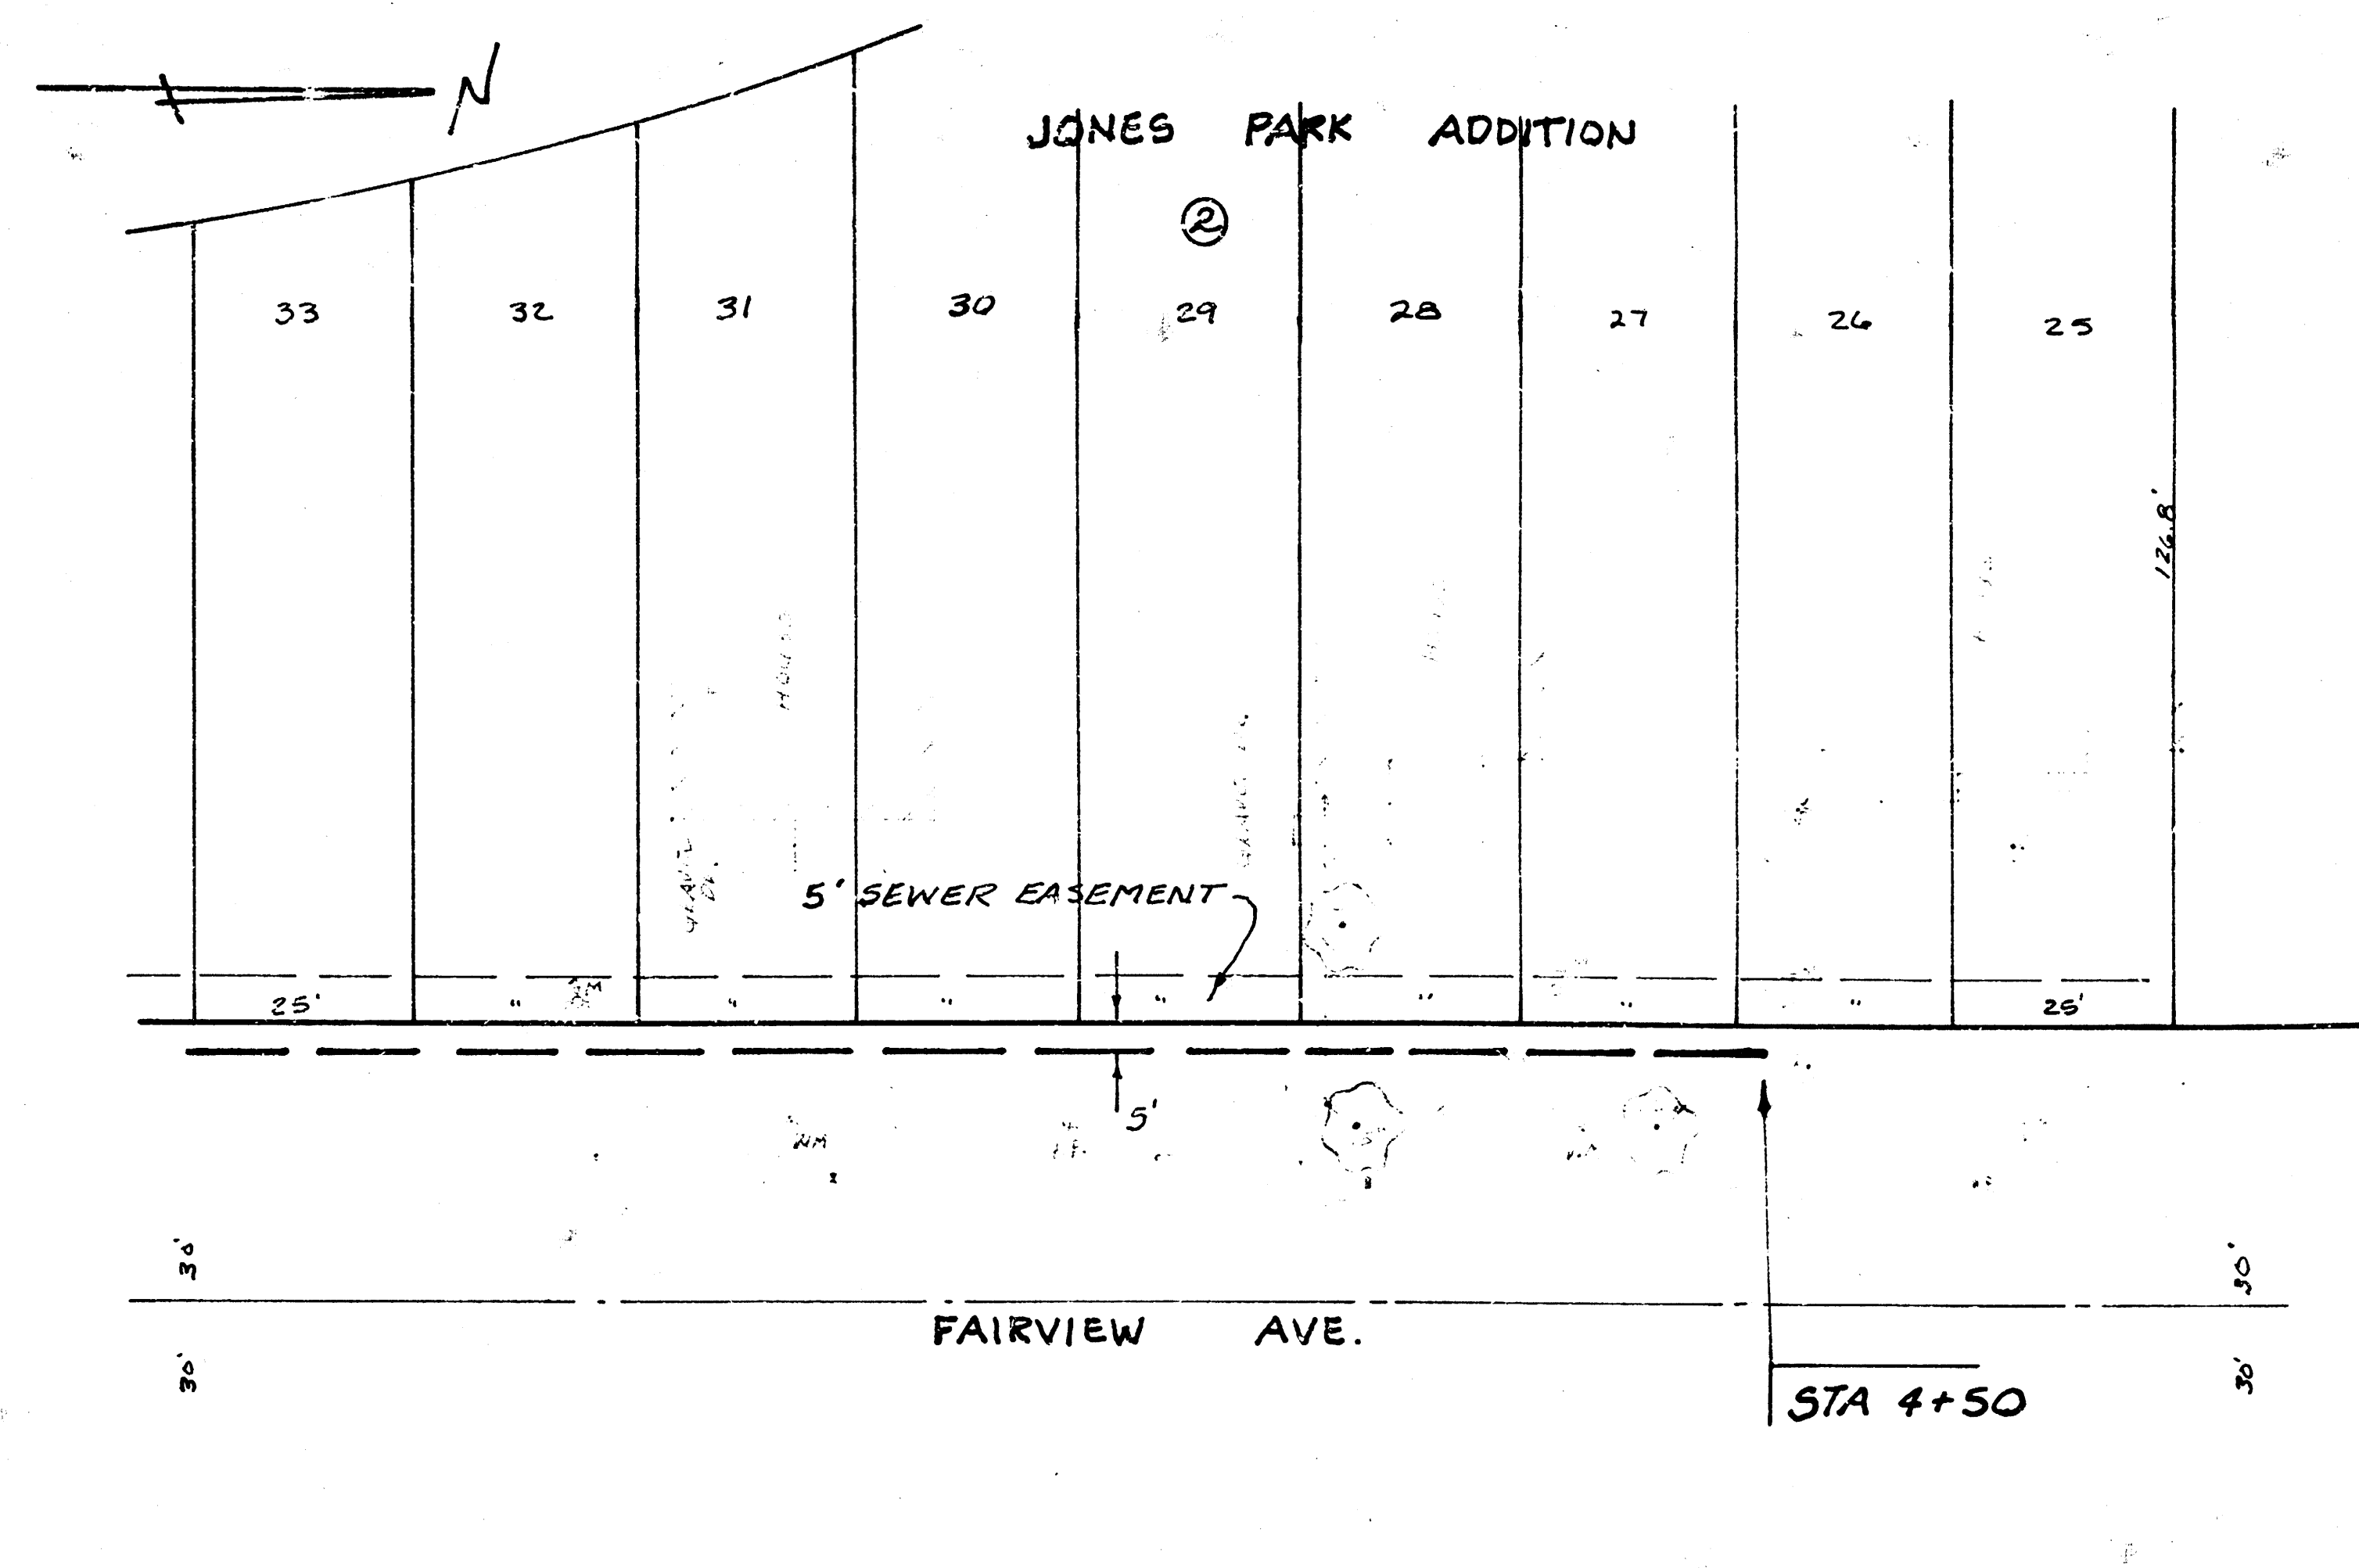


BM. 130.25 R.R. SPIKE N. FACE P.P. S. SIDE OF 34th ST. NO.
135 FT. E. OF E.L. FAIRVIEW.

BM. 129.24 R.R. SPIKE W. FACE P.P. WEST SIDE OF FAIRVIEW
2nd P.P. N. OF N.L. 34th ST. NO.

BM. 129.56 R.R. SPIKE S. FACE P.P. NORTH SIDE 35th ST. NO.
2nd P.P. W. OF FAIRVIEW.

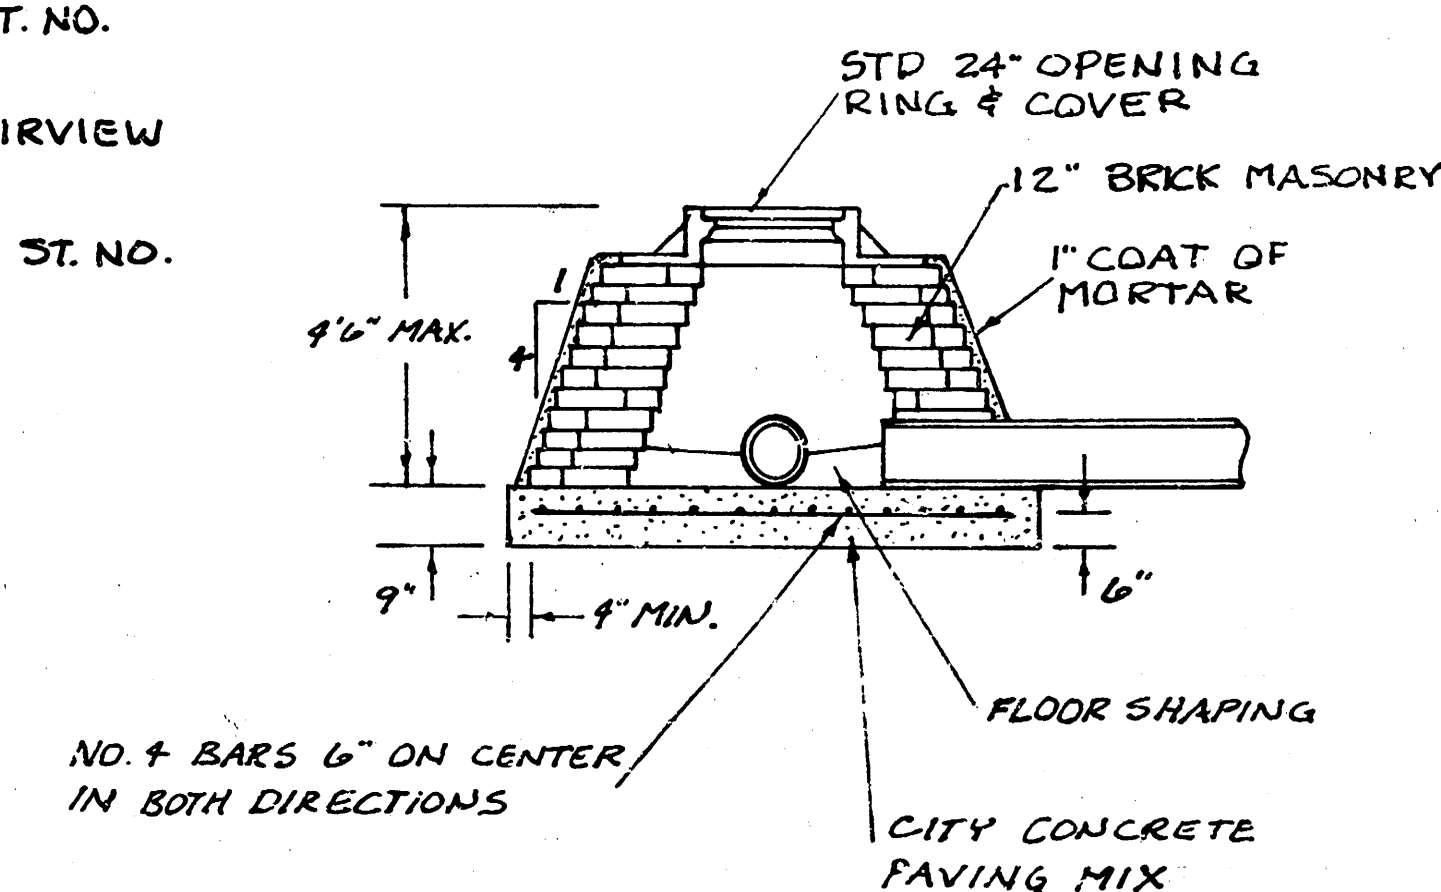




SPECIAL TYPE "B" MANHOLE DETAIL

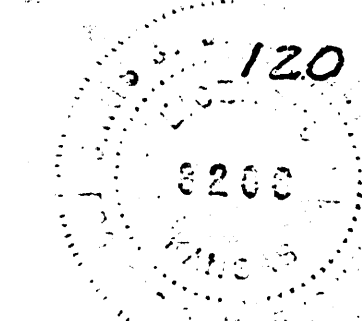

PROJECT DESCRIPTION	
LAT. 110 , MAIN 4 , S. S. NO. 23	
PROJECT NUMBER	
468-76-245-81258-003-000-001	
BOOK NO. JLA - 35	APPROVED BY
DRAWN BY LOOMIS	DATE
	REVISED
CITY OF WICHITA	
DEPARTMENT OF ENGINEERING	
M. E. LINDEBAK - CITY ENGINEER	SCALE

FILMED FROM THE BEST
AVAILABLE COPY

SCALE PLAN 1" = 20' HORIZ.
 PROFILE 1" = 20' VERT.

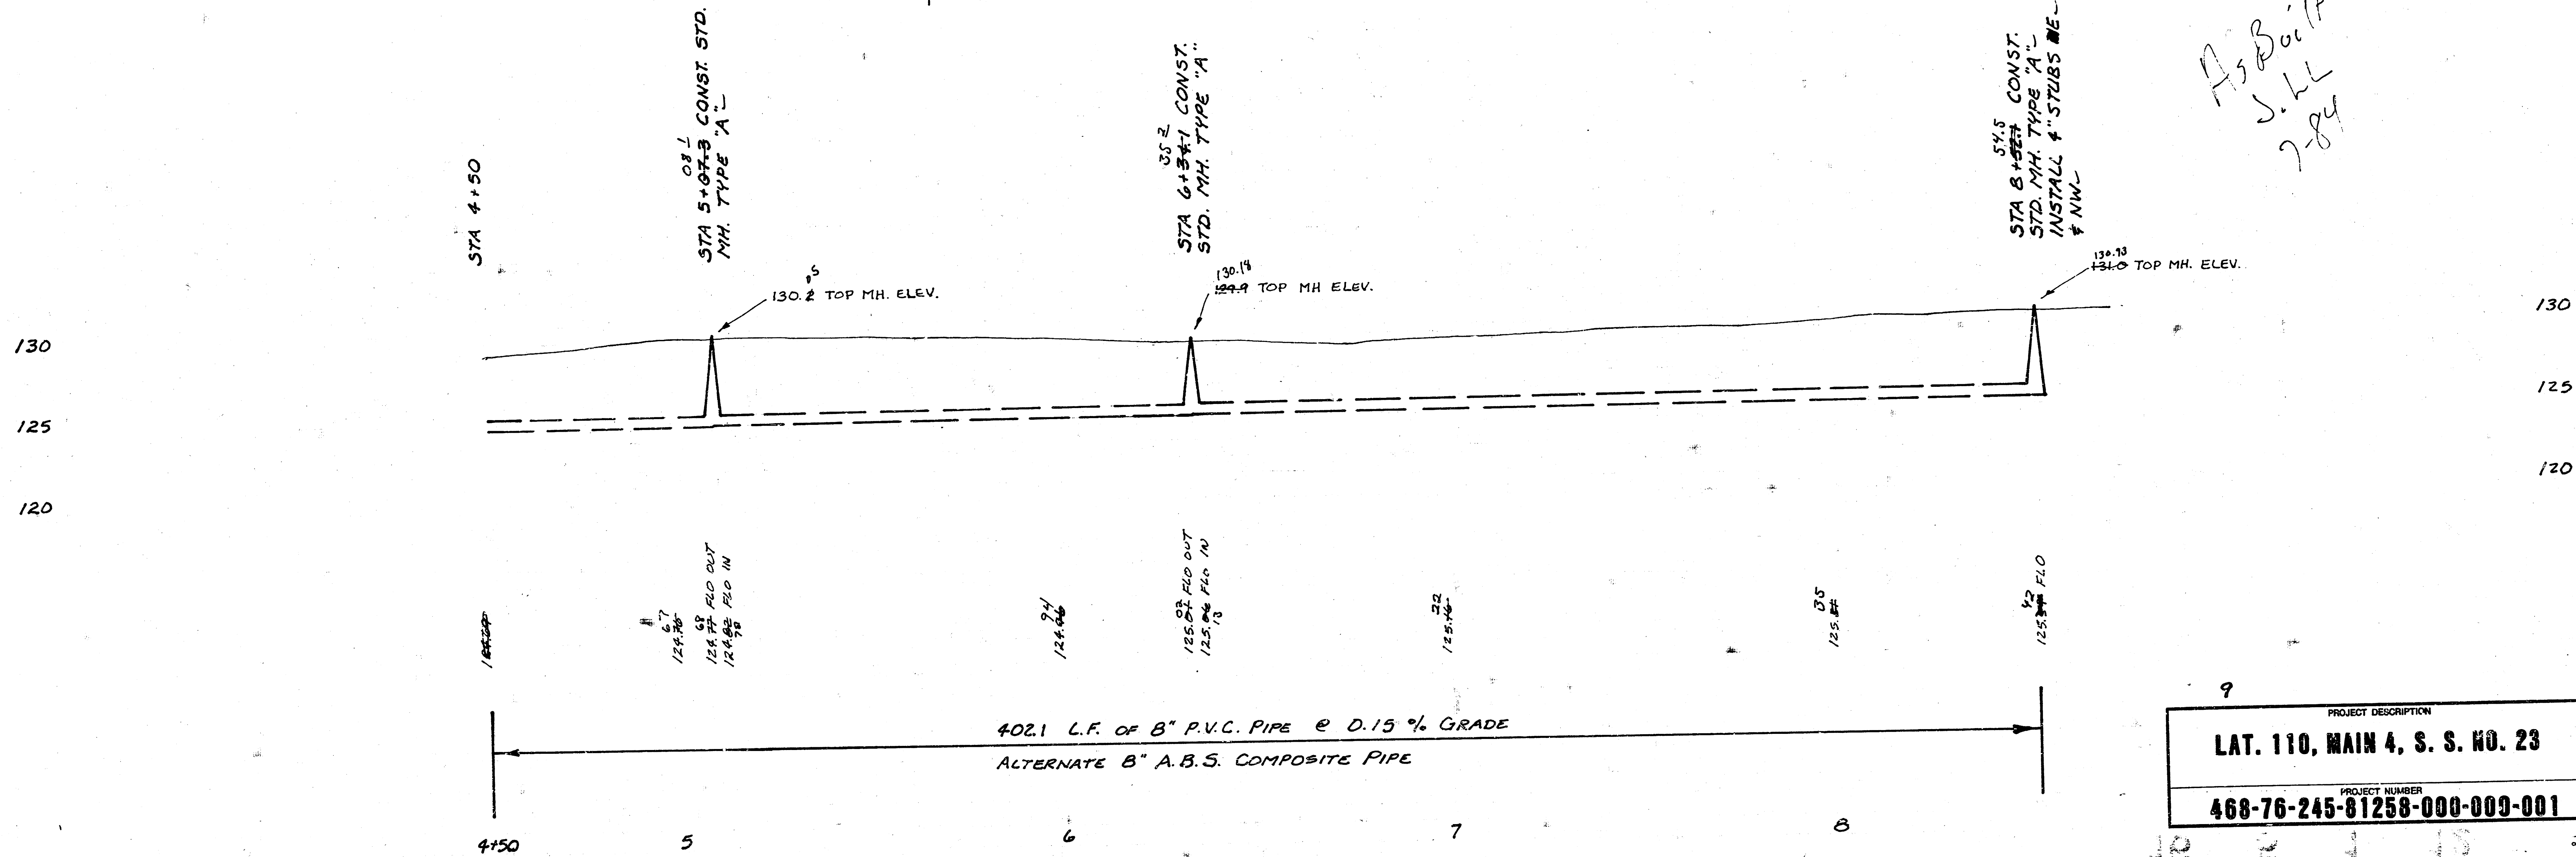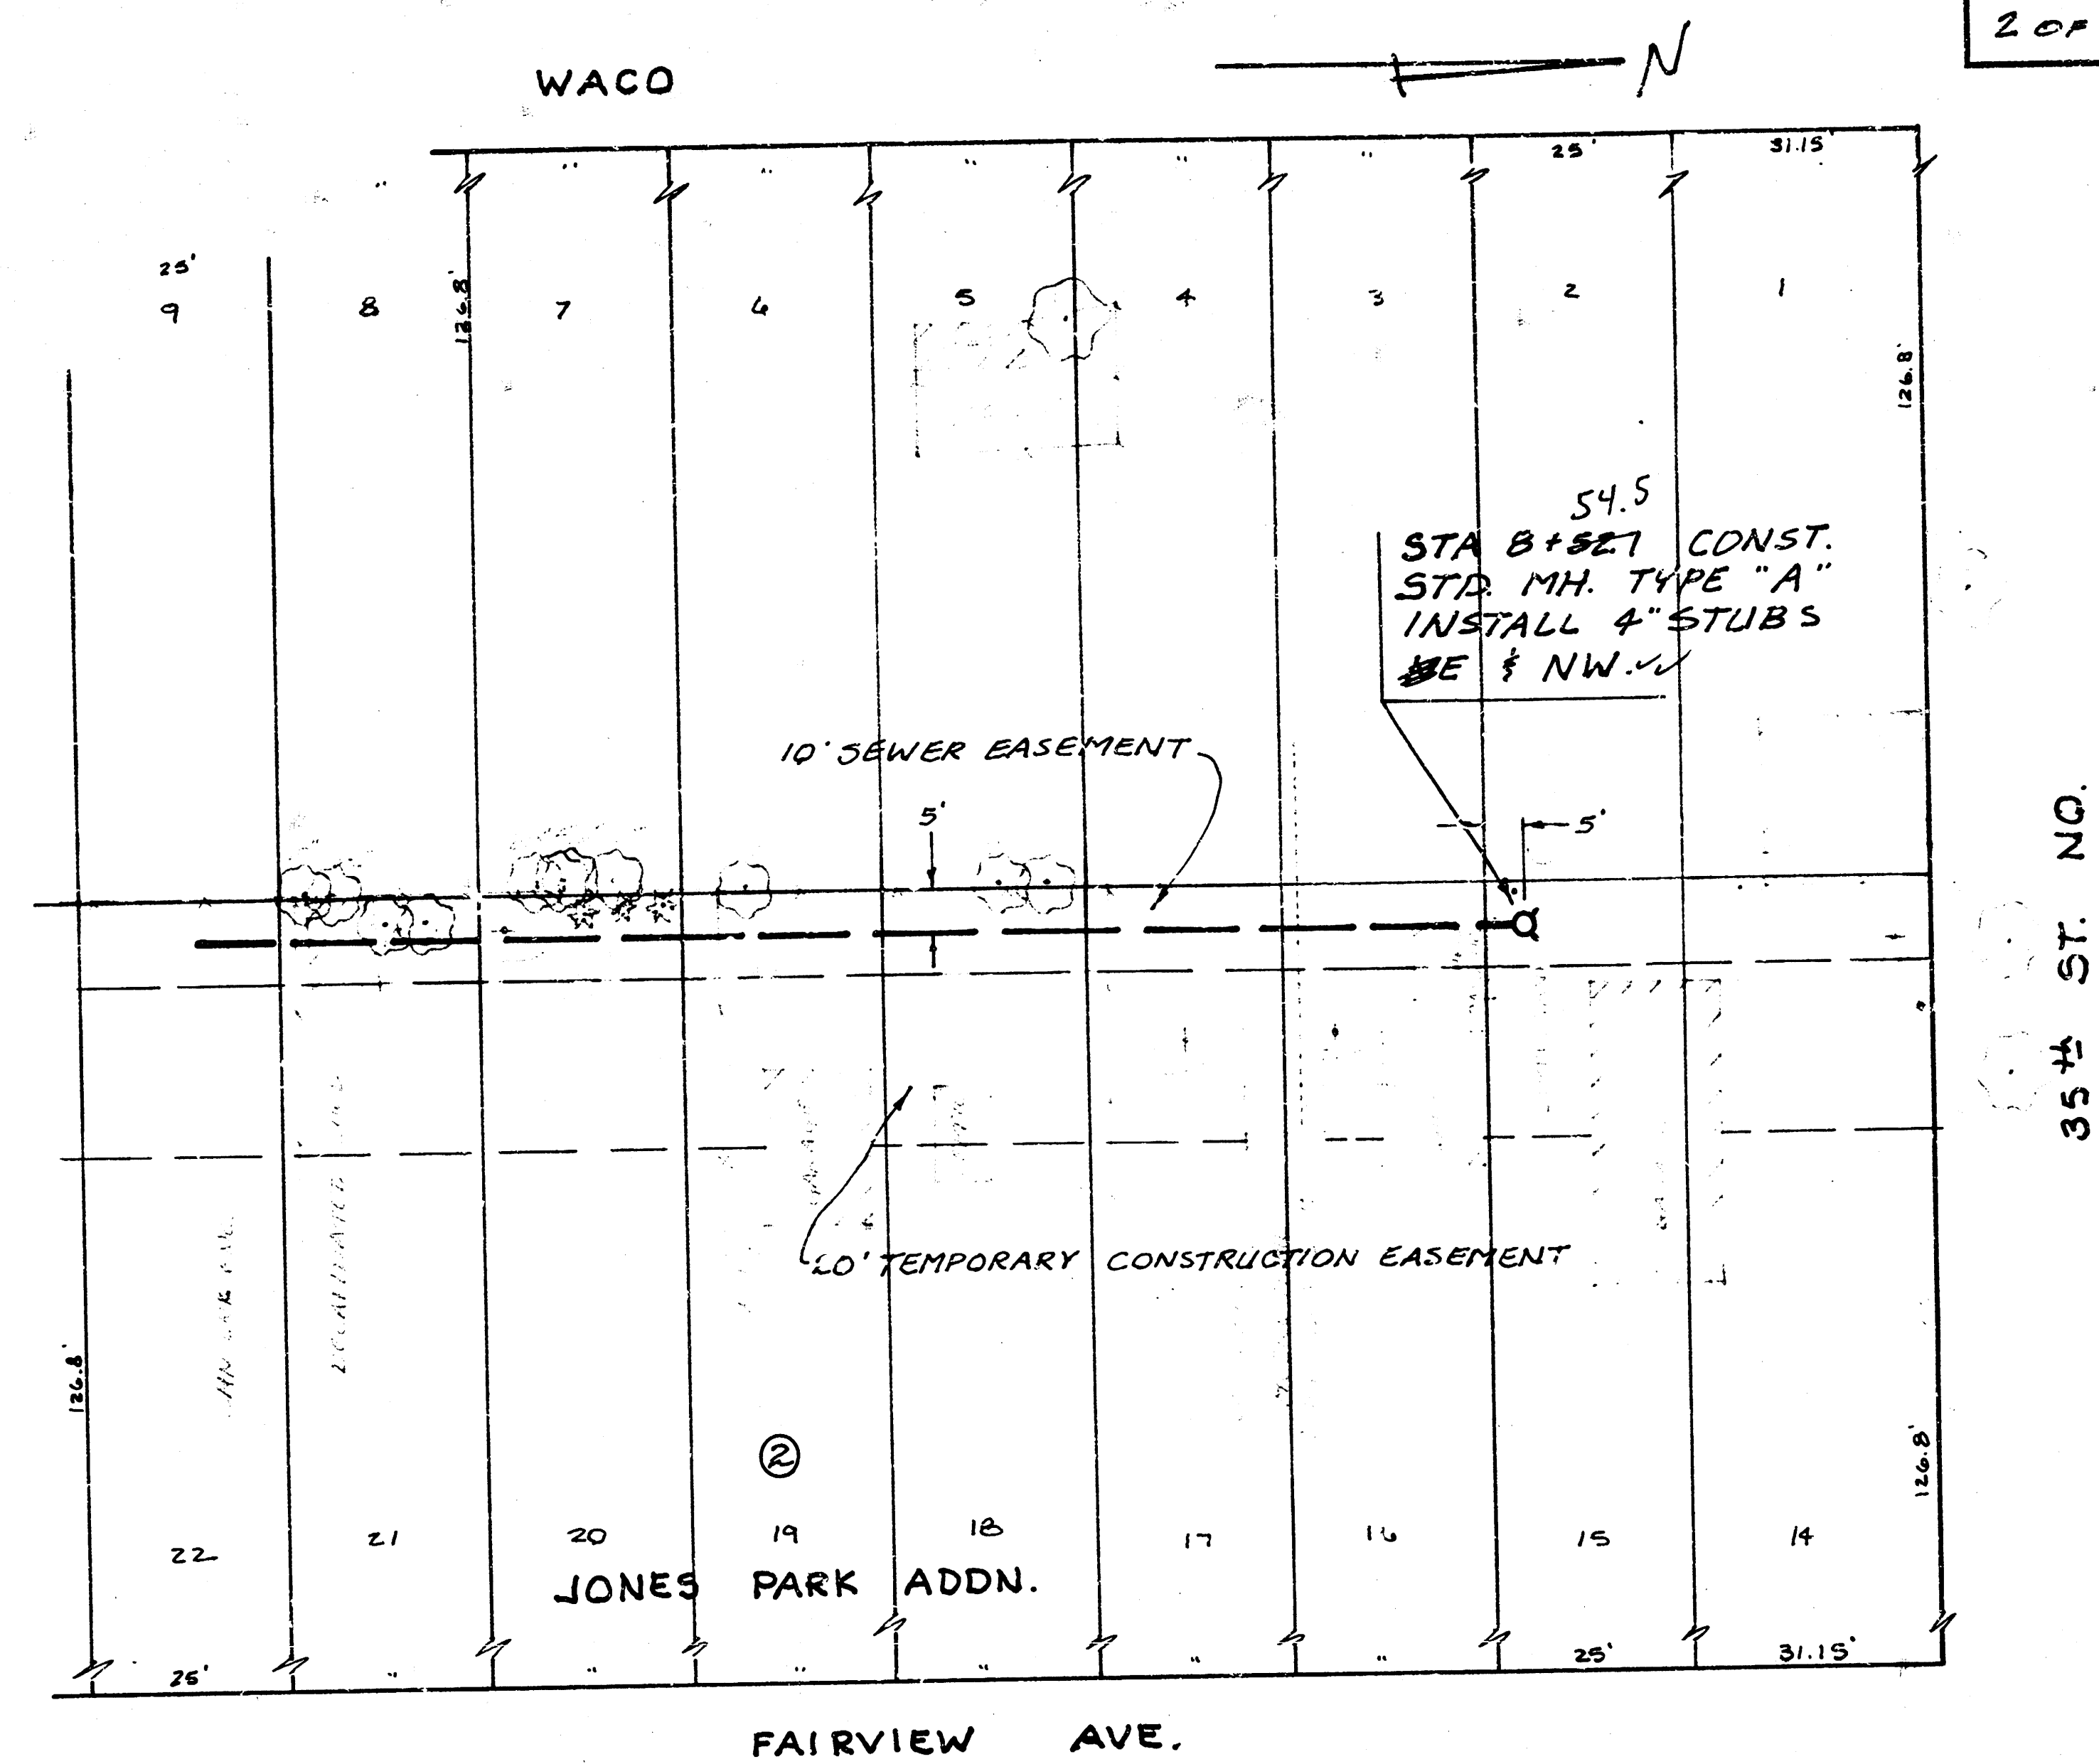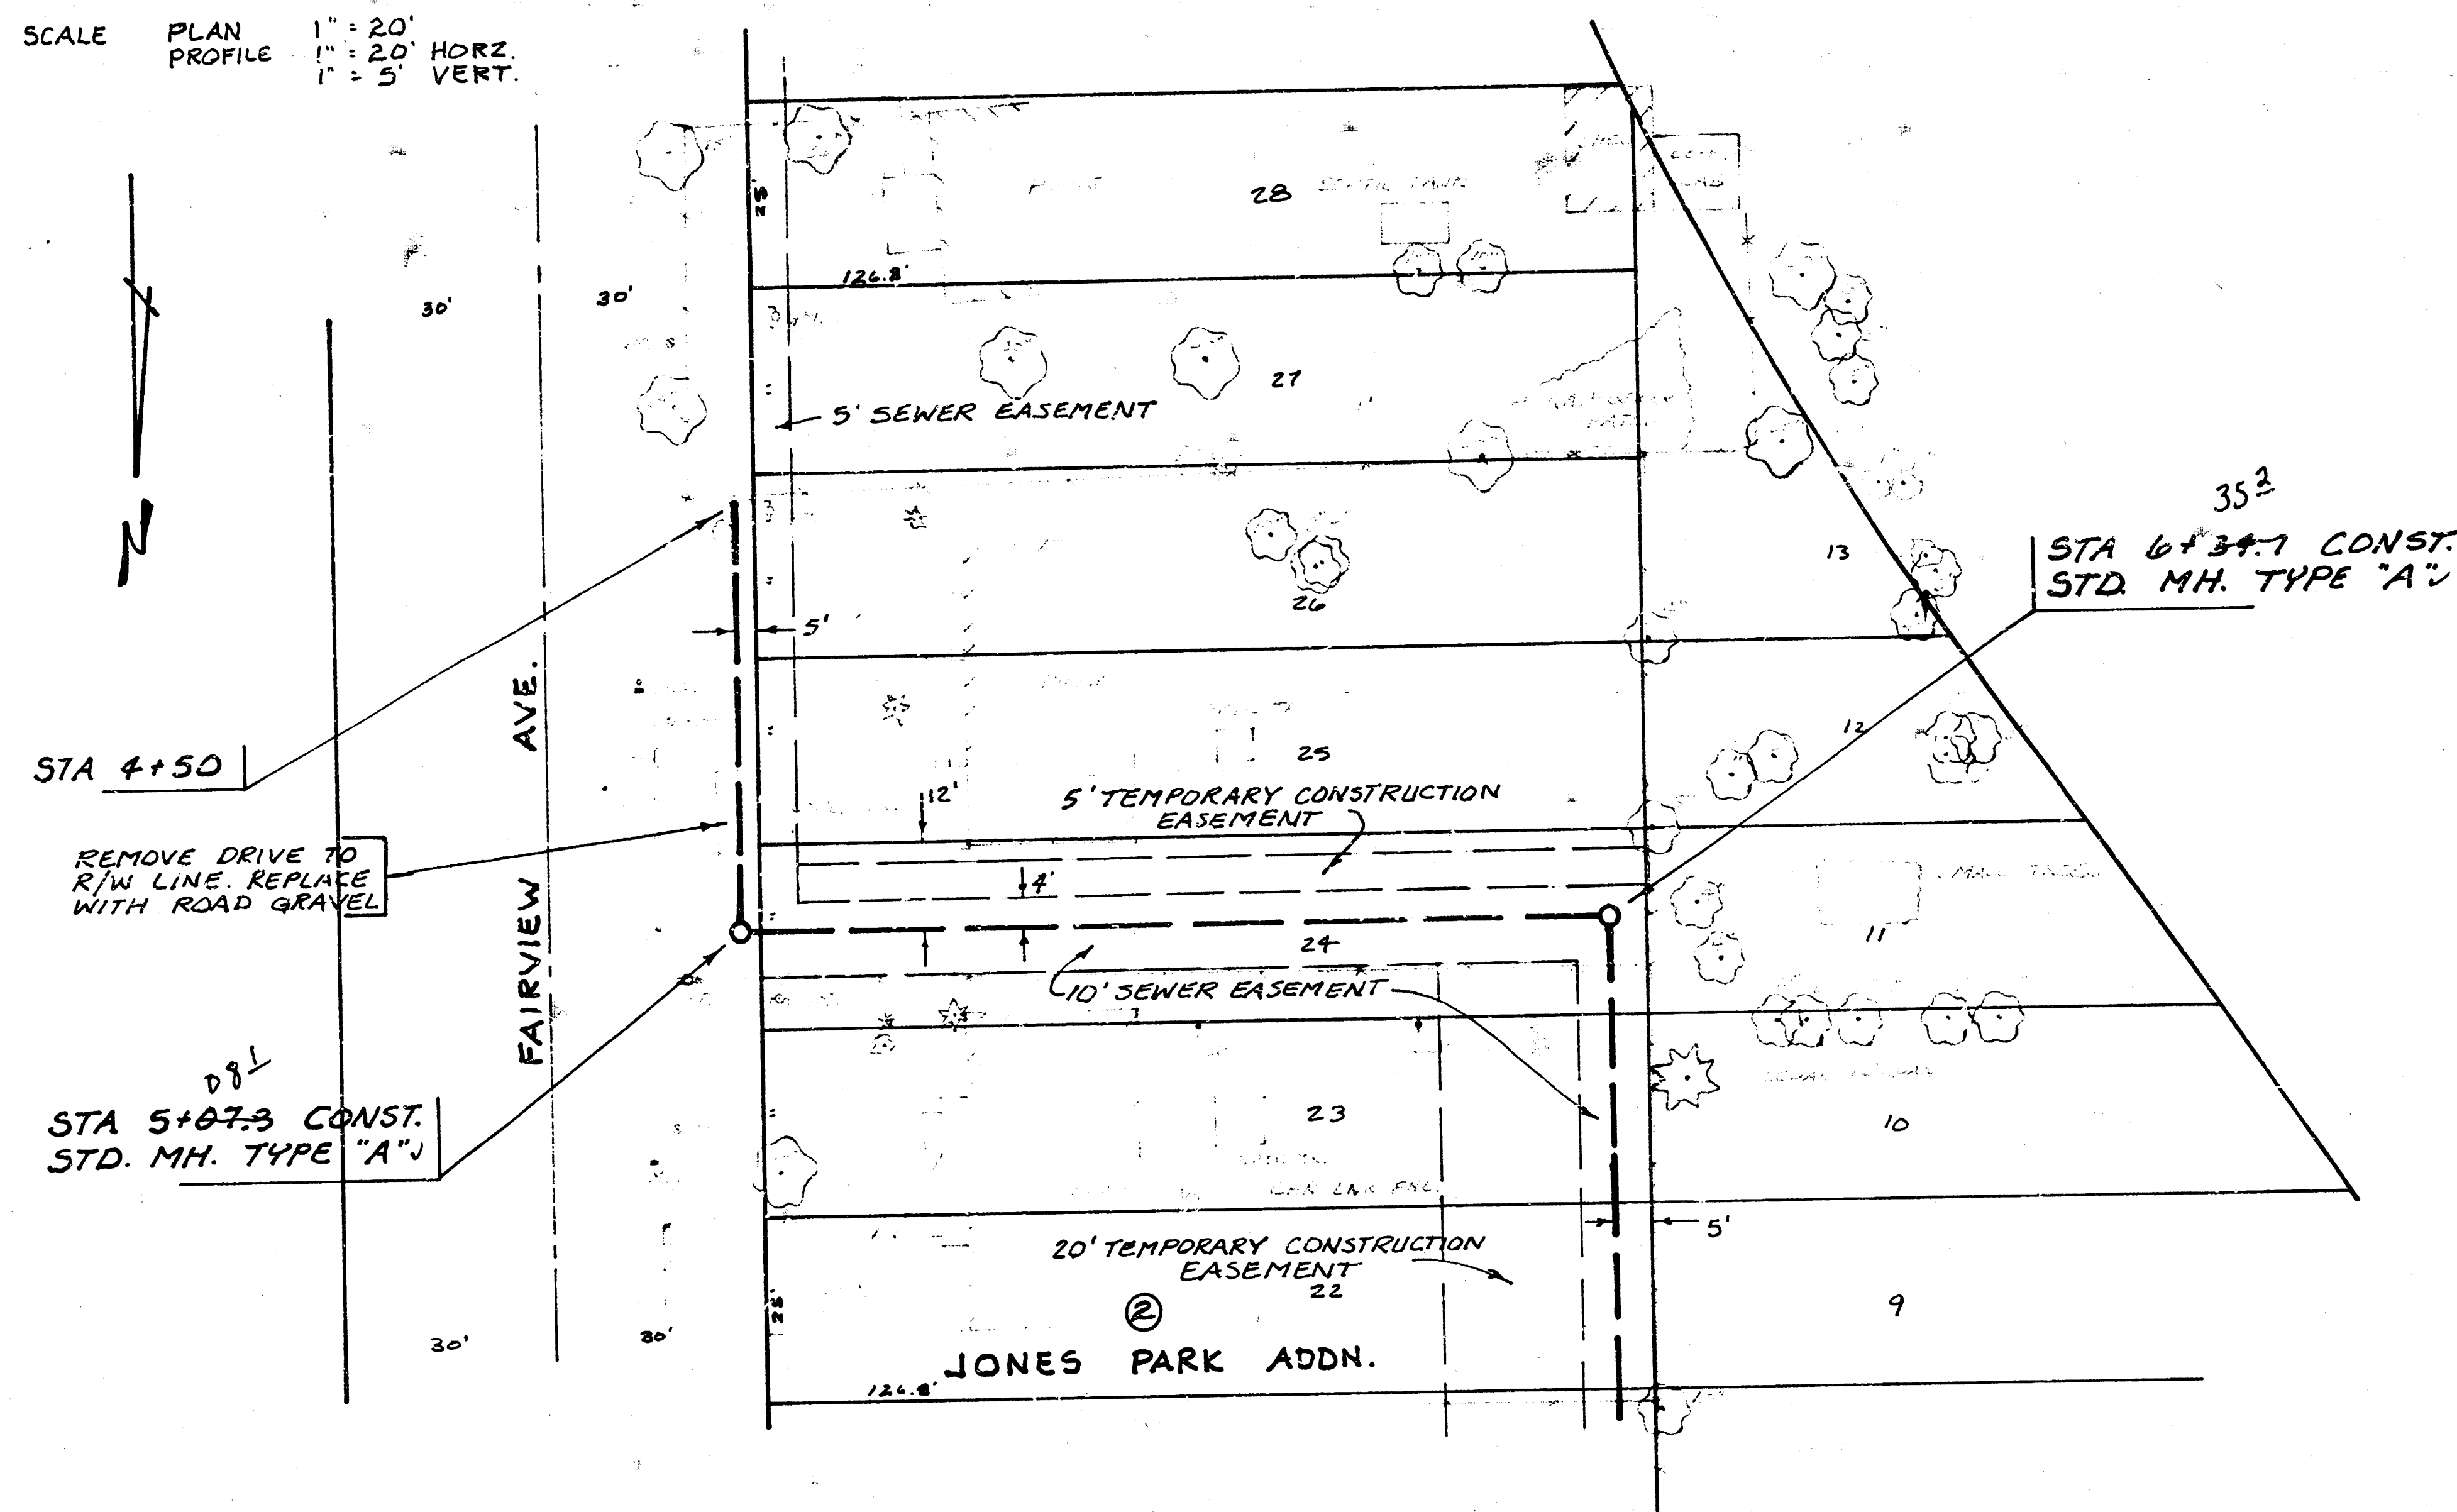

PROJECT DESCRIPTION
 LAT. 110, MAIN 4, S. S. NO. 23
 PROJECT NUMBER
 468-76-245-81258-000-000-001

FILMED FROM THE BEST
 AVAILABLE COPY