SHEET 1 OF 2

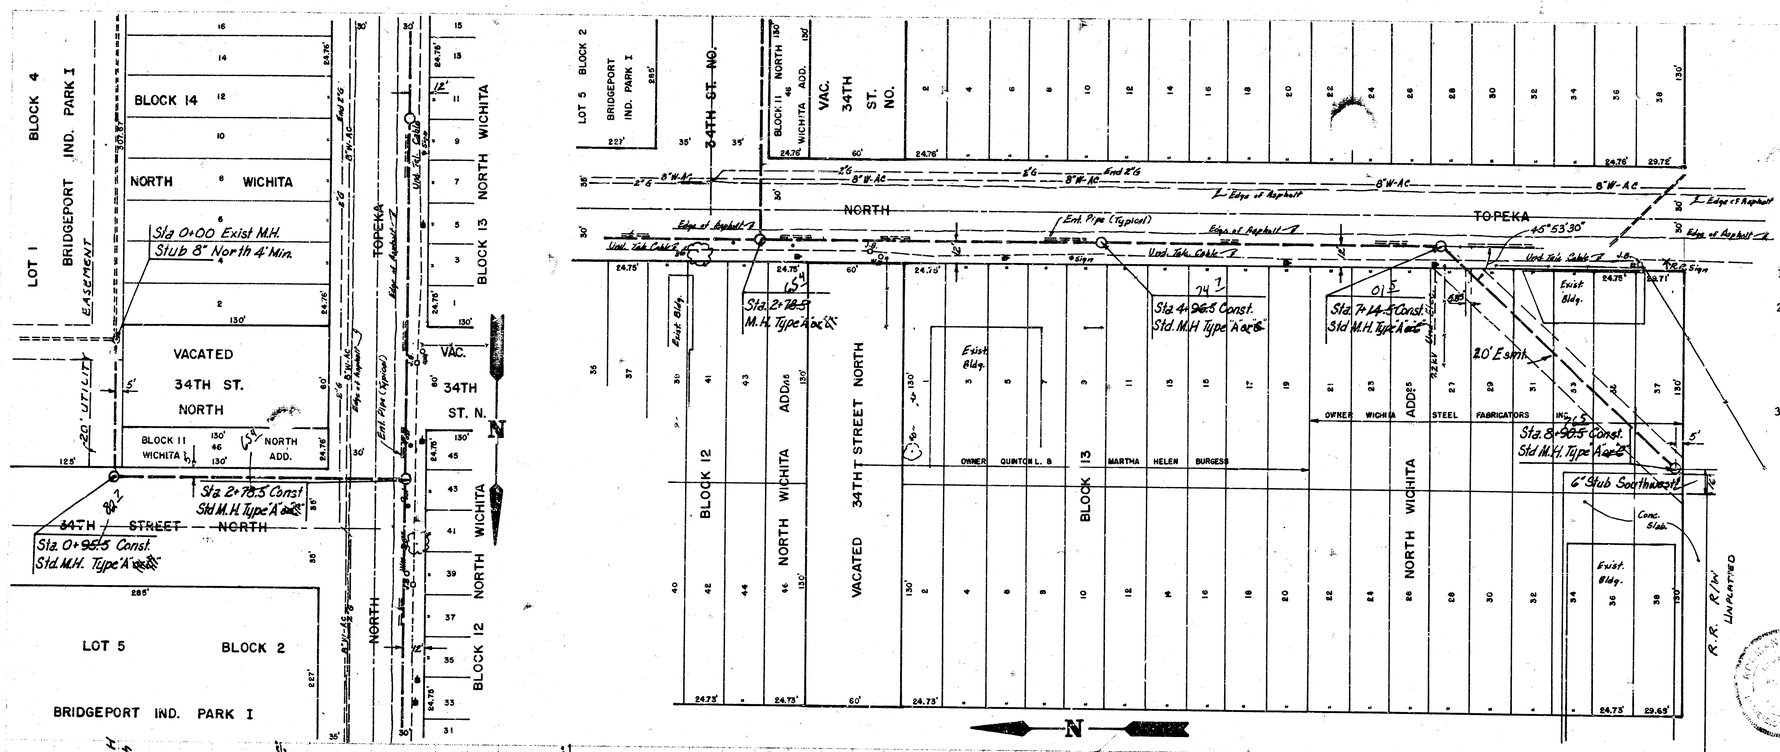

GENERAL NOTES

1. Removal and replacement of any or all entrance pipes shall be incidental to the project.
2. The contractor shall be responsible for preserving property irons. The contractor shall be required to re-establish any property irons which are damaged or destroyed by his construction operations. Such irons shall be re-established by a Registered Land Surveyor or a Licensed Professional Engineer in accordance with state laws.
3. Notify the following companies prior to any trenching.

ARKLA Gas Co.	942-8550
Bell Telephone Co.	268-3078
Cablevision	266-6817
Gas Service Co.	263-7511
Kansas Gas & Electric Co.	261-6248
Derby Refining Co.	267-0361
Kan-U-Dig-It	267-2889

B.M. 130.98 R.R. Spike in Power Pole 150' North of 33rd St. N. & Topeka

B.M. 130.86 60d Step in Power Pole 30' W. 35th St. N. & Topeka

B.M. 132.51 R.R. Spike in Power Pole 100' N. & 130' E. 34th St. & Topeka

B.M. 130.45 60d Step in Power Pole SW Corner of 34th & Emporia

SCALE
PLAN 1"=40'
PROFILE 1"=40' HORIZ.
PROFILE 1"= 5' VERT.

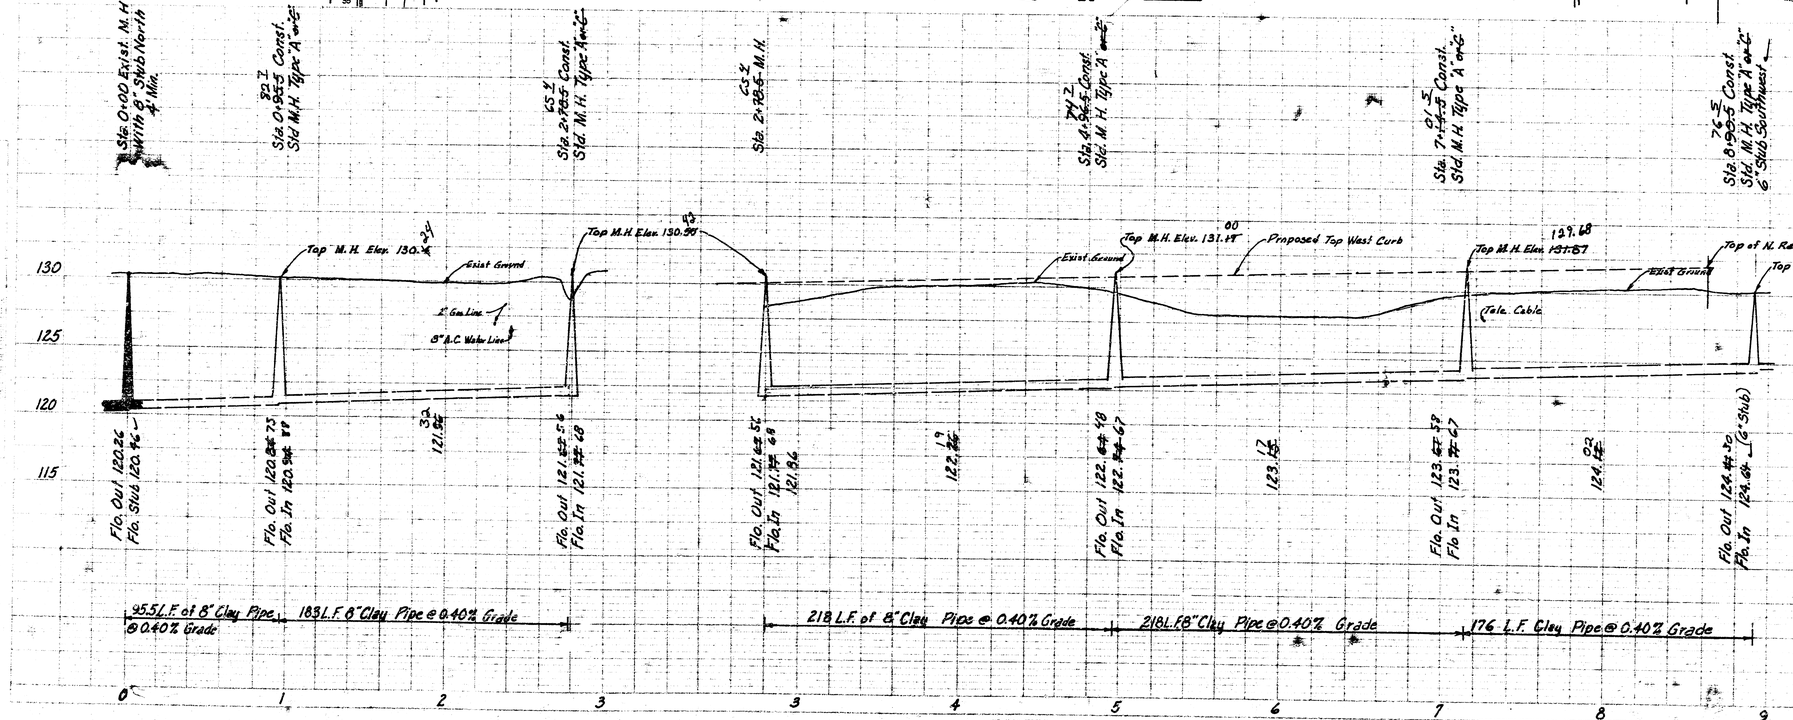

PLATE 1-SINGLE PLAN AND PROFILE-FULL LINE

As Built J.L.L. 6-85

CITY OF WICHITA
MIKE LINDEBAK — CITY ENGINEER

PROJECT DESCRIPTION
LAT. 112, MAIN 4, SANITARY SEWER 23

PROJECT NUMBER
468 76 245 81314 000 000 001

Booker/Freund
Engineers Architects Planners

SCALE AS NOTED | DATE JUNE, 1984 | DWG. NO. K-8138-L

1/2

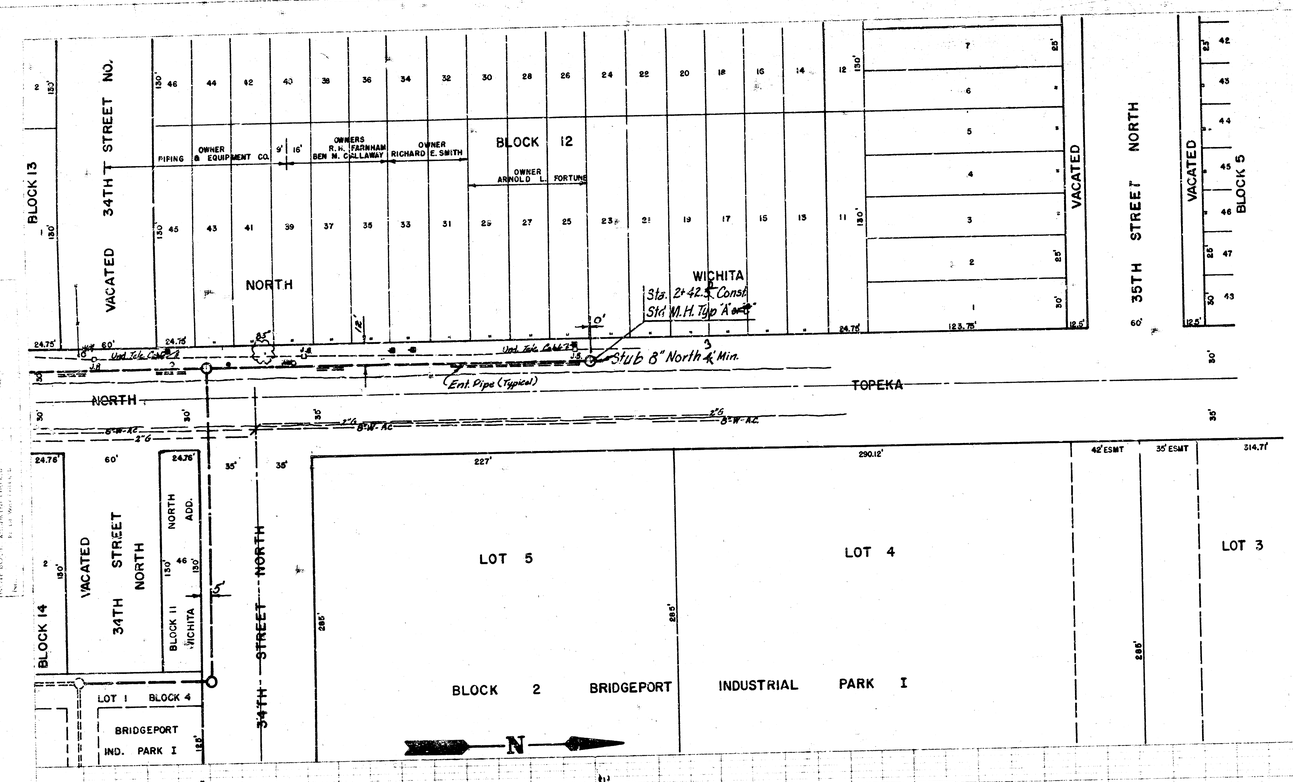

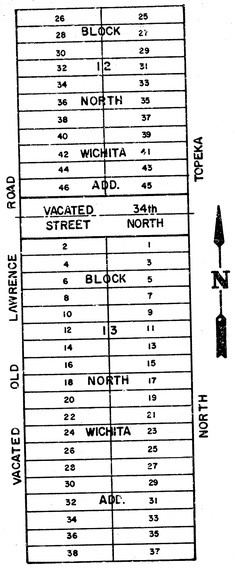

BENEFIT DISTRICT MAP
Scale 1" = 100'

B.M. 130.98 R.R. Spike in Power Pole 150' North of 33rd St. N. & Topeka

B.M. 130.86 60d Step in Power Pole 30' W of 35th St. N. & Topeka

B.M. 132.31 R.R. Spike in Power Pole 100' N. & 130'E. 34th St. N. & Topeka

B.M. 130.45 60d Step in Power Pole SW Corner of 34th & Emporia

SCALE
PLAN 1"=40'
PROFILE 1"=40' HORIZ.
PROFILE 1"= 5' VERT.

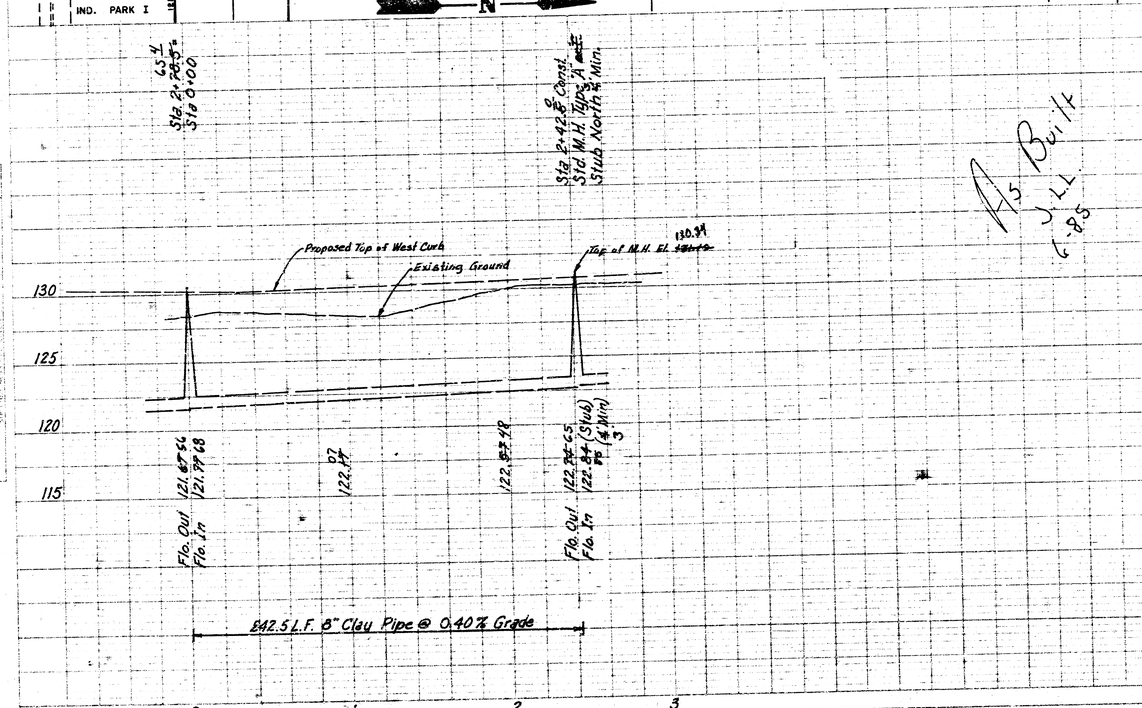

CITY OF WICHITA
M. E. LINDEBAK — CITY ENGINEER
PROJECT DESCRIPTION
LAT. 112, MAIN 4, SANITARY SEWER 23
PROJECT NUMBER
468 76 245 81314 000 000 001
Booker/Freund
Engineers Architects Planners
SCALE AS NOTED DATE JUNE, 1984 DWG. NO. K-8132-2

2/2

10 4 3 3

HIGHWAY FEDERAL AID SHEET
PLATE I-SINGLE PLAN AND PROFILE FULL LINE
PRINTED IN U.S.A.